

Q R

NOTICE TO SUPERINTENDENT OF STREETS.

Drain Permit No. 8845-8846

City of New Bedford,

Office of City Clerk, _____

NOV 6 1914

191

To Superintendent of Streets.

Permission has this day been issued to

Name Cohen Bros. Address 1088 Acushnet Ave

to lay drain from premises east side of Summer st. between
Coggeshall and Adams st.

to connect with sewer in Adams street.

James Dignan
City Clerk.

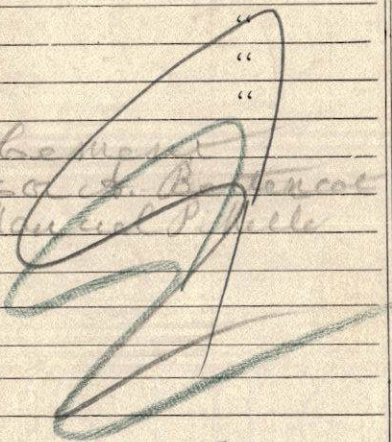
Return of Foreman.

Entered Dec 1 1914.

Time 11 A.M.

By Frank G. De Kello

COST.

Labor	70	hours @	31	21	88
	17	"	34	5	84
	7	"	50	3	50
		"		31	22
		"			
		"			
		"			
Stock					50
Carting					50
Total Cost				32	22
Deposit				30	00
Balance due					2 22

Pieces pipe to curb 15

" " curb to house 4

Cut at Sewer 2 ft

Cut at curb 2 ft

Size of pipe 6 in

Correct

Frank G. De Kello

Foreman.