

O. K. - rush please

NOTICE TO SUPERINTENDENT OF STREETS.

Drain Permit No. 9343

City of New Bedford,

Office of City Clerk,

JUN 15 1915

To Superintendent of Streets.

Permission has this day been issued to

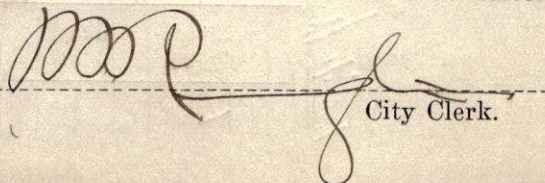
Bill to - Hermenegilde Laffleur
823 Brock Ave.

Name Zephiren Lemieux Address 65 Correll St

to lay drain from premises of Zephiren Lemieux & S. Hadley

Street east of Quaker Street Ave

to connect with sewer in Correll street.


City Clerk.

Return of Foreman.

Entered June 29 1915.

Time 10 A.M.

By Frank B. DeMello

COST.

Labor	99 hours @ 36	30 69
	21 " 34	7 22
	4 " 50	2 00
	"	39 91
	"	
	"	
	"	
	"	
Stock	Cement	50
	for Batterment	
	Manuel P. Mello	
Carting		50
Total Cost		40 91
Deposit		115 -
Balance due		

Pieces pipe to curb 7 ¹⁰

" " curb to house 63

Cut at Sewer 8 ft

Cut at curb 3 ft

Size of pipe 6 in

Correct

Frank B. DeMello
Foreman.