

C. K.

NOTICE TO SUPERINTENDENT OF STREETS.

Drain Permit No. 9418

City of New Bedford,

AUG 6 1915

Office of City Clerk, ----- 191


To Superintendent of Streets.

Permission has this day been issued to

Name Mary Michaber Address 87 Acushnet Ave.

to lay drain from premises of Mary Michaber, on the S. E. of
Linckham St. between Brook and Church Sts.

to connect with sewer in Linckham street.

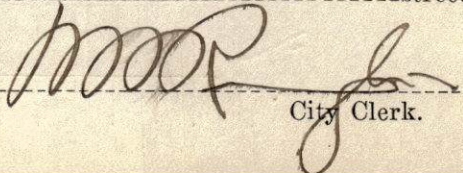

City Clerk.

Return of Foreman.

Entered Sept 3 1915
 Time 11 A.M.
 By Frank B. De Mello

COST.

Labor	34	hours @	31	10	63
	8 1/2	"	34	2	92
	3	"	50	1	50
		"		15	05
		"			
		"			
		"			
		"			
Stock	Cement for Restaurant				25
	Manuel De Mello				
Carting					50
Total Cost				\$15	80
Deposit				20	—
Balance due					

Pieces pipe to curb 8
 " " curb to house 7
 Cut at Sewer 8 ft
 Cut at curb 6 ft
 Size of pipe 6 in
 Correct

Frank B. De Mello
 Foreman.