

P.K.

NOTICE TO SUPERINTENDENT OF STREETS.

Drain Permit No. 9471

City of New Bedford,

OCT 2 1915

Office of City Clerk, _____ 191

To Superintendent of Streets.

Permission has this day been issued to

Name Pierre M. Gentilhomme Address 276 Collette St.

to lay drain from premises of Pierre M. Gentilhomme on the
west side of Bowditch St. south of Collette St.
to connect with sewer in Collette street.

M. W. Remington.
City Clerk.

Return of Foreman.

Entered Nov 1 191 5

Time 4 P.M.

By Frank C. De Kello

COST.

Labor	200	hours @ 31	62	50
	57	" 34	19	59
	11	" 50	5	50
		"	87	59
		"		
		"		
		"		
		"		
Stock	Cement			50
	Dynamite 6 lbs		2	40
	2 x plasters 15			75
	2 hills 11			55
	House 10			
Carting	House 10			50
Grass			23	40
But			10	80
			126	49
Total Cost				
Deposit			113	
Balance due				11.49

Pieces pipe to curb 21

" " curb to house 6

Cut at Sewer 8 ft


Cut at curb 6 ft

Size of pipe 6 in

Correct

Frank C. De Kello

Foreman.

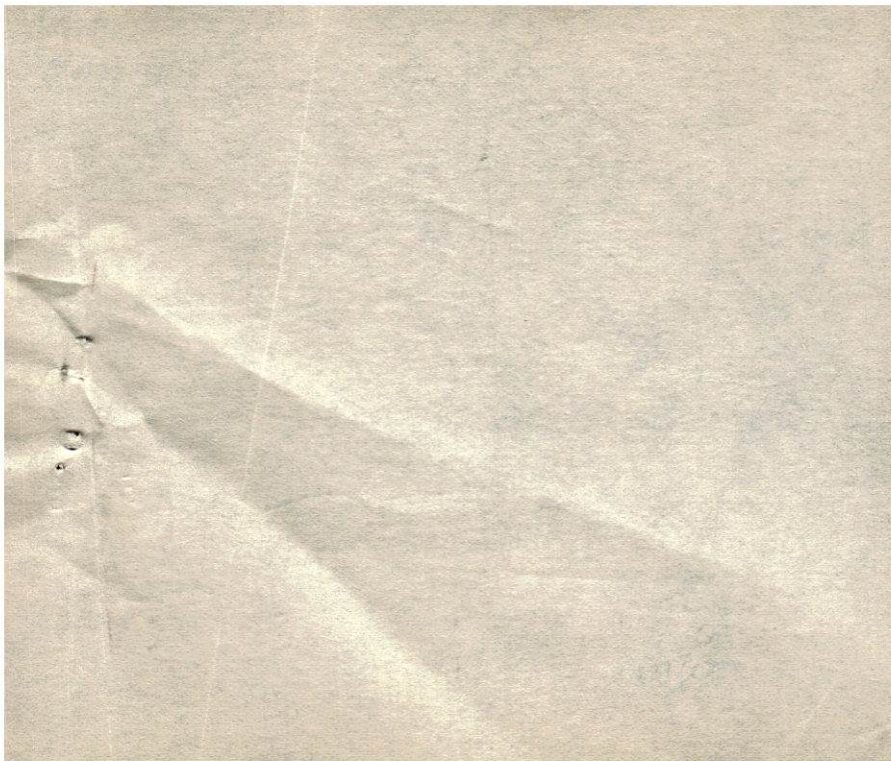

To be repaired
later

Granolithic } 13 sq yds
5 square } @ 1.80 =
23.40

Bitulitic

~~12 sq ft = 36 sq ft =~~

3 sq yds @ 3.60 = 10.80

$$\begin{array}{r}
 23.40 \\
 1080 \\
 \hline
 3420 \\
 92.29 \\
 \hline
 126.49
 \end{array}$$

$$\begin{array}{r}
 126.49 \\
 3420 \\
 \hline
 92.29
 \end{array}$$

$$\begin{array}{r}
 48 \\
 321 \\
 \hline
 1610
 \end{array}$$

$$\begin{array}{r}
 180 \\
 140 \\
 180 \\
 \hline
 2340
 \end{array}$$

Partially paid.
2 pieces at $5 \times 2 \frac{1}{2} =$
3 Sq. Yds.

Dorothea Sykes
 on Bonded St. by chain 23.40
 5 years $(4-8) \times (5-0) = 135g.4$