

O. K.

NOTICE TO SUPERINTENDENT OF STREETS.

Drain Permit No. 9566

City of New Bedford,

NOV 17 1915

Office of City Clerk, \_\_\_\_\_ 191

To Superintendent of Streets.

Permission has this day been issued to

Name Albert Houghton Address 160 David St.

to lay drain from premises Albert Houghton, on the  
south side of David st. west of Brock Ave,

to connect with sewer in David street.

James Dignam  
Asst. City Clerk.

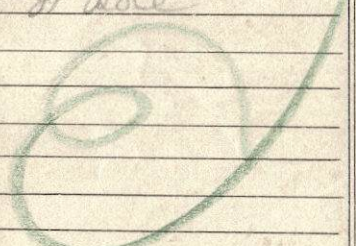
# Return of Foreman.

Entered Mar 28 1915

Time 1 Pull

By Franco De Nello

## COST.

Labor	42	hours	@ 31	13	13
	15	"	34	5	33
	4	"	50	2	00
		"		20	46
		"			
		"			
		"			
		"			
Stock	<u>Cement</u>				25
	<u>channel brace</u>				
	<u>1/2" x 2" wood</u>				
					
Carting					
Total Cost				21	21
Deposit				20	00
Balance due					1.21

Pieces pipe to curb 8

“ “ curb to house 7

Cut at Sewer 9 ft

Cut at curb 6 ft

Size of pipe 6 in

Correct \_\_\_\_\_

Franco De Nello

Foreman.