

NOTICE TO SUPERINTENDENT OF STREETS.

Drain Permit No. 9623

City of New Bedford,

Office of City Clerk, Jan. 17 1916

To Superintendent of Streets.

Permission has this day been issued to

Name City of New Bedford Address (Fire Station)

to lay drain from premises N. E. corner North and

Pleasant st

to connect with sewer in North street.

Frank:

Please furnish pipe

[Signature]
City Clerk.

Return of Foreman.

Entered Jan 24 191 6.

Time 3 P.M.

By Frank B. DeHelle

COST.

Labor	363 1/2 hours @ 31	112	69 -
Rolls -	53 " 34	18	39 -
	32 " 50	16	00
	"	147	08 ✓
	"		
	240 " 31	74	40 -
Roll 9 -	92 " 34	31	45 -
	21 " 50	10	50
Stock		116	35 ✓
	Feb 6 12-23 " 31	71	61 -
	90 " 34	30	77 -
	18 " 50	9	00 -
		111	38 ✓
	48 31	15	00
Carting	16 50	8	00
		23	00 ✓
		1	00 -
		5	81
Total Cost			
Deposit	No. Deposit		100
Balance due			

Pieces pipe to curb 39 18 ft.

" " curb to house 5

Cut at Sewer 7 ft.


Cut at curb 8 ft.

Size of pipe 8 in.

Correct

Frank B. DeHelle

Foreman.

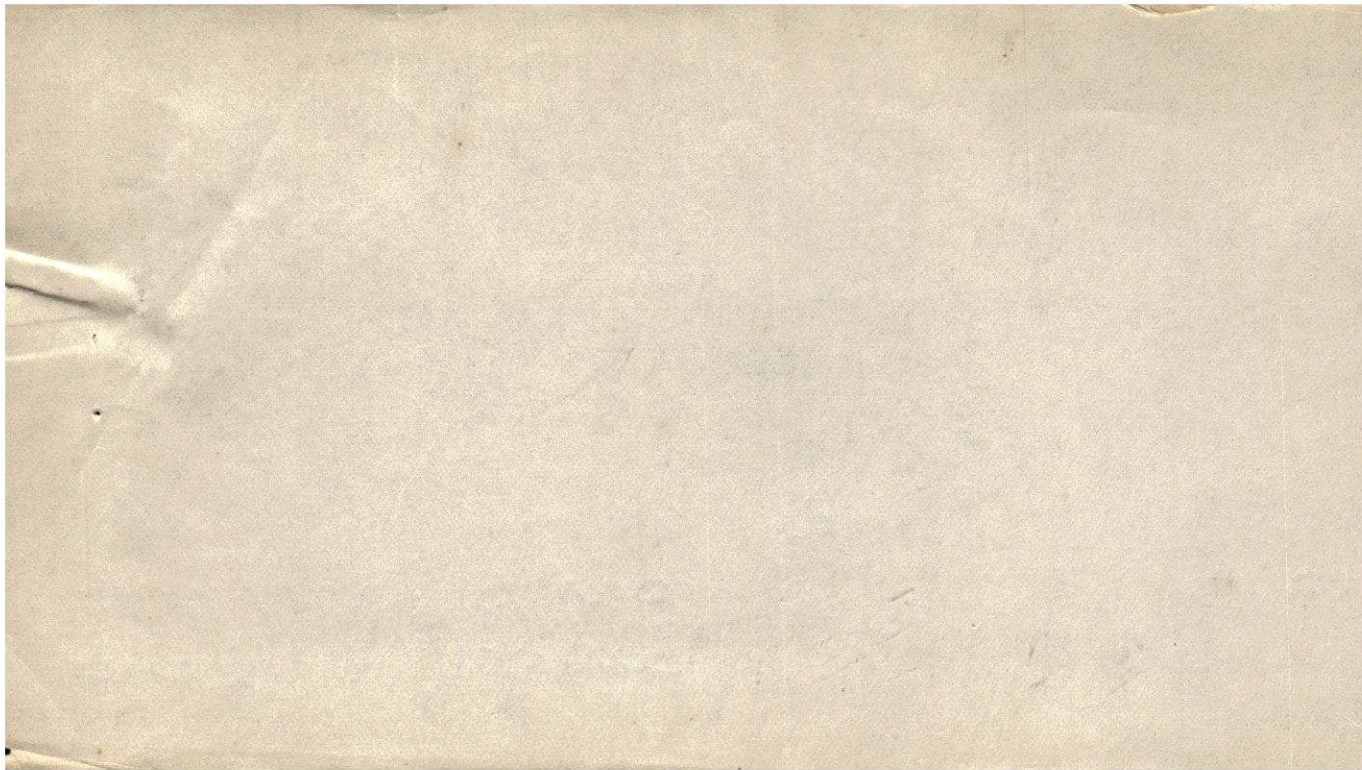

Dynamite 18-lb		
Exploder	62	54
Drill sharp	93	54
8 in pipe	86 ft	247
8 in band	2	724
Cement	2 bags	458

18 lb. Dynamite @ 30¢ =	5.40
2 Exploder @ 5¢ =	3.10
93 Drill sharpened @ 5¢	4.65
86 ft. 8" pipe @ 24¢	20.64
2 pcs. - 8" Band @ 72¢ =	1.44
2 Bags Cement @ 45¢ =	.90

Casting pipe	.84
" flag	1.87
" "	.94
" "	1.88
Pipe	3.53

Casting duct (R. 18)	449.81
	3.93
	453.74

453.74

25.61

14.05

6.53
2.93

403.62

labor -

caulking

stake

pipe -

3

