

O. K.

NOTICE TO SUPERINTENDENT OF STREETS.

Drain Permit No. 9797

City of New Bedford,

Office of City Clerk, JUN 30 1916 191

To Superintendent of Streets.

Permission has this day been issued to

Name Abraham Epstein Address 51 Summer St
to lay drain from premises of Abraham Epstein at
177 Cedar St
to connect with sewer in Sycamore street.

W. H. B. Remington.

P. G. H. City Clerk.

Return of Foreman.

Entered July 10 1916
 Time 1 P.M.
 By Frank B. De Kello

COST.

Labor	185 hours @ 31	57	35
	34 " 34	11	69
	11 " 50	5	50
	"	74	54
	"		
	"		
	"		
	"		
Stock	Cement		50
	for Bottom coat		
	Auton & Peneine		
	Madame 12-2 1/2		
	3 1/3 sq. yds. 60¢	2	00
	Carting		50
	Carting from house	2	06
		79	60
Total Cost			
Deposit		100	-
Balance due			

Pieces pipe to curb 53 $\frac{59}{4} = 11.75$ 20.40
 " " curb to house 4


Cut at Sewer 9 ft

Cut at curb 6 ft

Size of pipe 6 in

Correct

Frank B. De Kello
 Foreman.

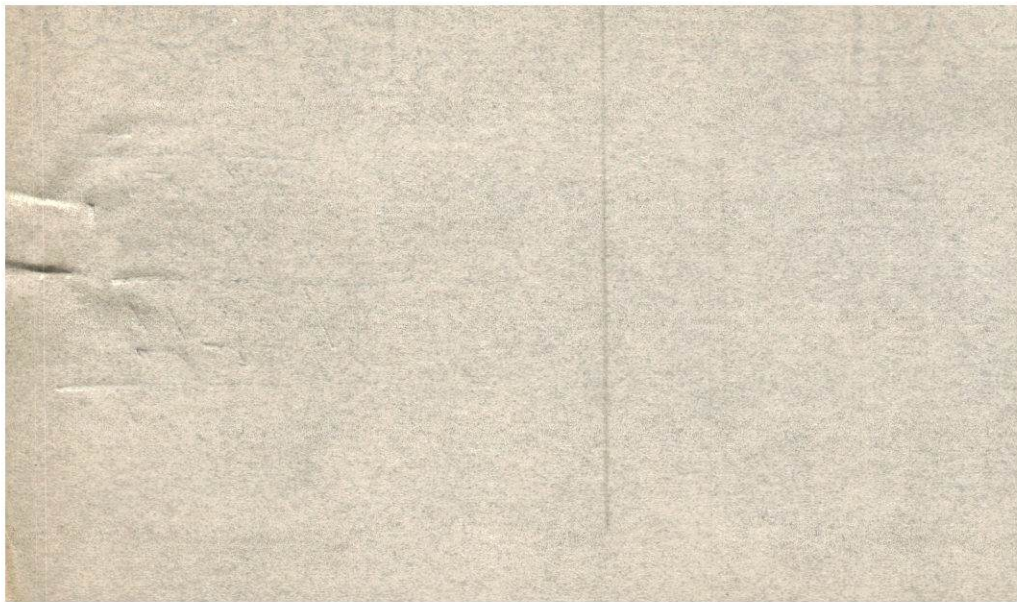

Reel mounted Aug. 20/1913 - 2.44
 " " Dec. 18/1916

76.07 - 5.5100
 78.51
 179.60

15811
 153.50

3.11