

NOTICE TO SUPERINTENDENT OF STREETS.

Drain Permit No. 13762

City of New Bedford,

Requires separate entrance for sewage and roof water.

Office of City Clerk, MAY 11 1925 19

To Superintendent of Streets.

Permission has this day been issued to

Name Domingo Quadros
Constantino C. Mendoza Address 14 Dumble

to lay drain from premises of Domingo Quadros & Constantino C

Mendoza, on the south side of Richards St. west of Bolton

to connect with sewer in Richards street;

Josue Vezina
City Clerk.

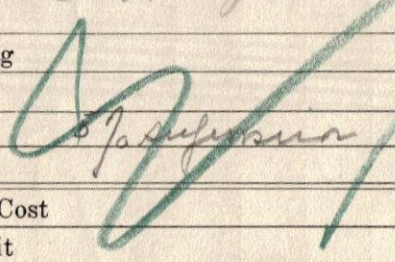
1925
MAY
11

Card
OK
me

Return of Foreman.

Entered July 1 19 25
 Time 2 P M
 By Frank B DeHelle

COST.

Labor	51	hours @	59	30	28
	17	"	63	10	63
	6	"	78	4	69
		"		45	60
		"			
		"			
		"			
		"			
Stock	Cement				50
	Cement Perreira				
	1 lb 1 lb 1 lb				
	Dirt Surface				
Carting					50
				46	60
				2	33
				48	93
Total Cost					
Deposit				60	—
Balance due					11.07

Pieces pipe to curb 7
 " " curb to house 5
 Cut at Sewer 8 ft
 Cut at curb 6 ft
 Size of pipe 6 in
 Correct

 Frank B DeHelle
 Foreman.