


THE EXISTING LOTS AND EASEMENTS SHOWN HEREON, WERE COMPILED FROM THE PLANS ENTITLED "DEFINITIVE PLAN OF LAND - LOT LAYOUT PLAN FOR ZUCKERMAN'S FARM, NEW BEDFORD, MASSACHUSETTS" BY ATLANTIC DESIGN ENGINEERS, LLC AND FILED IN THE BRISTOL COUNTY REGISTRY OF DEEDS, SOUTHERN DISTRICT, AT PLAN BOOK 150, PAGE 82.

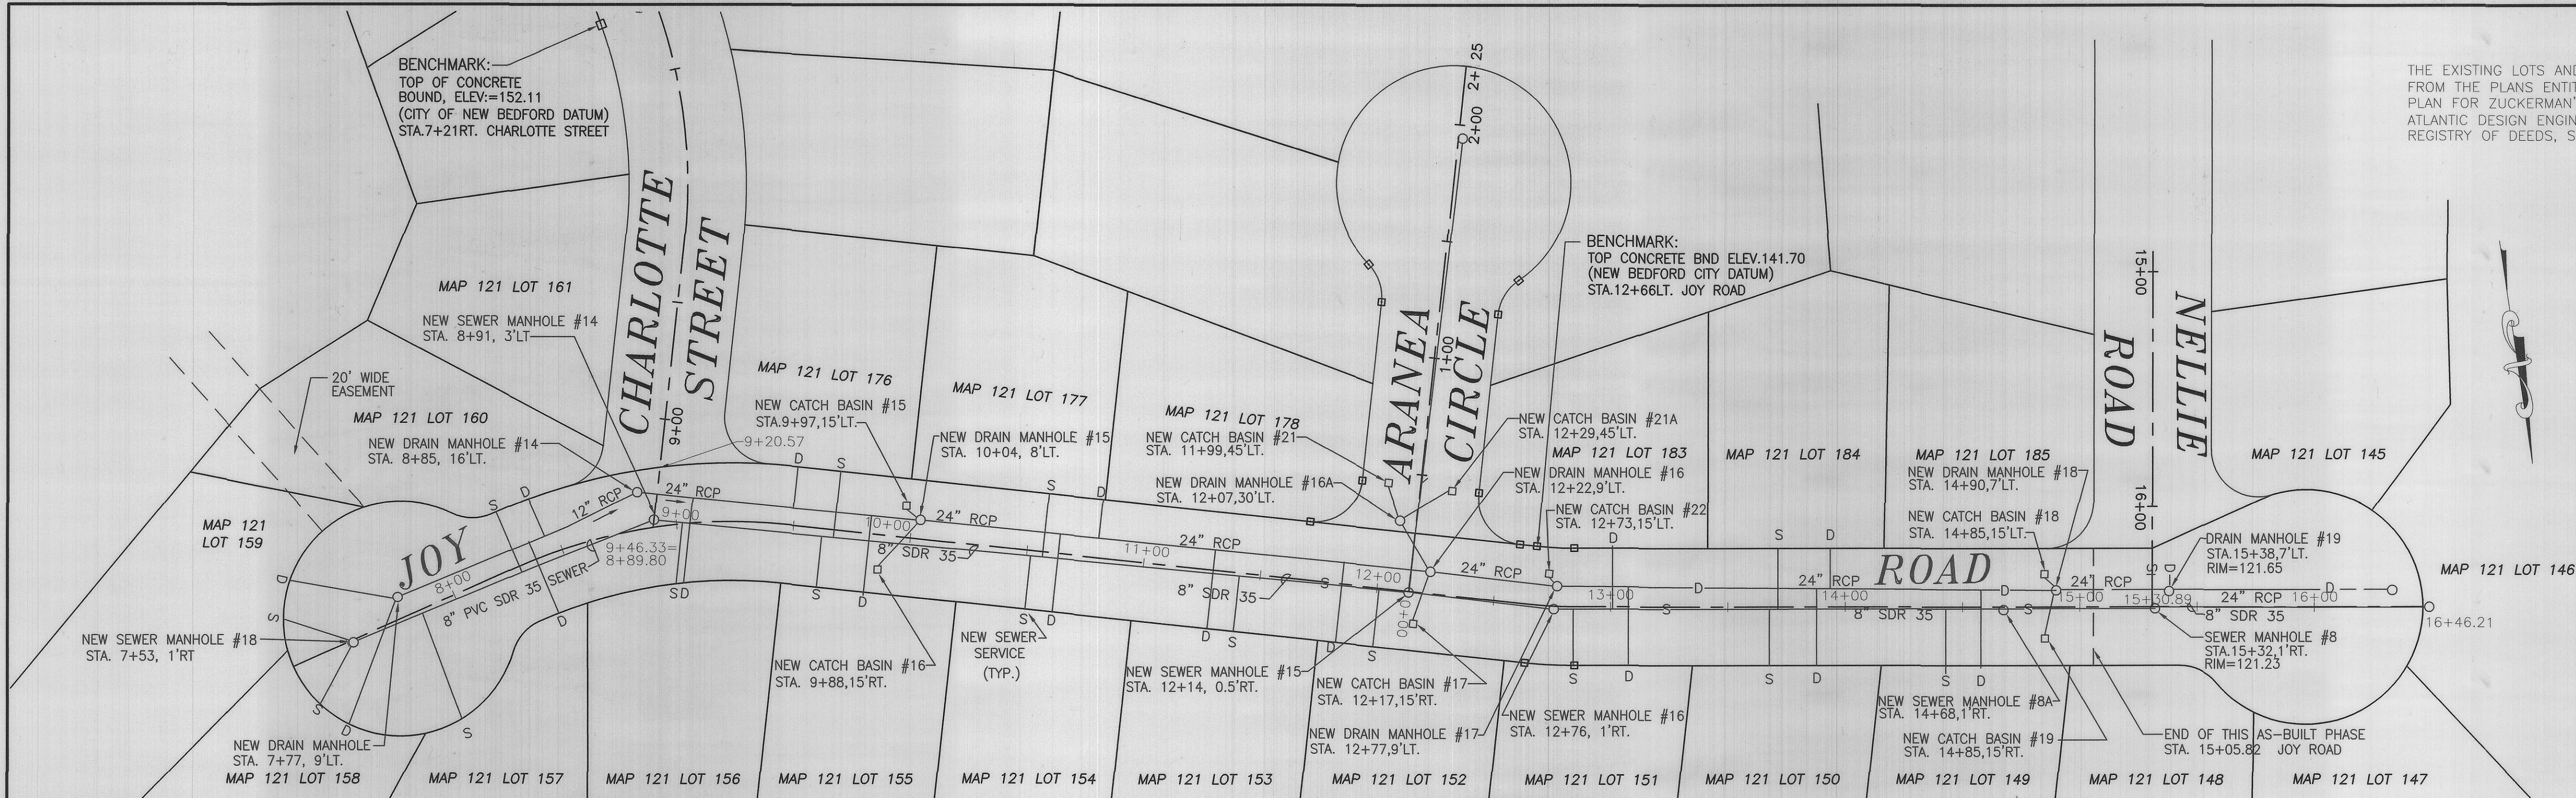

SEWER WYES STATIONS	LOT NUMBER	SERVICES STREET SIDELINES
(SMH 7+53)	121-158	28'±R
(SMH 7+53)	121-159	30'±L
7+85	121-157	48'R±
8+30	121-160	28'±L
9+03	121-156	26'R±
9+67	121-176	28'±L
9+62	121-155	22'R±
10+52	121-154	23'R±
10+57	121-177	27'±L
11+41	121-153	24'R±
12+00	121-152	25'R±
12+86	121-151	24'R±
13+70	121-150	24'R±
13+76	121-184	26'±L
14+46	121-149	24'R±

AS-BUILT SEWER AND SURFACE DRAIN
JOY ROAD

NOTE: SEE PREVIOUS AS-BUILT INFORMATION FOR JOY ROAD WEST OF NELLIE ROAD (COMPLETED BY OTHERS)

FROM STA.7+25 (164.80 FEET EAST OF CHARLOTTE STREET) 780.81 FEET WESTERLY TO STA.15+05.82 BY EAST LINE OF NELLIE ROAD

ACCEPTED:

CITY COUNCIL: _____

MAYOR: _____

CITY CLERK: _____

SCALES:




HORIZONTAL 1"=40' VERTICAL: 1"=4'

CONSTRUCTED BY: PICO CONSTRUCTION DEVELOPER: JOSE VERISSIMO & JOSE T. DESOUSA

CONSTRUCTION COMPLETED DATE: DECEMBER 19, 2013

David M. Delo 12/27/2013

CITY ENGINEER

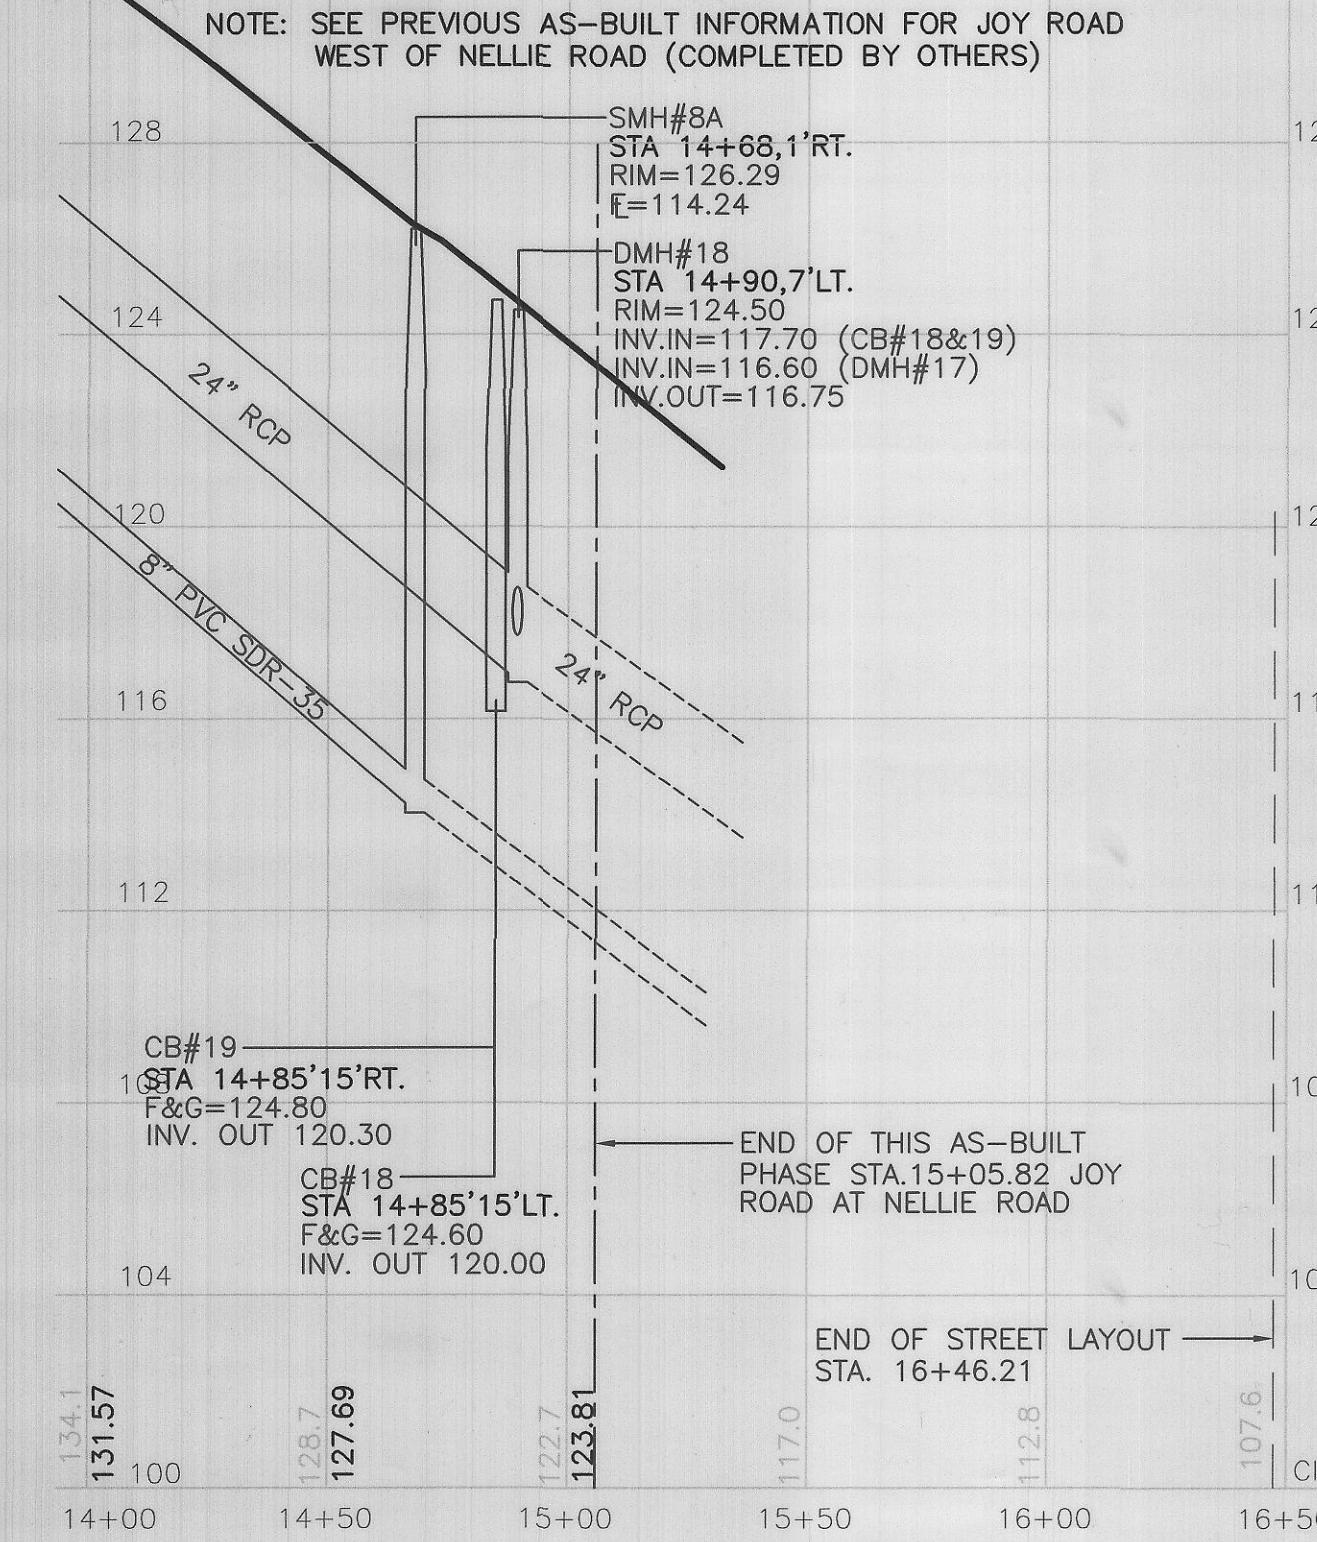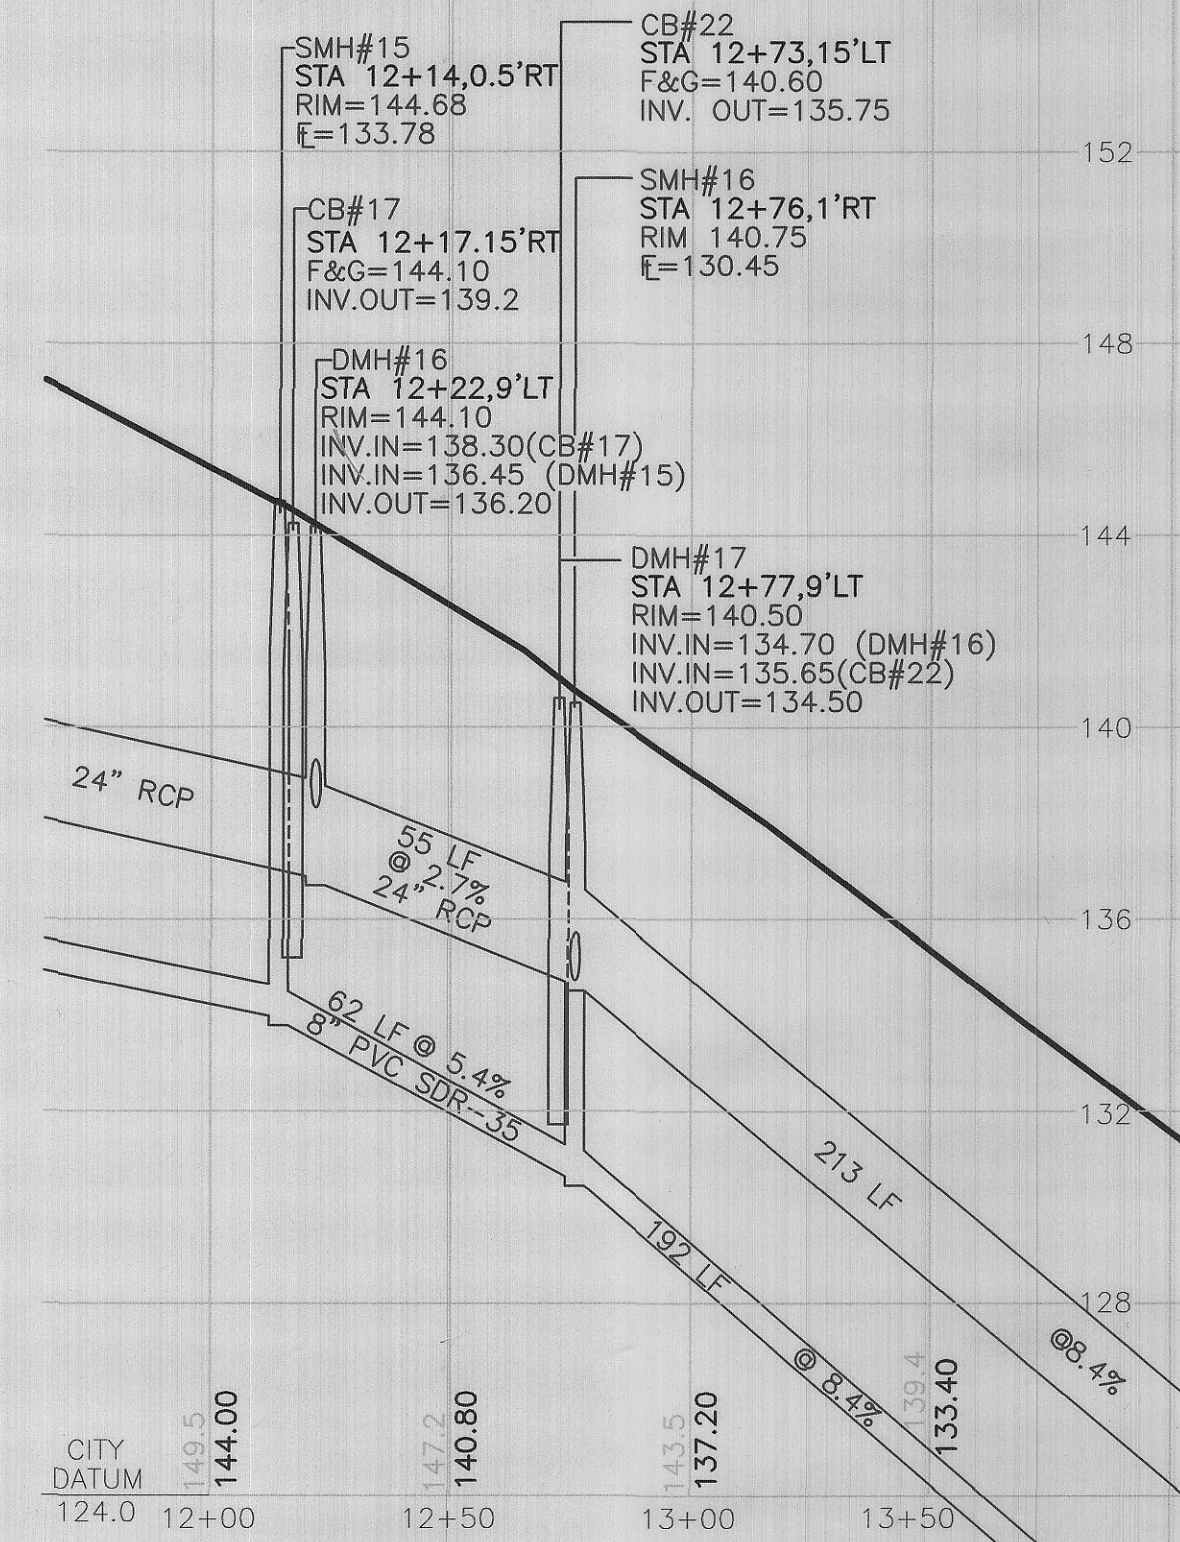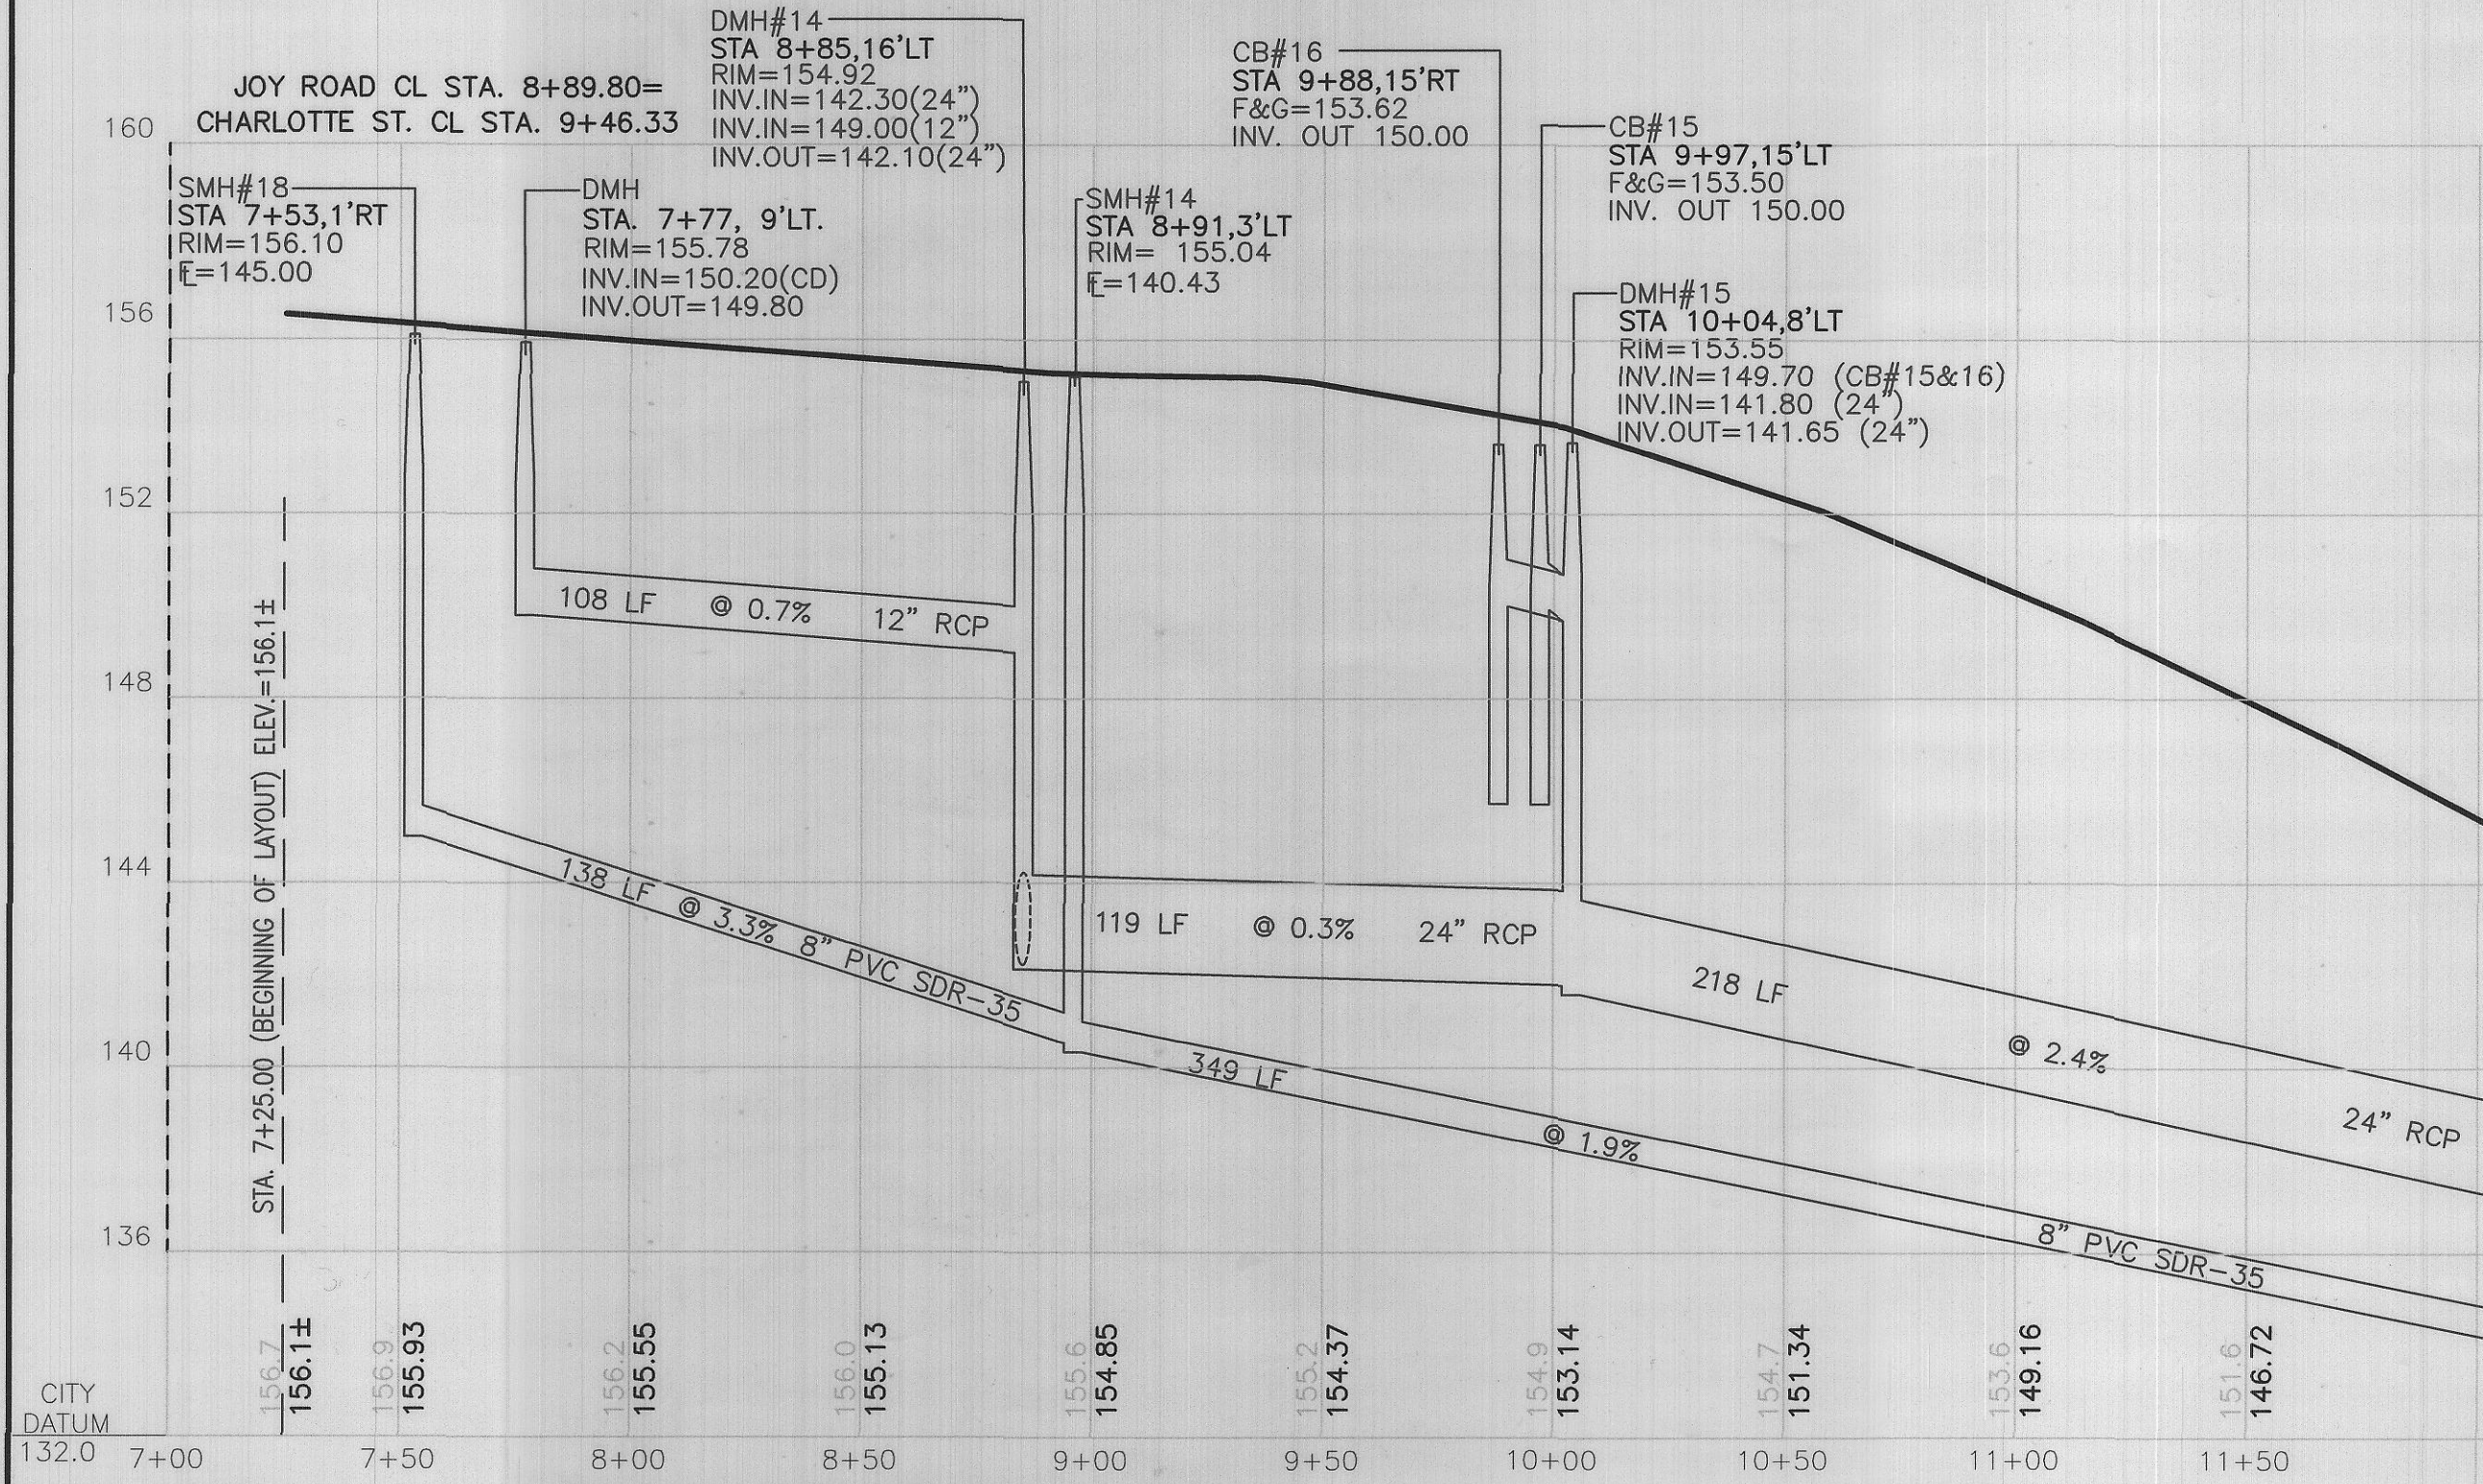

DRAIN LOCATION STATIONS	LOT NUMBER	SERVICES STREET SIDELINES
(DMH 7+77)	121-158	56'±R
(DMH 7+77)	121-159	45'±L
8+39	121-157	33'R±
8+44	121-160	17'±L
9+06	121-156	36'R±
9+49	121-176	18'±L
9+83	121-155	34'R±
10+63	121-154	34'R±
10+80	121-177	17'±L
11+30	121-153	34'R±
11+85	121-152	34'R±
13+01	121-183	27'±L
13+08	121-151	34'R±
13+88	121-150	33'R±
13+94	121-184	17'±L
14+58	121-149	34'R±