




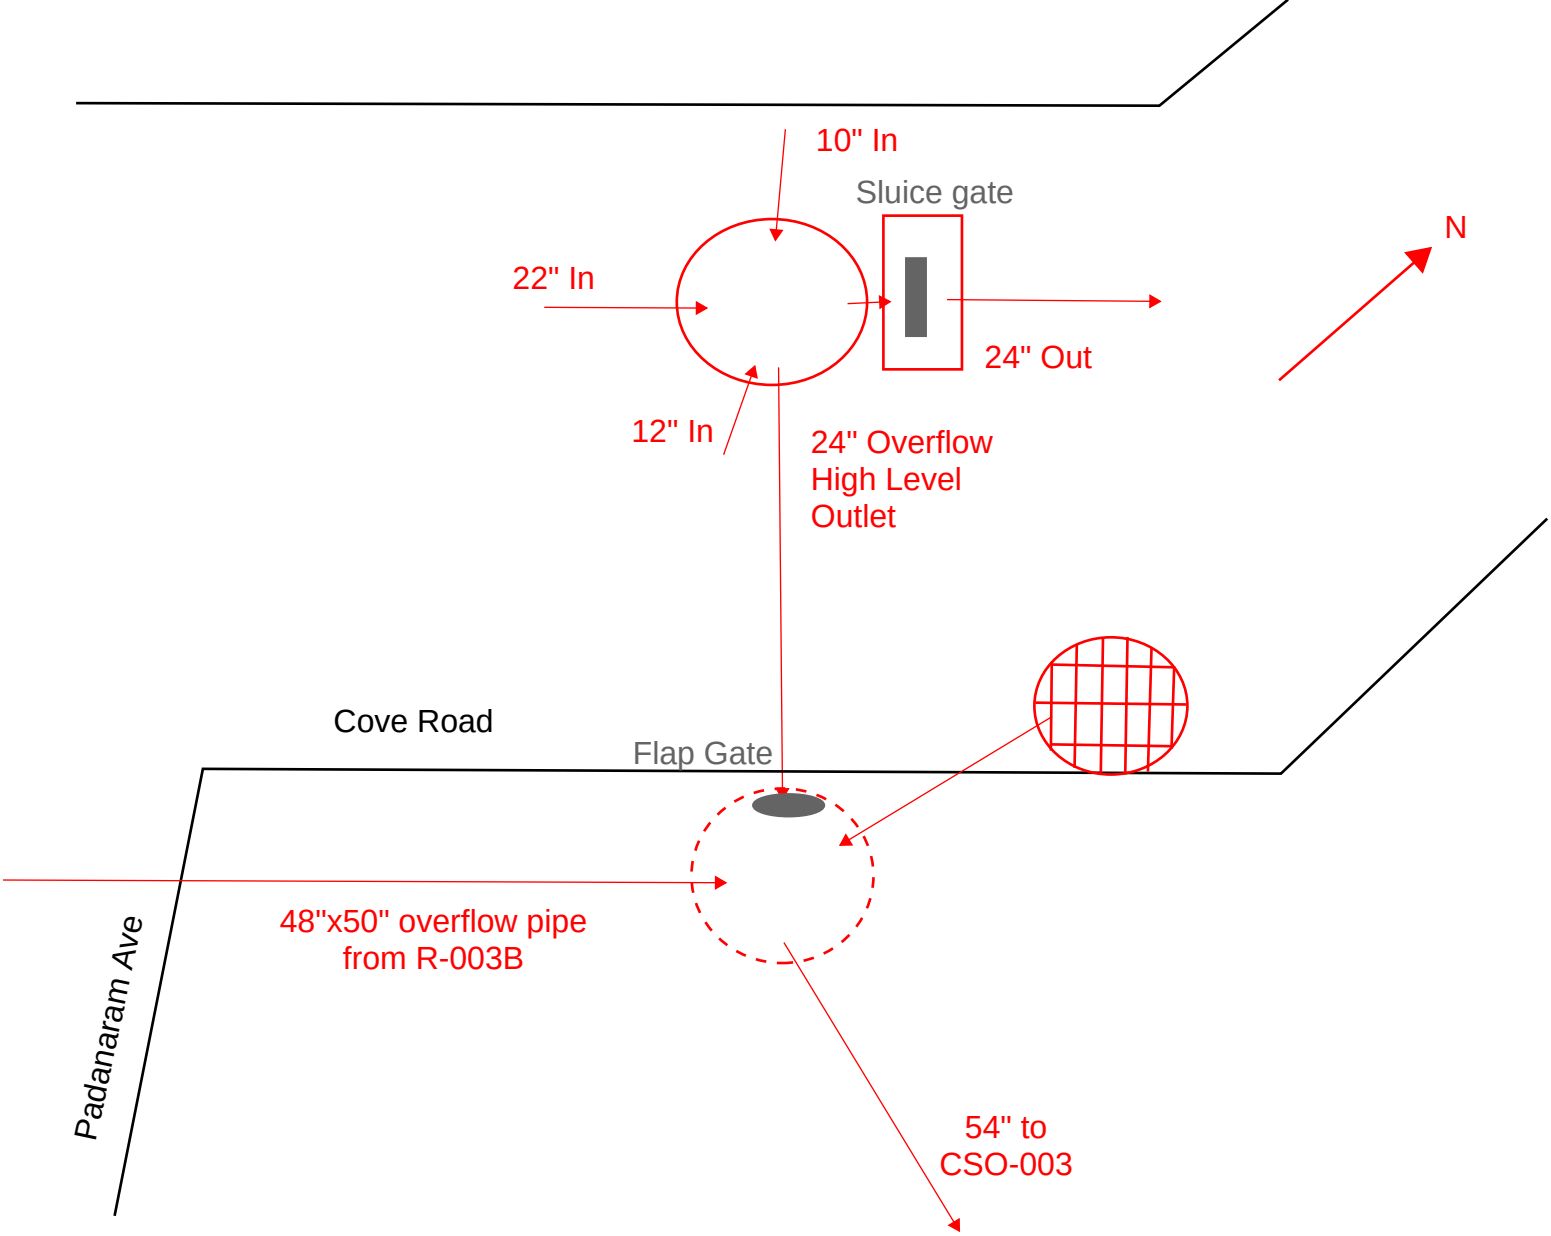


R-003A

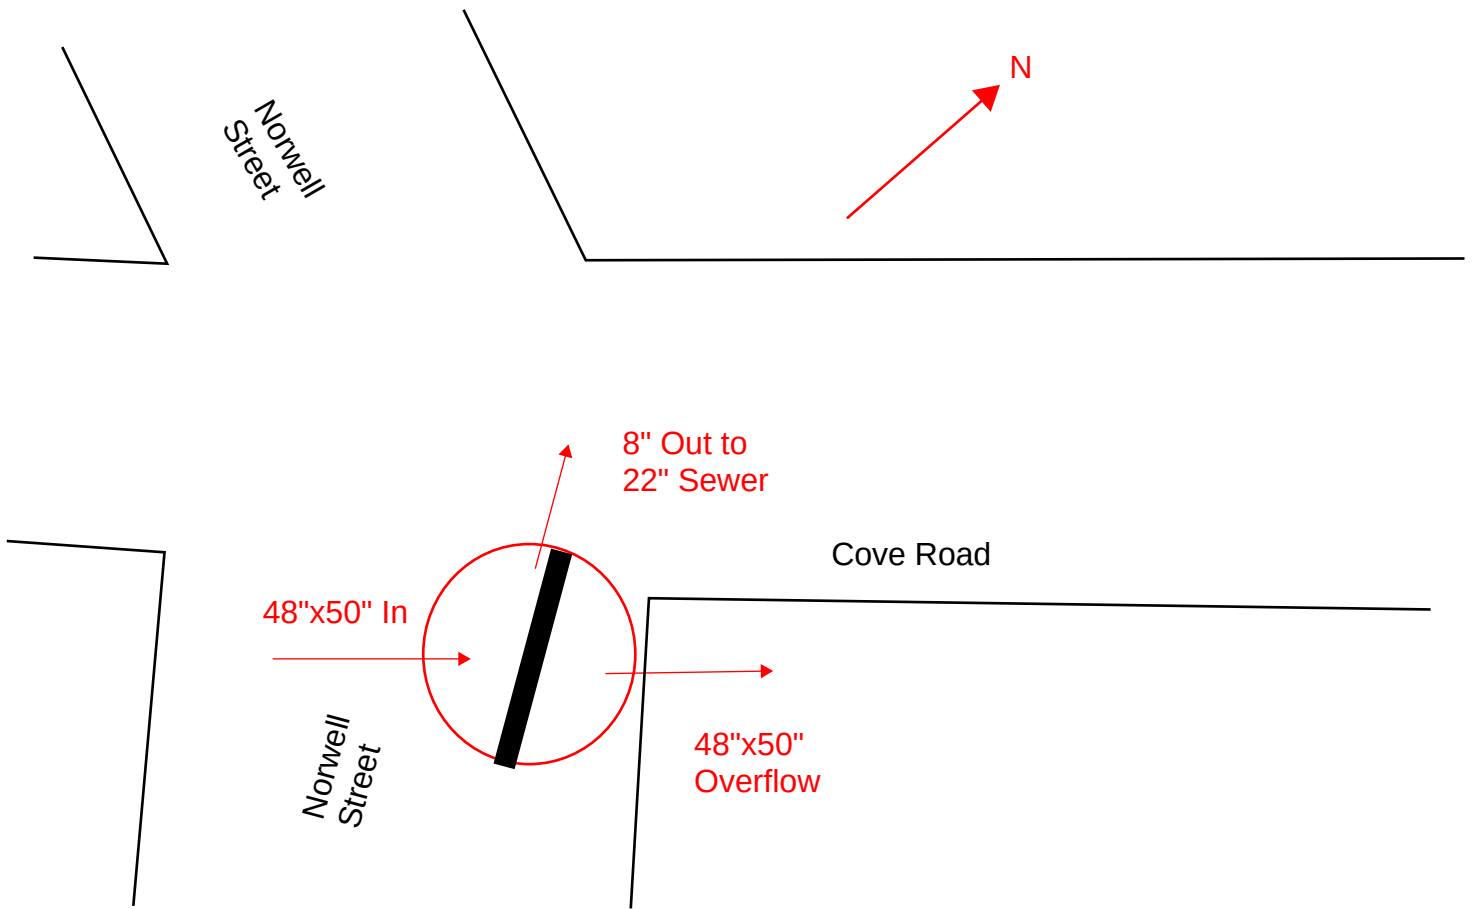


R-003B

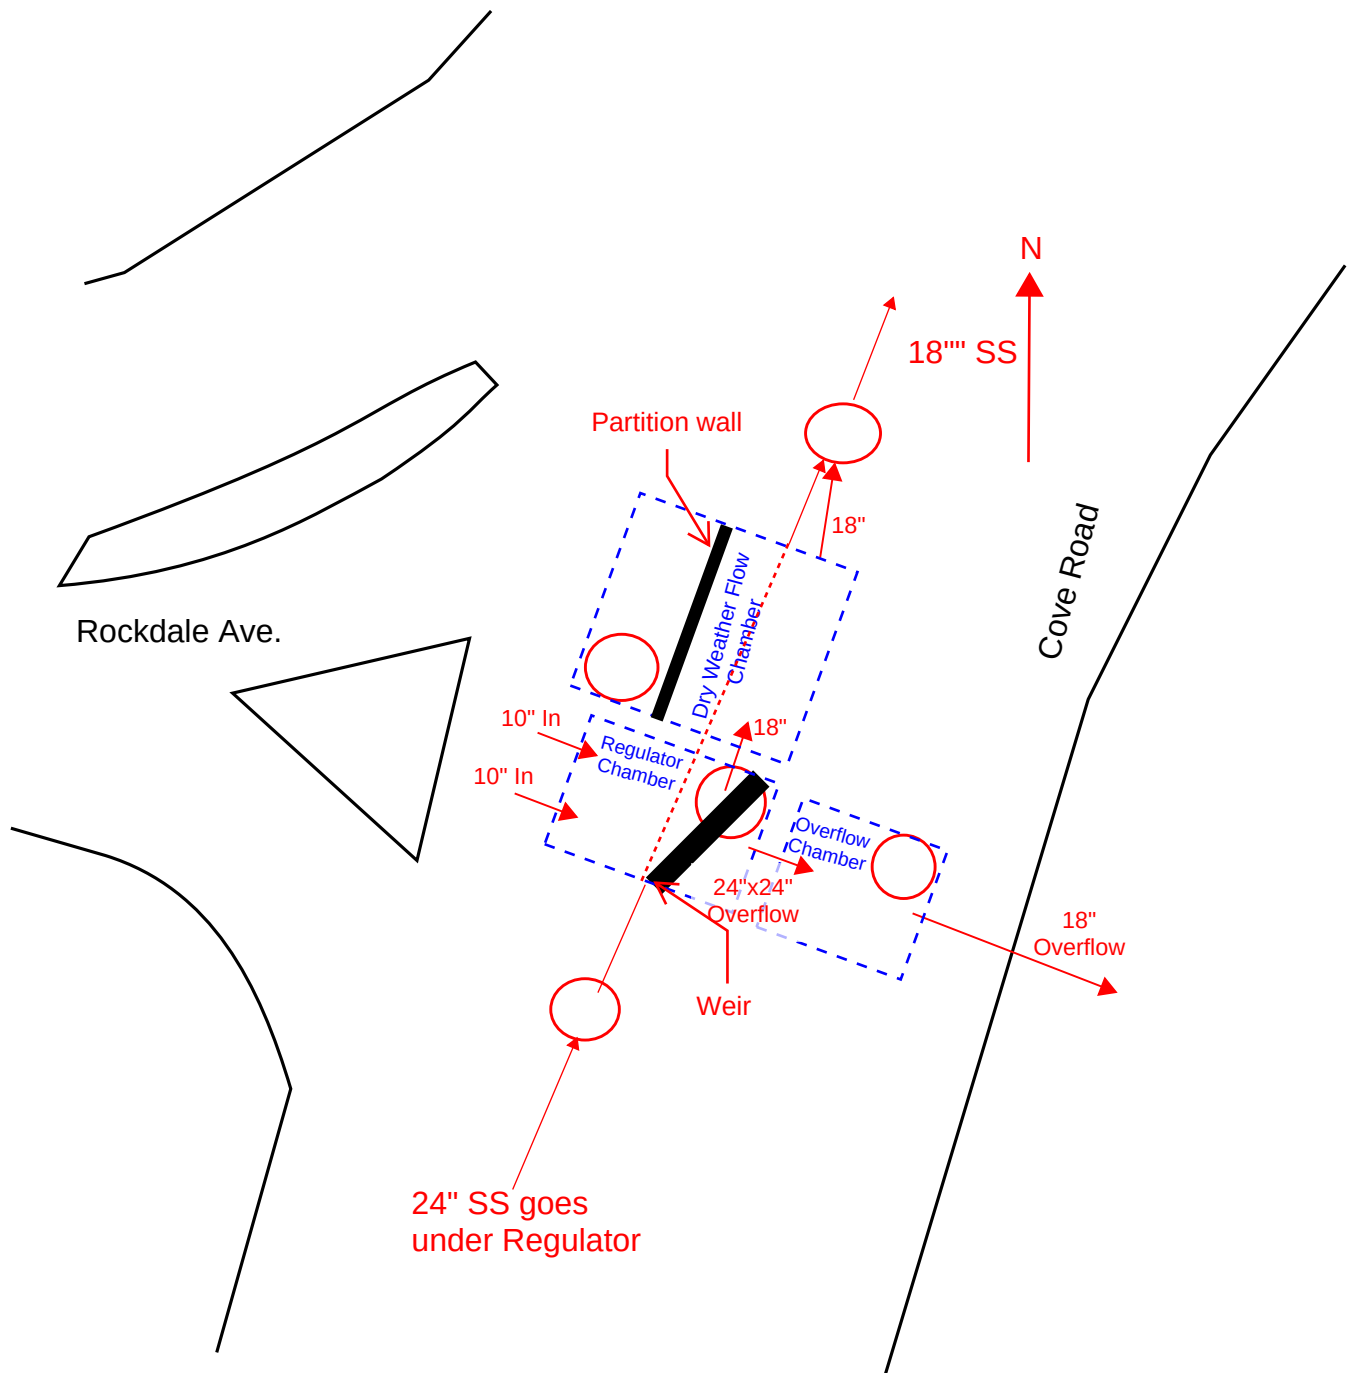


R-004A

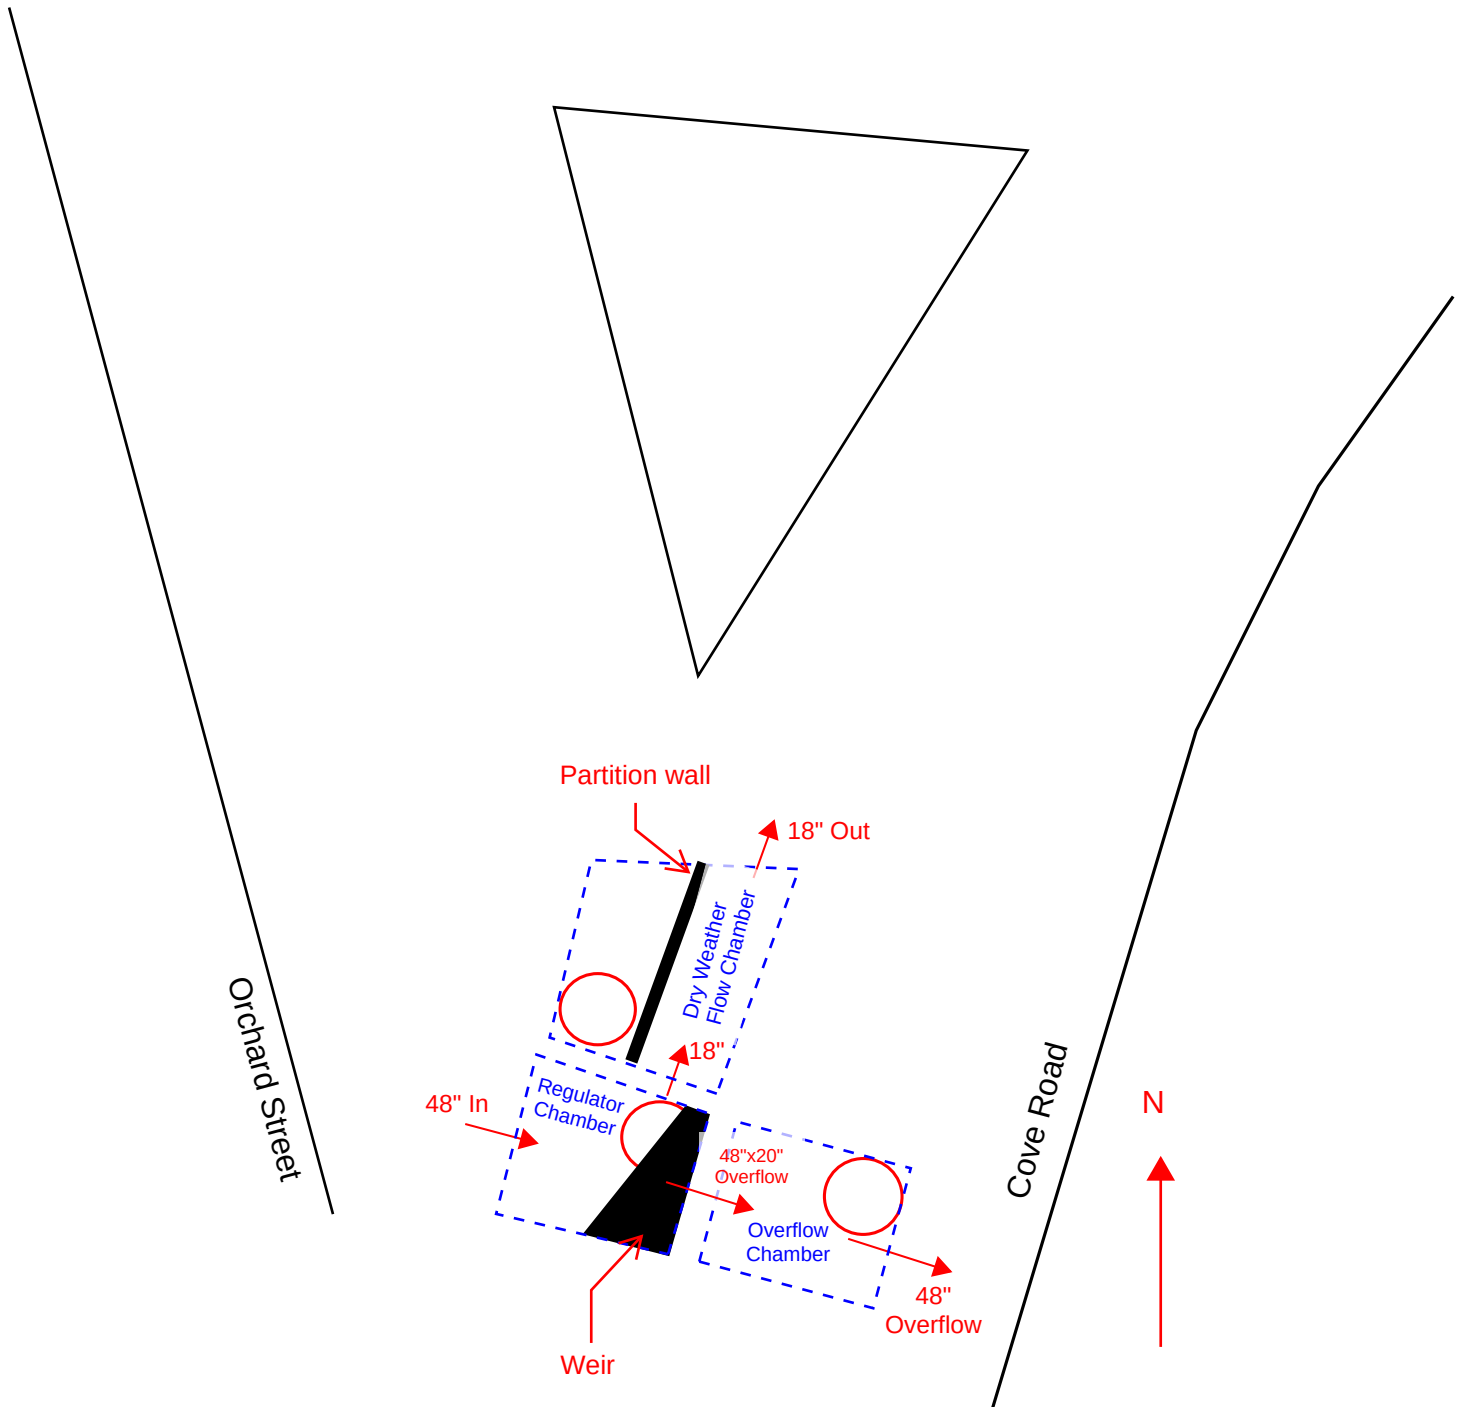


R-004B

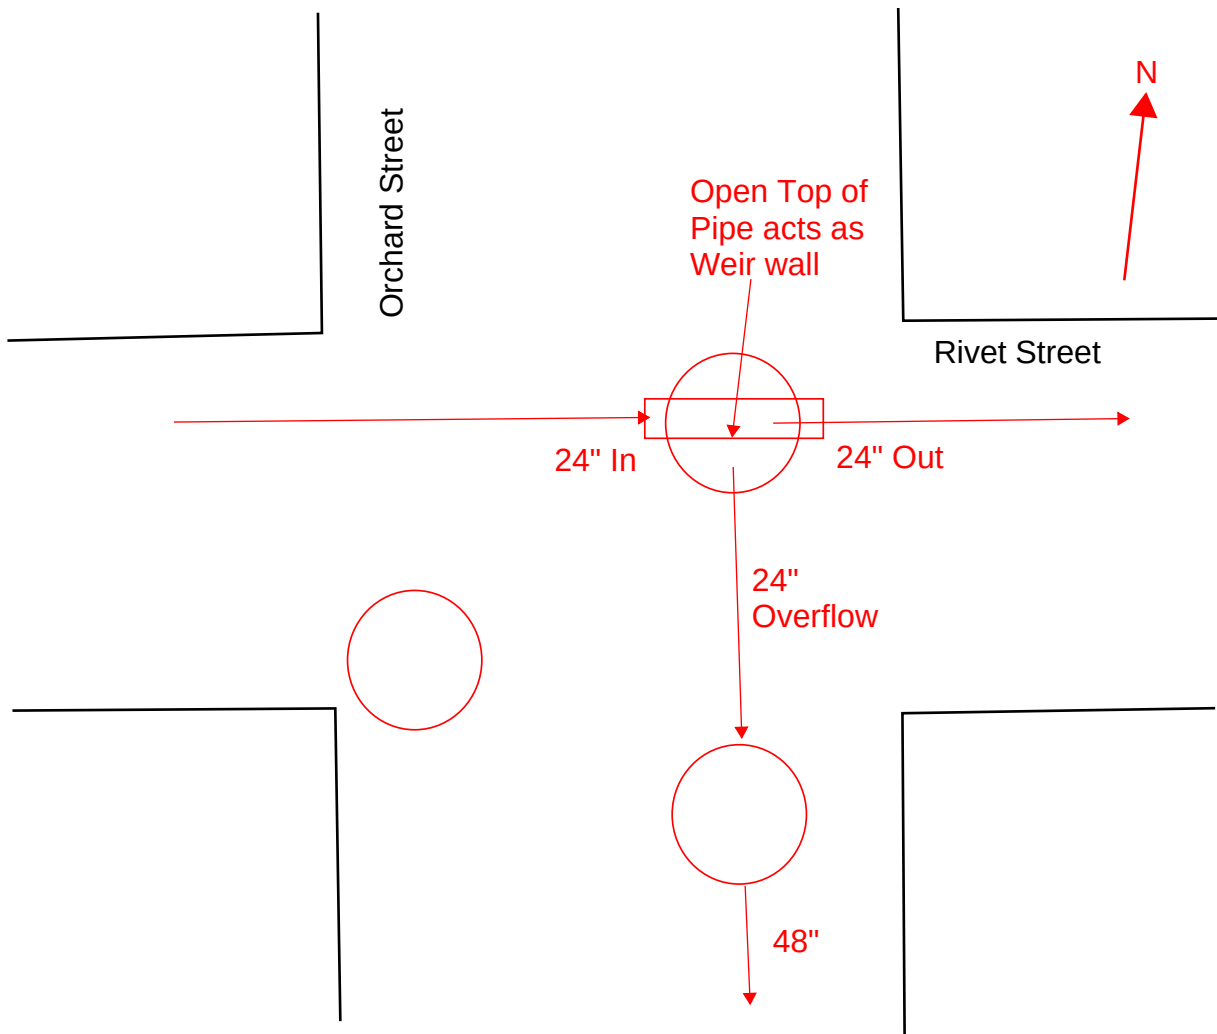


R-004D

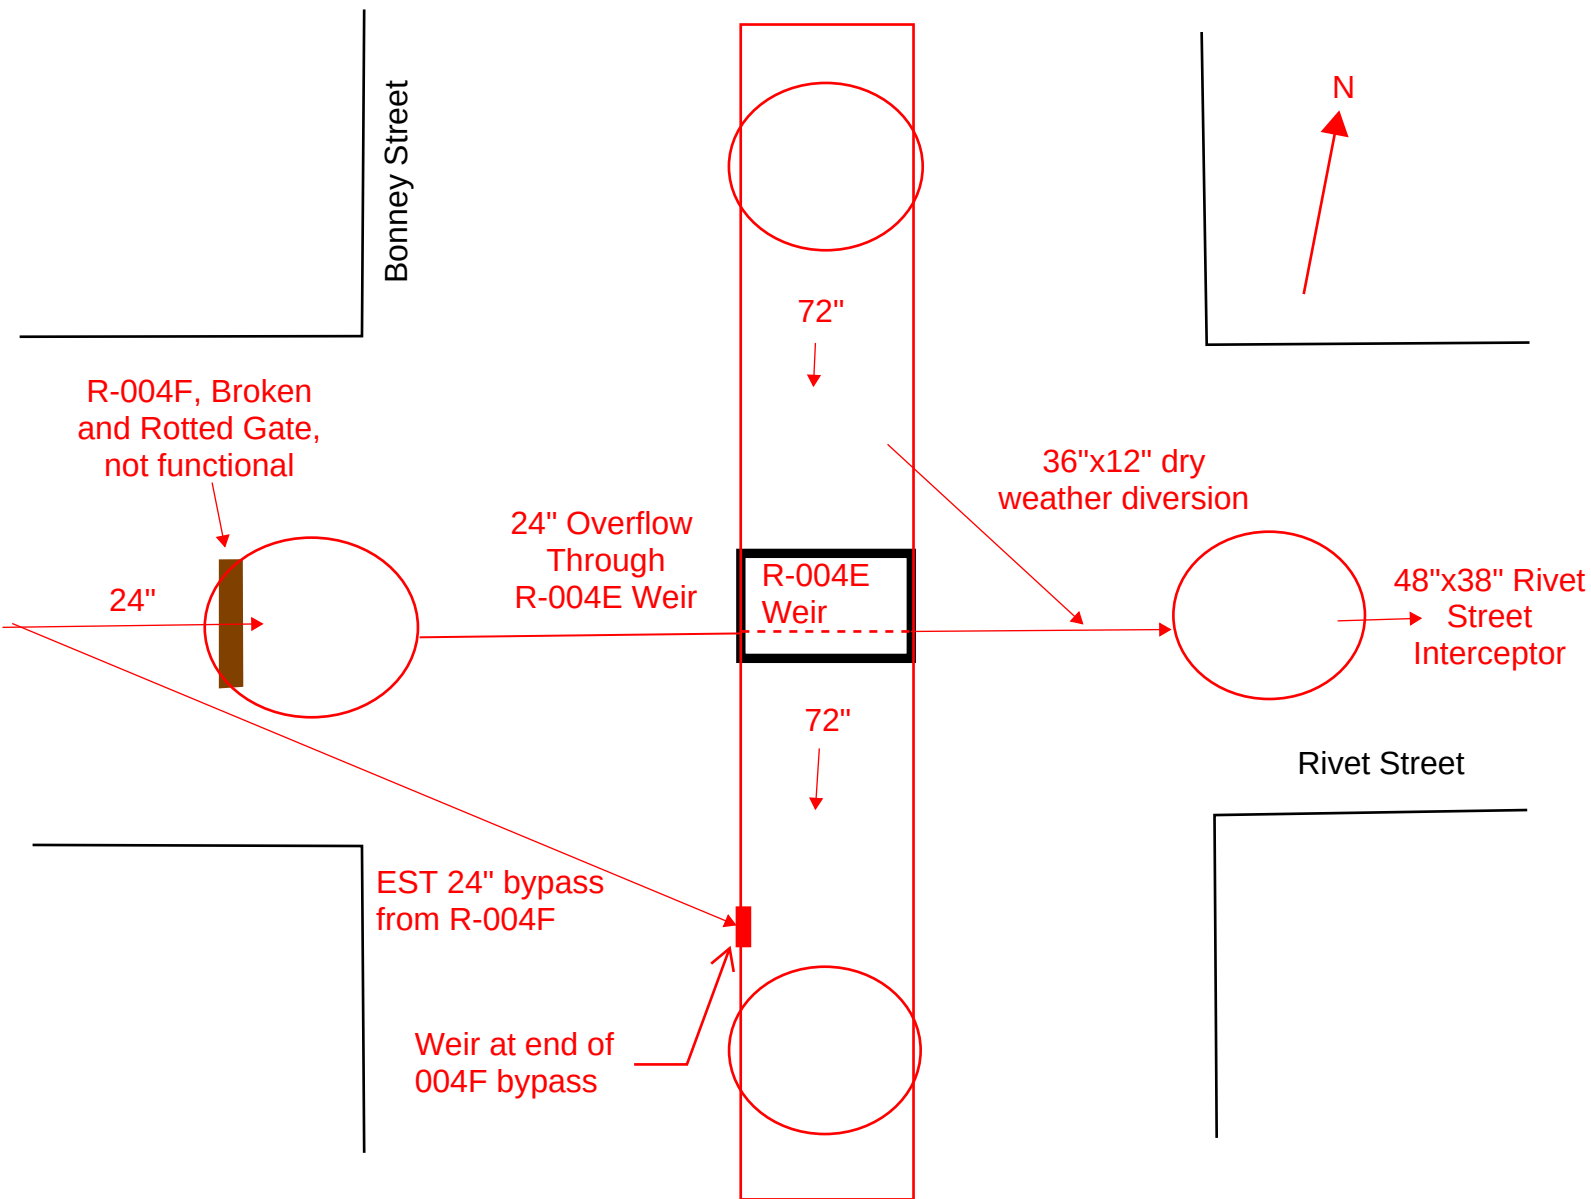


R-004E

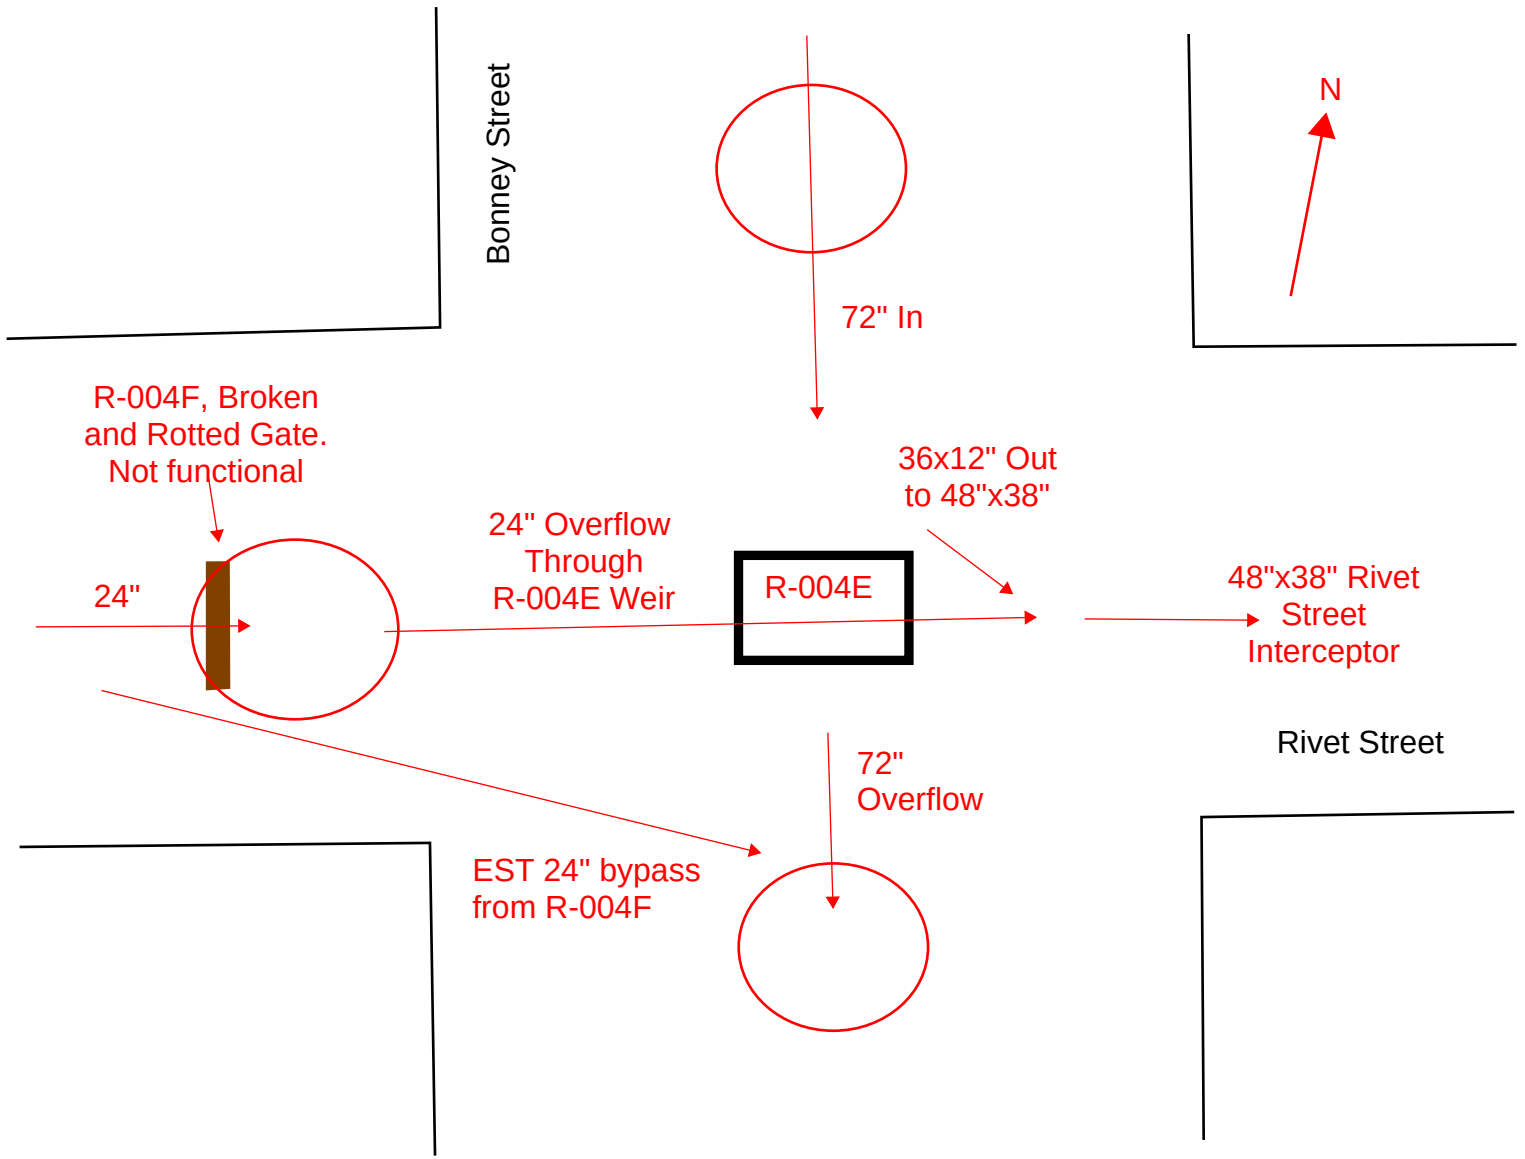


R-004F

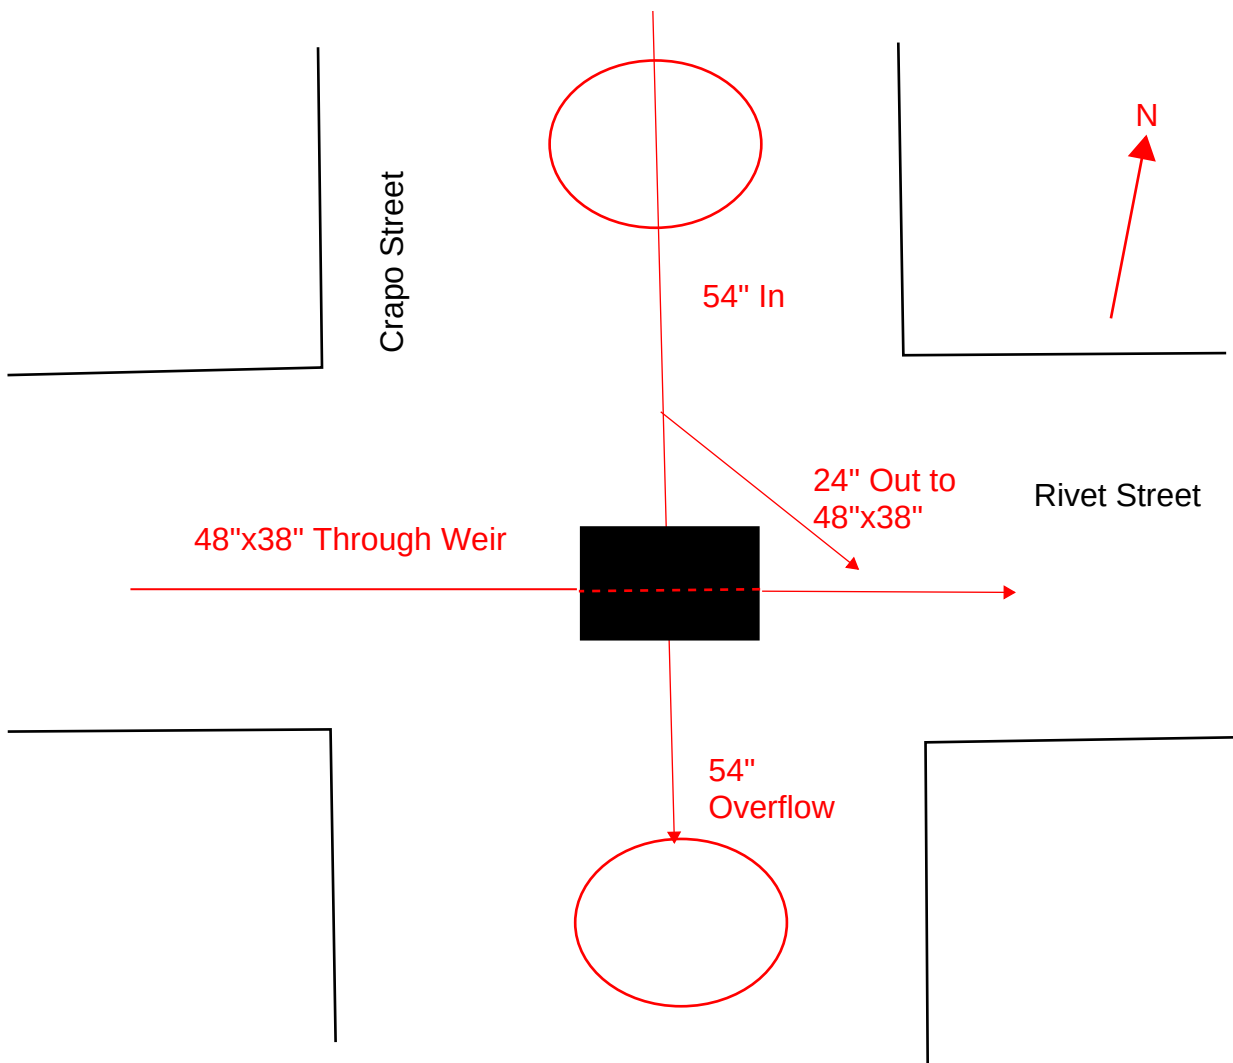

R-004G

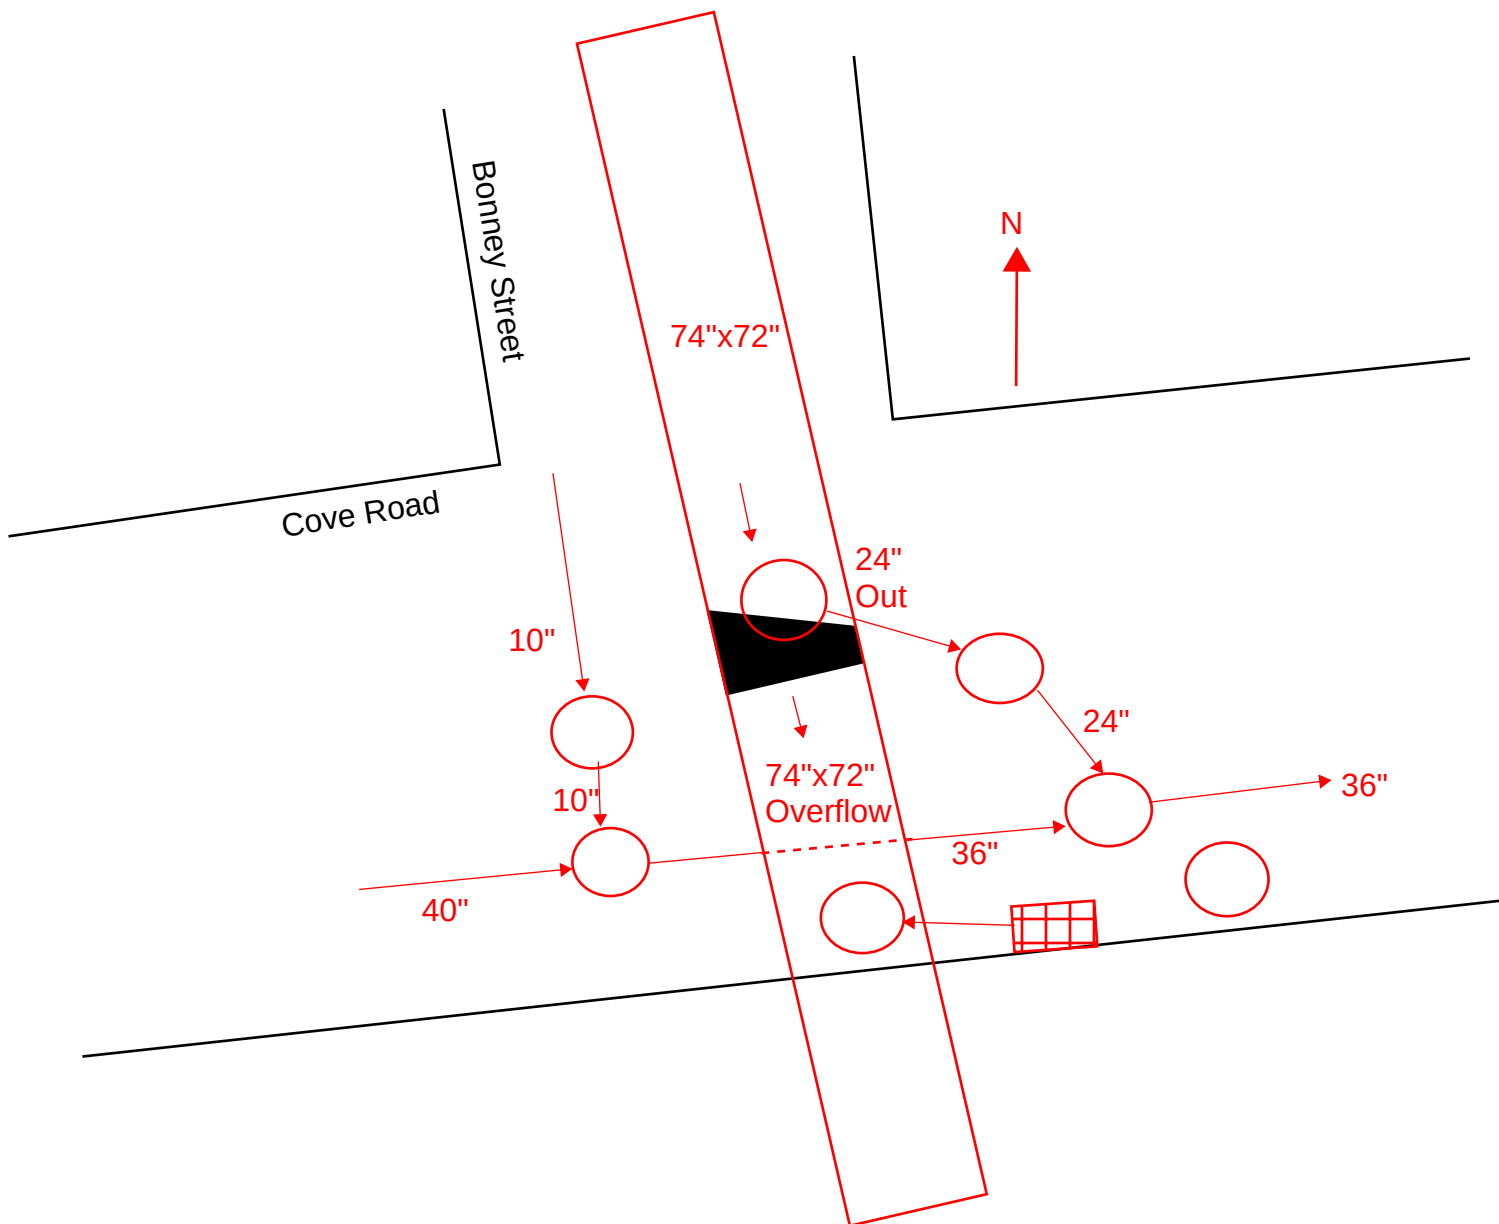


R-004H

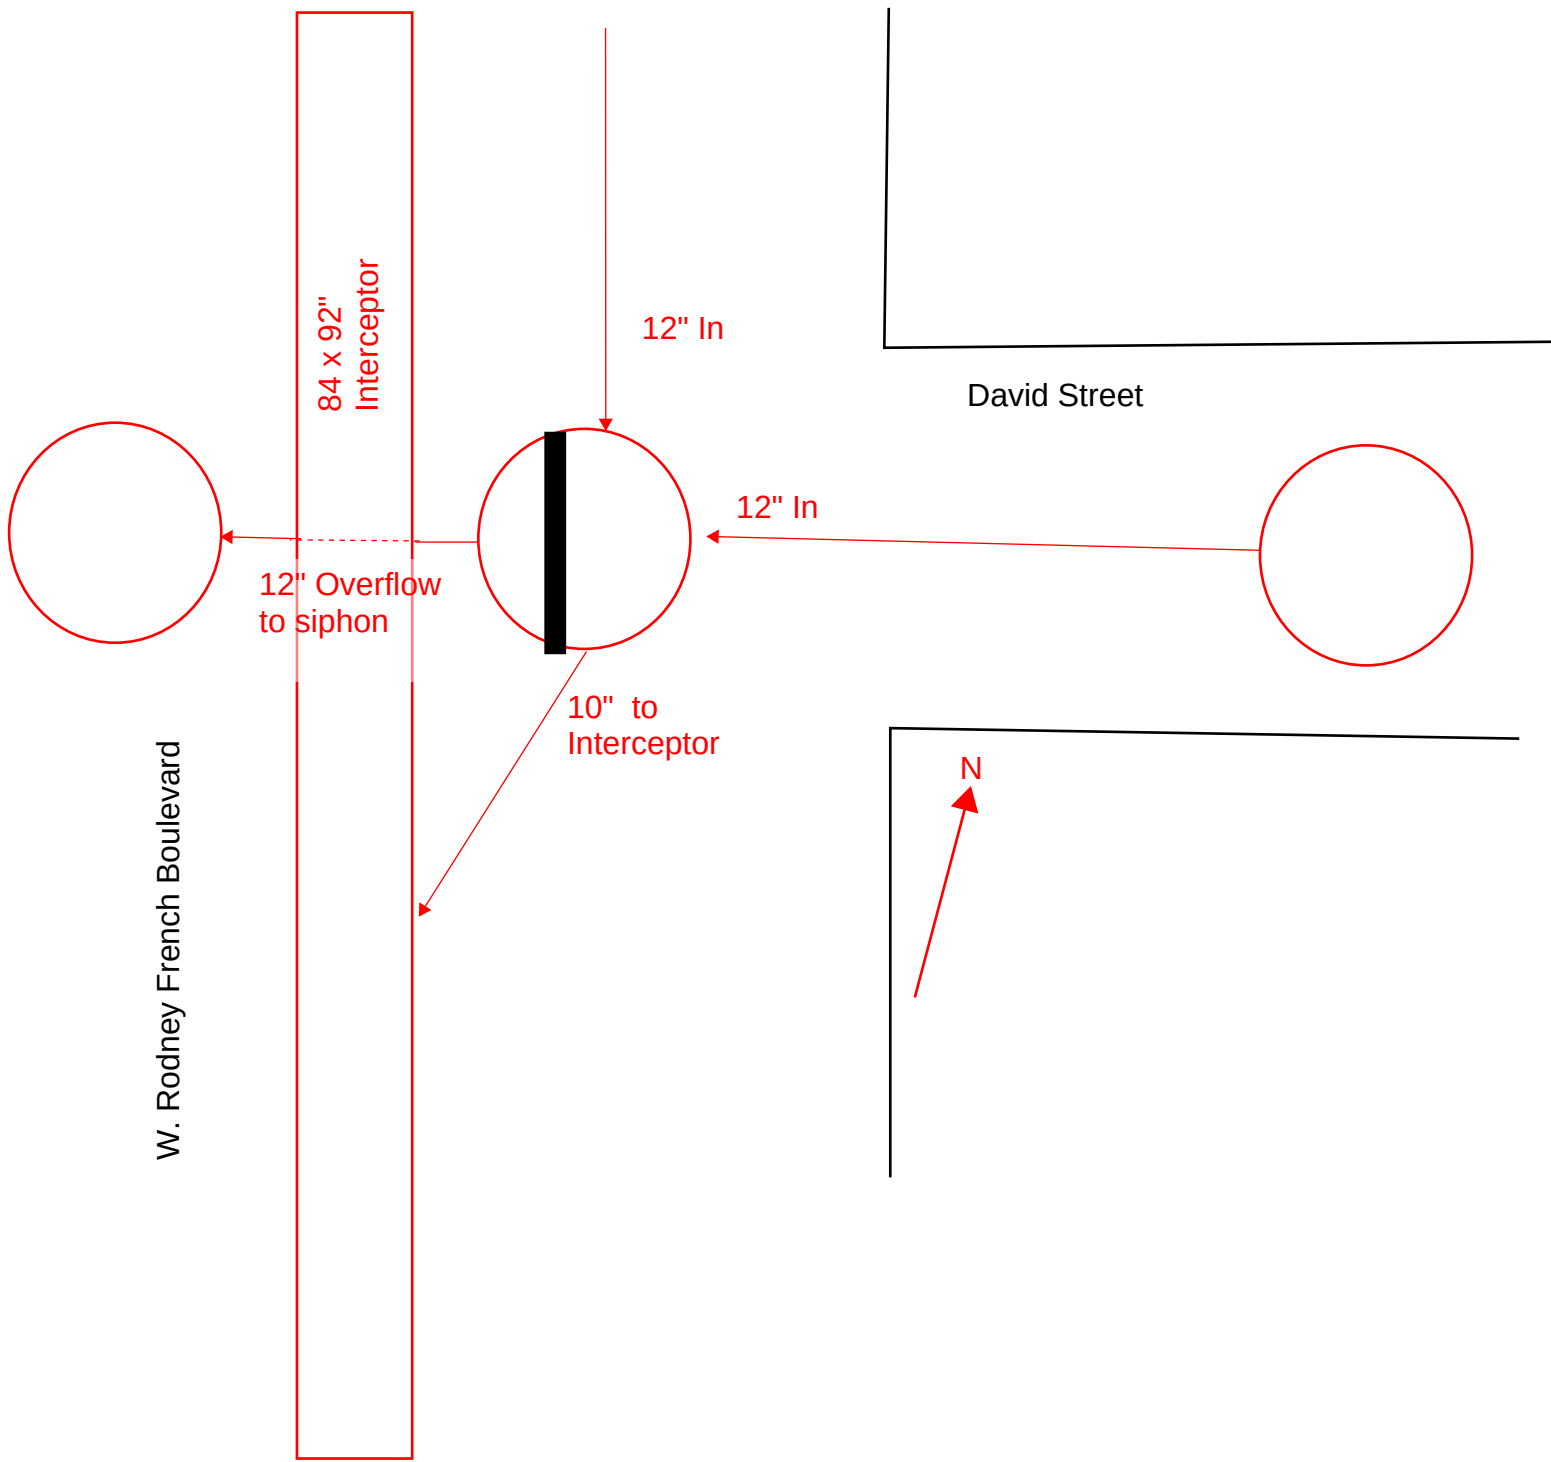


R-004I

W. Rodney French Blvd.

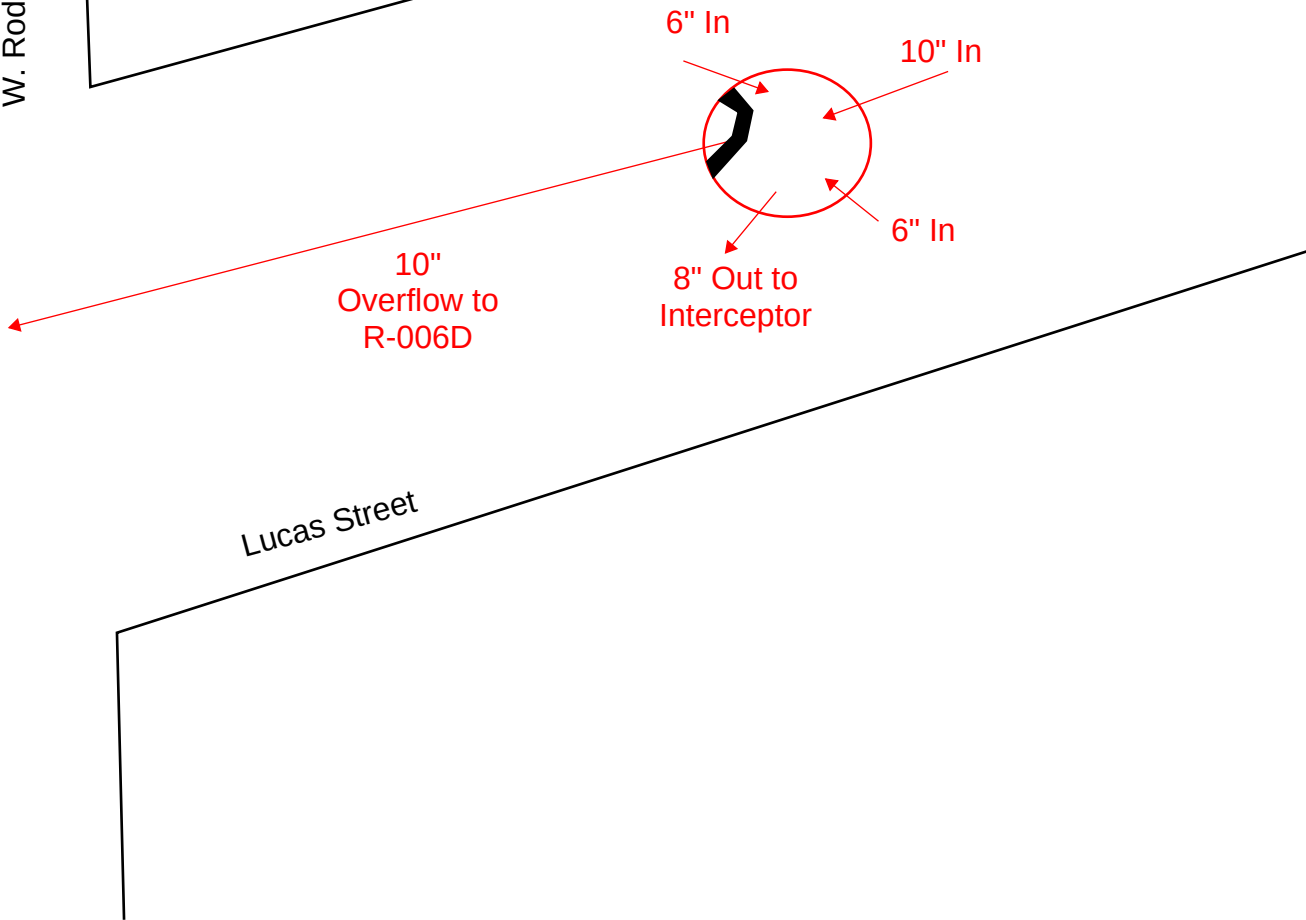


Lucas Street


R-006A

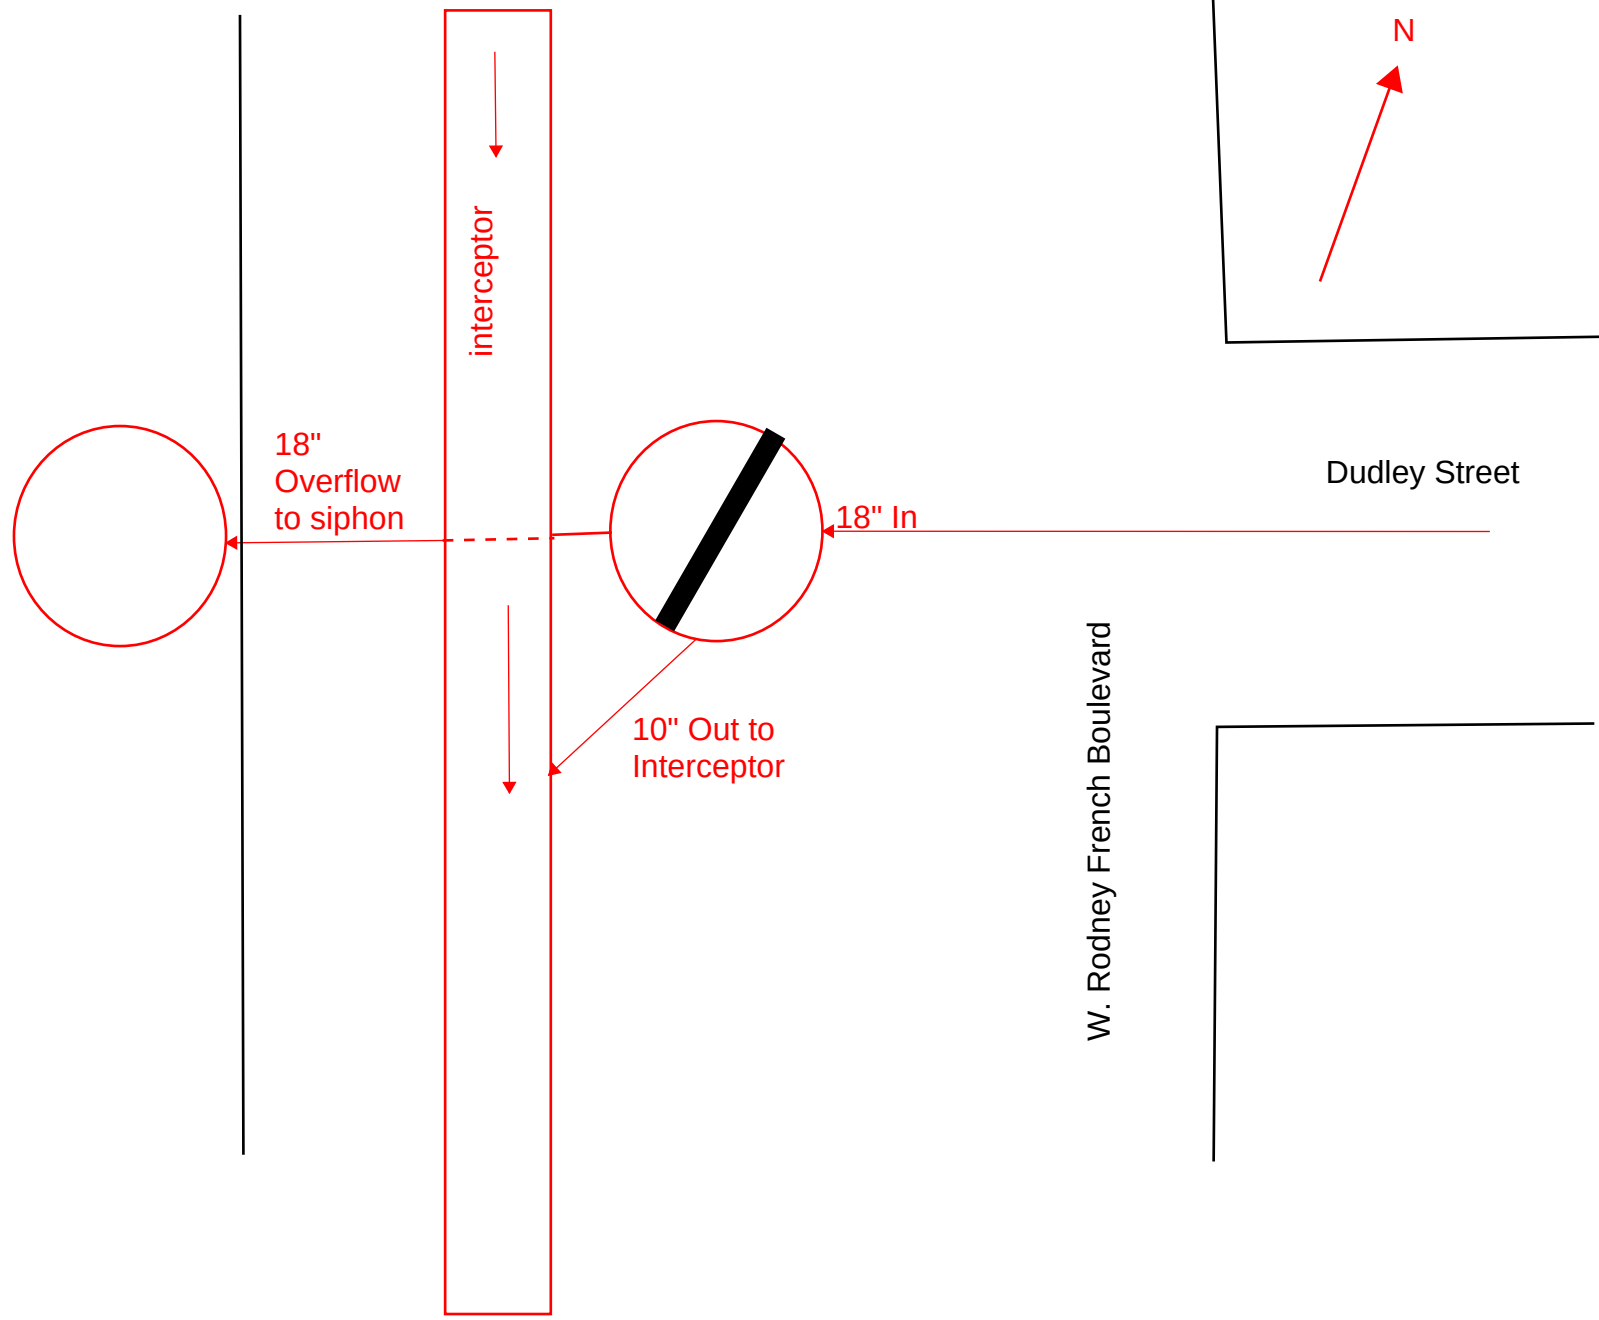


R-005A

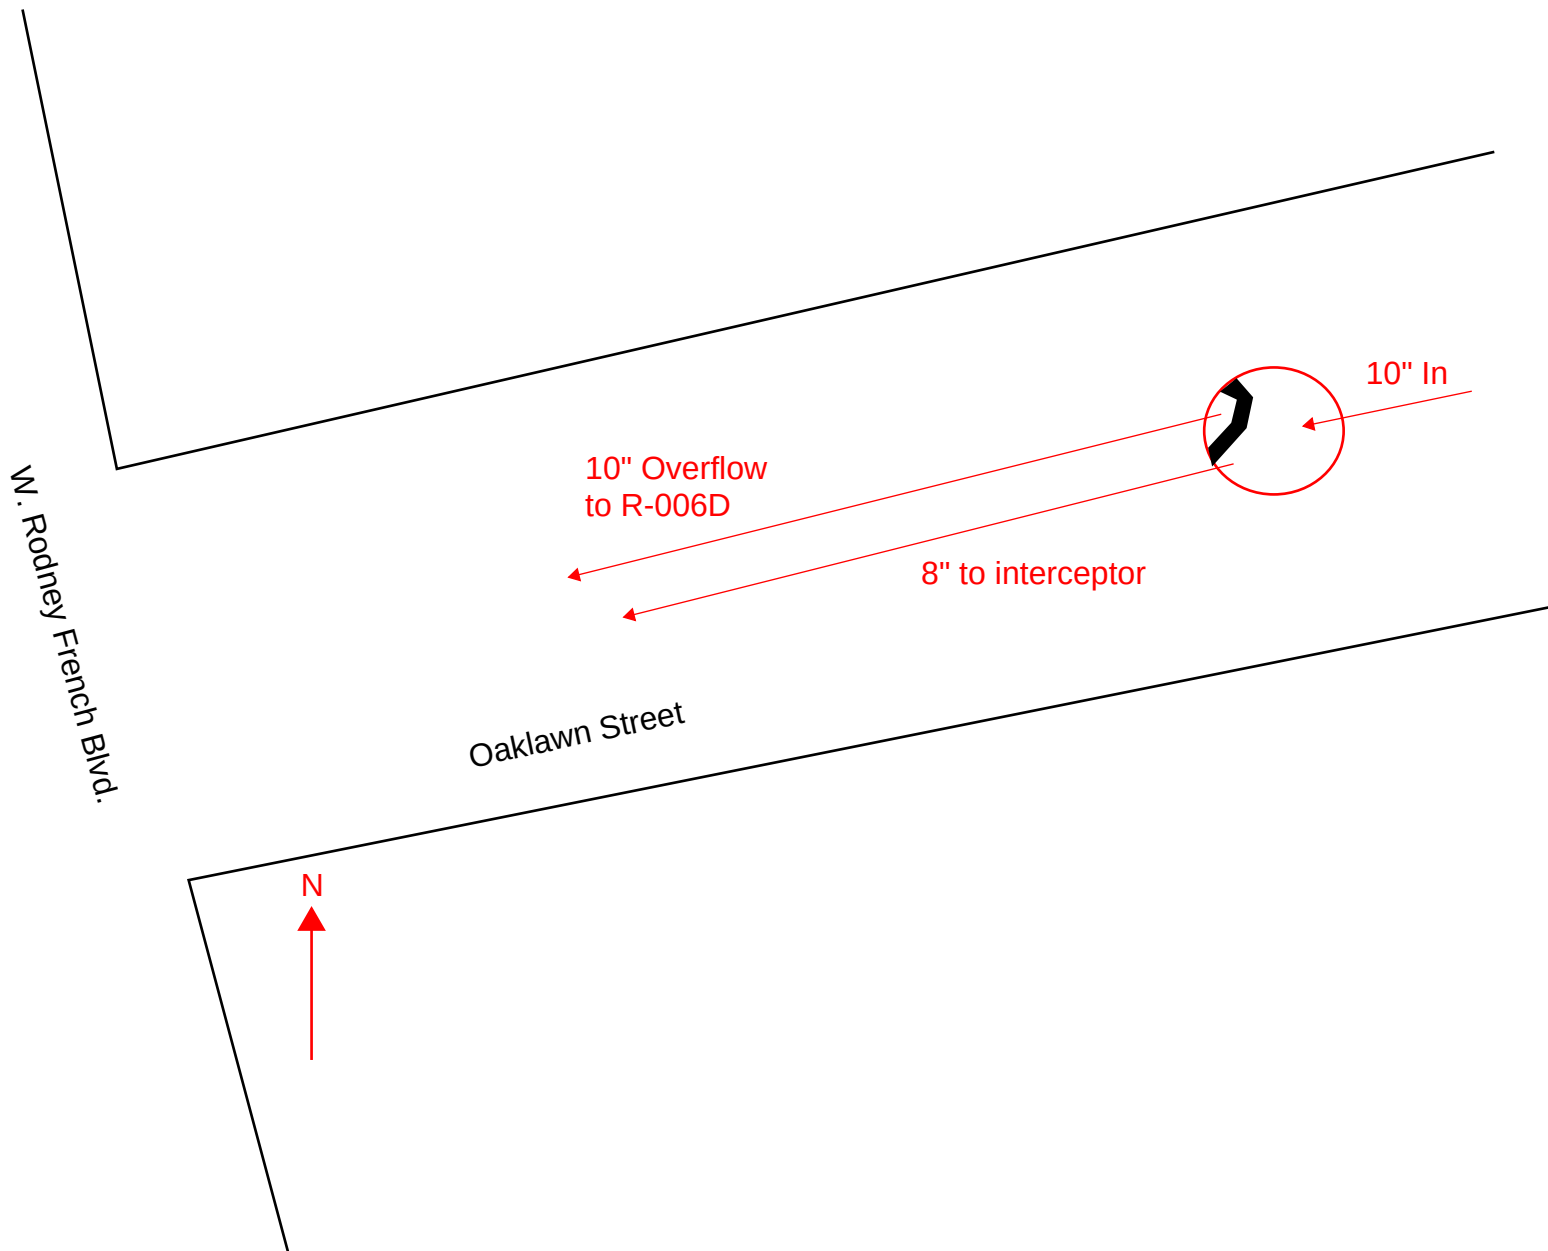


R-006B

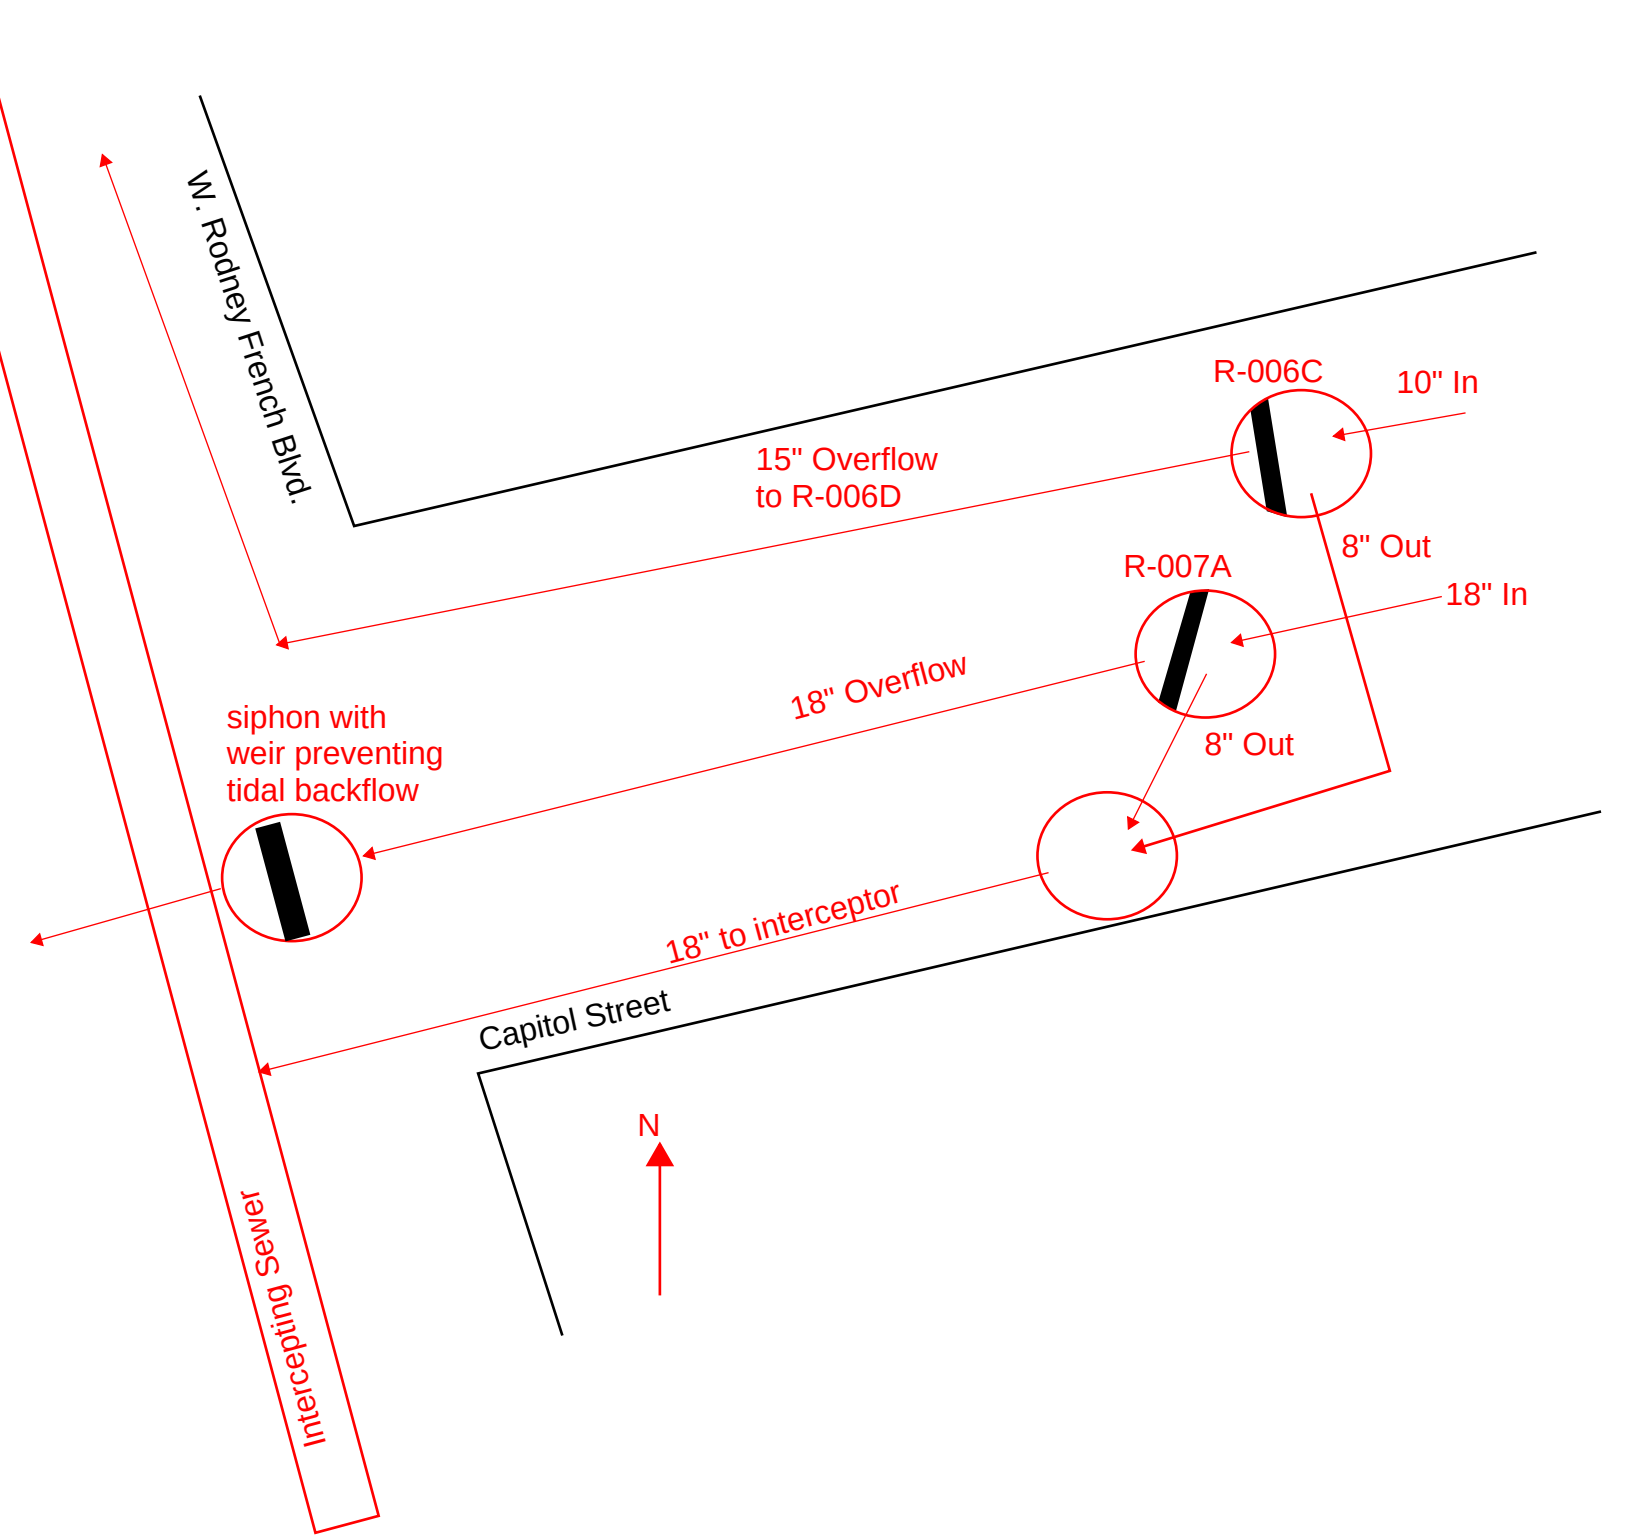



R-006C and
R-007A

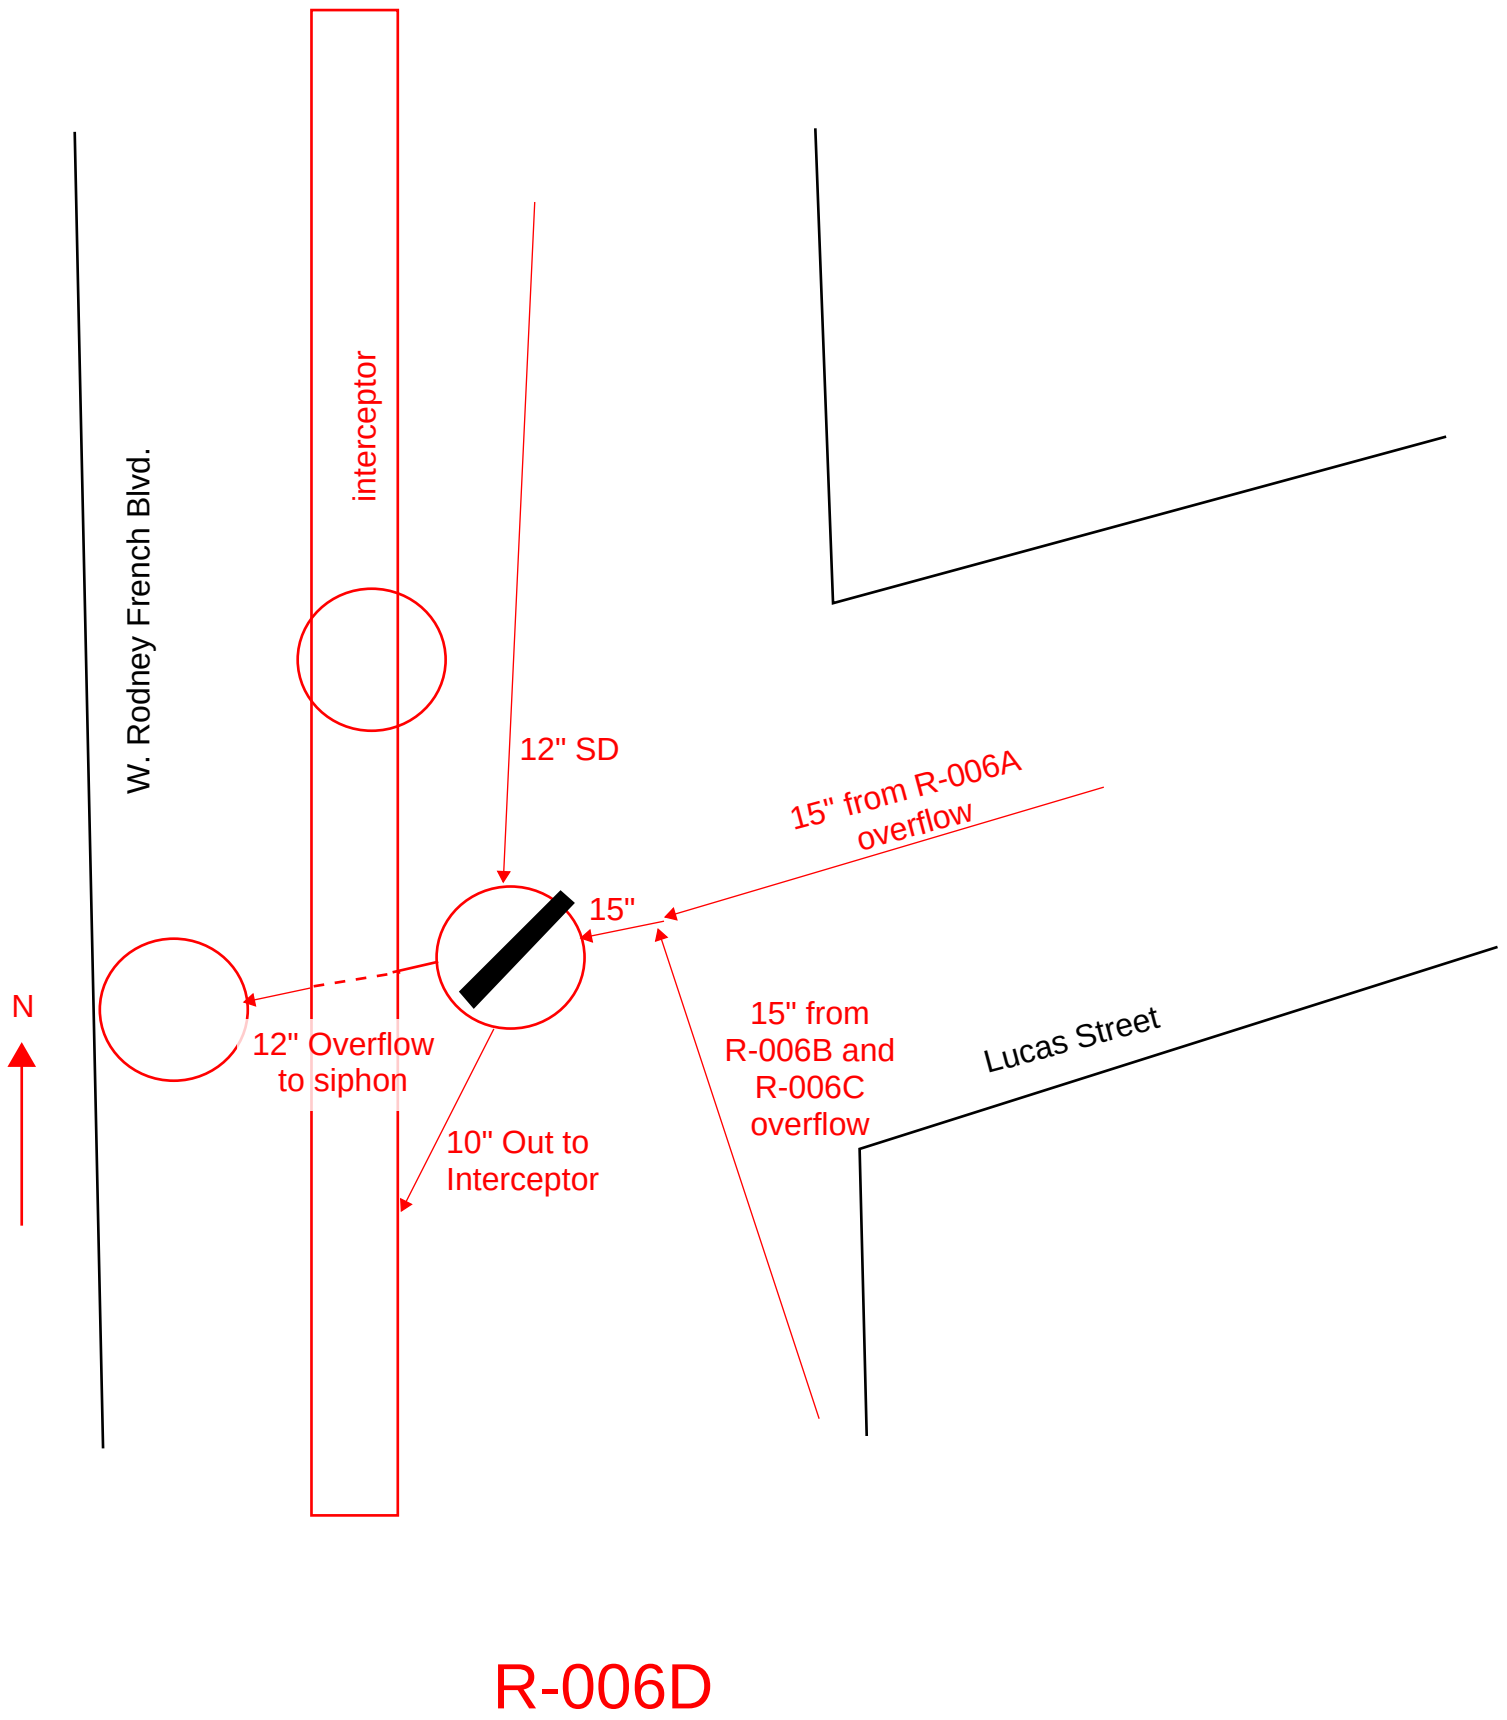

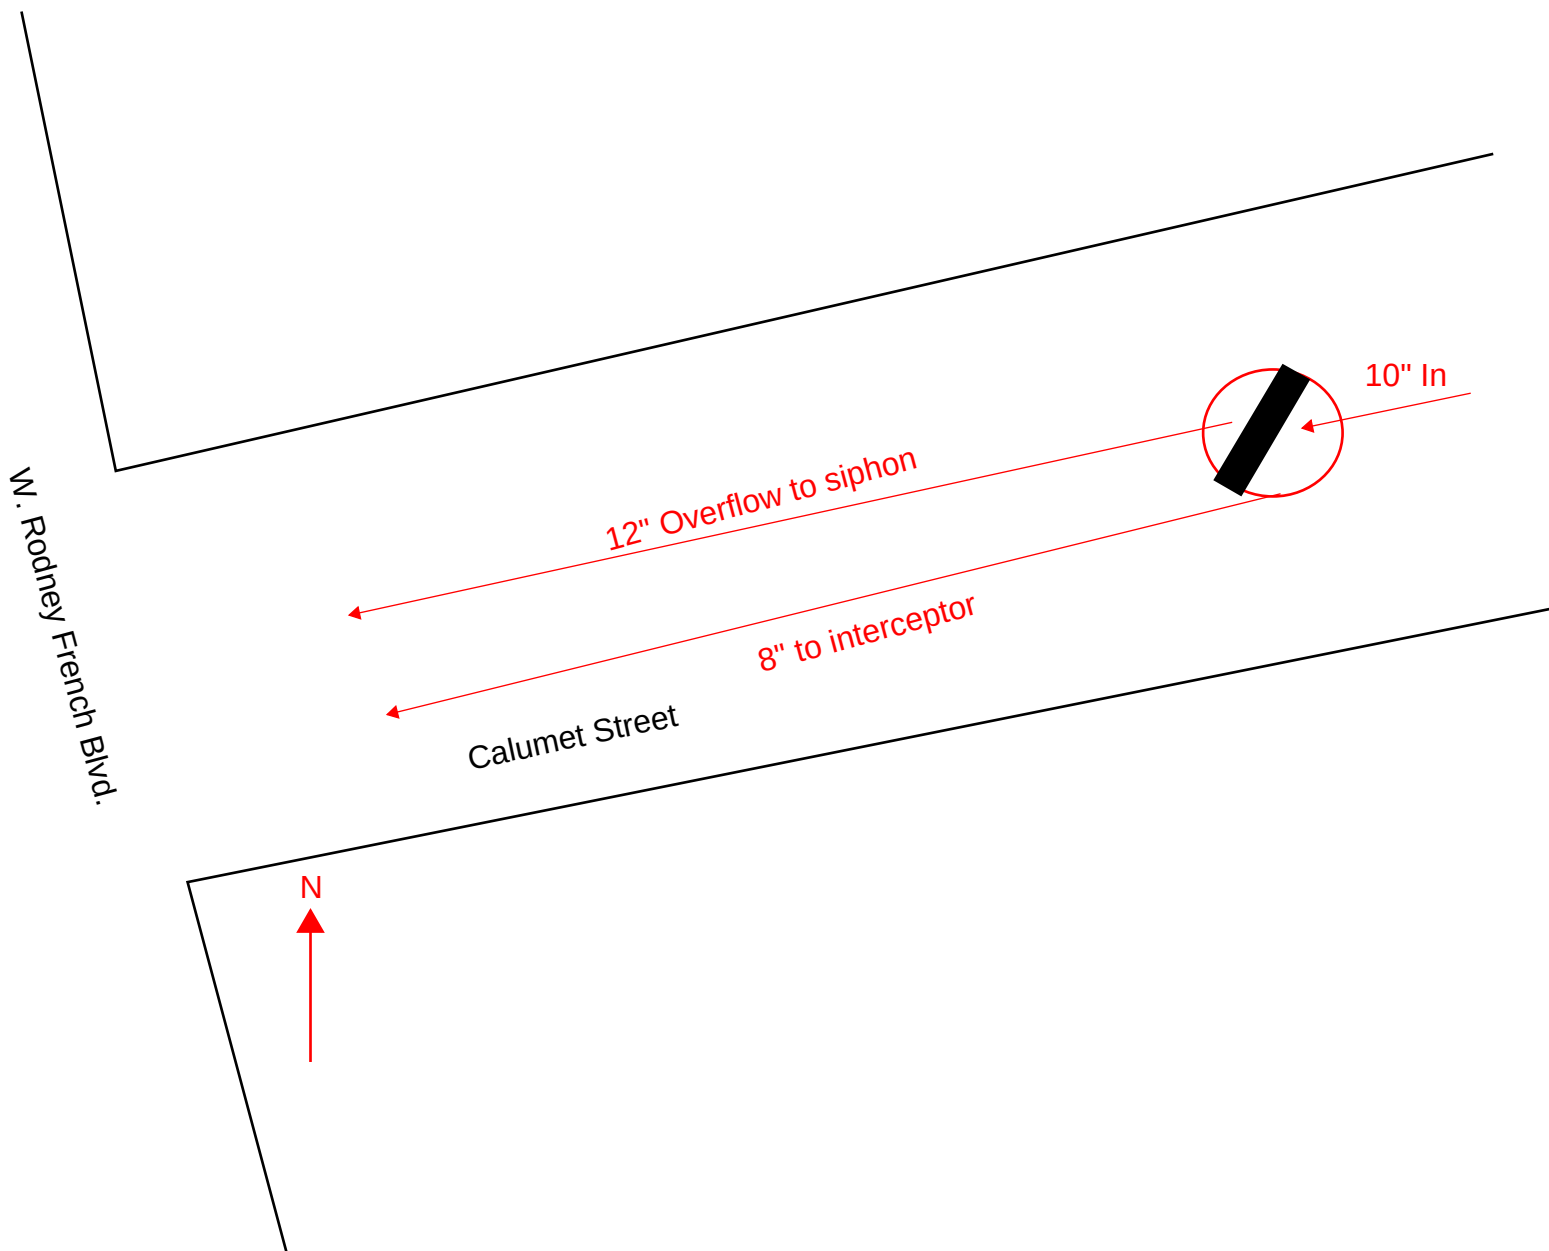

R-008A

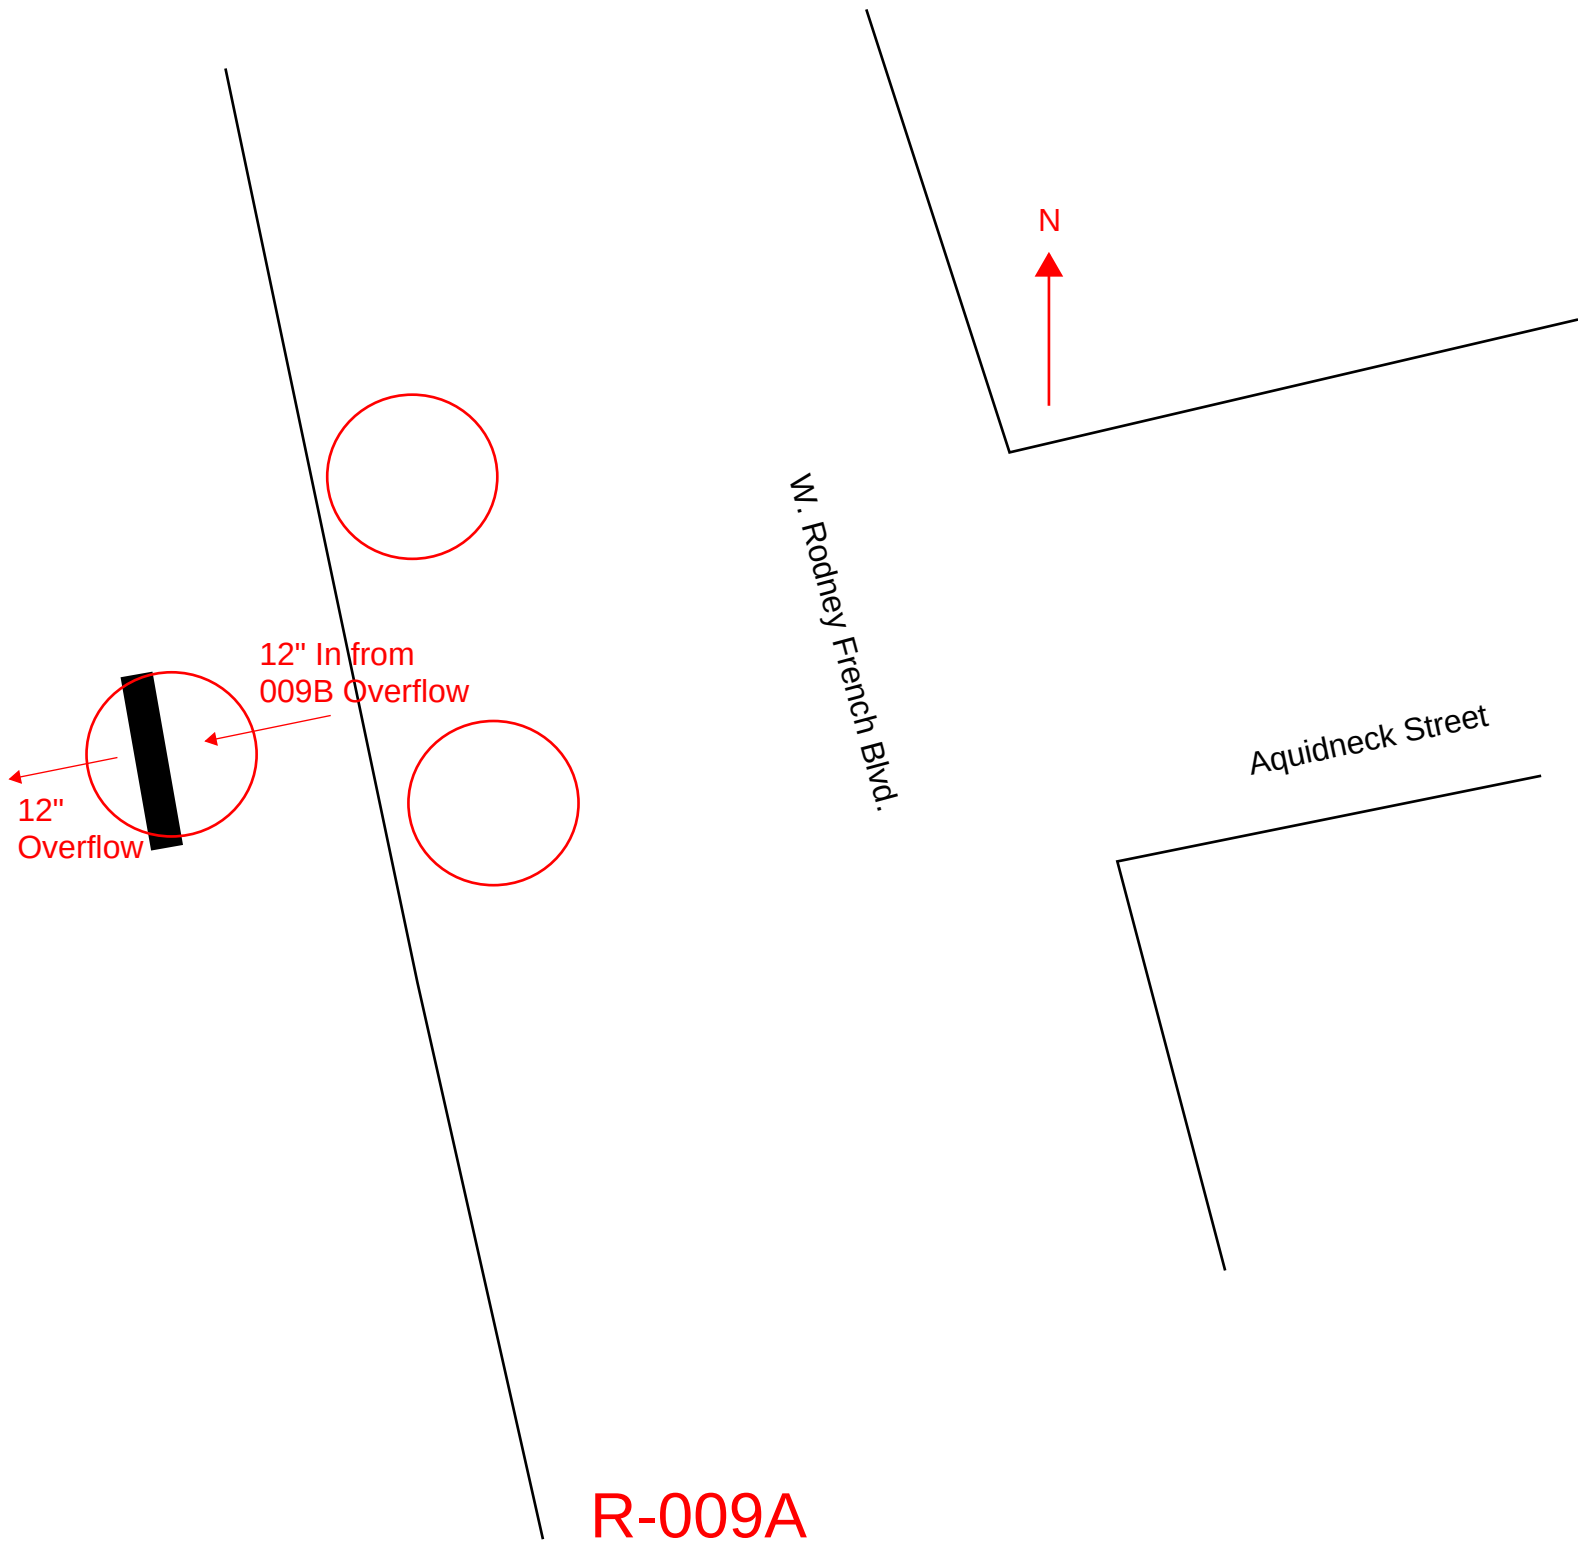

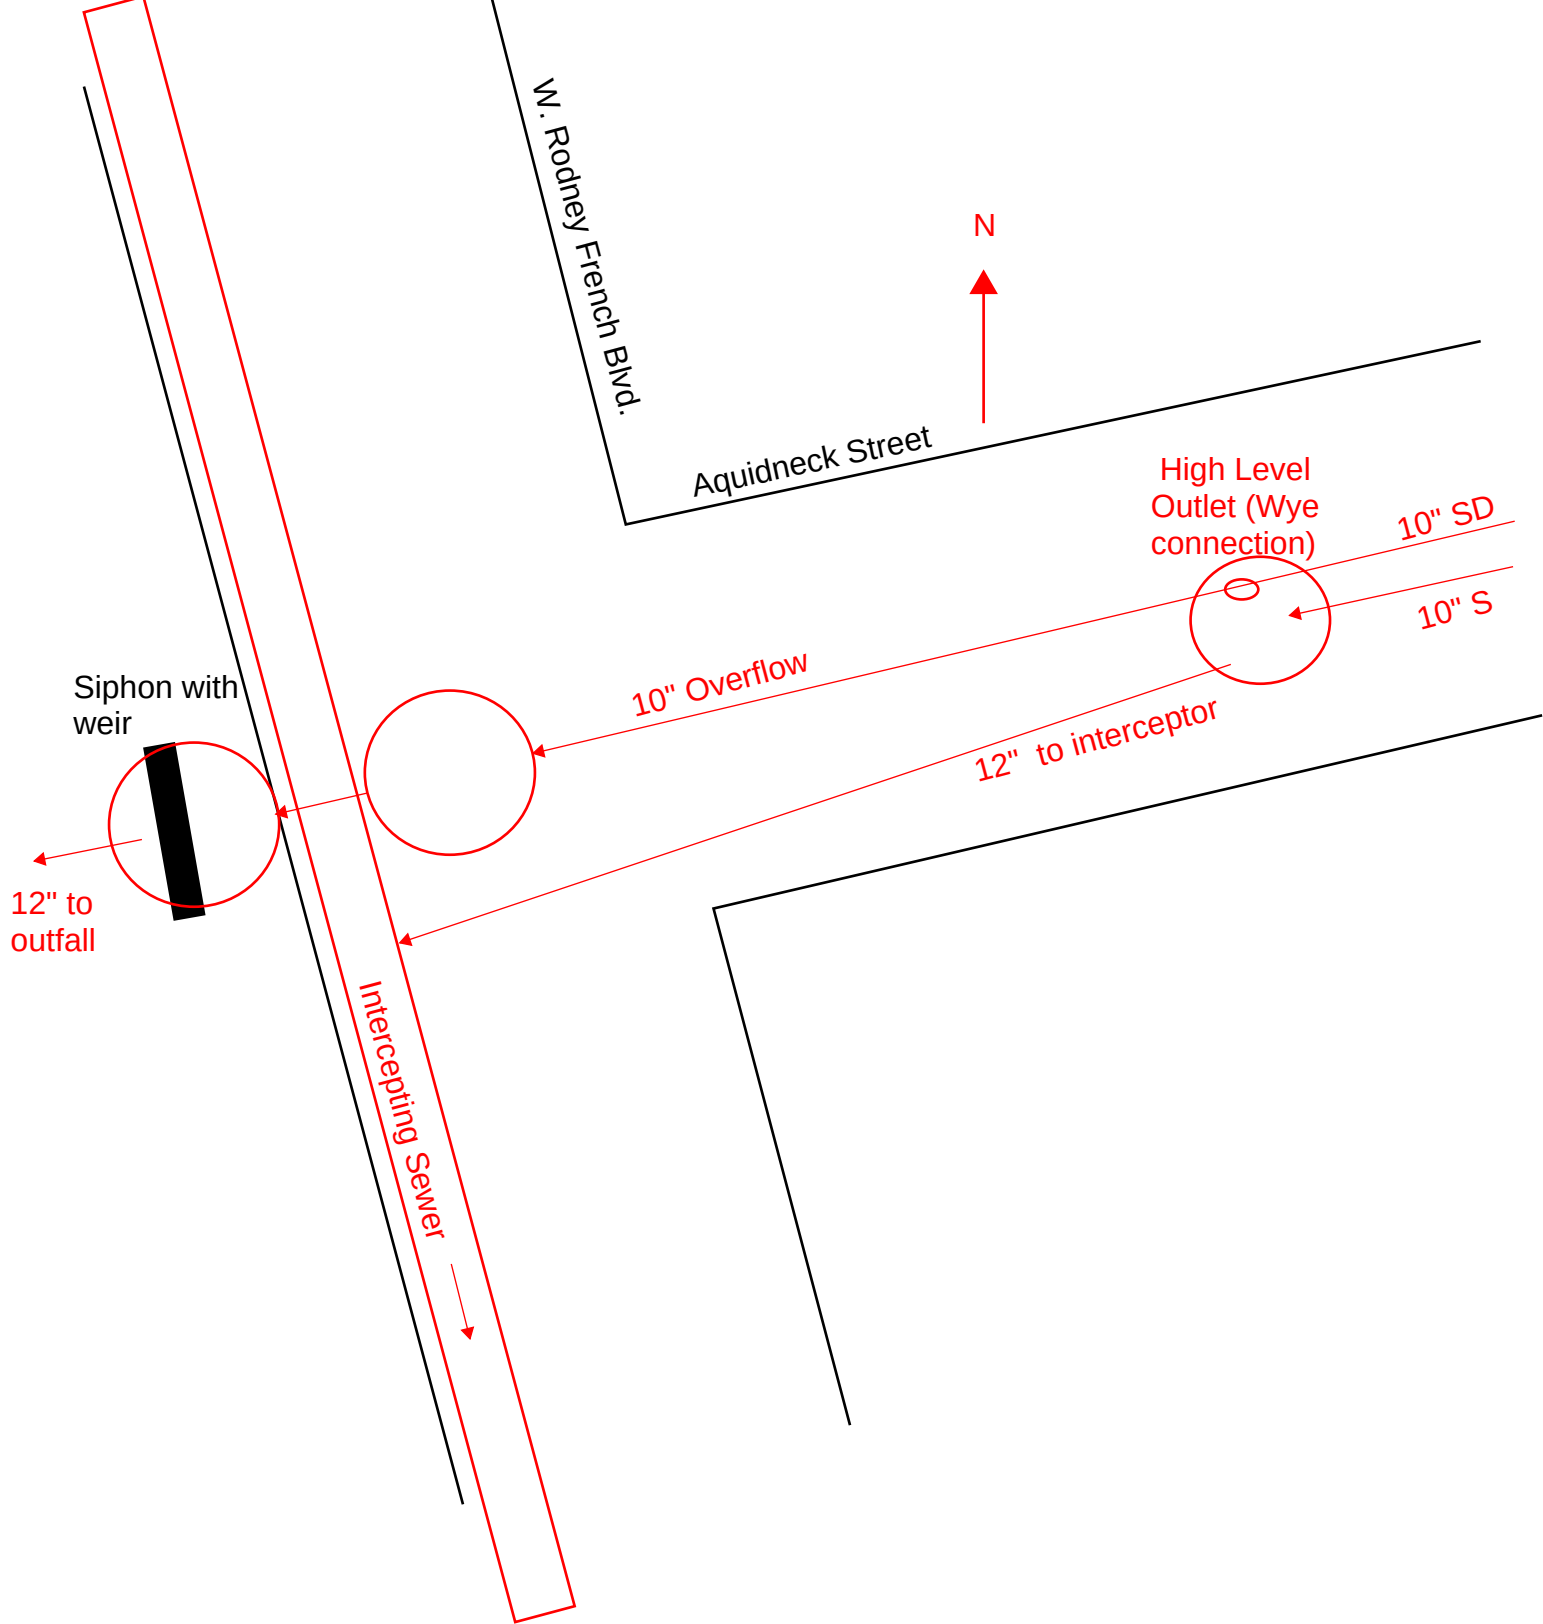


R-009A




W. Rodney French Blvd.


Bellevue Street

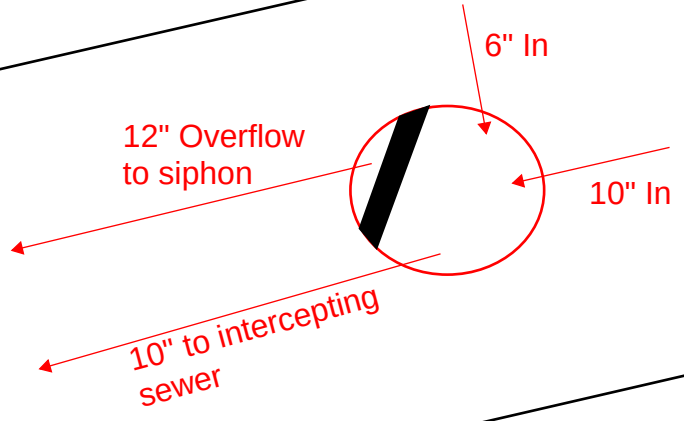


R-010A

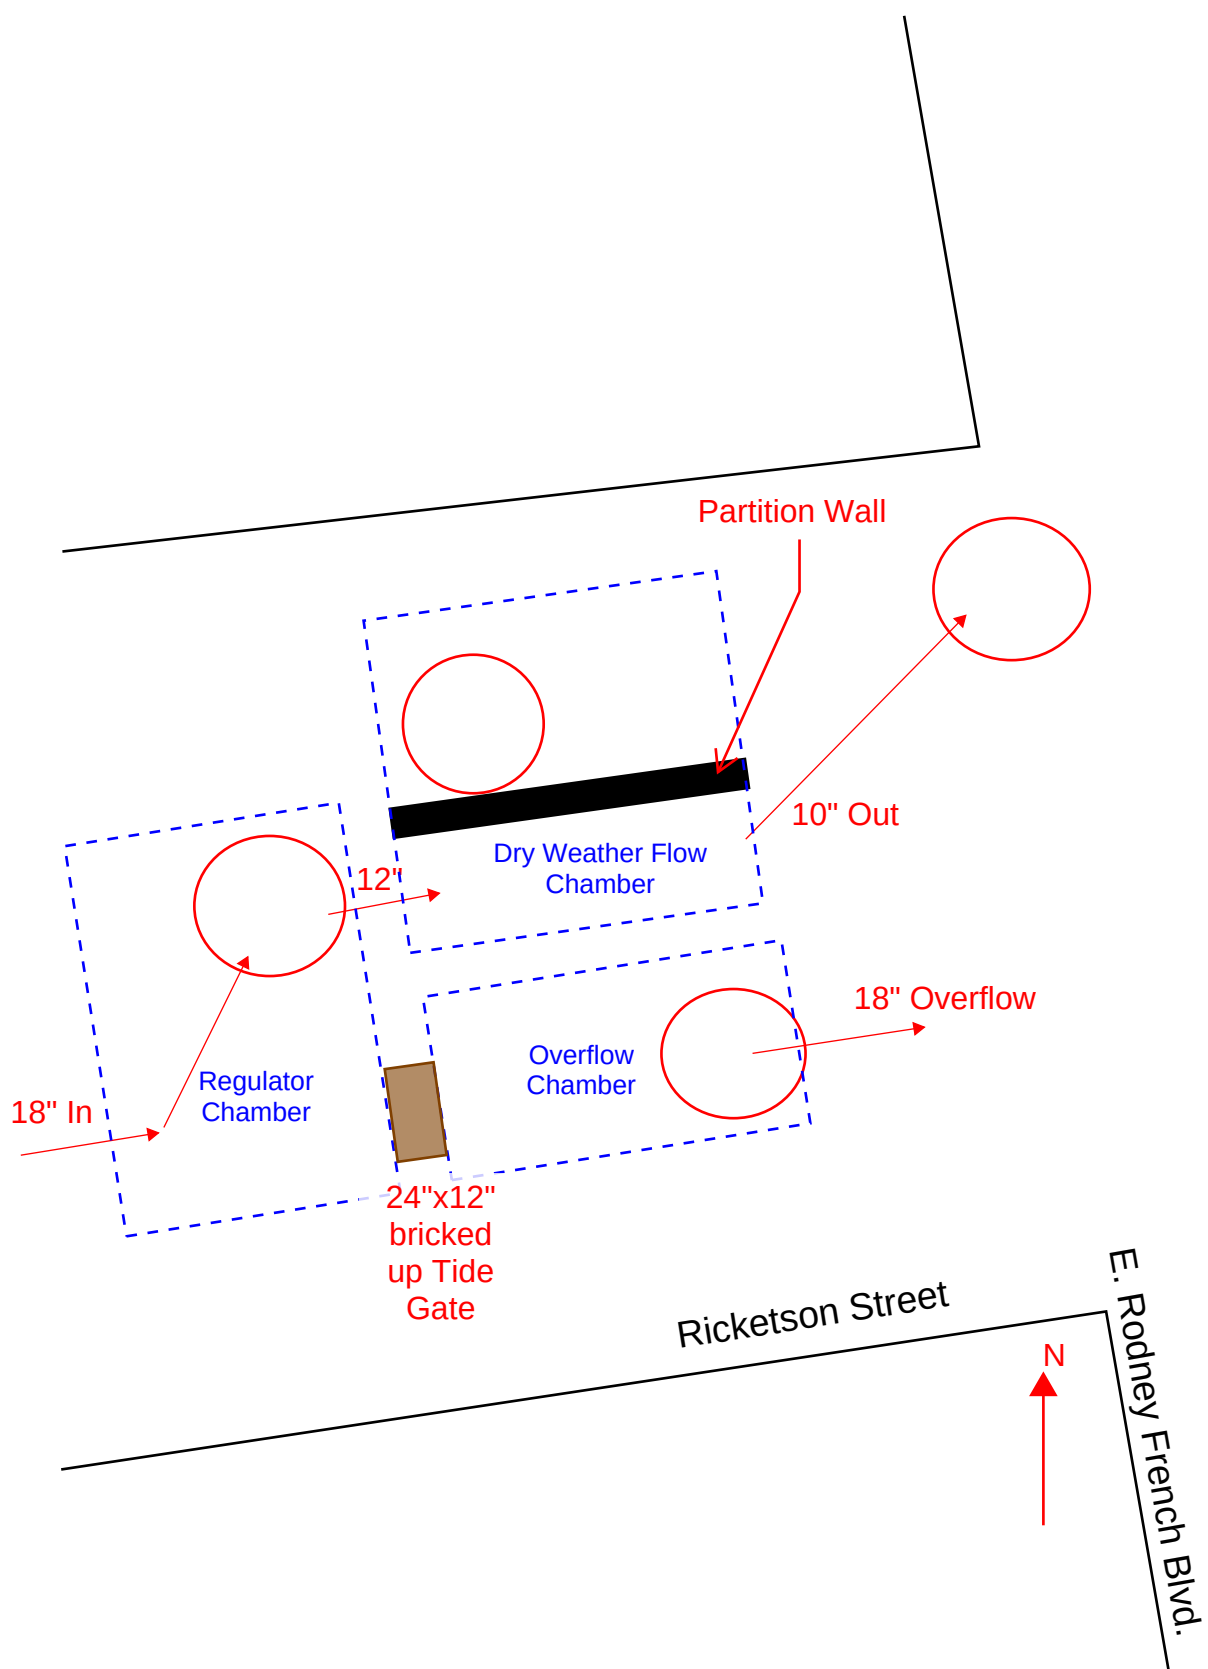


R-012A

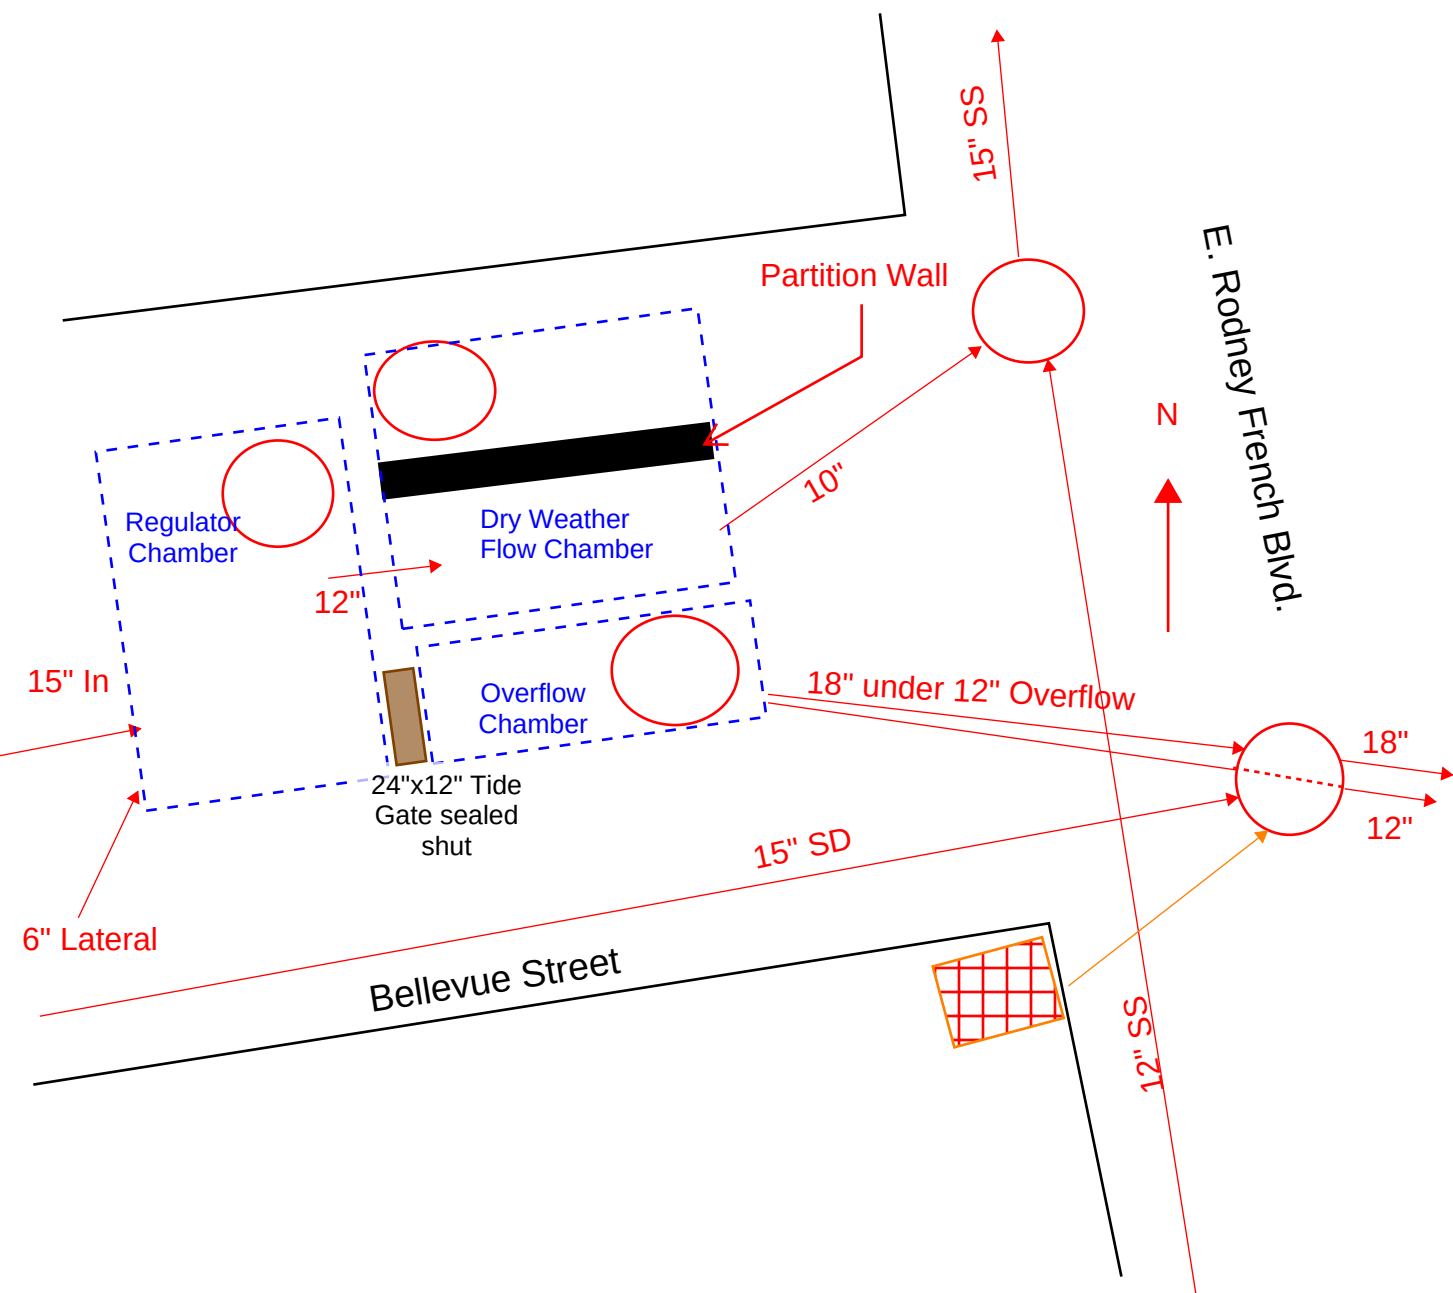

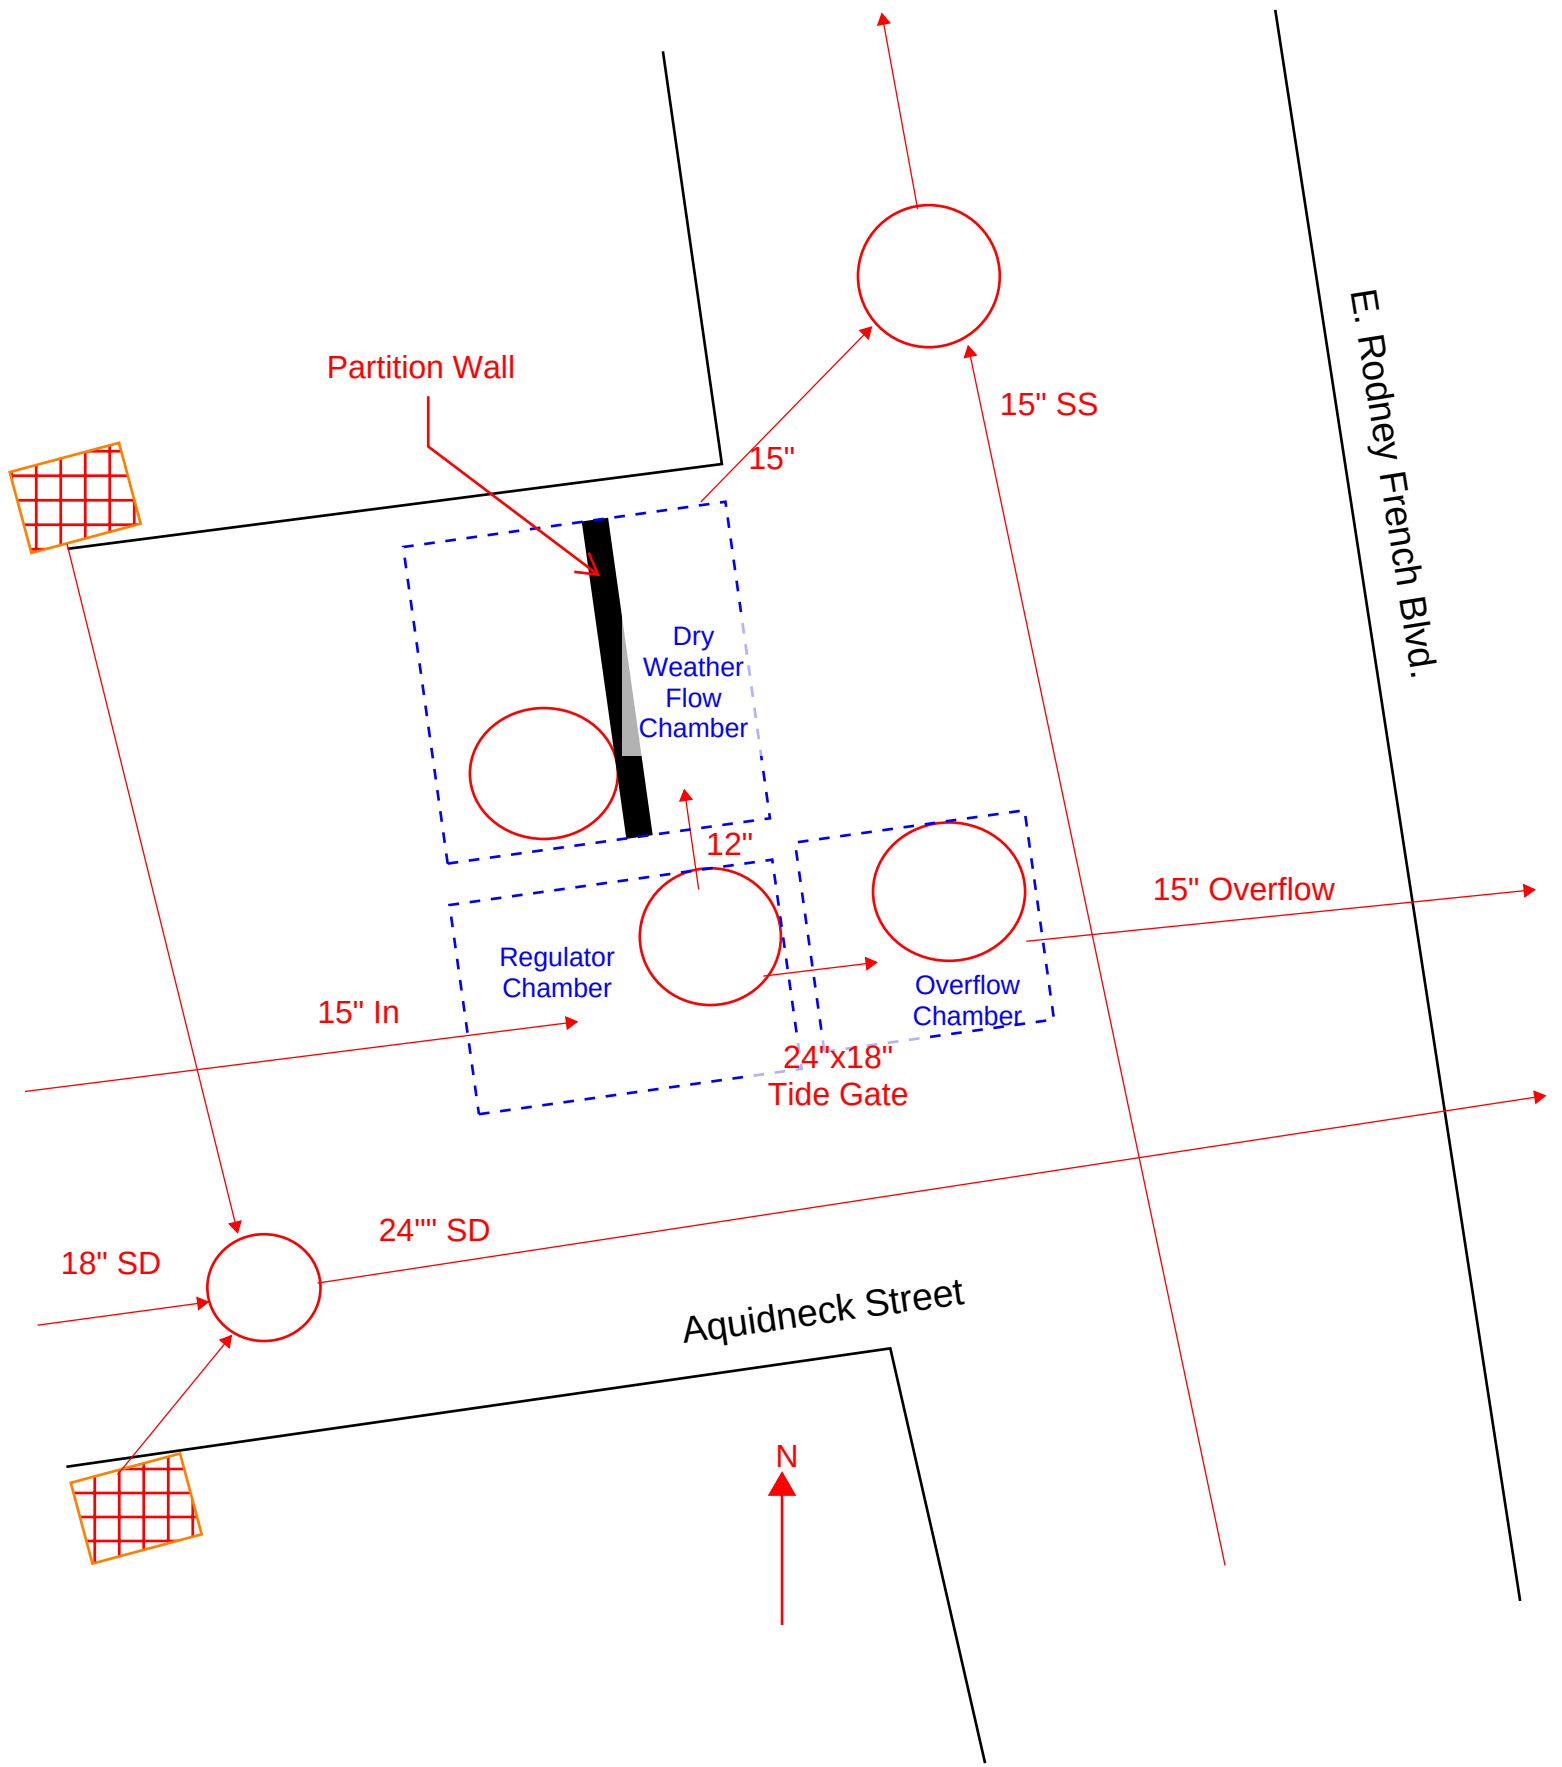


R-013A

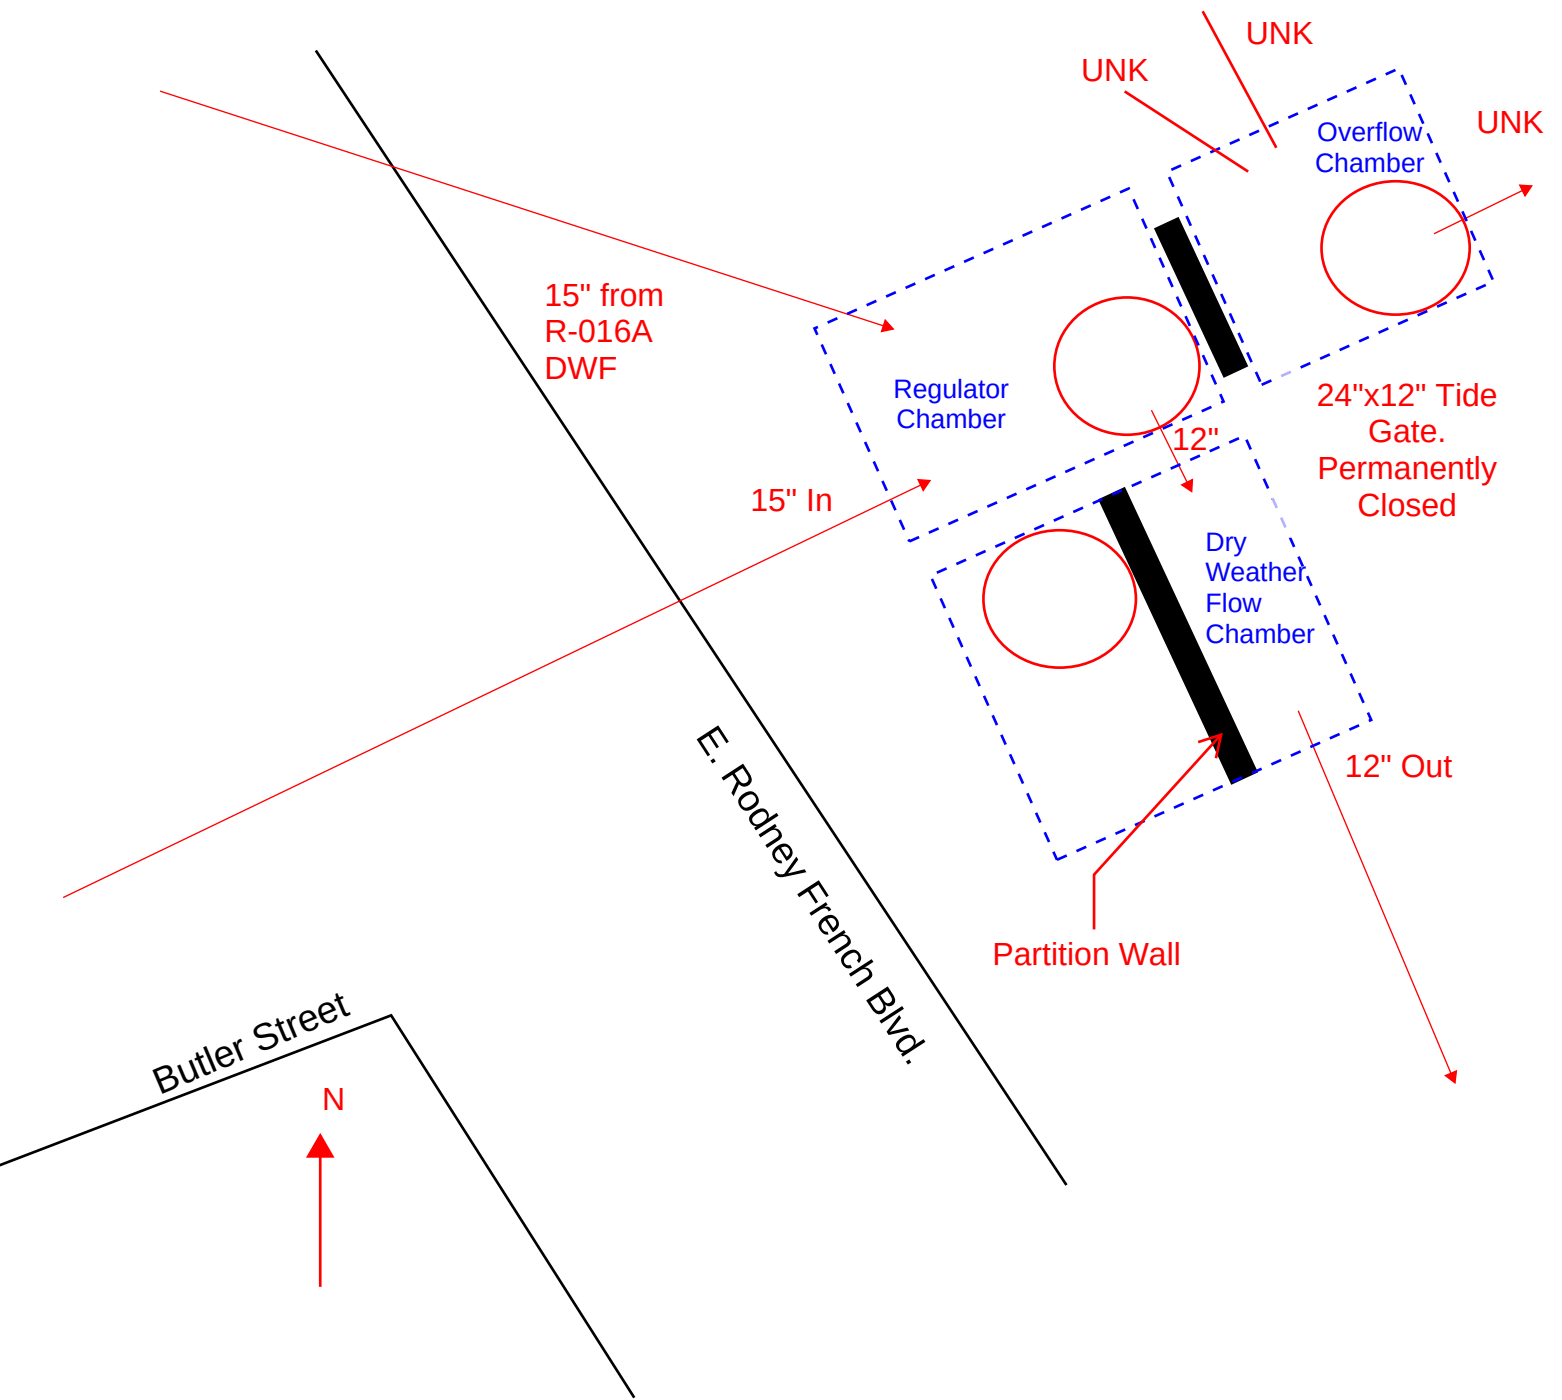


R-015A




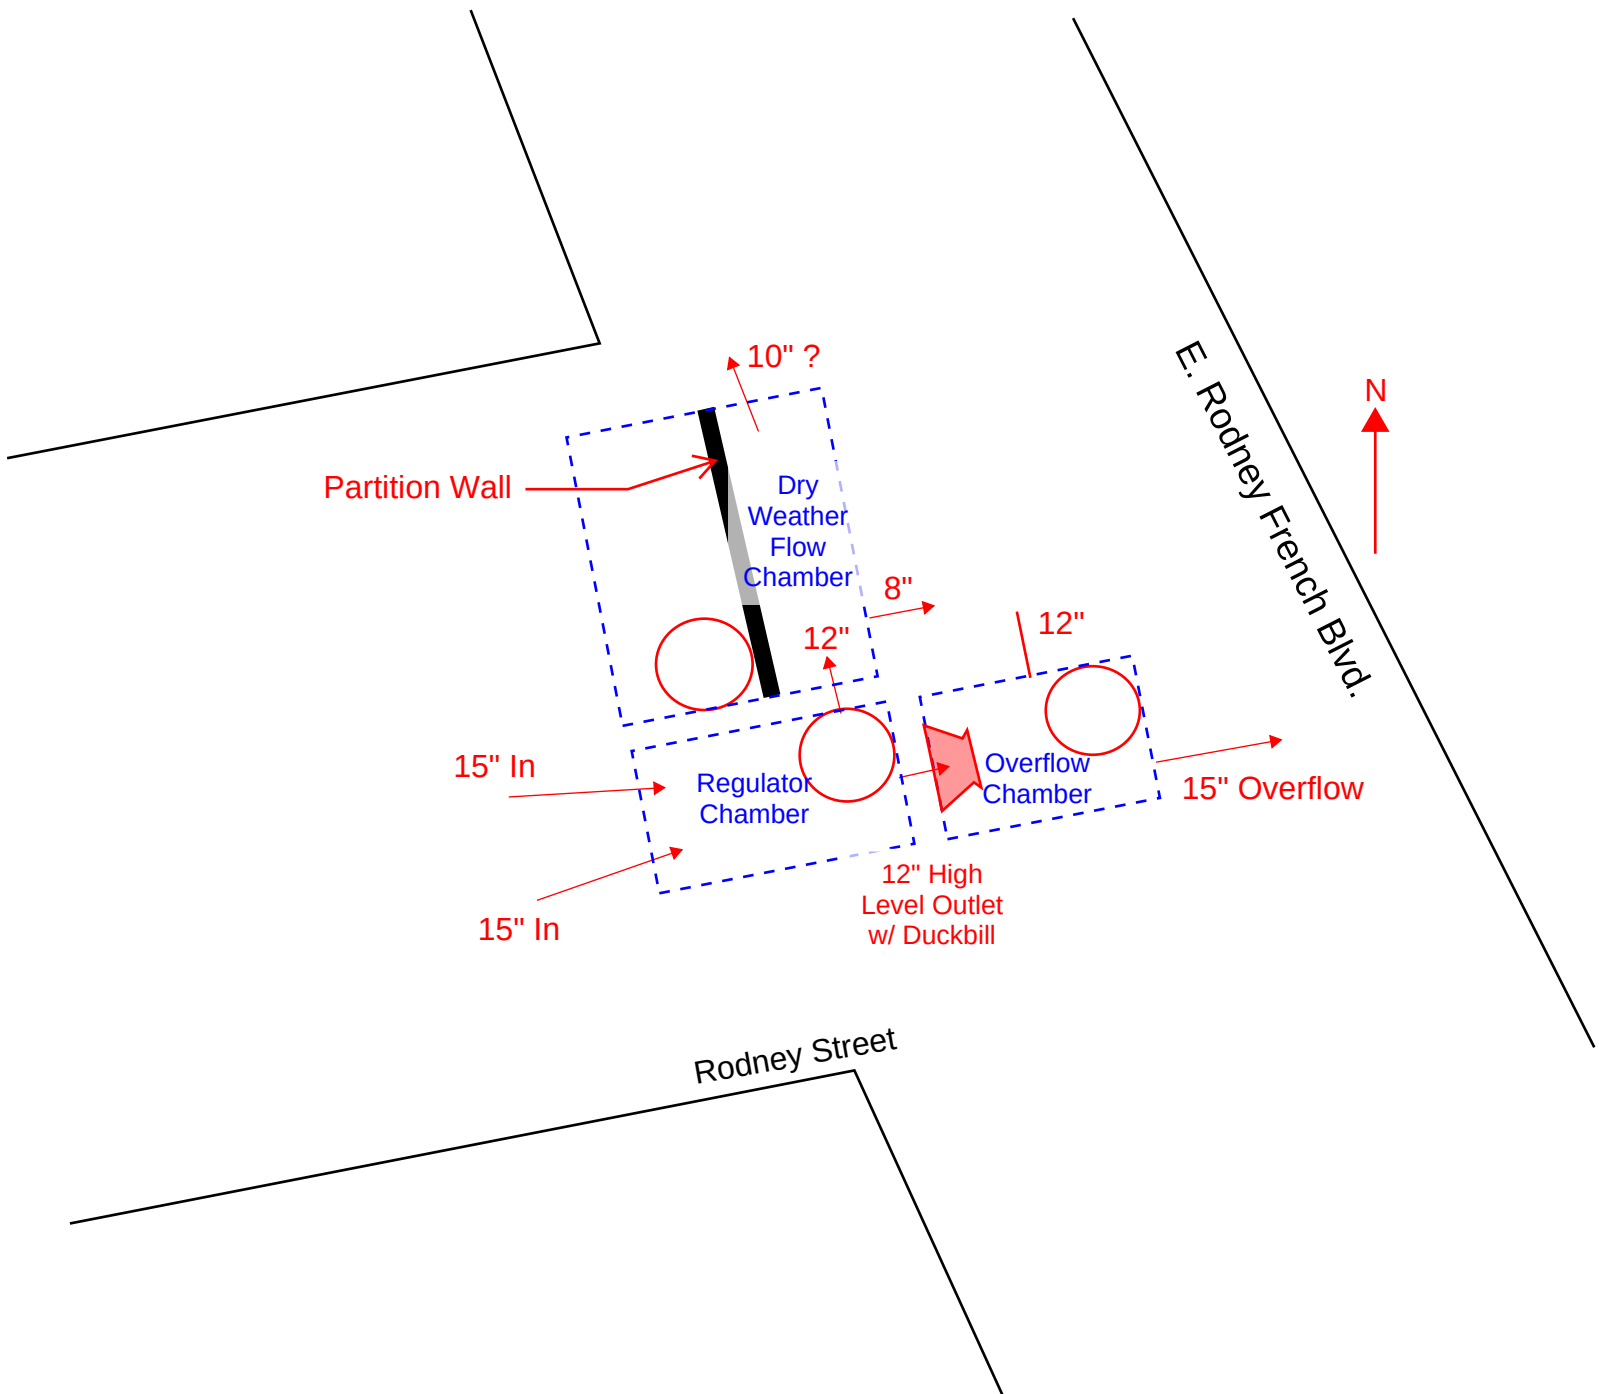


R-017A

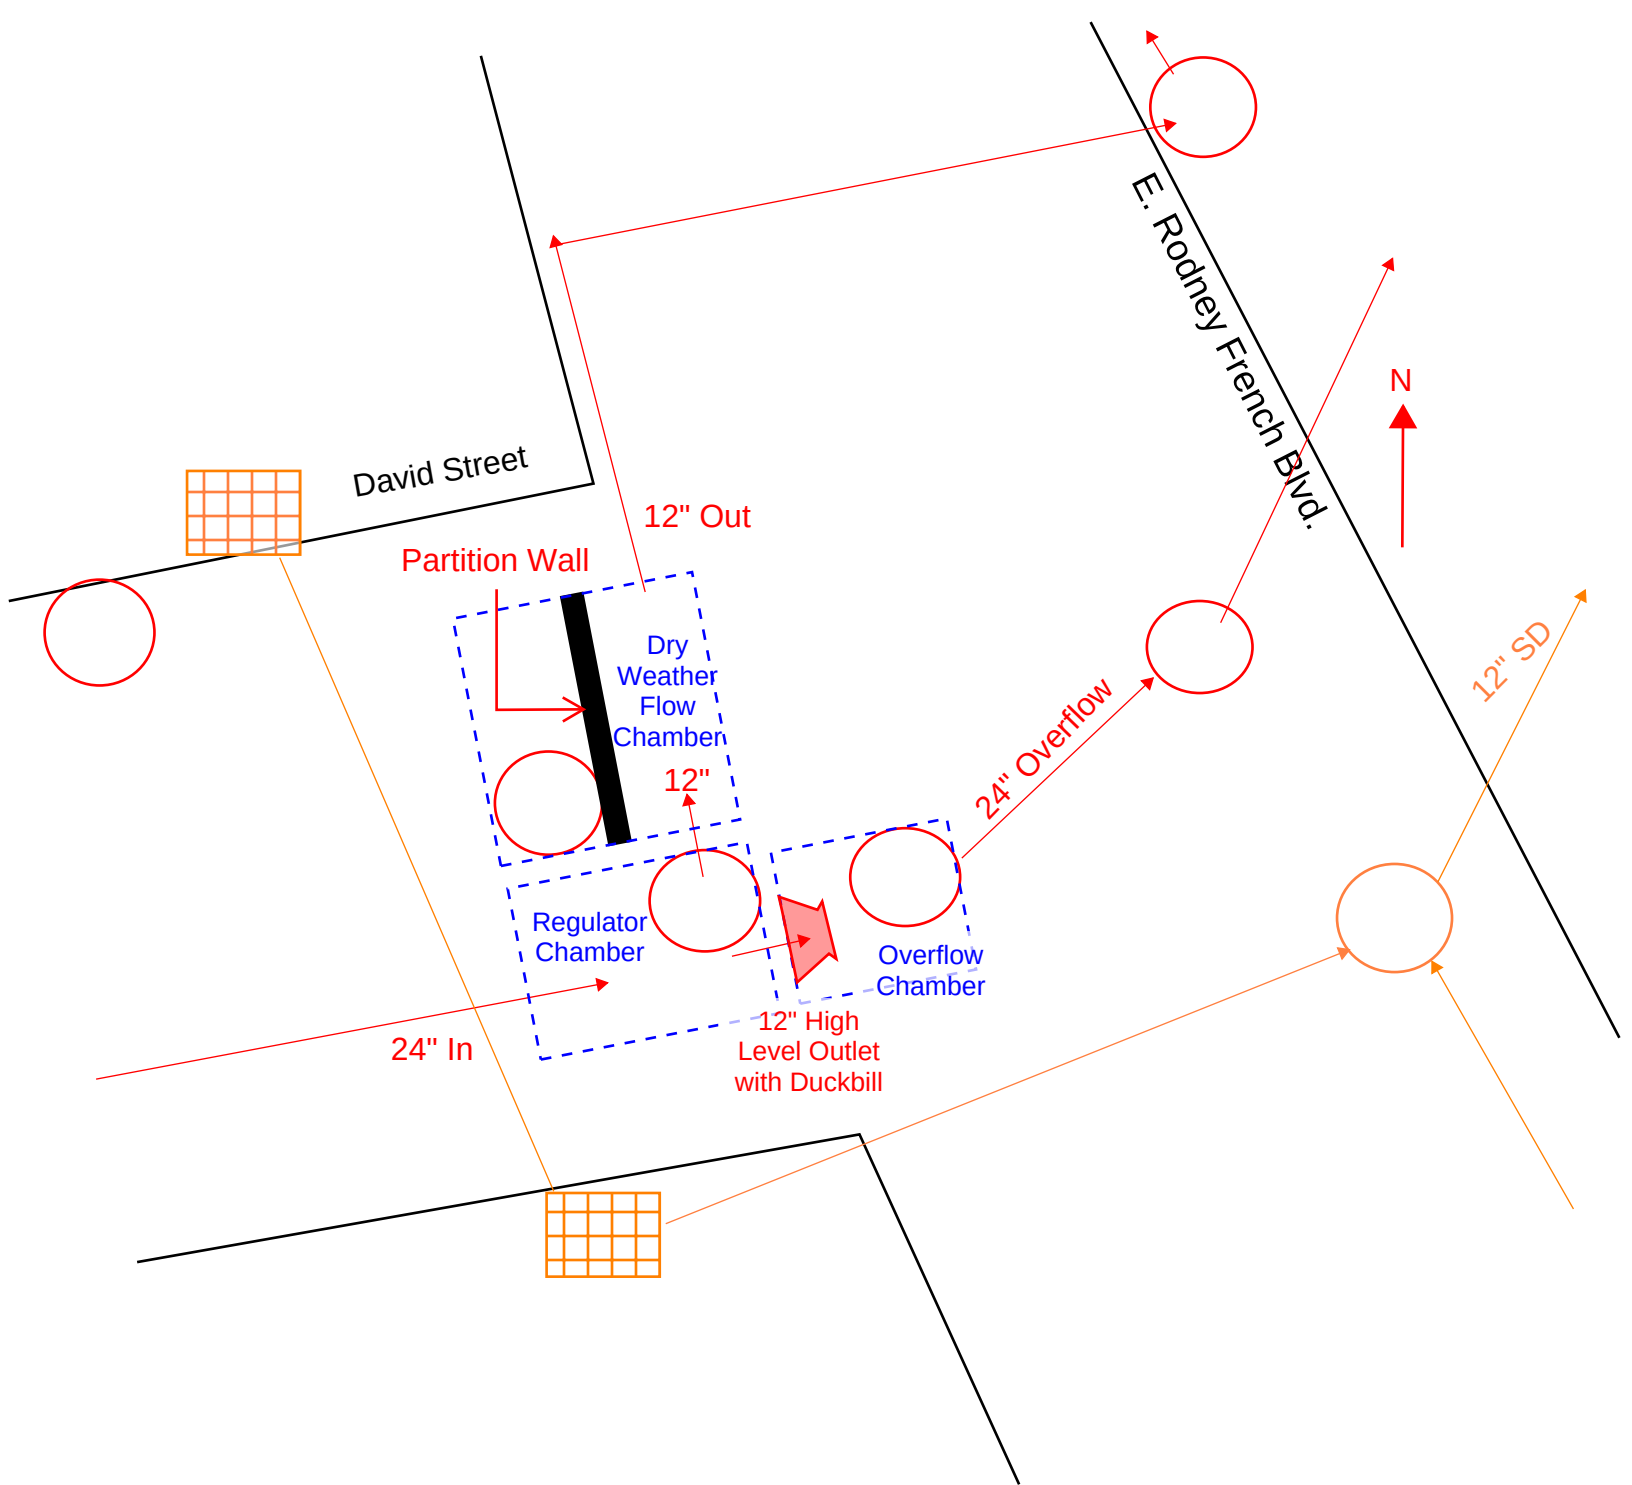


R-017C

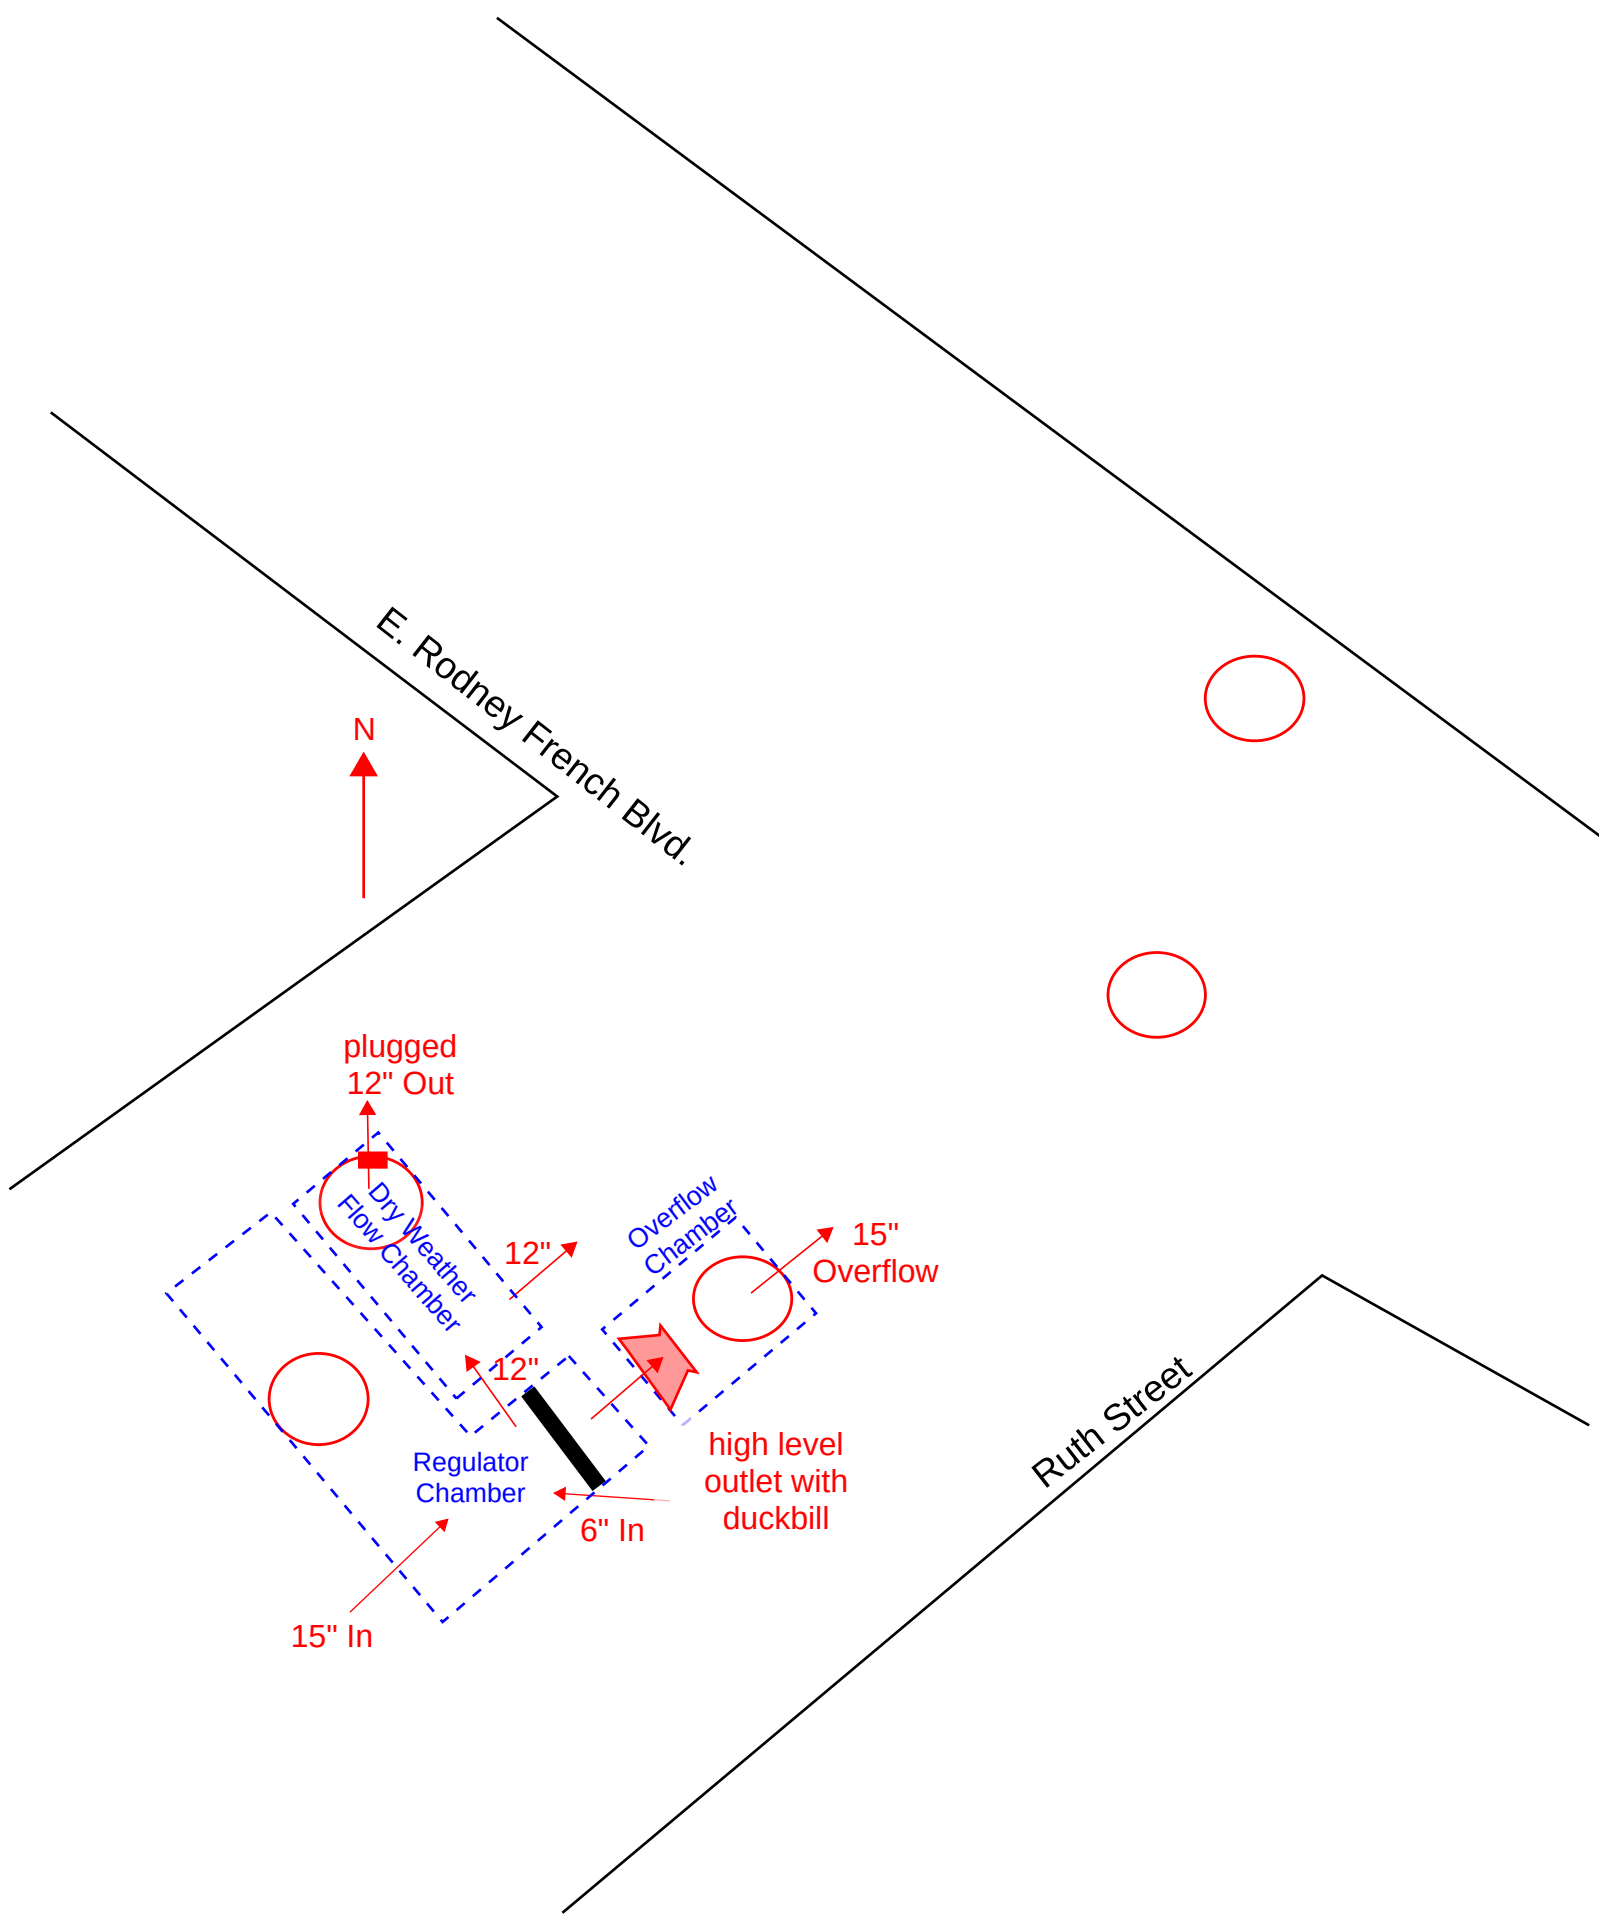

R-017D

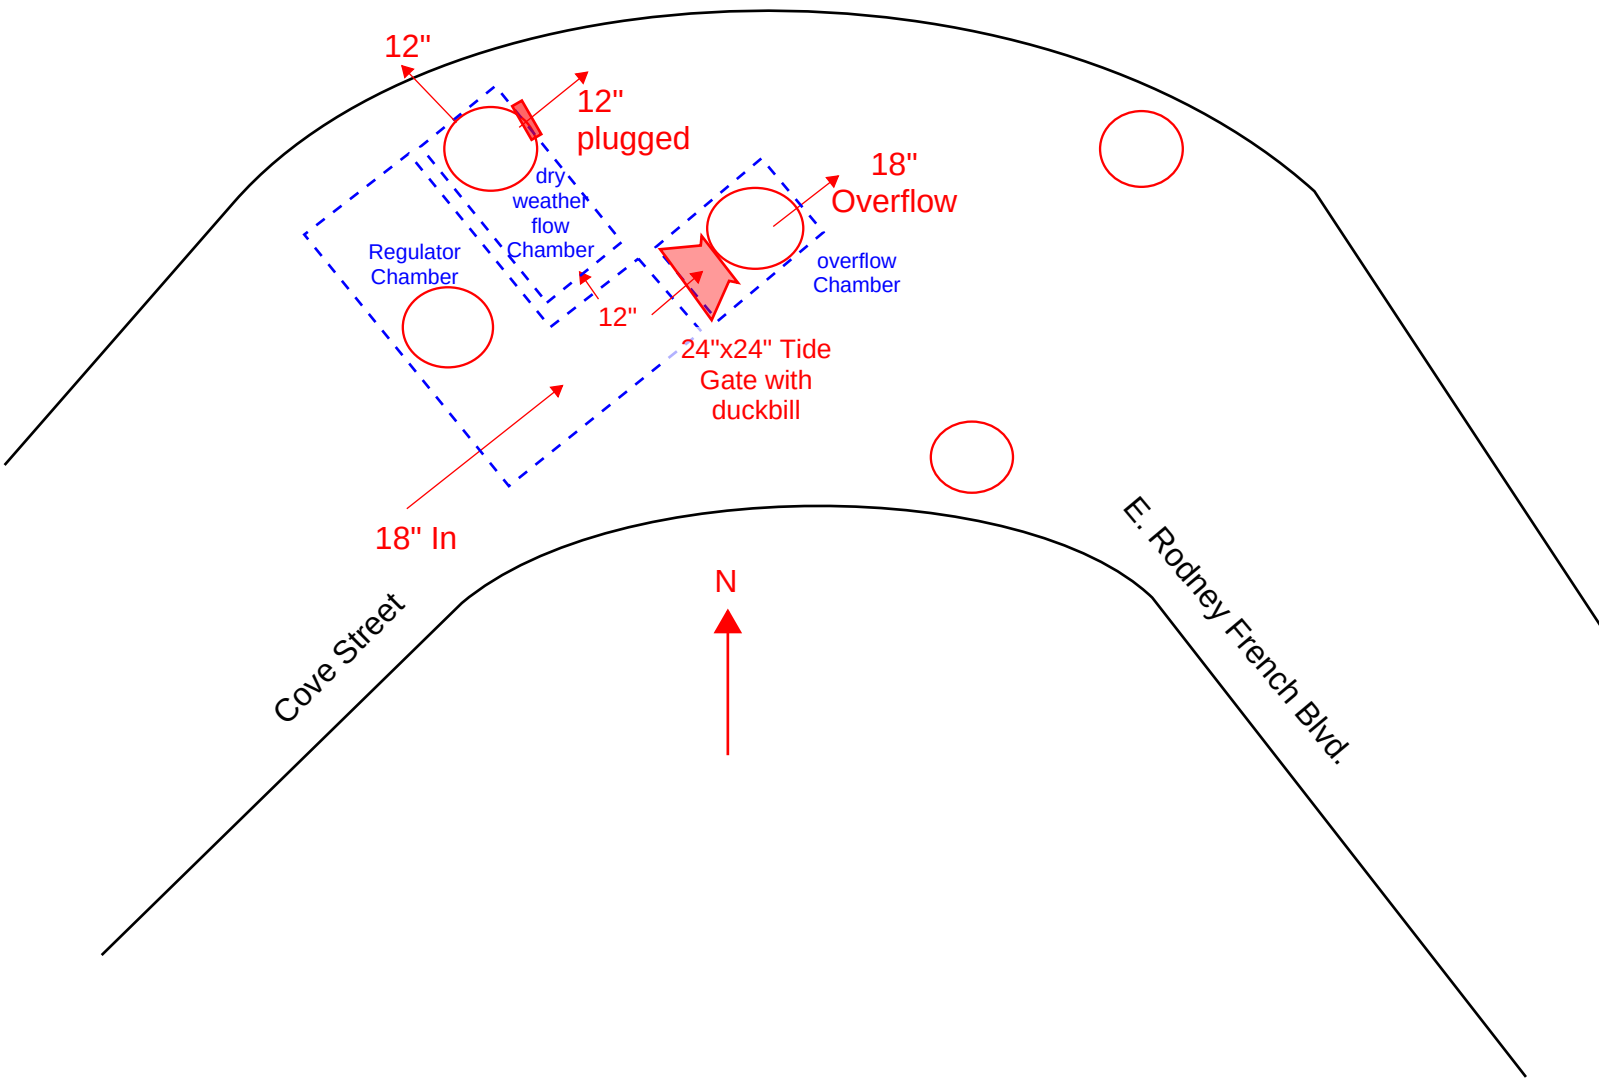

R-018A

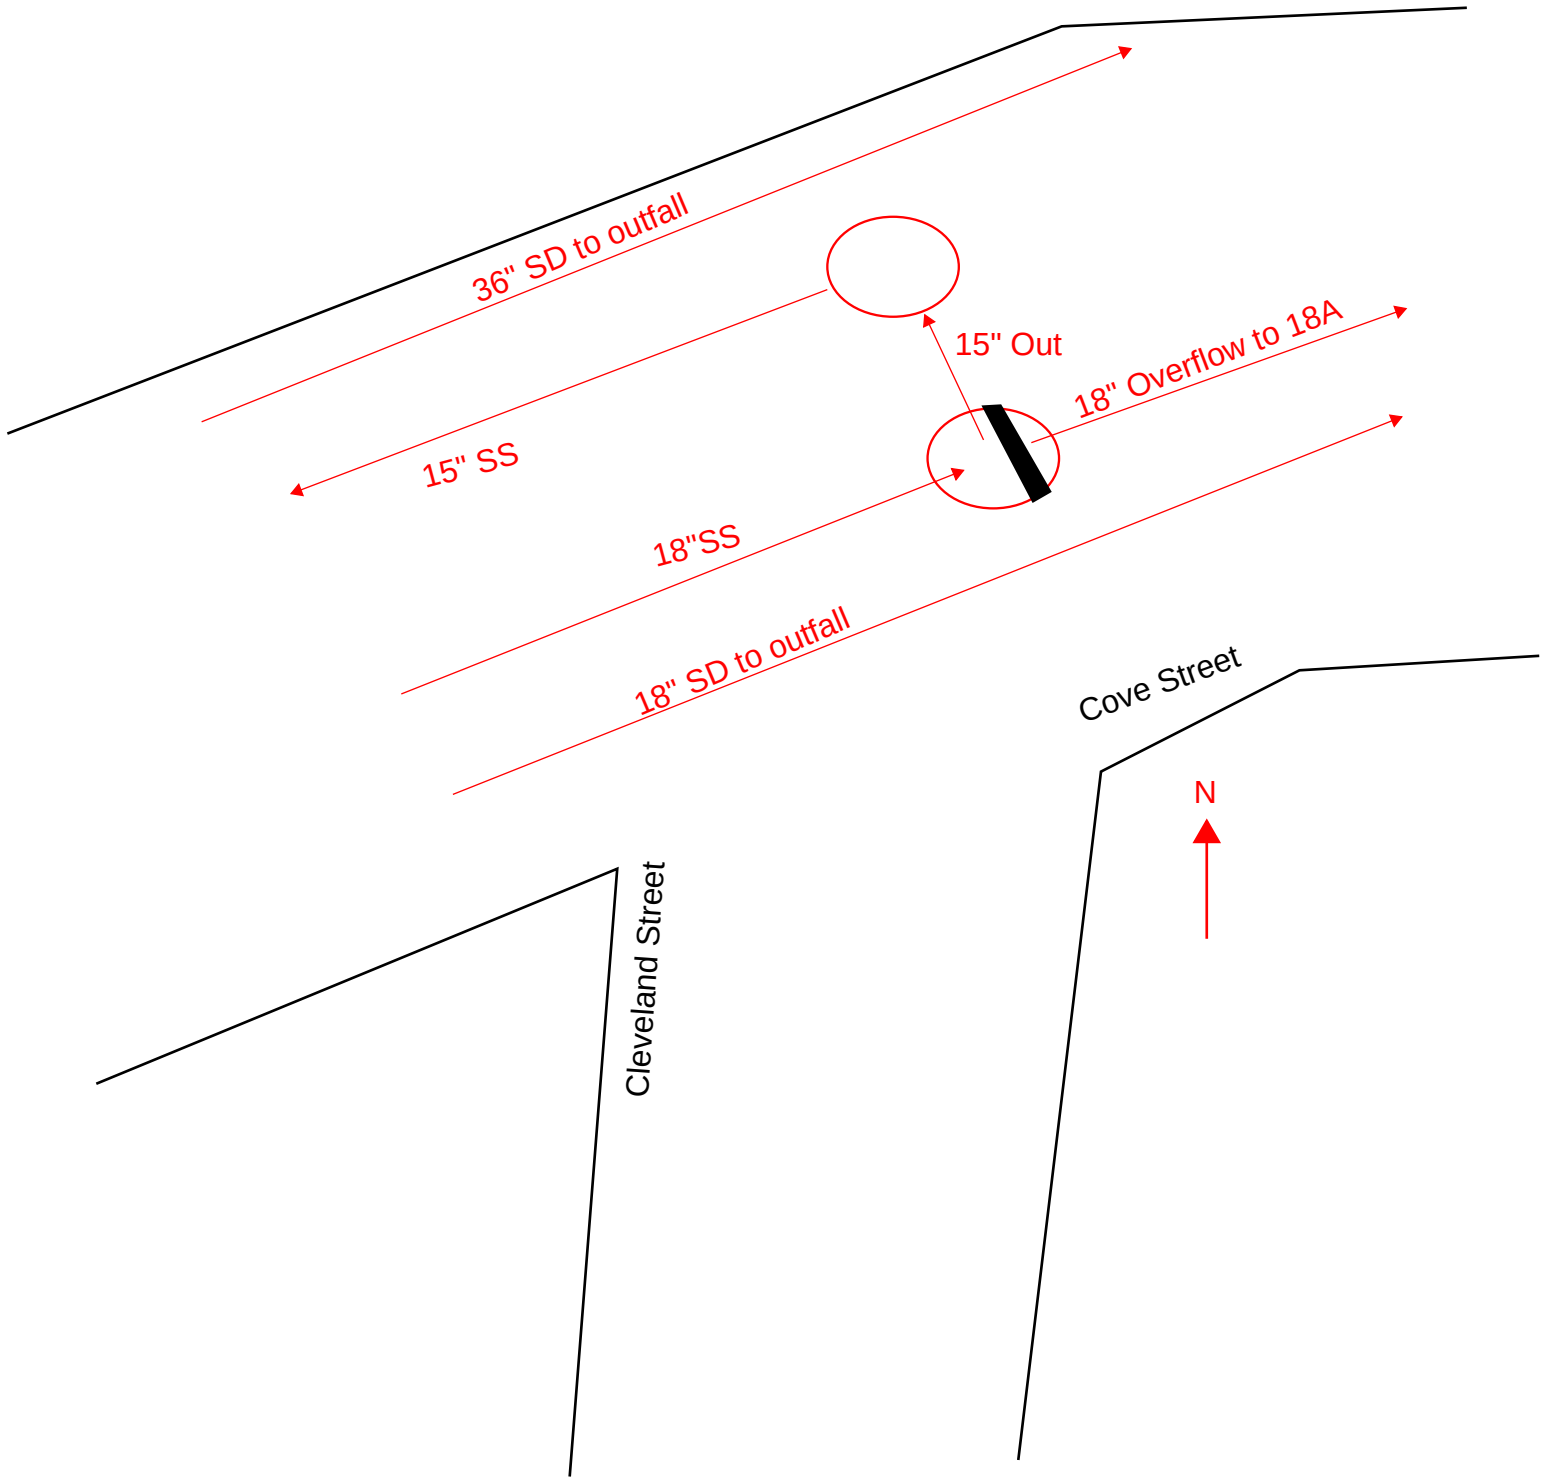

R-018B

Purchase Street

Sidewalk

Wamsutta Street

8" lateral

24" S

24" S

Inflow Chamber,
Overflow Chamber
Underneath

36"

Sidewalk

Rt-18 Southbound

N

30" Overflow (Under)


12"


12" to
Wamsutta
St. PS

Stop Planks


fence

R-020A

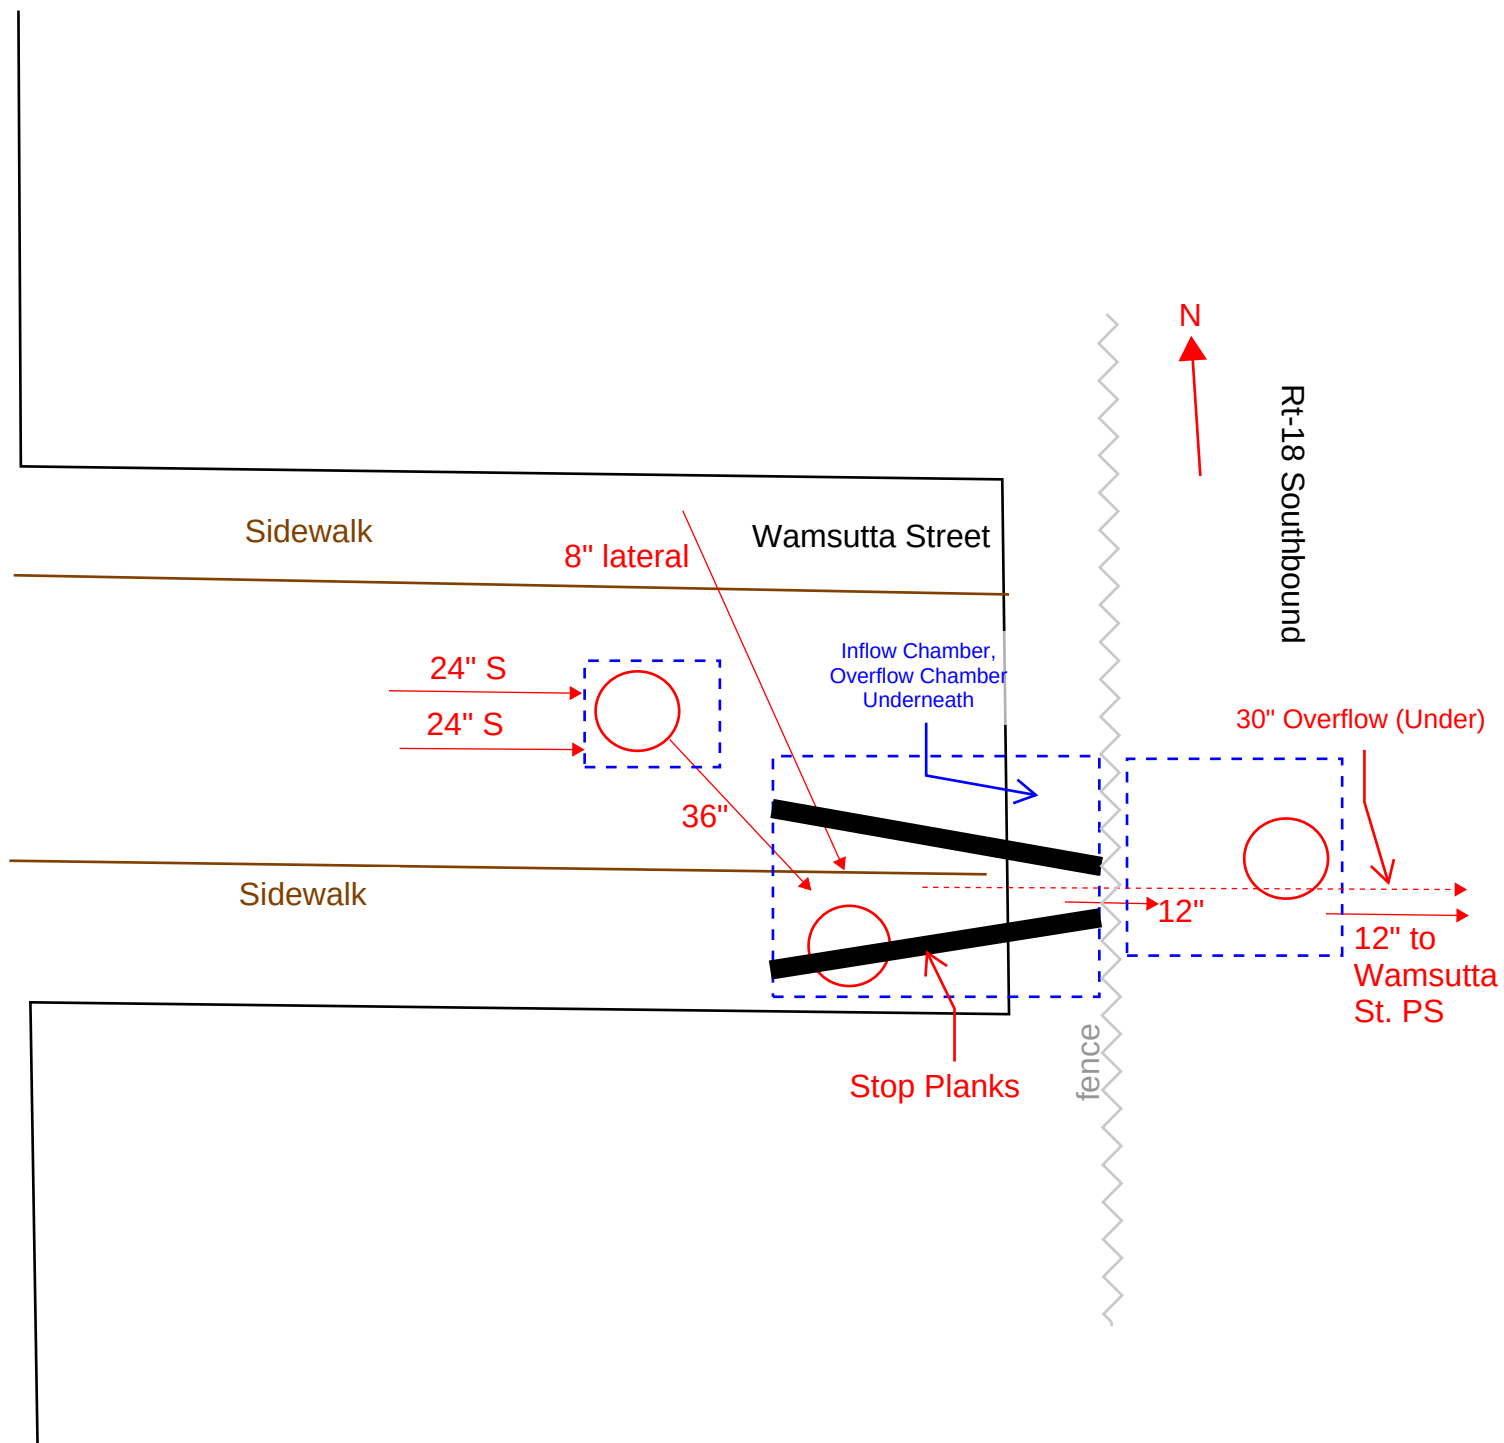


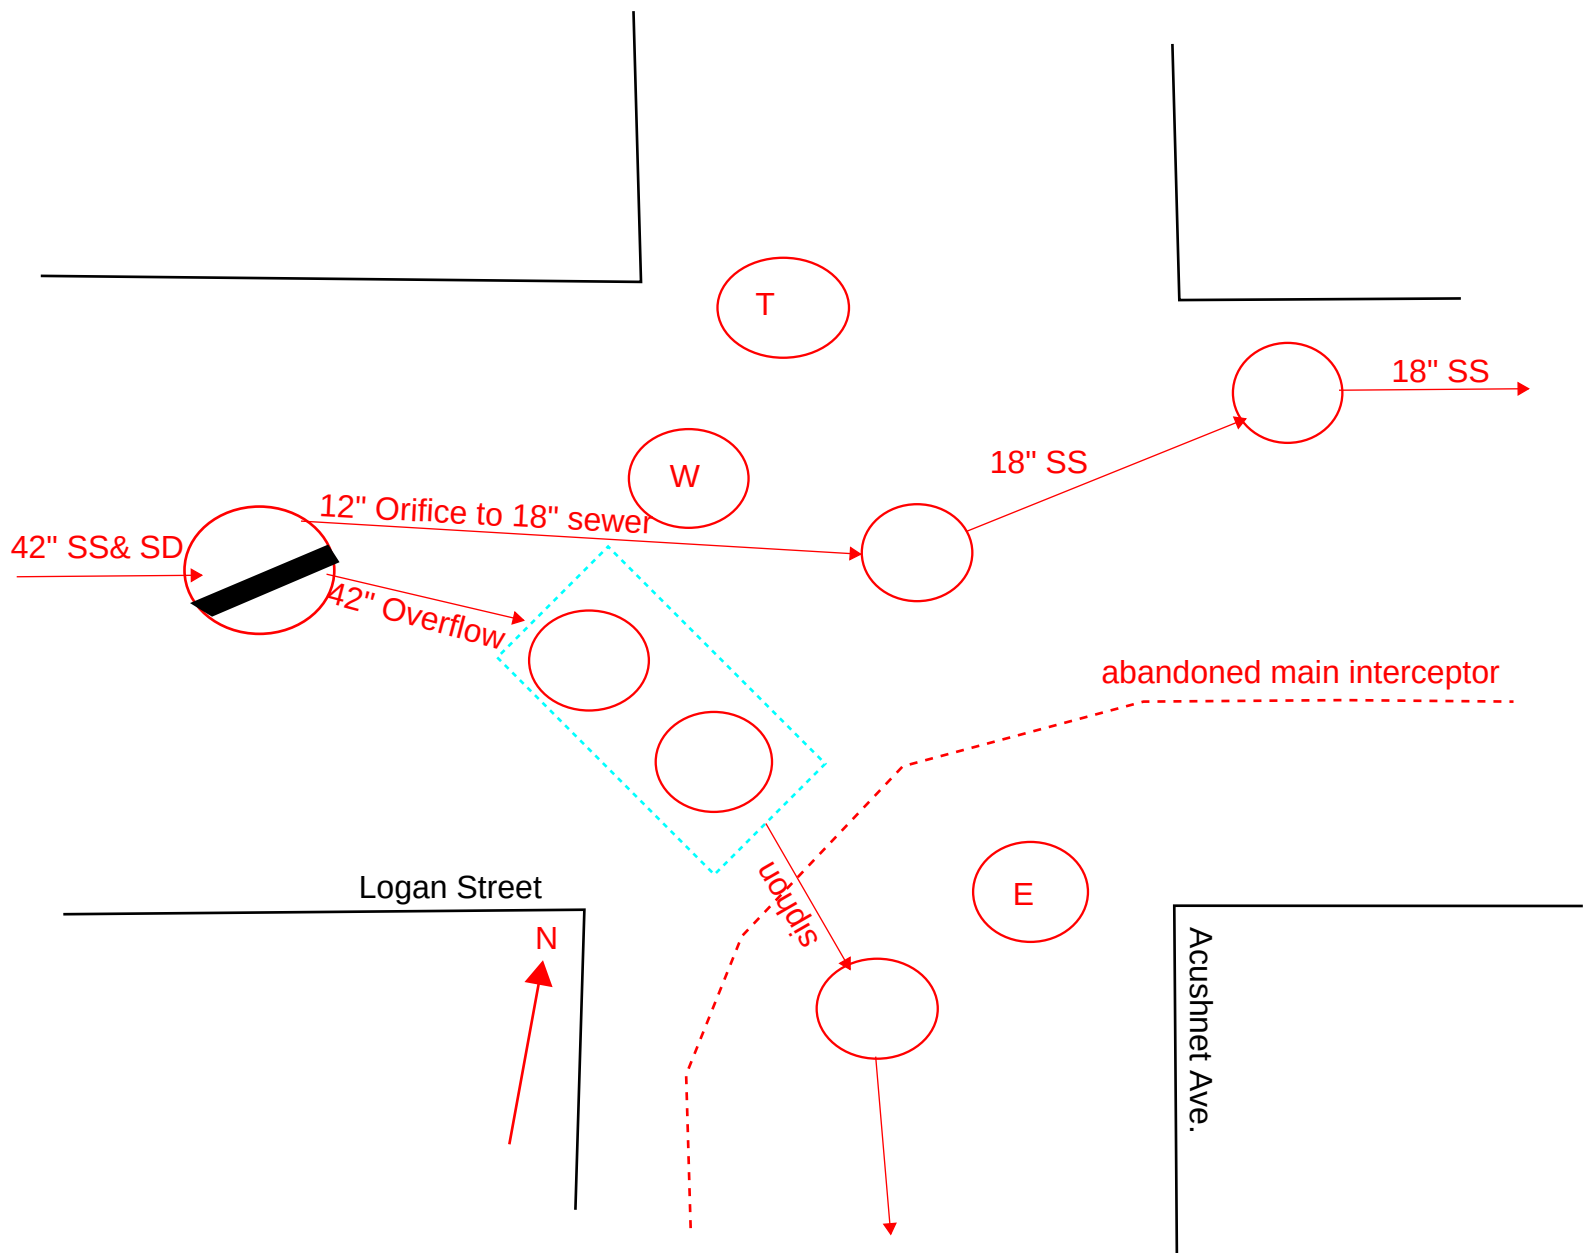


R-020B

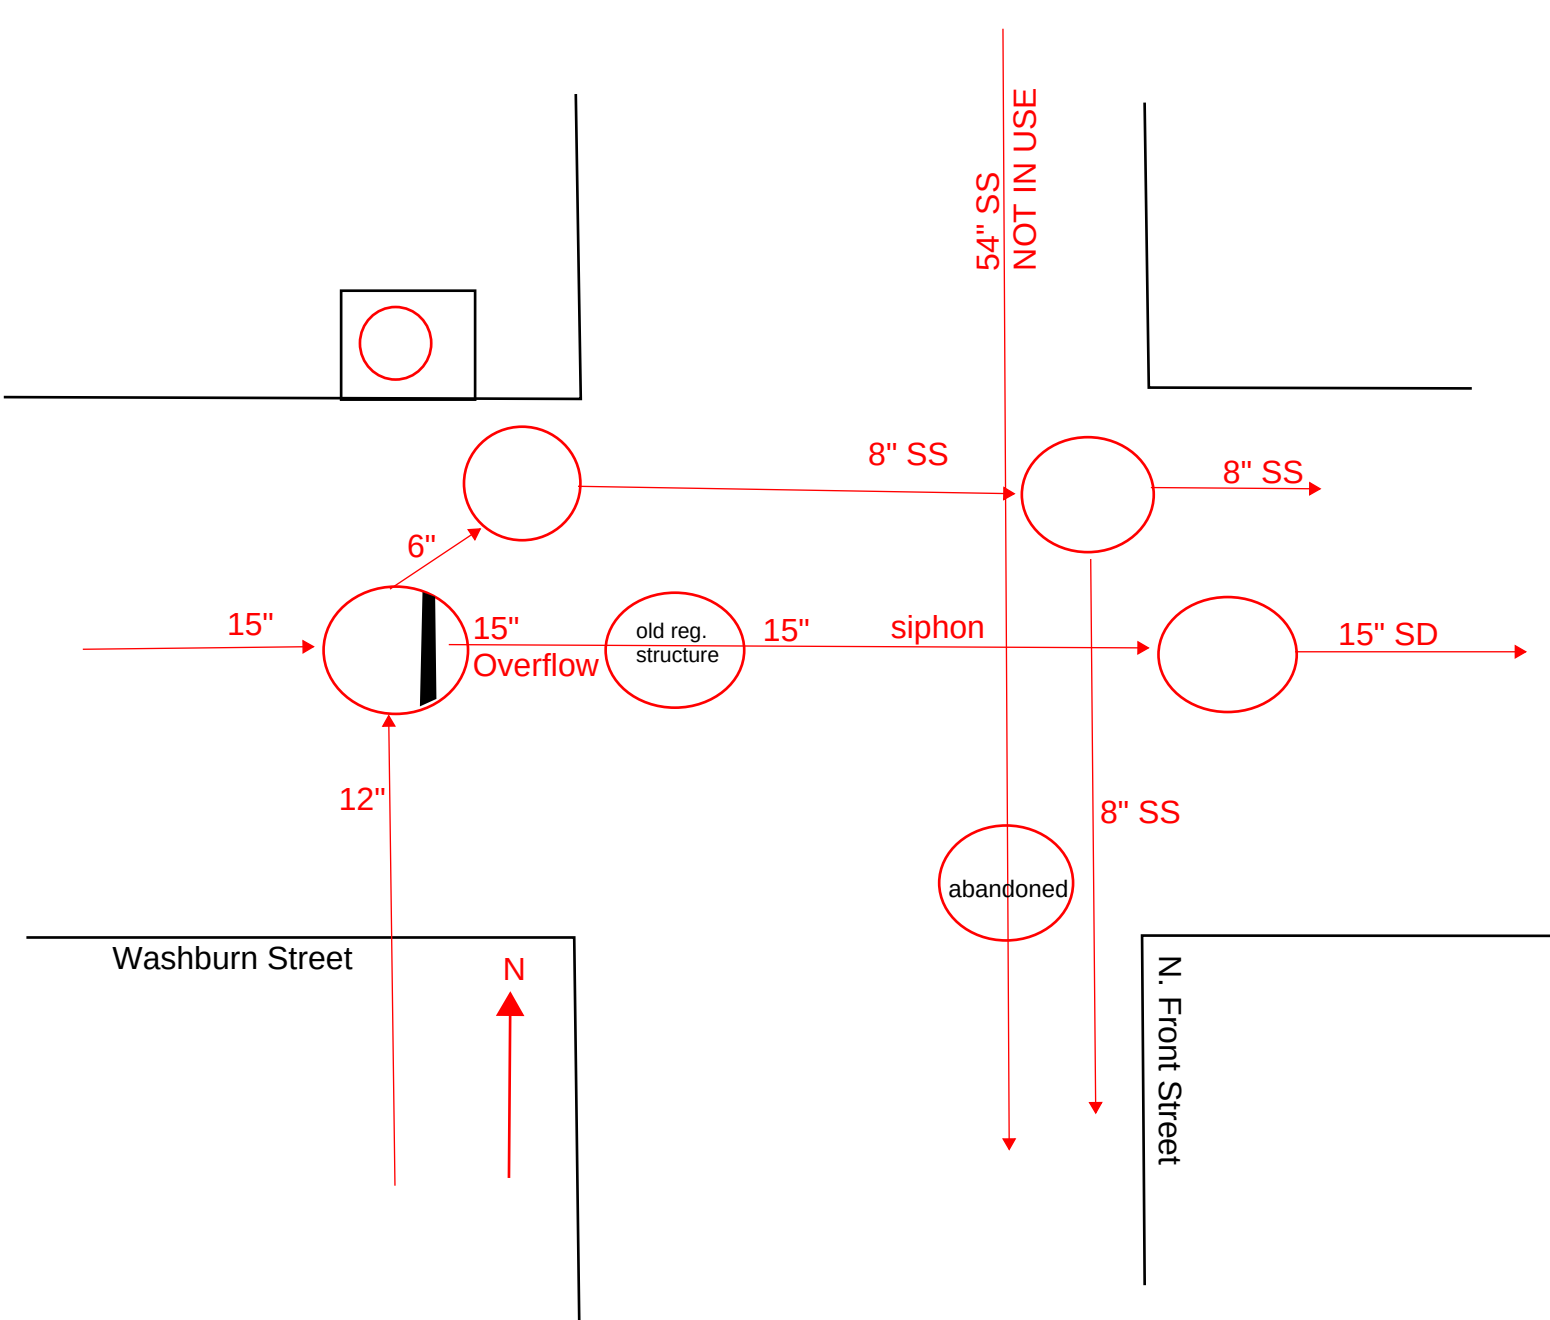


R-021A

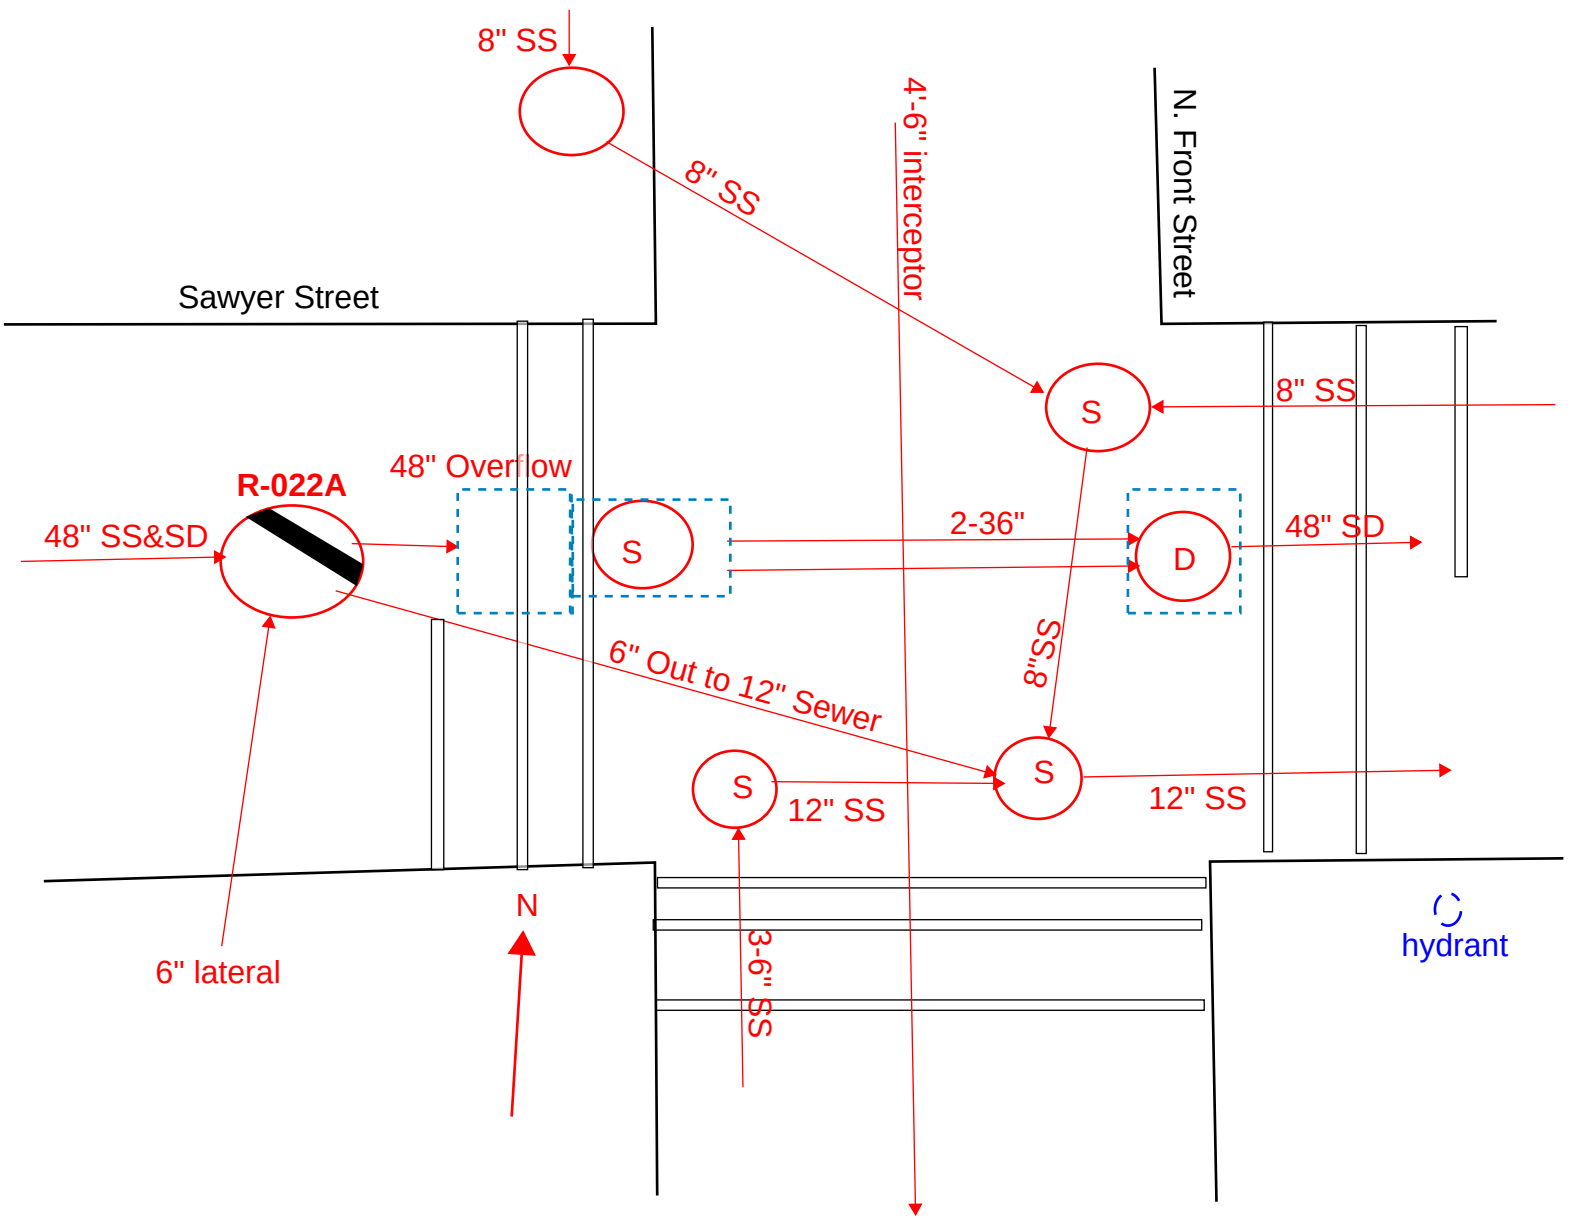


R-022A

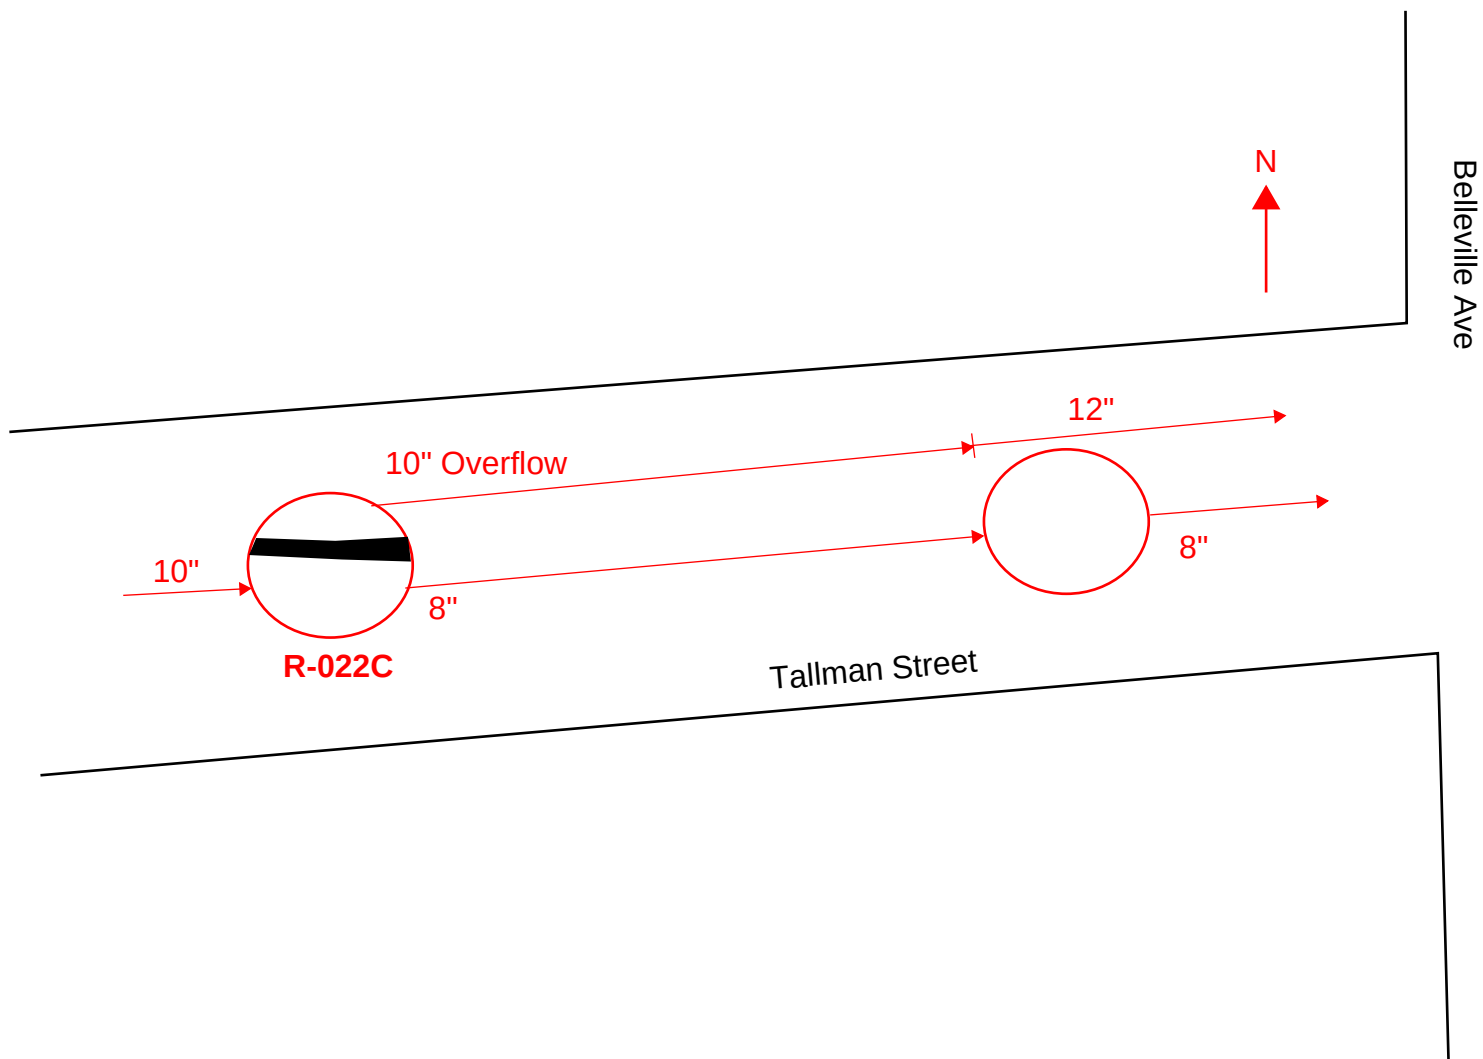


R-022C

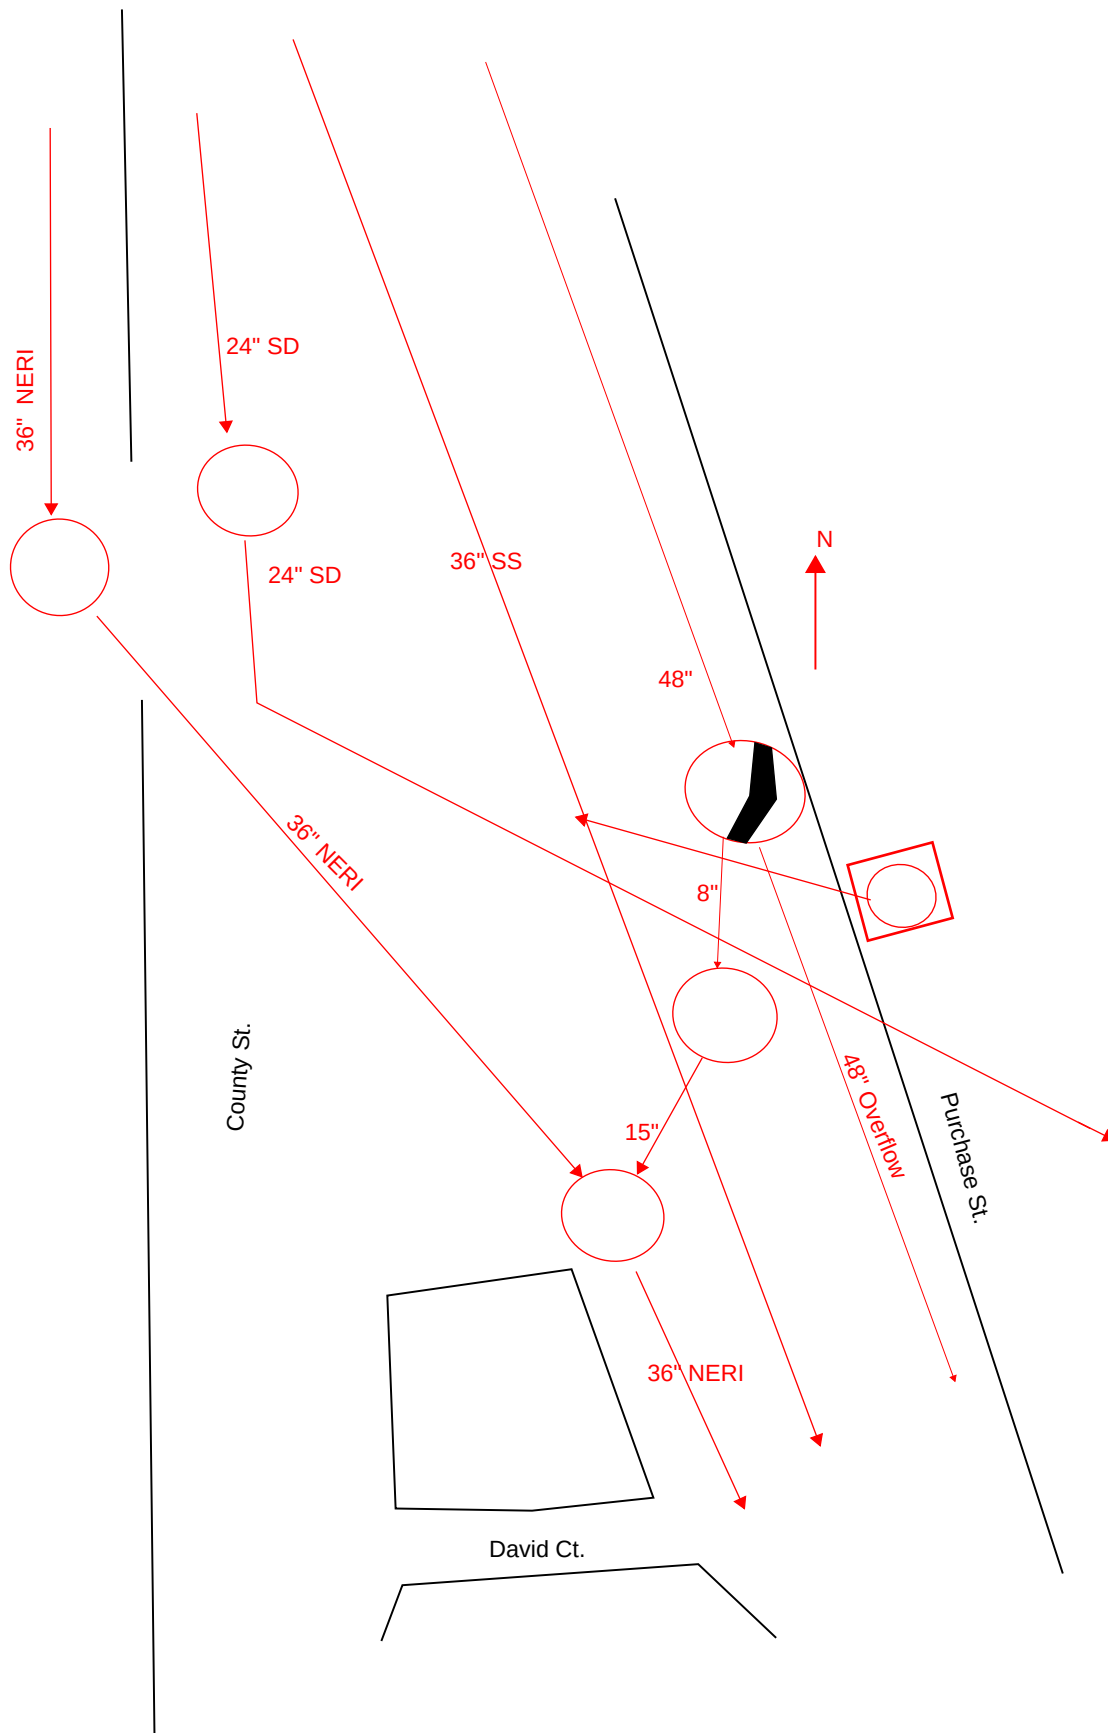


R-022D

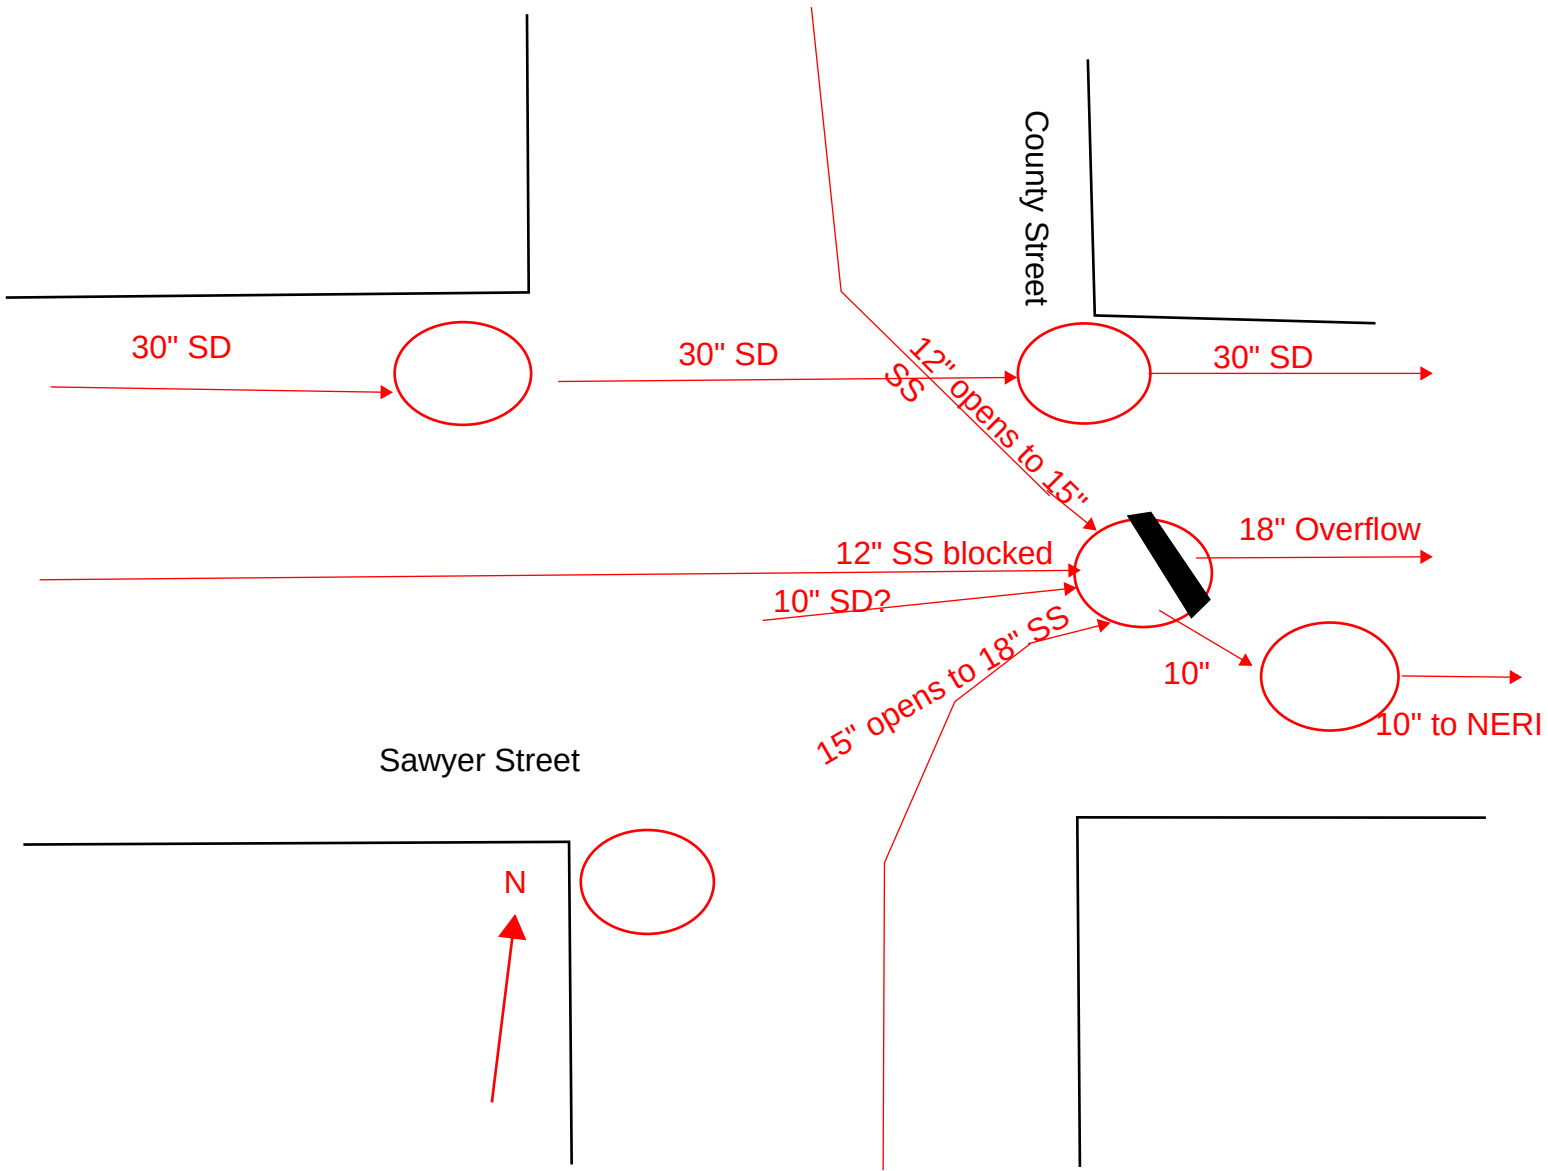


R-022E

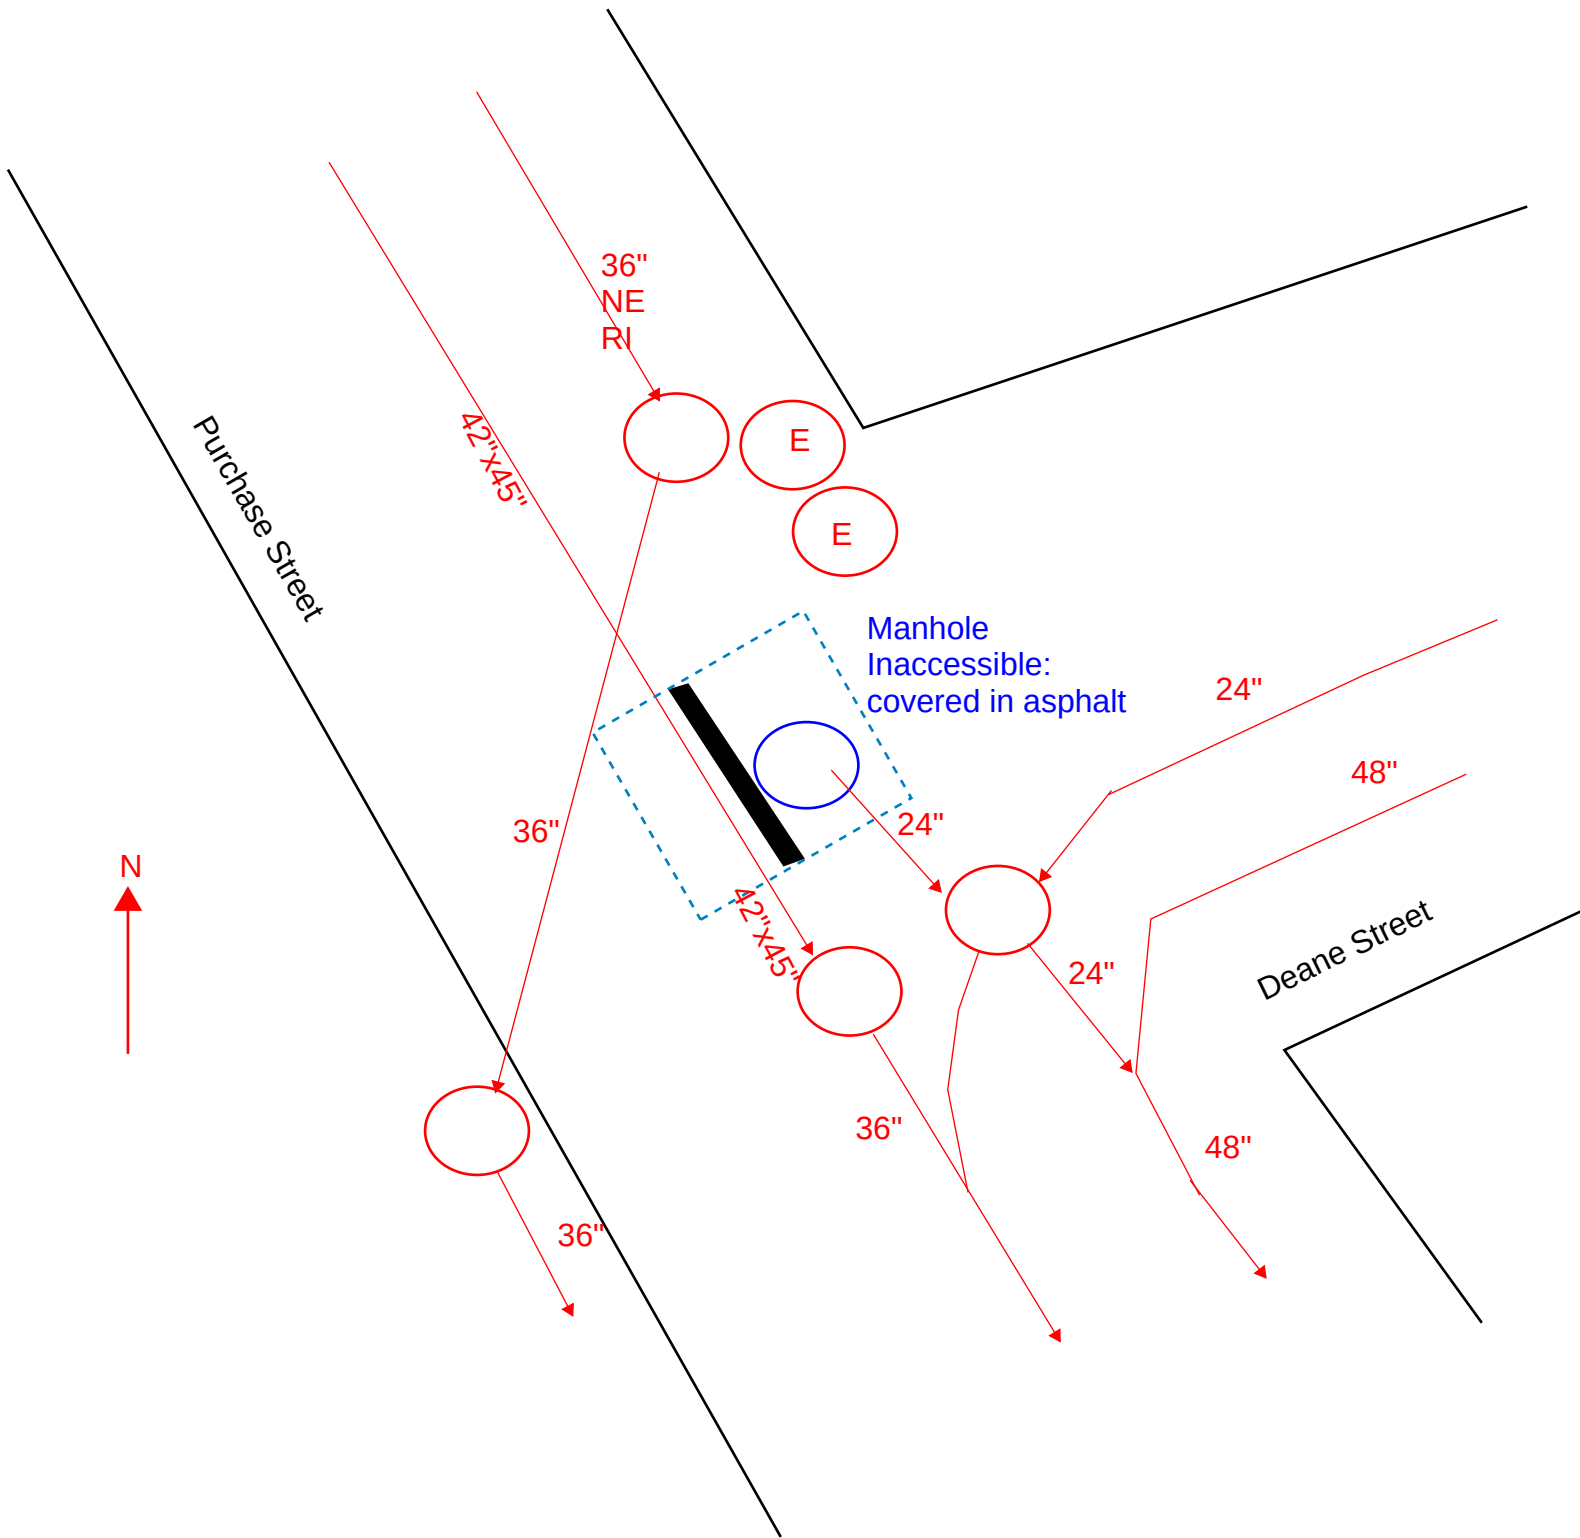


R-022F

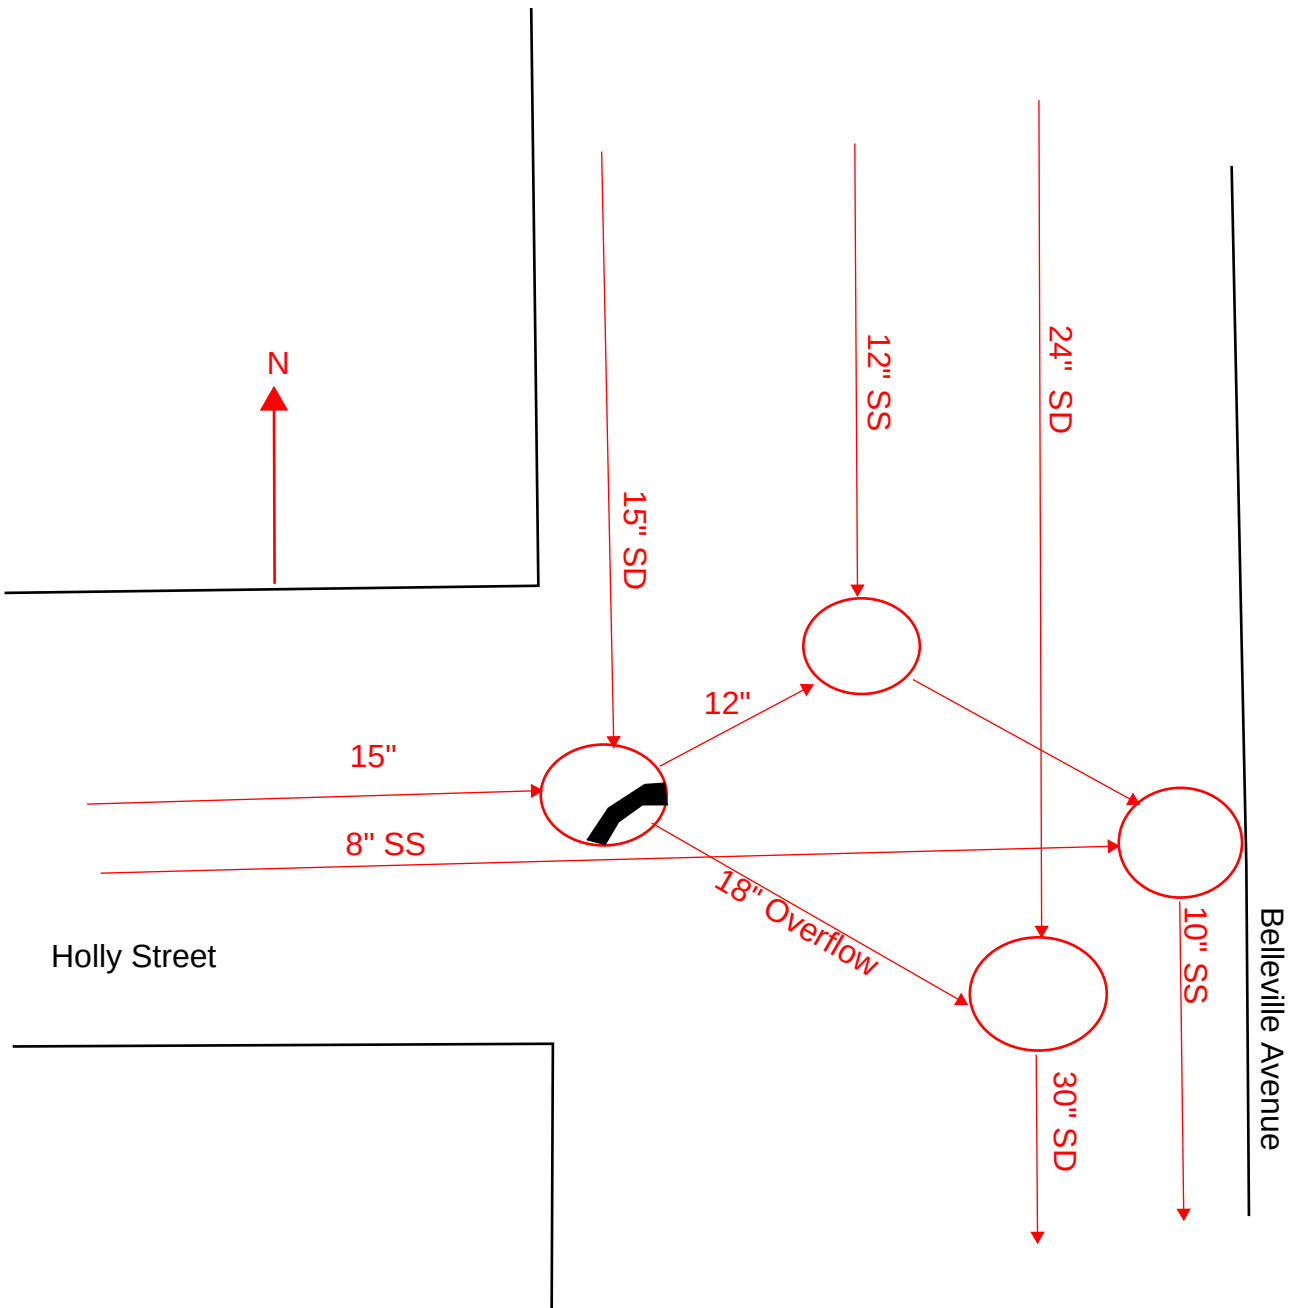

R-022G

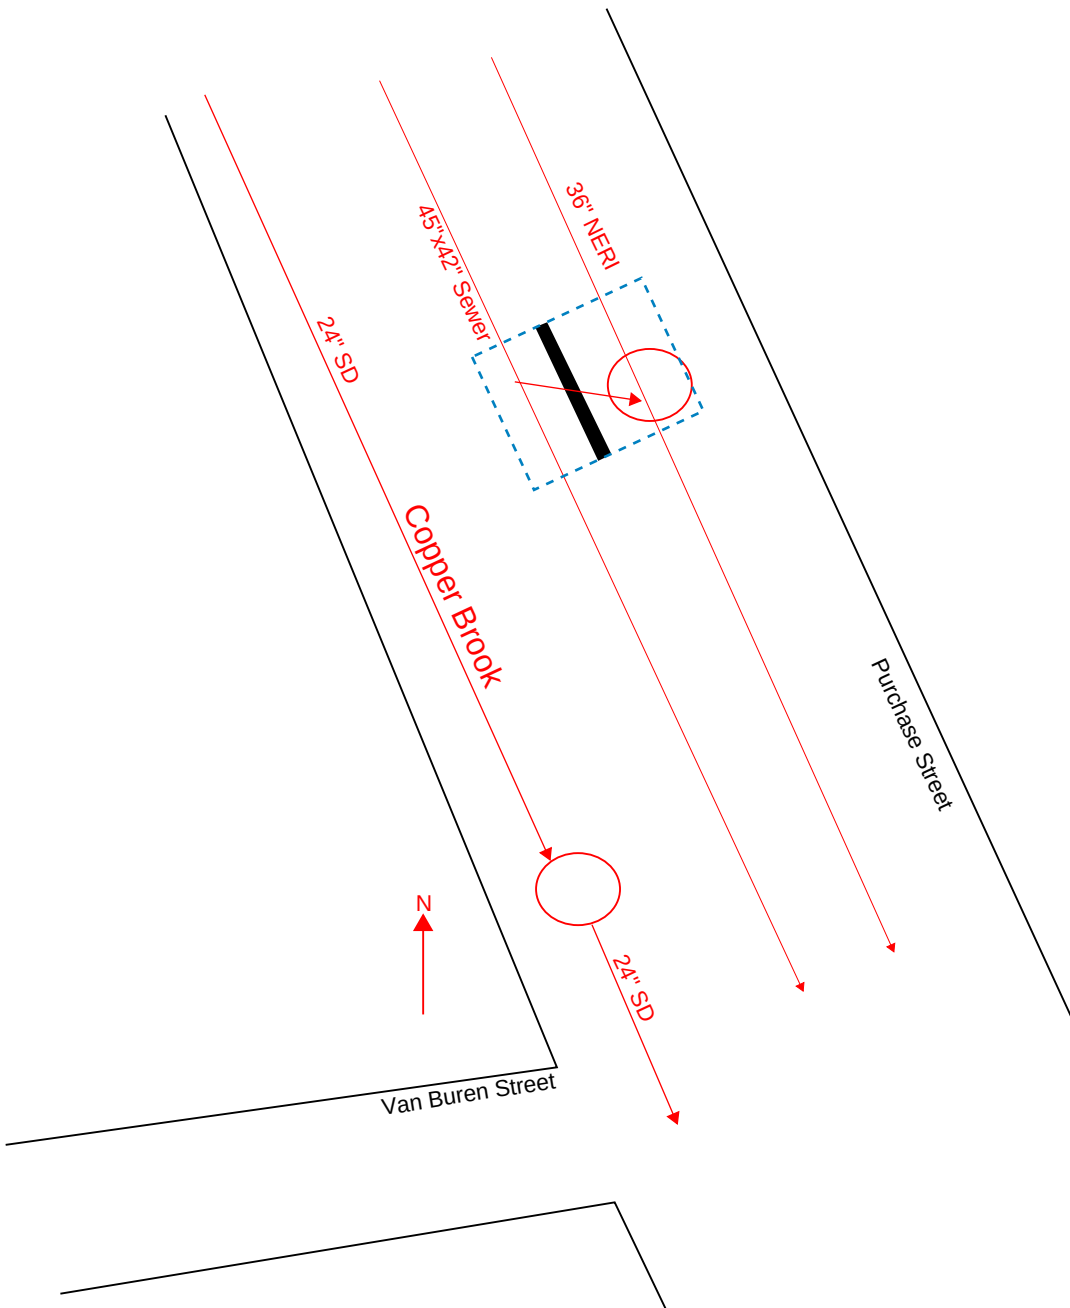


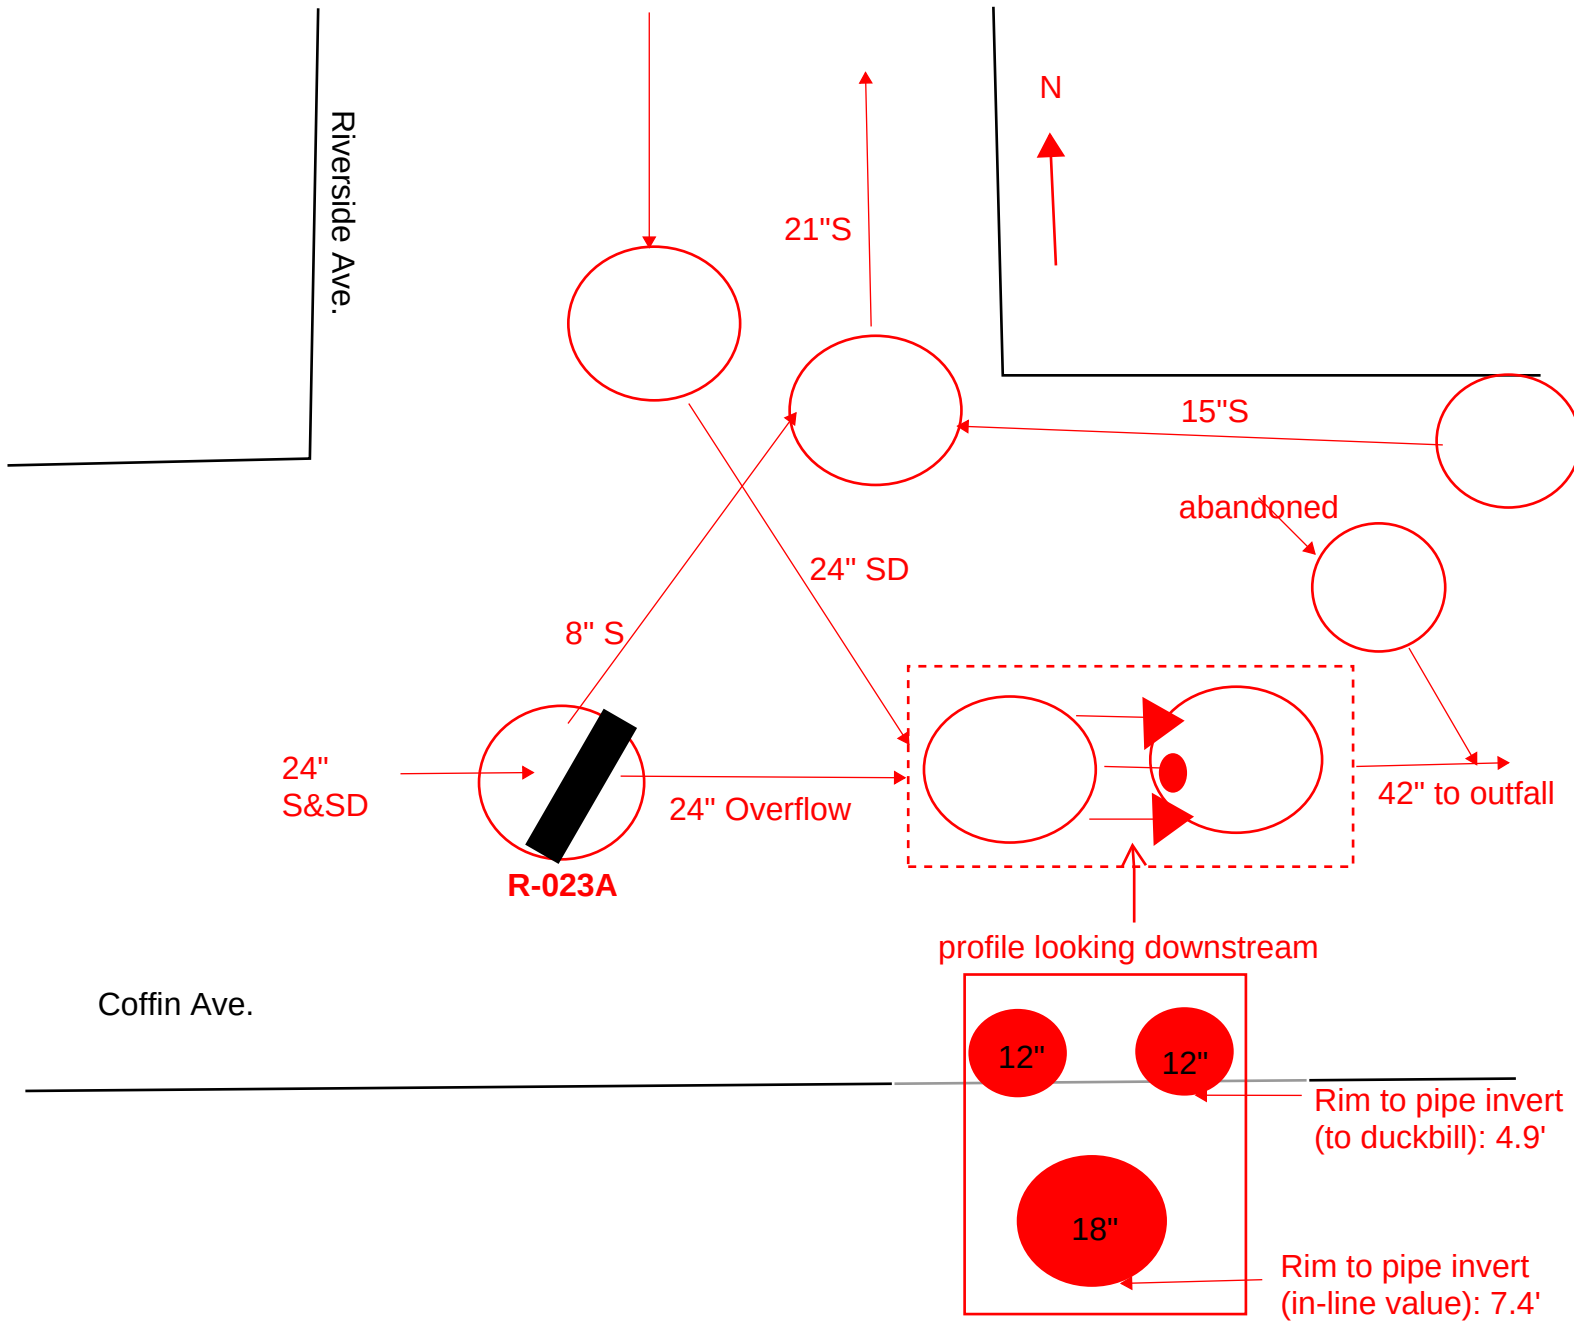


Rim to pipe invert
(to duckbill): 4.9'

Rim to pipe invert
(in-line value): 7.4'


R-023A

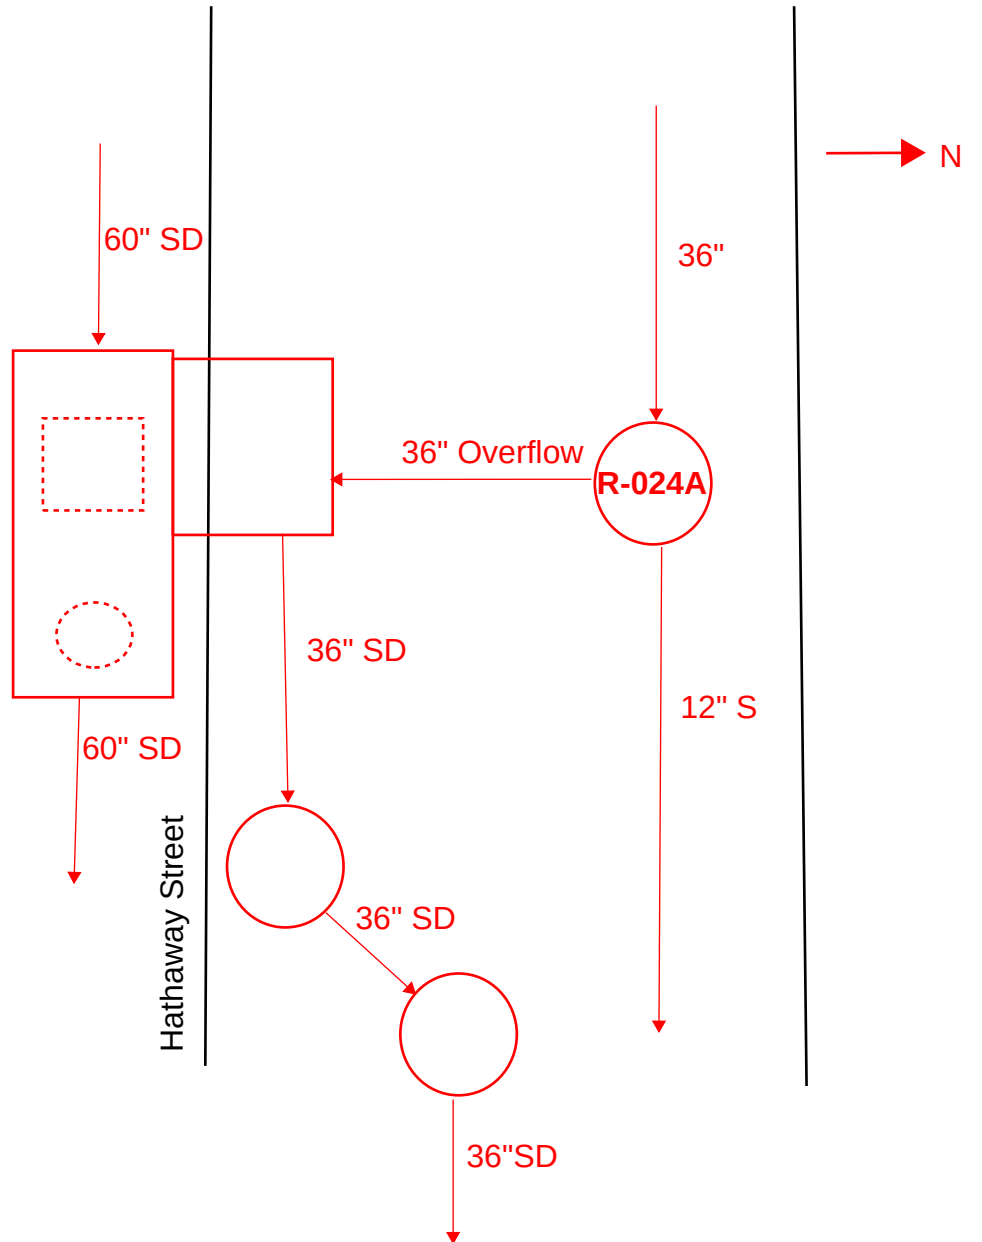


R-024A

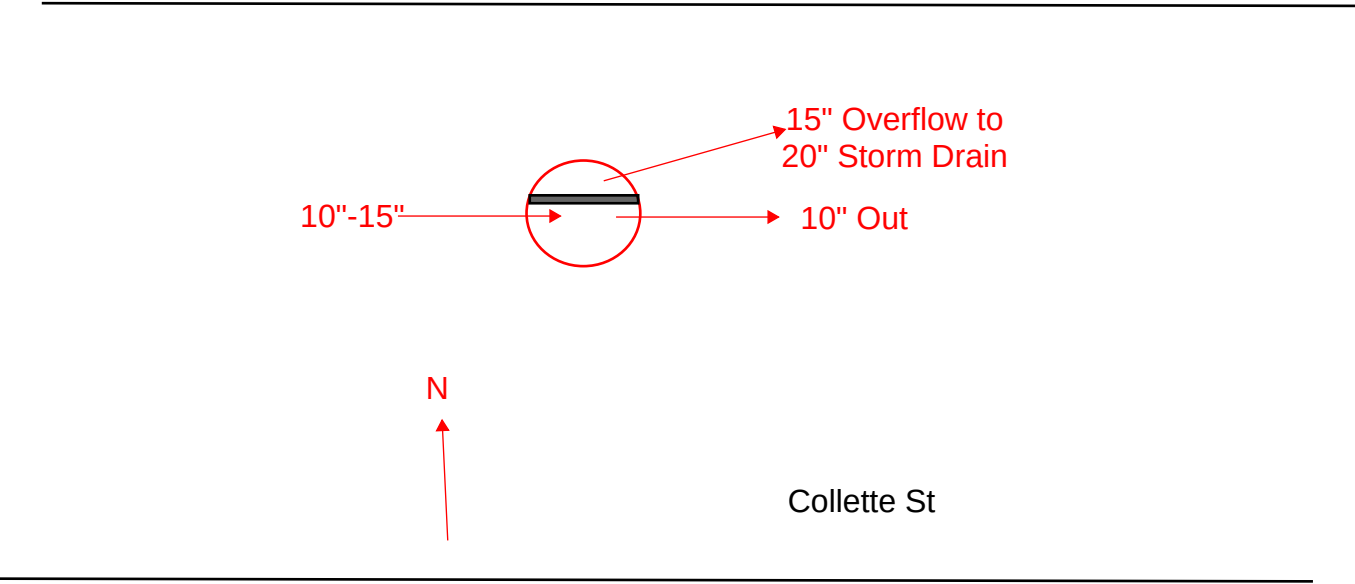


R-024B

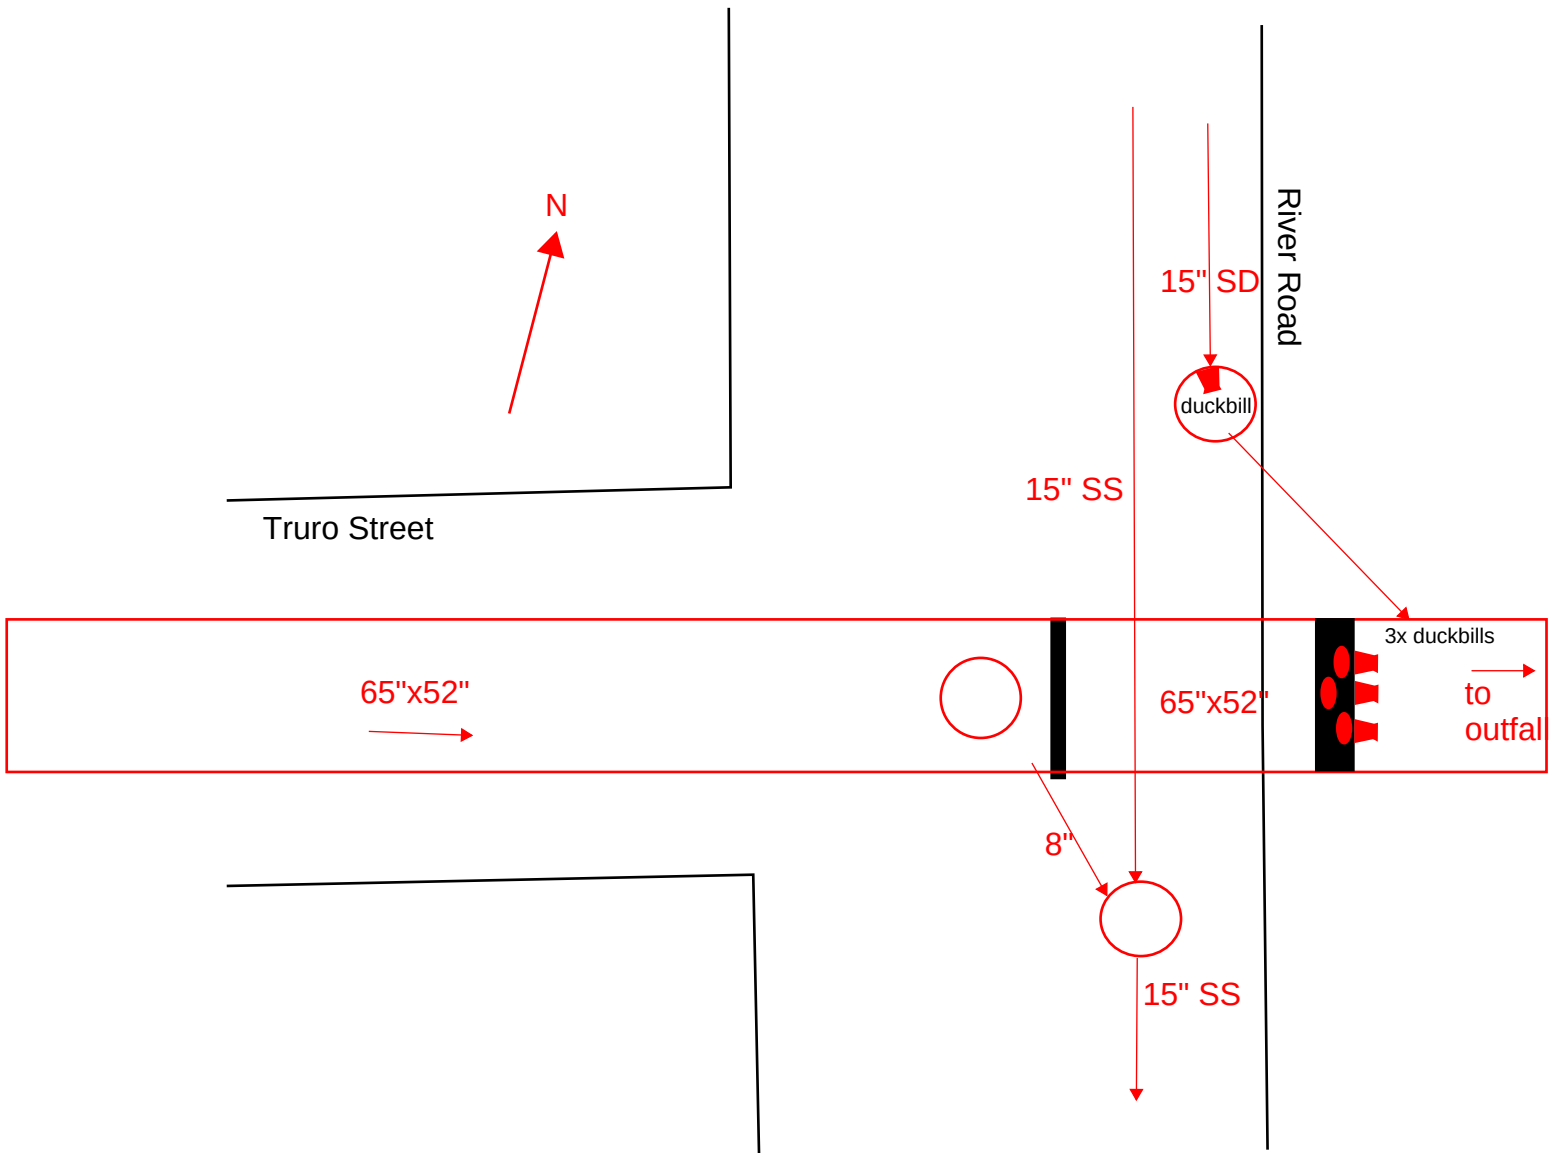


R-026A

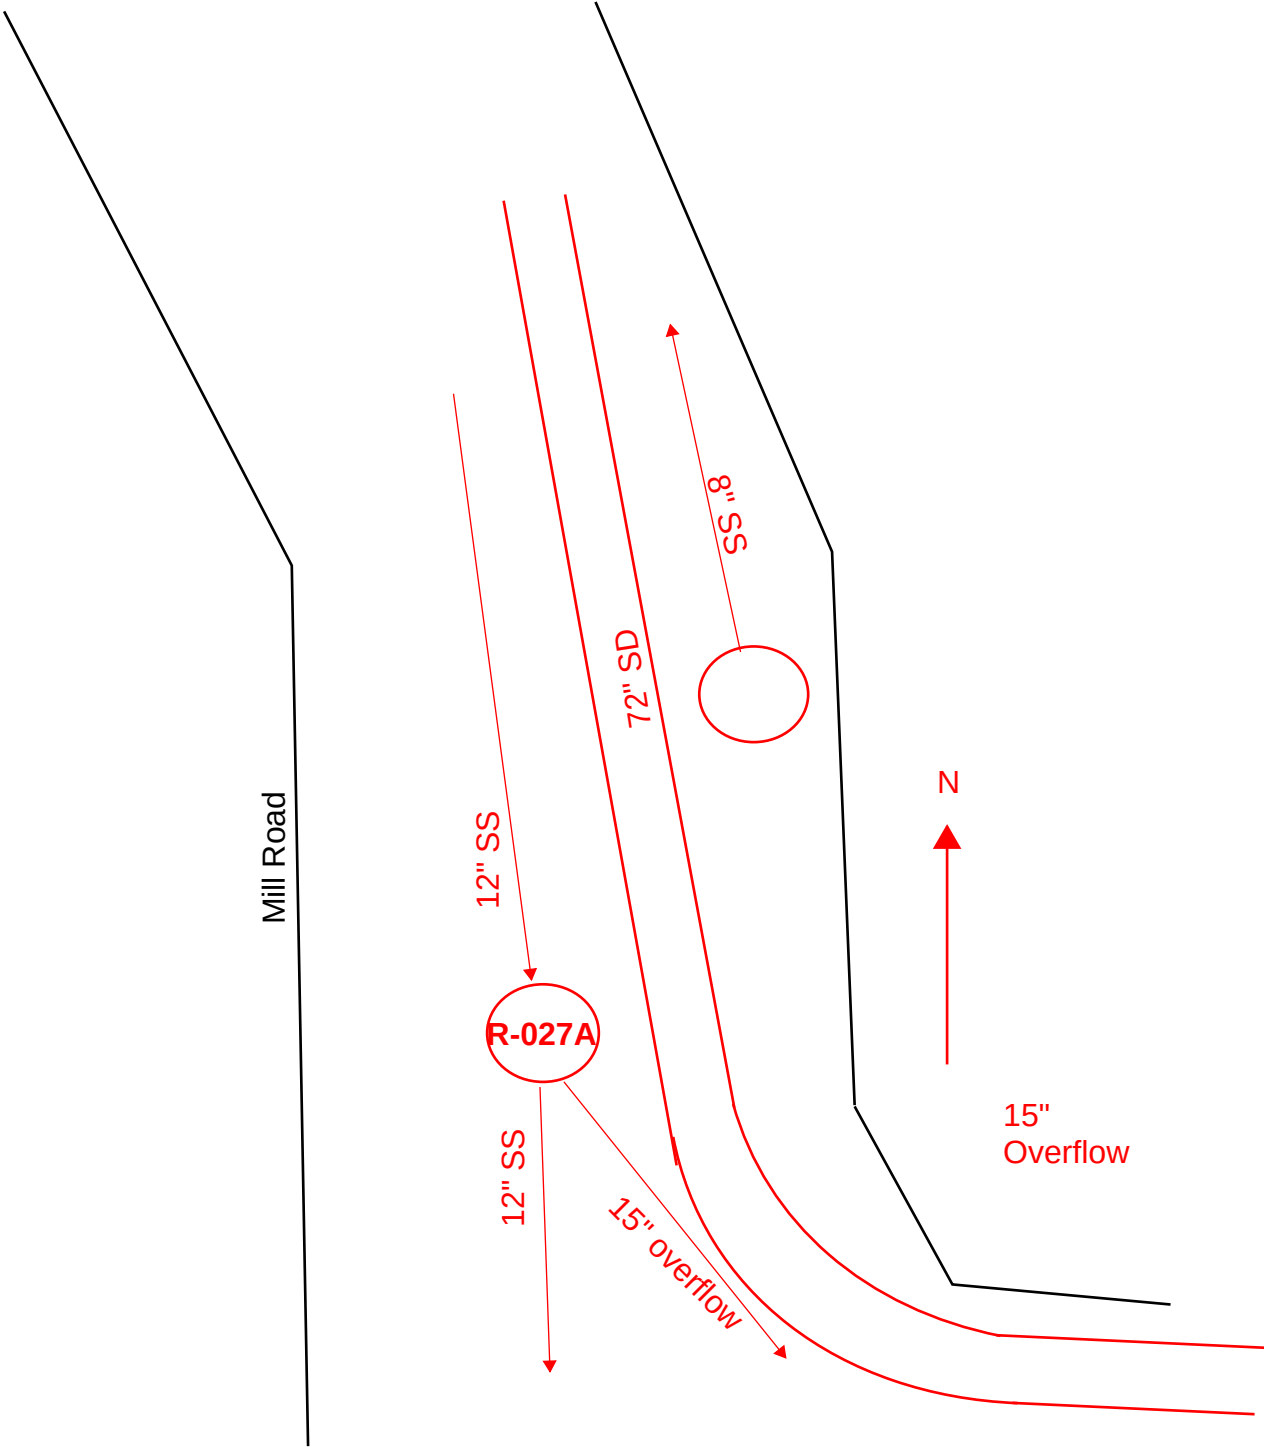

R-027A

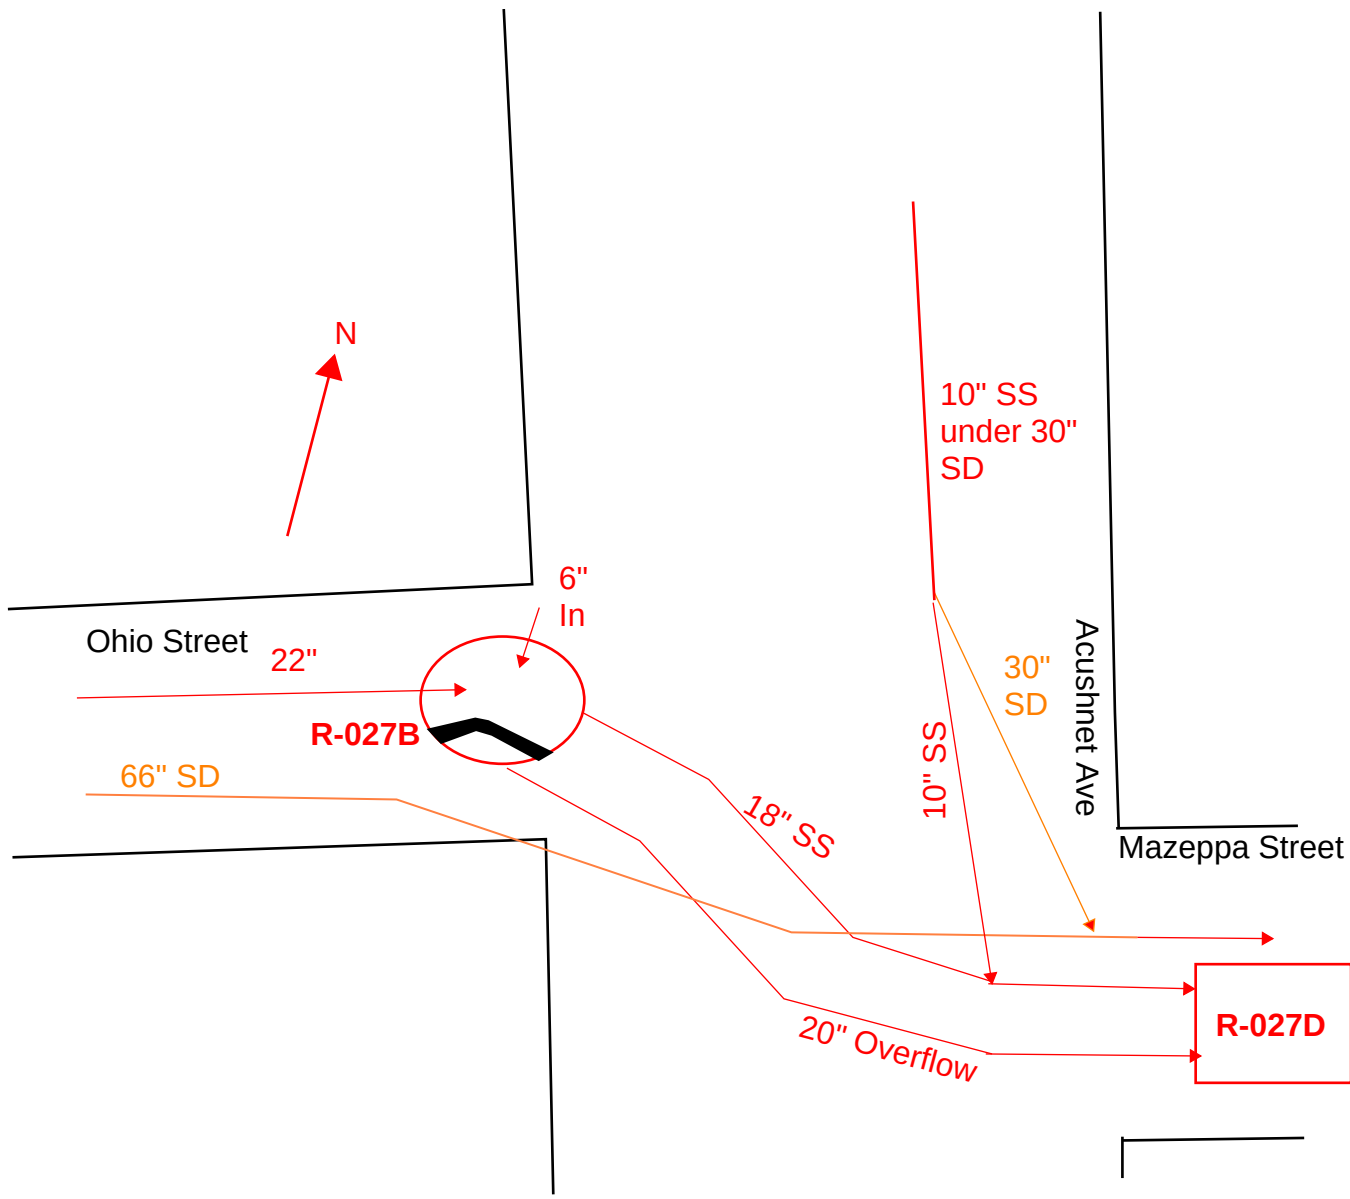

R-027B

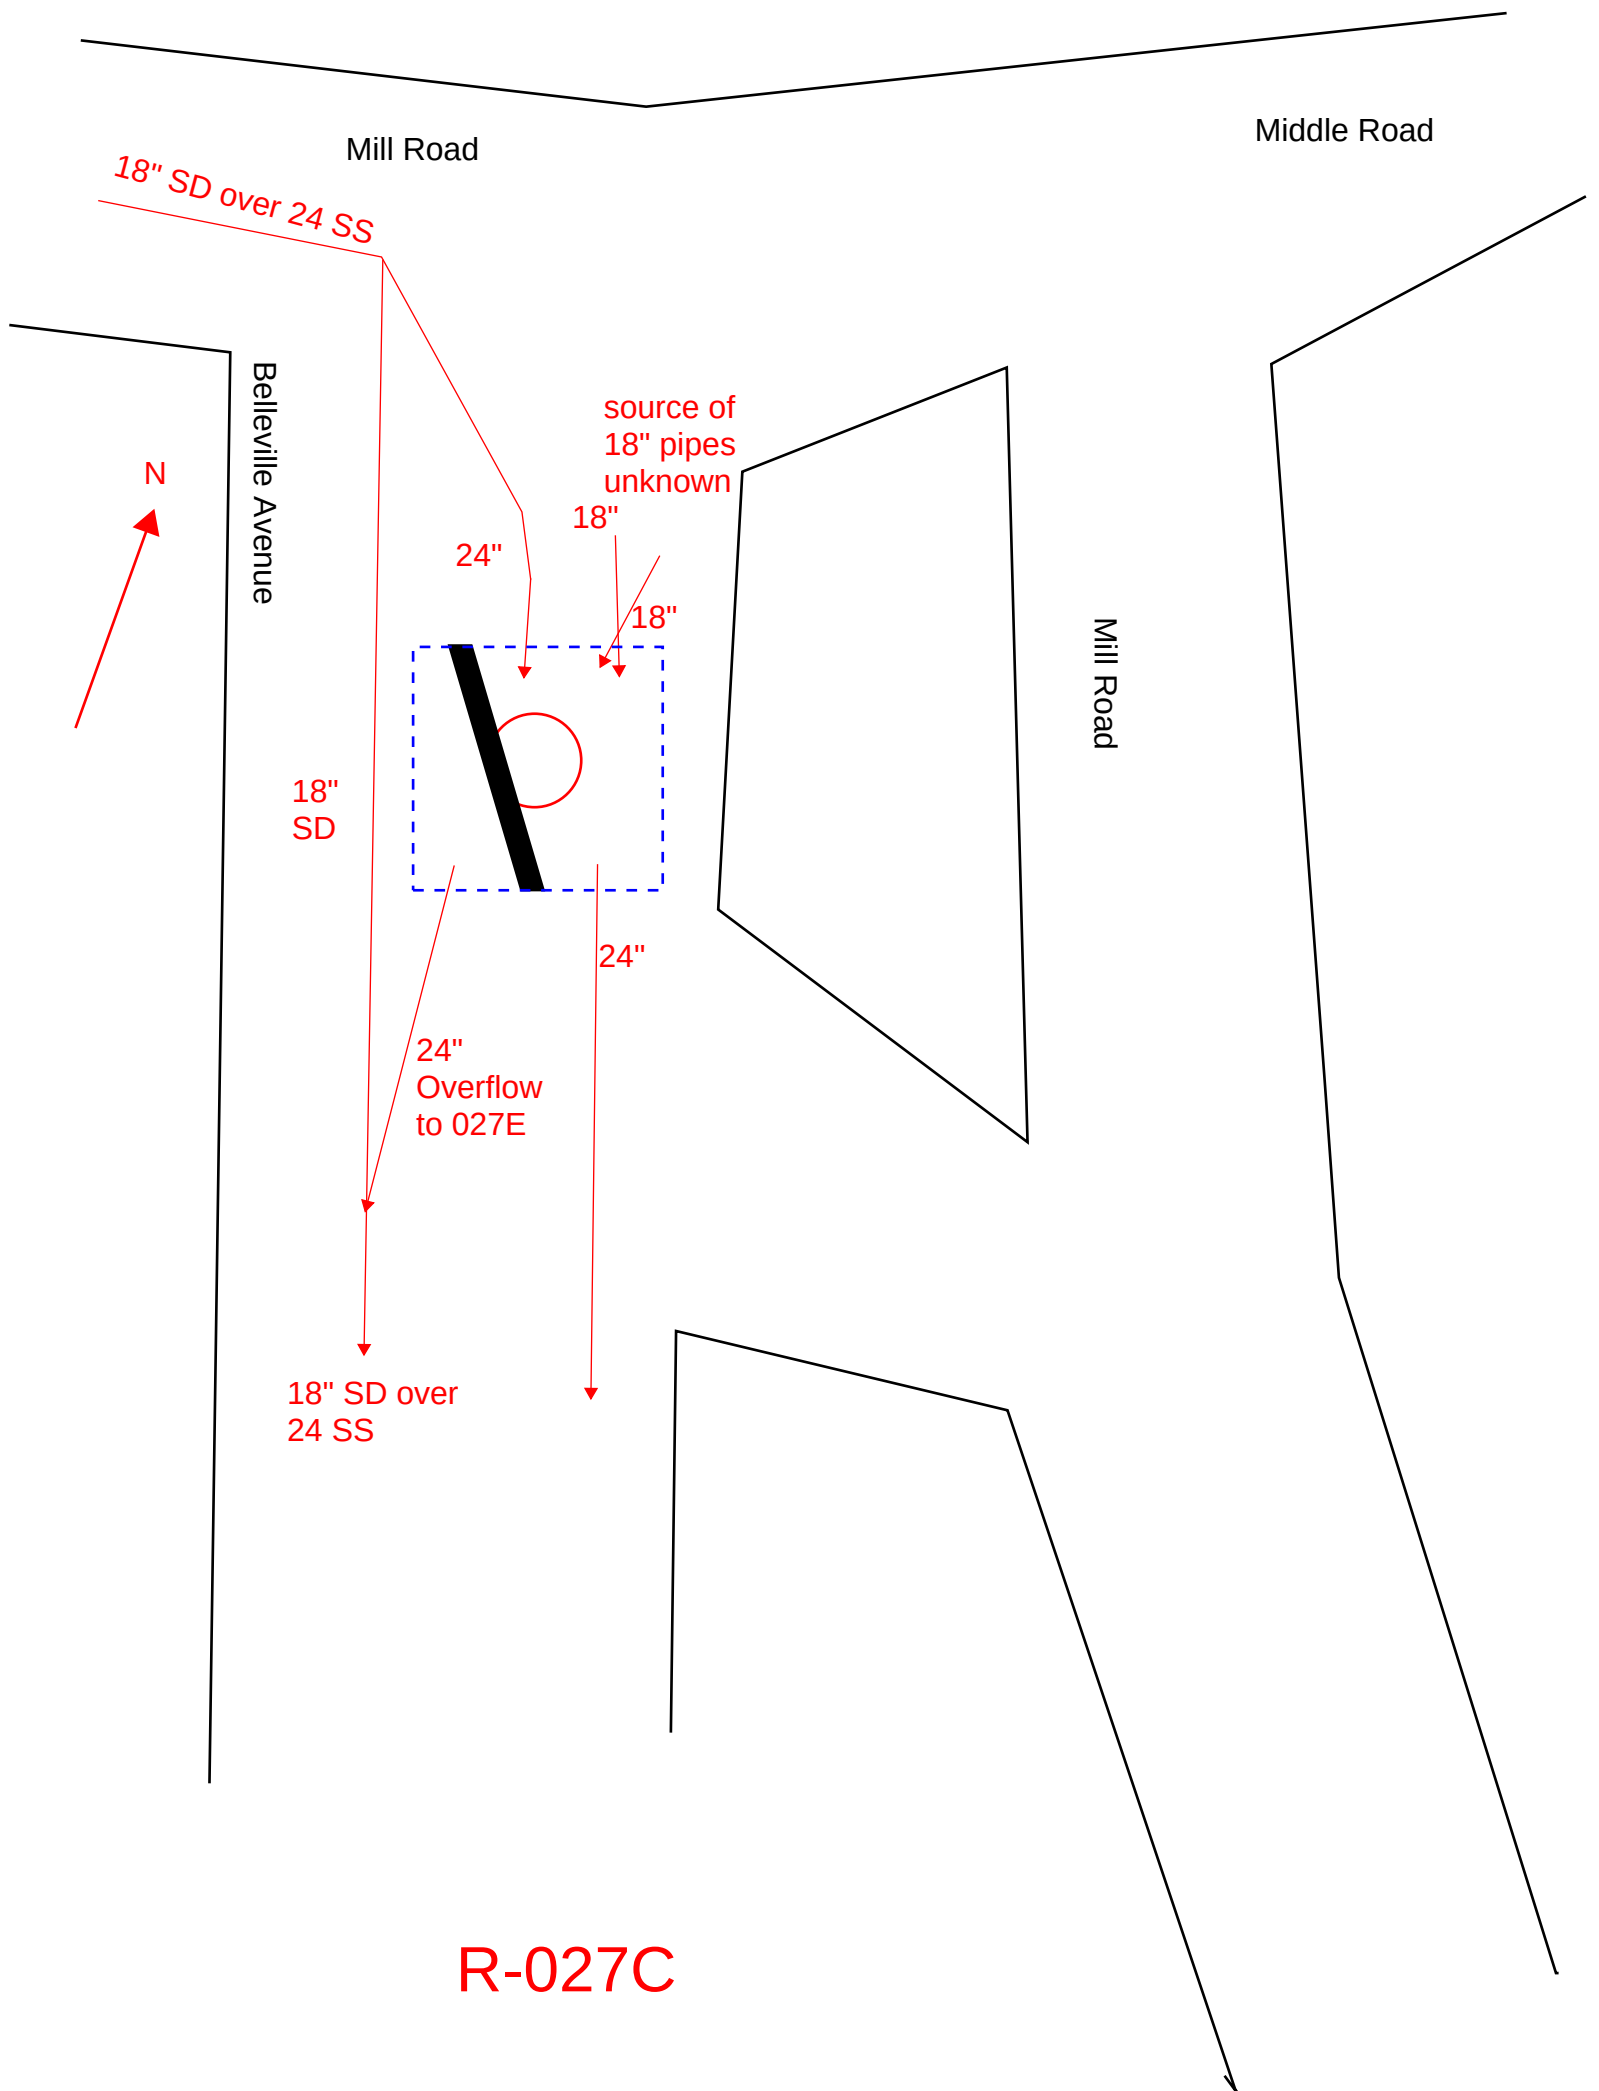

Mill Road

Middle Road

18" SD over 24 SS

Belleville Avenue

N

source of
18" pipes
unknown

24"

18"

18"

18"
SD


24"

24"
Overflow
to 027E


18" SD over
24 SS

Mill Road


R-027C

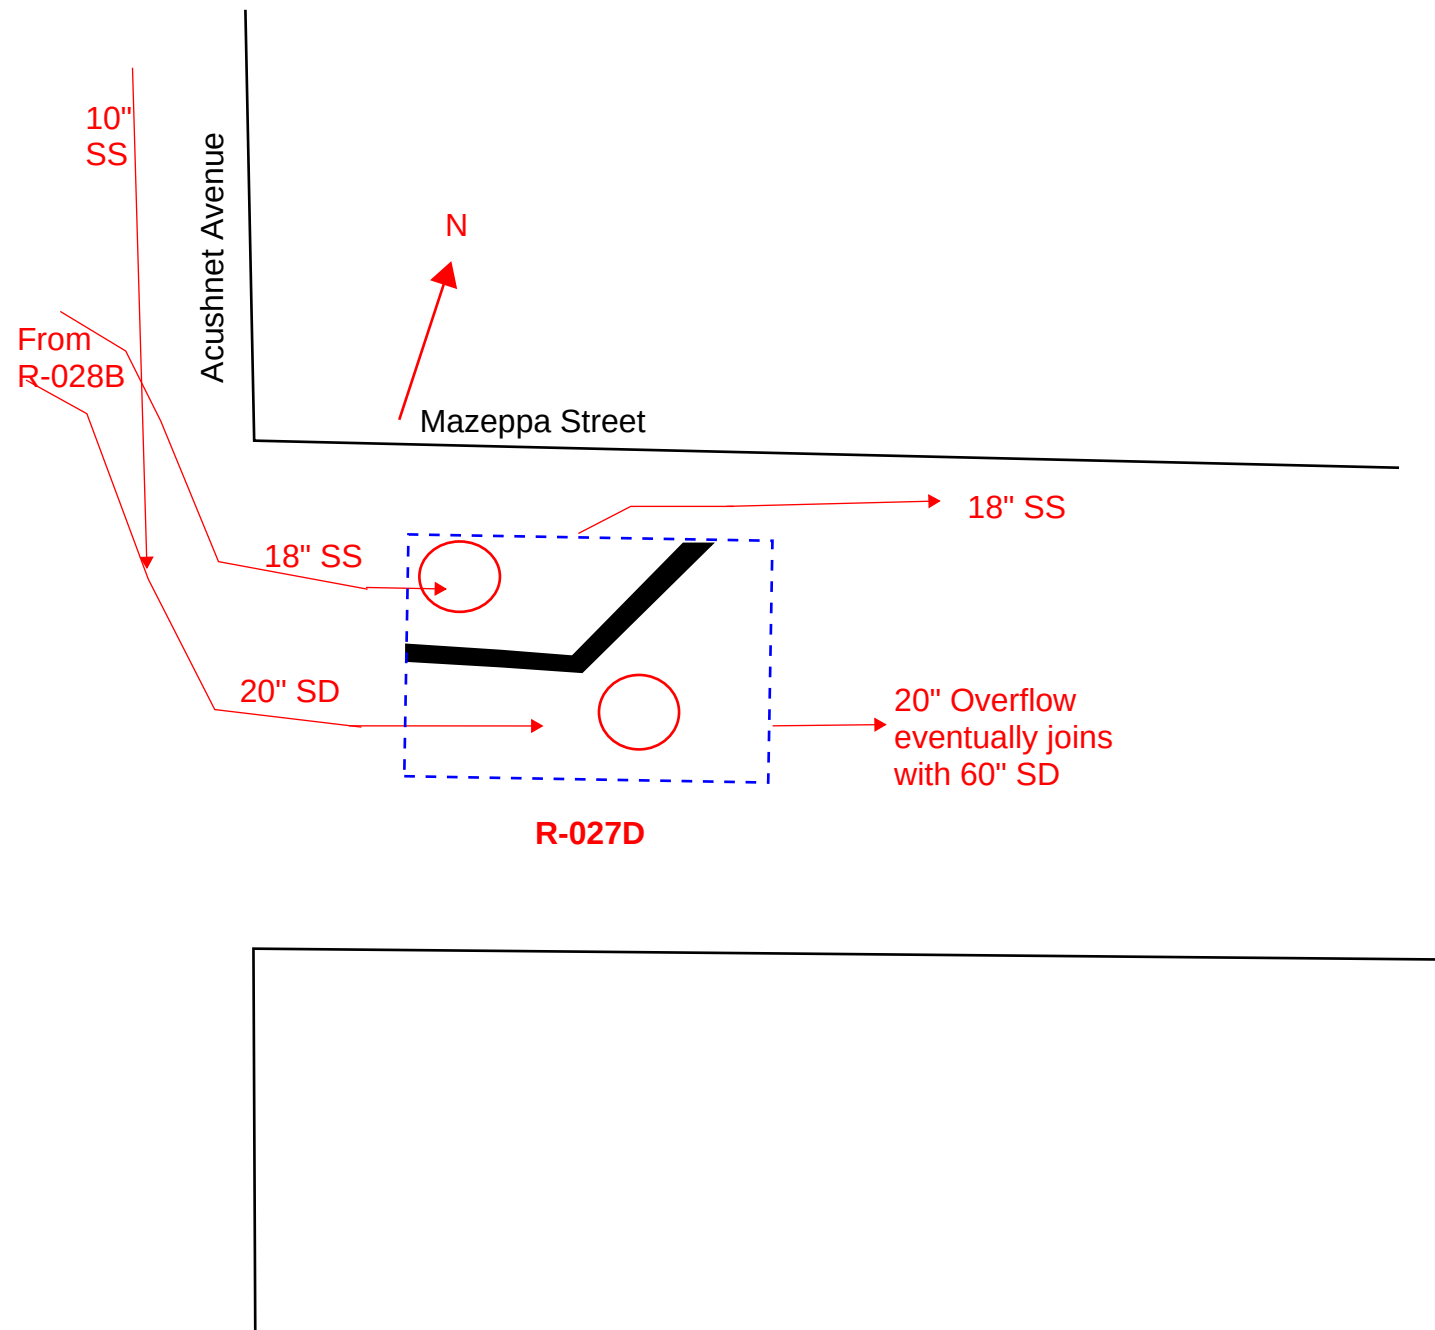


R-027D

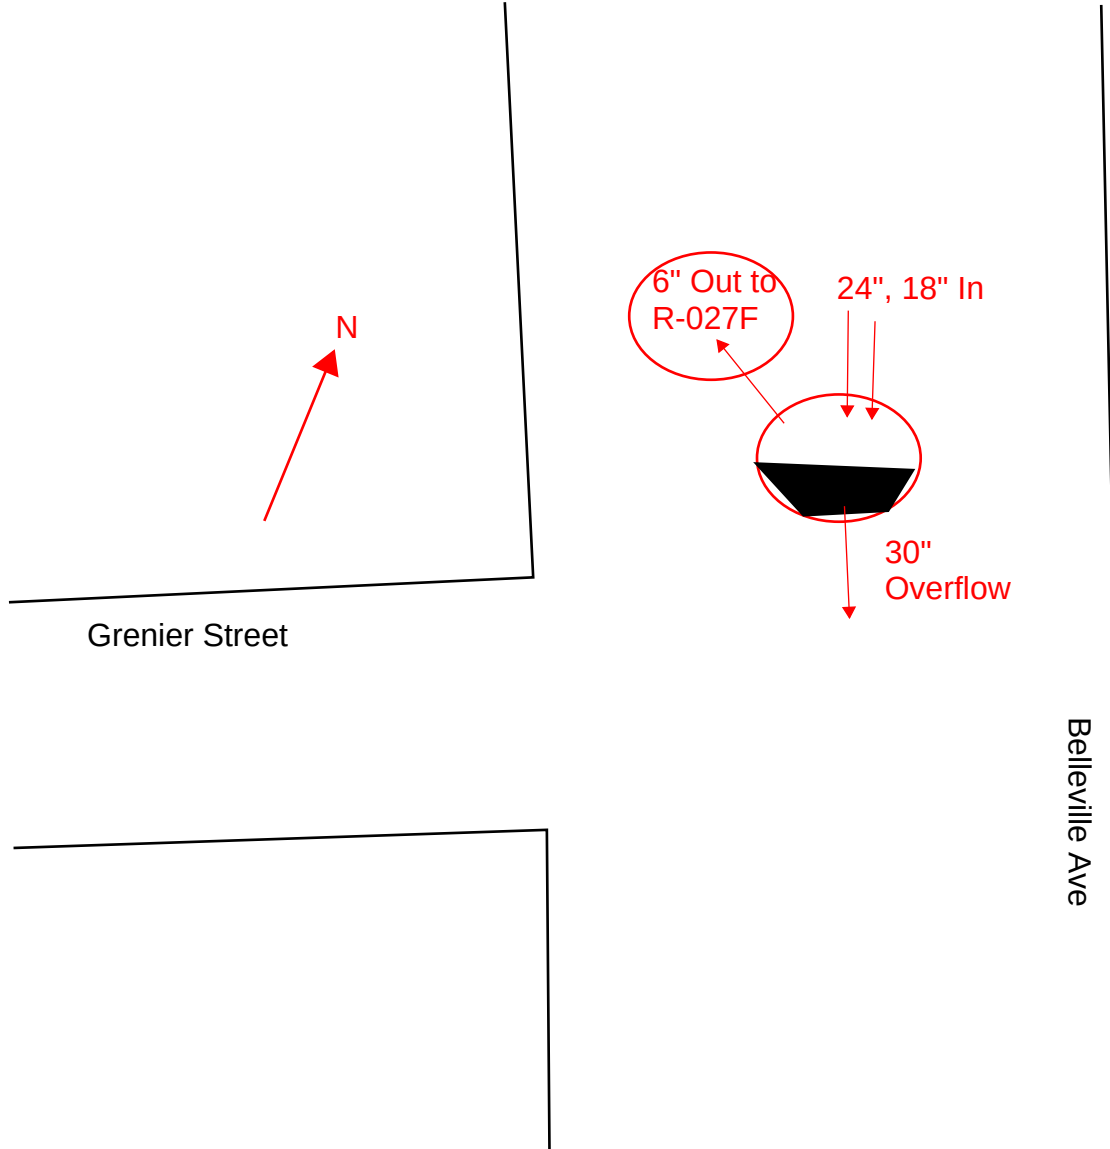


R-027E

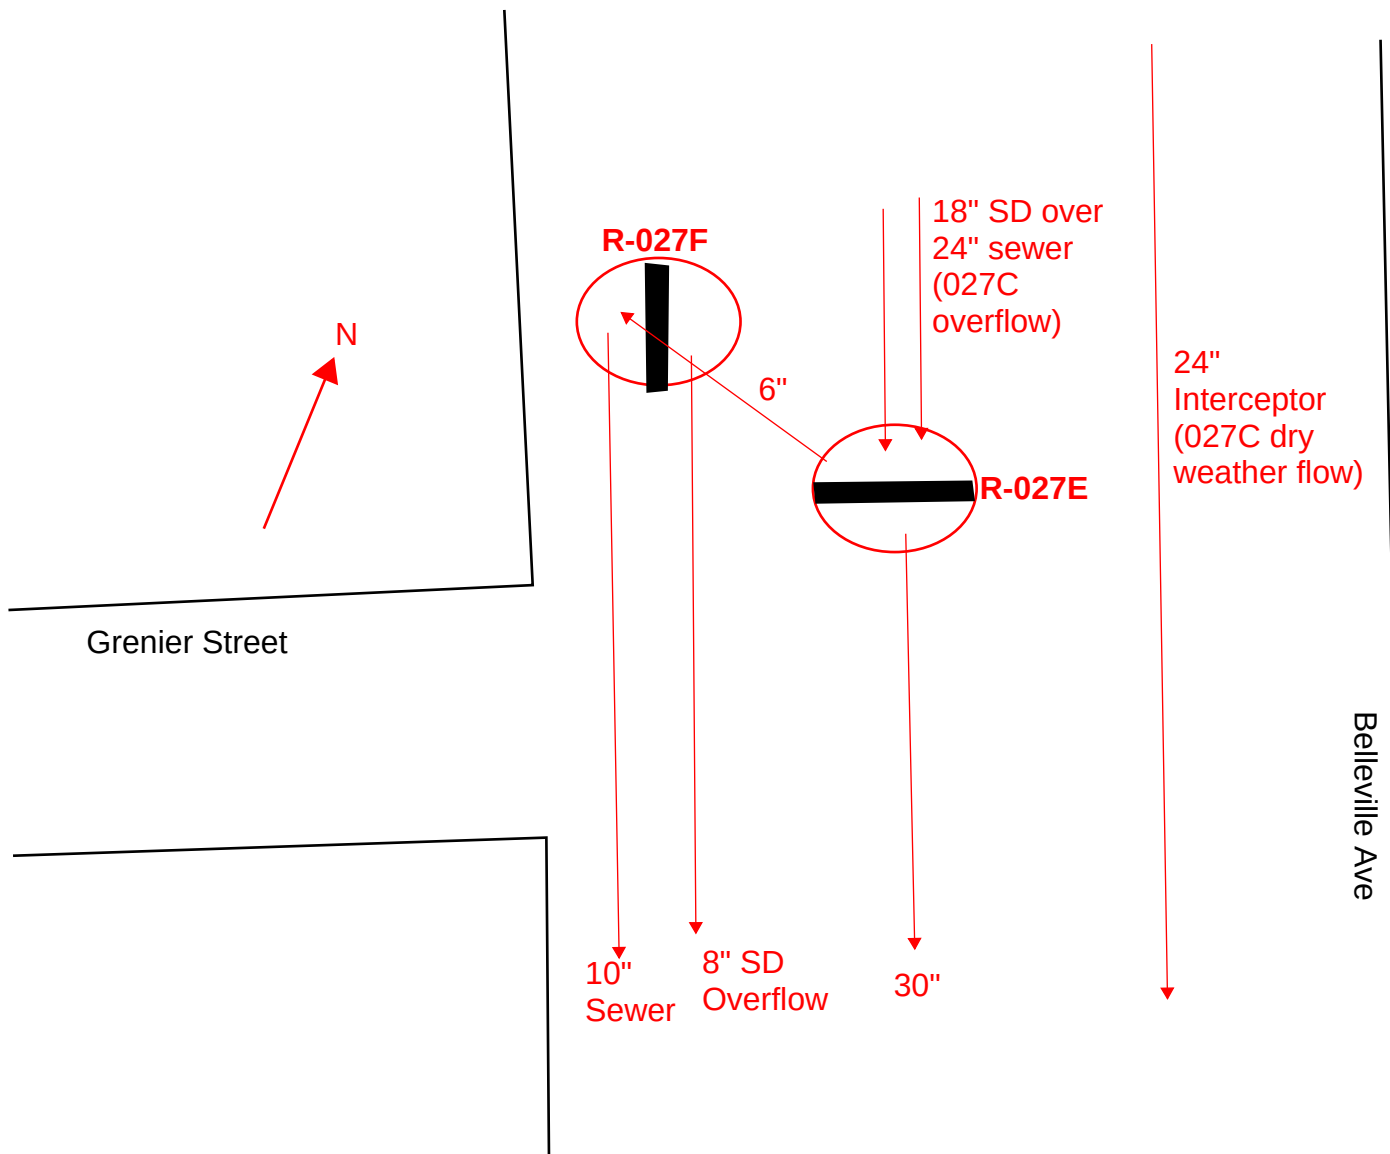


R-027F

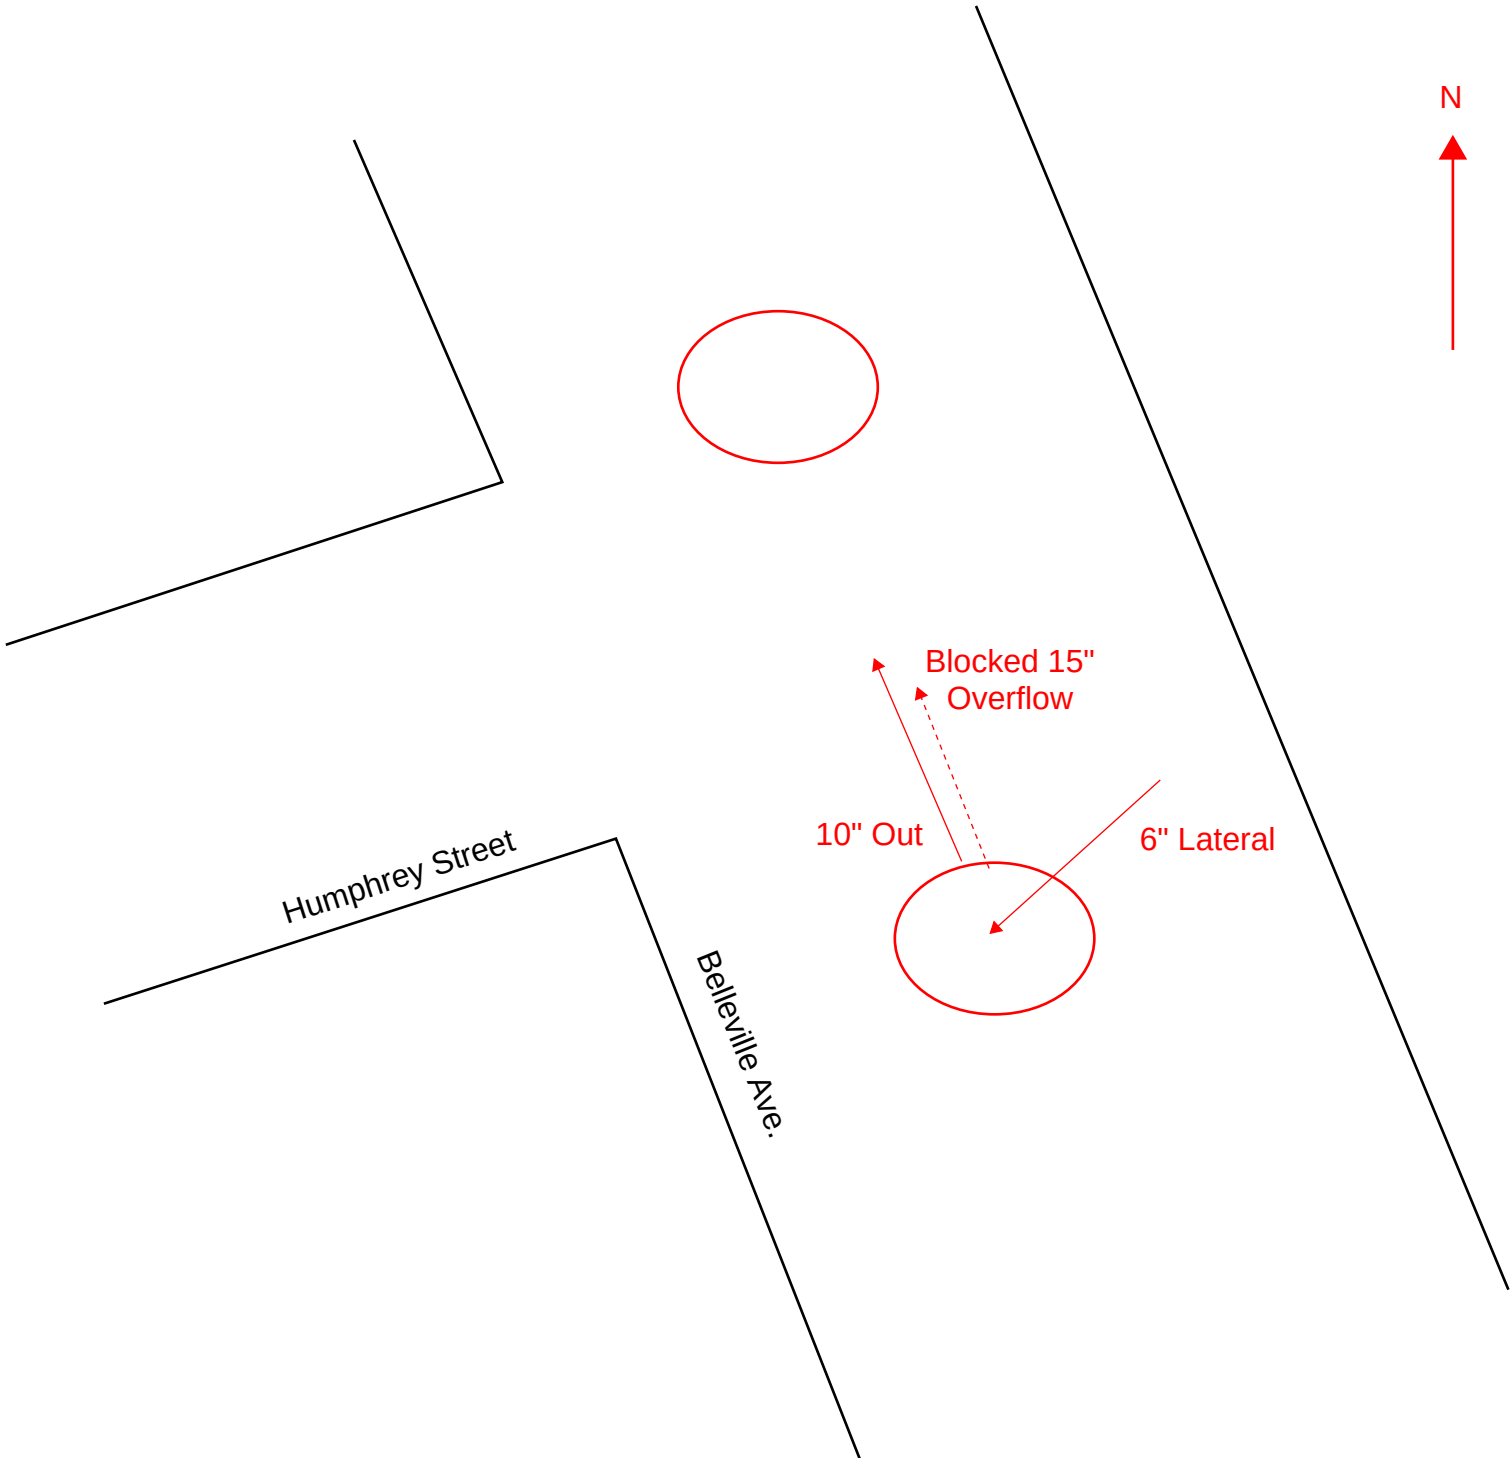


R-027G

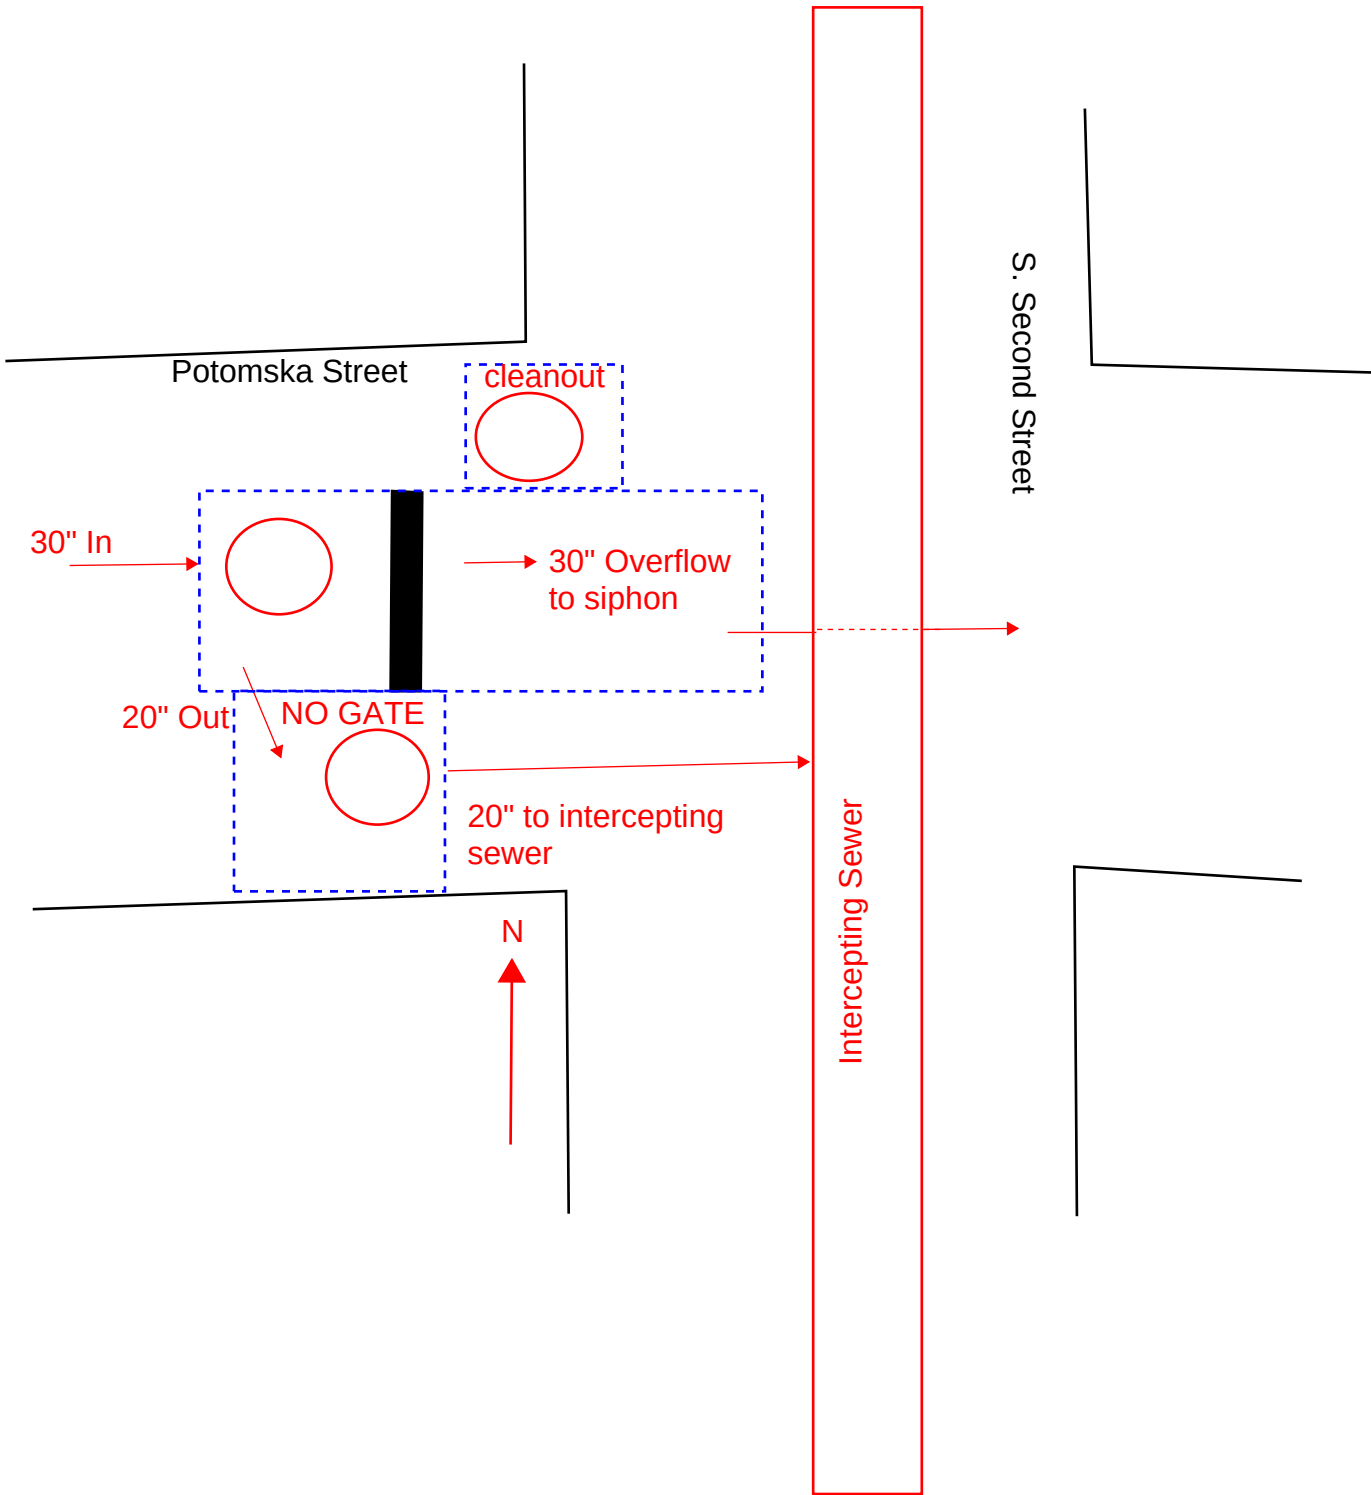


R-030A

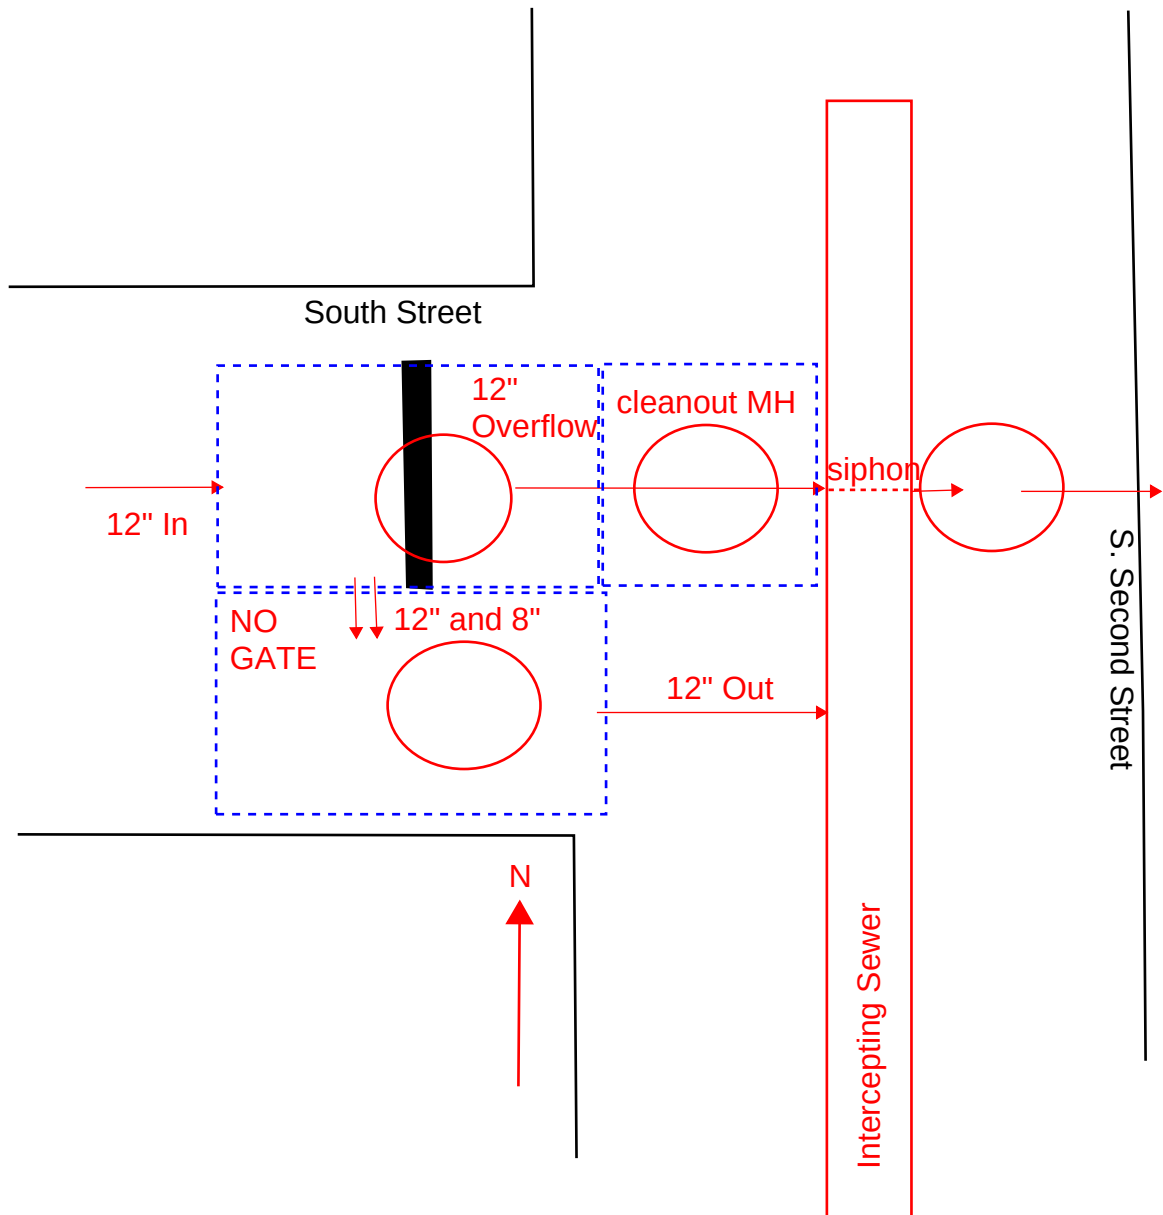


R-030B

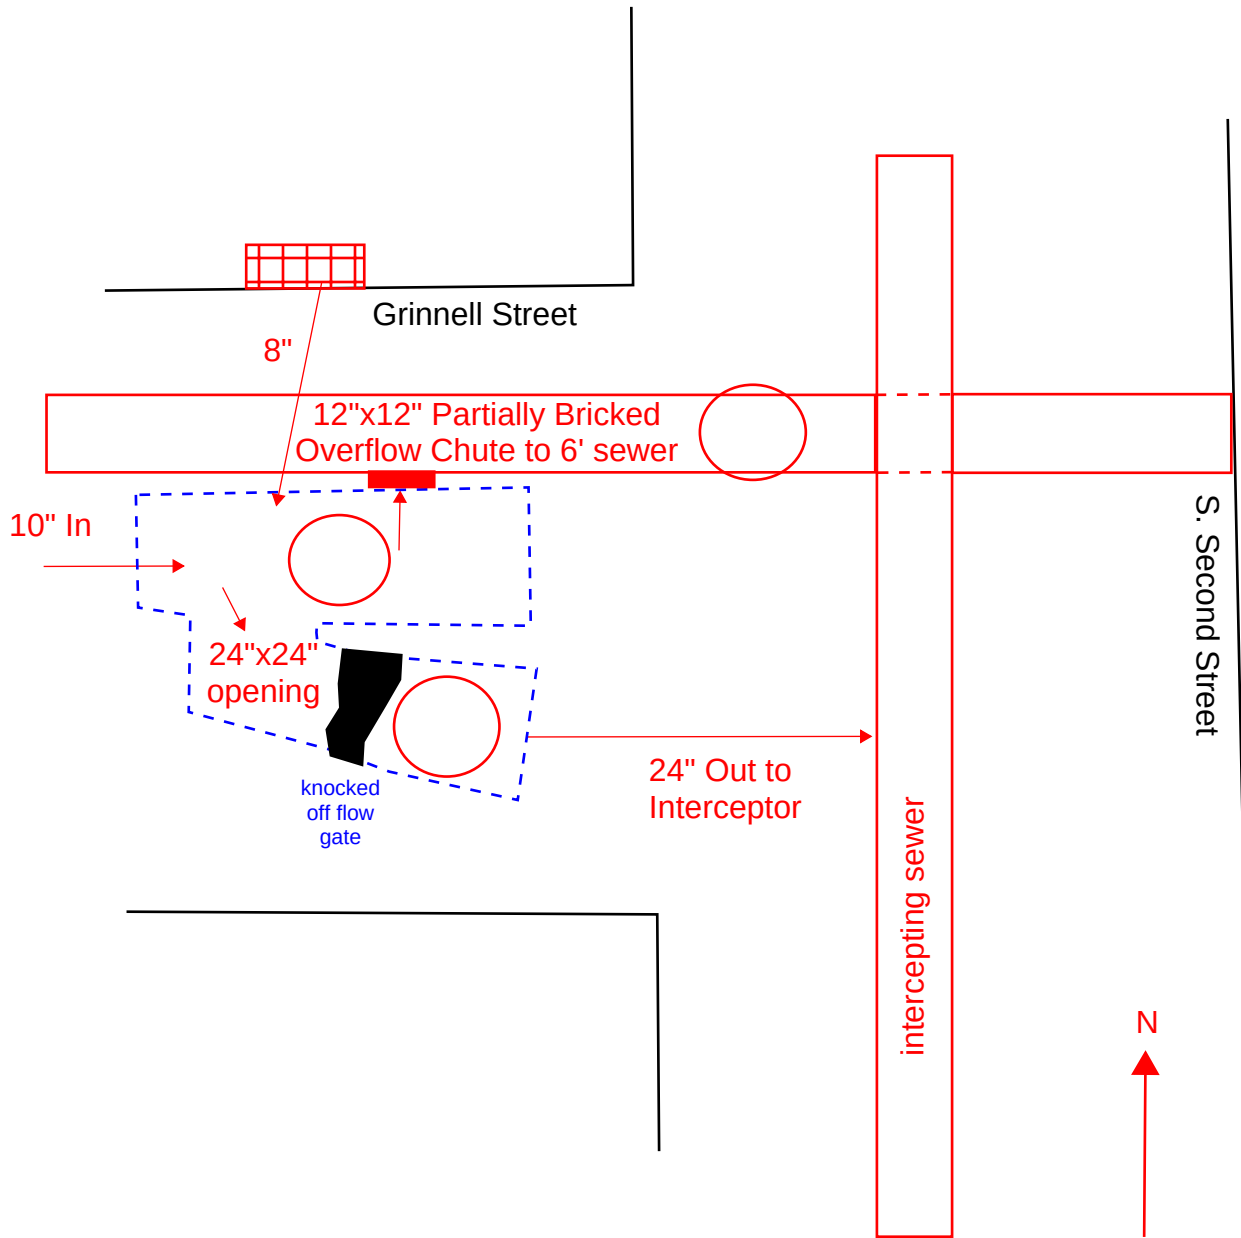


R-031A

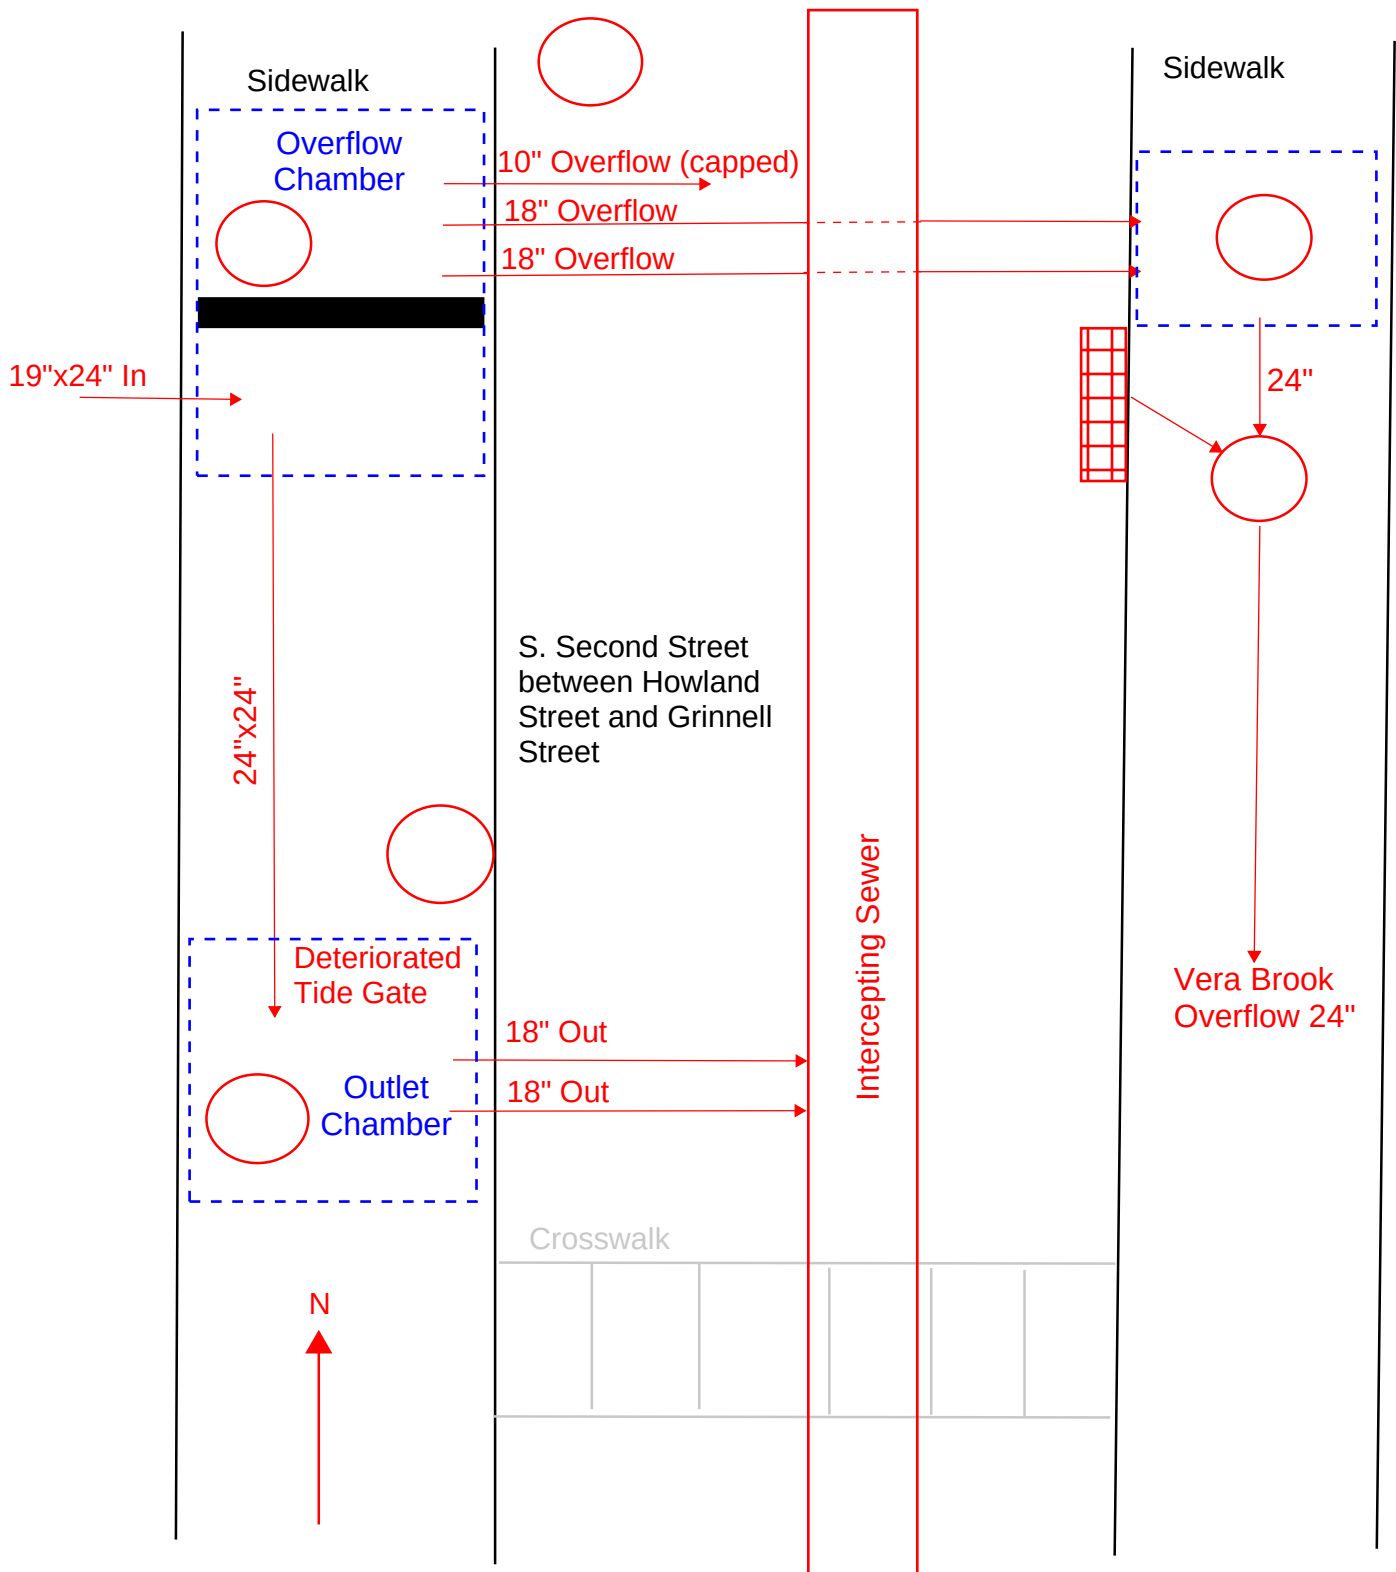

R-031B

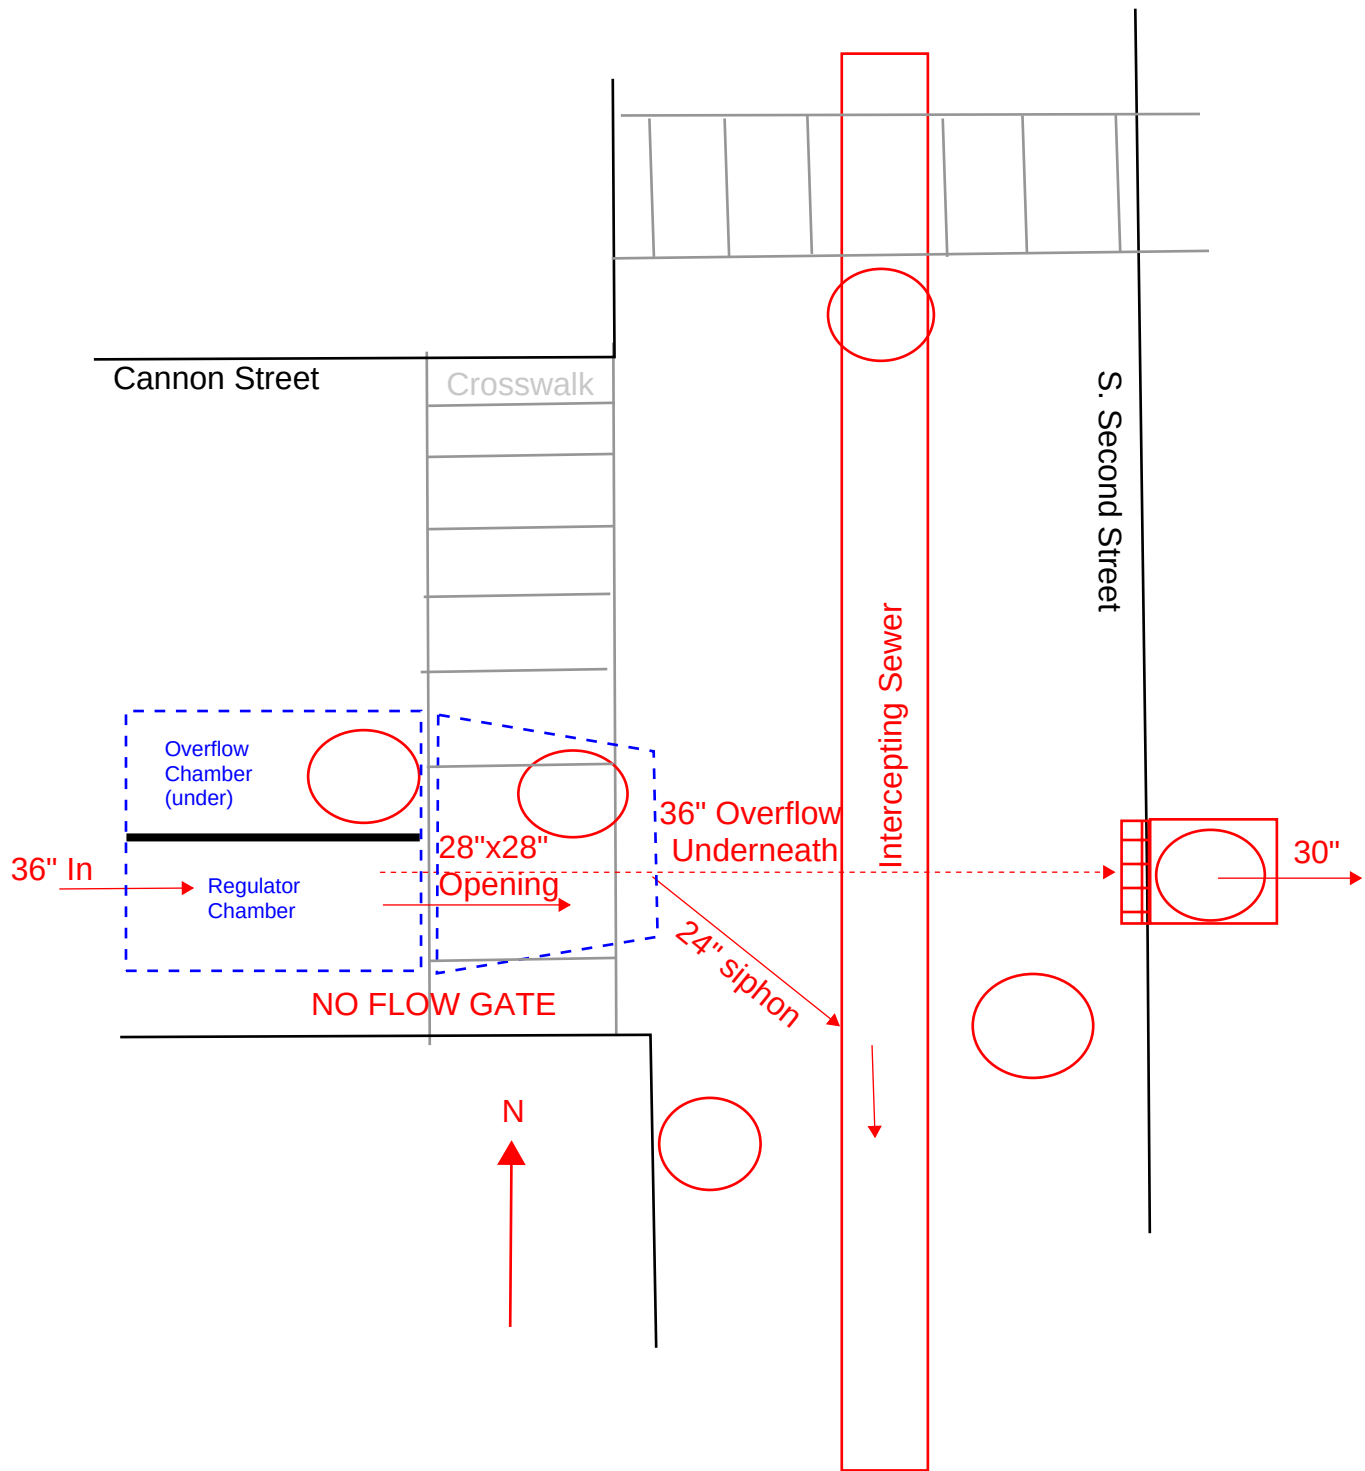



R-031C

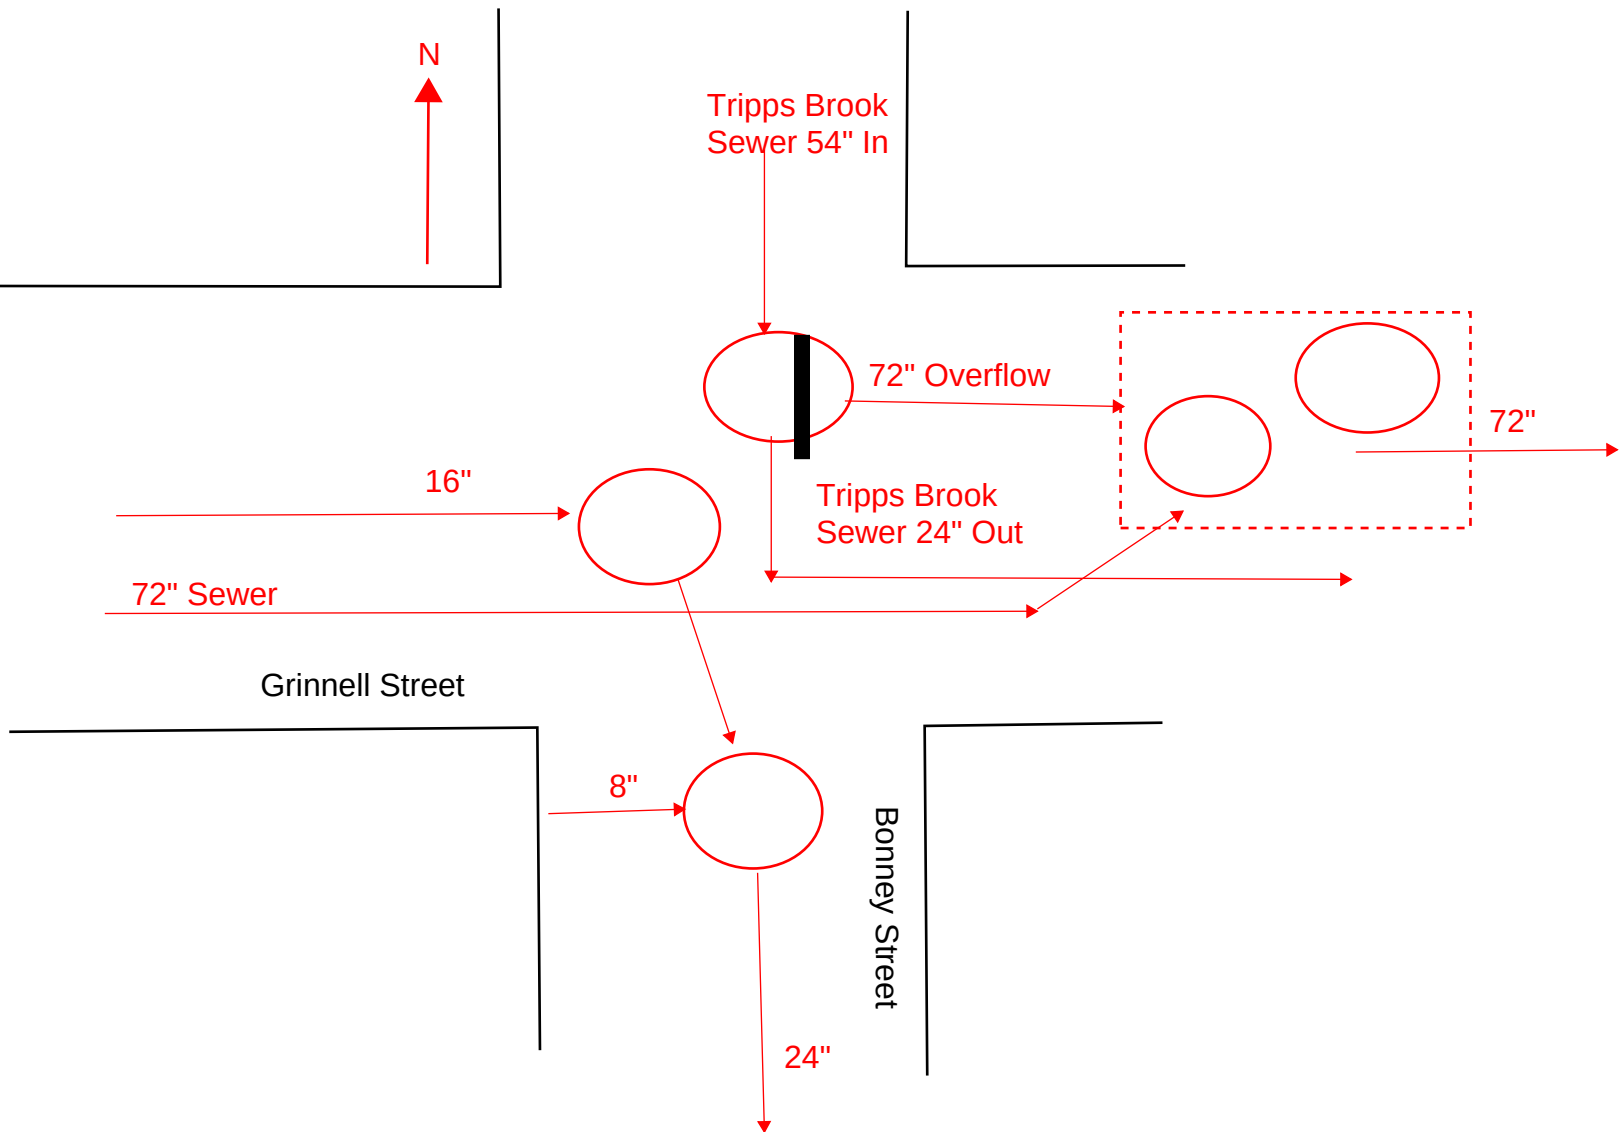


R-031D

R-031E

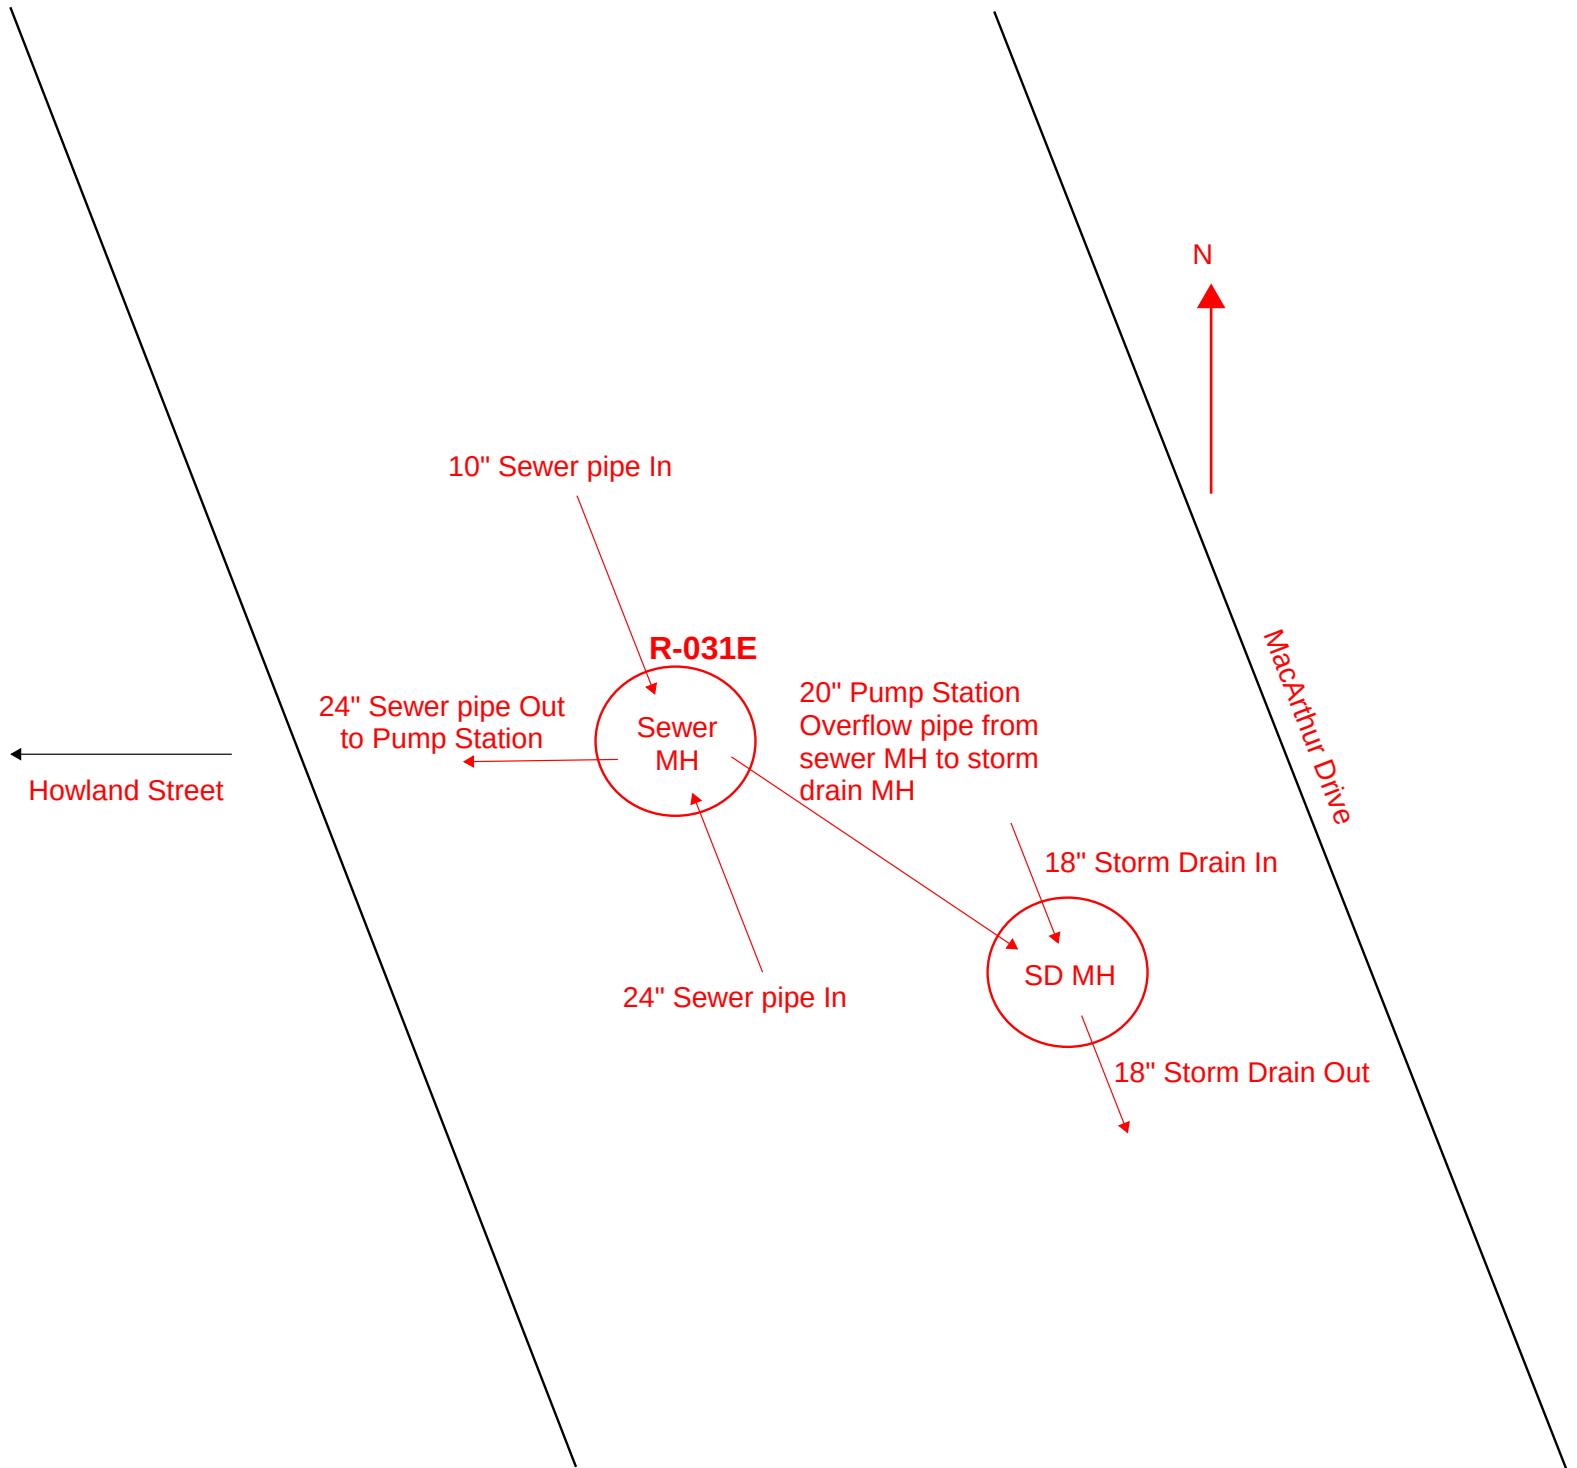


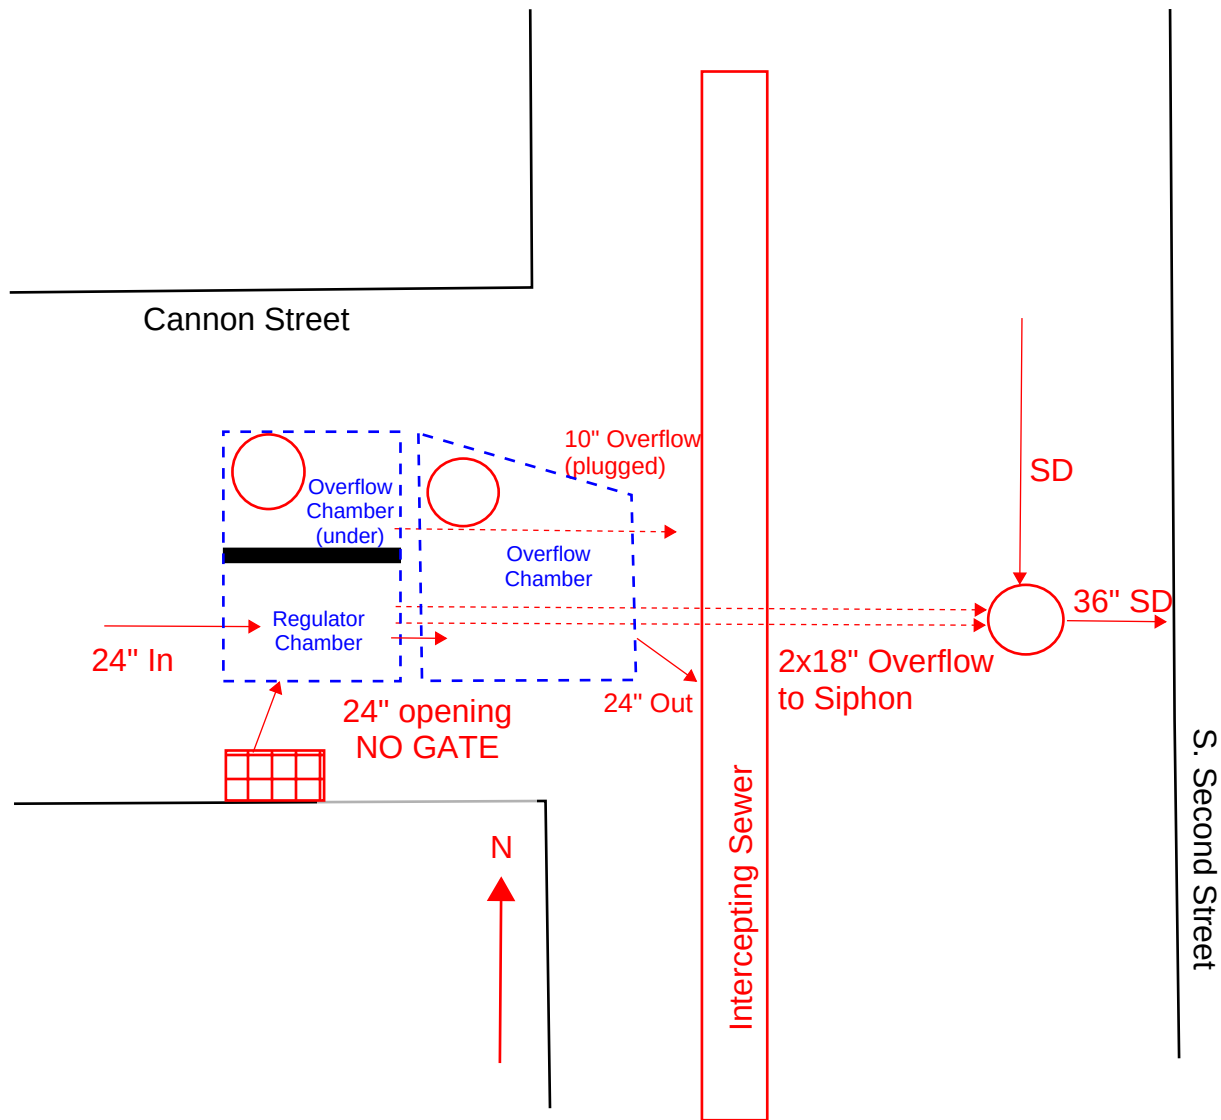

R-032A

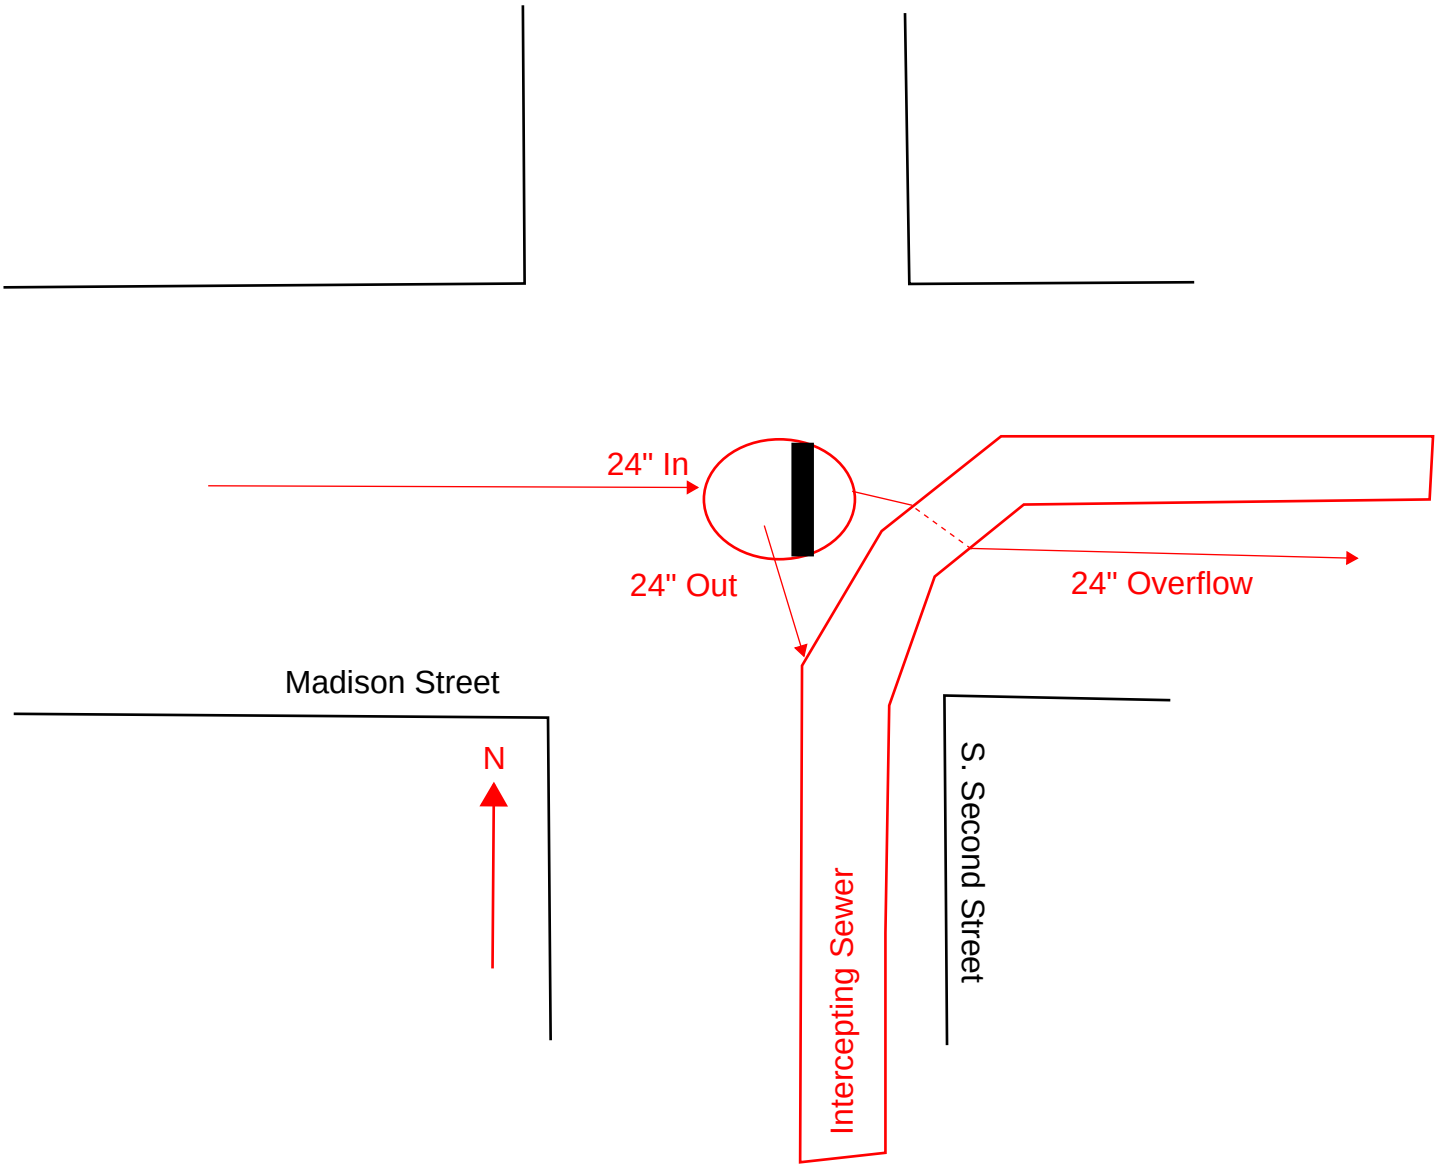

R-032B

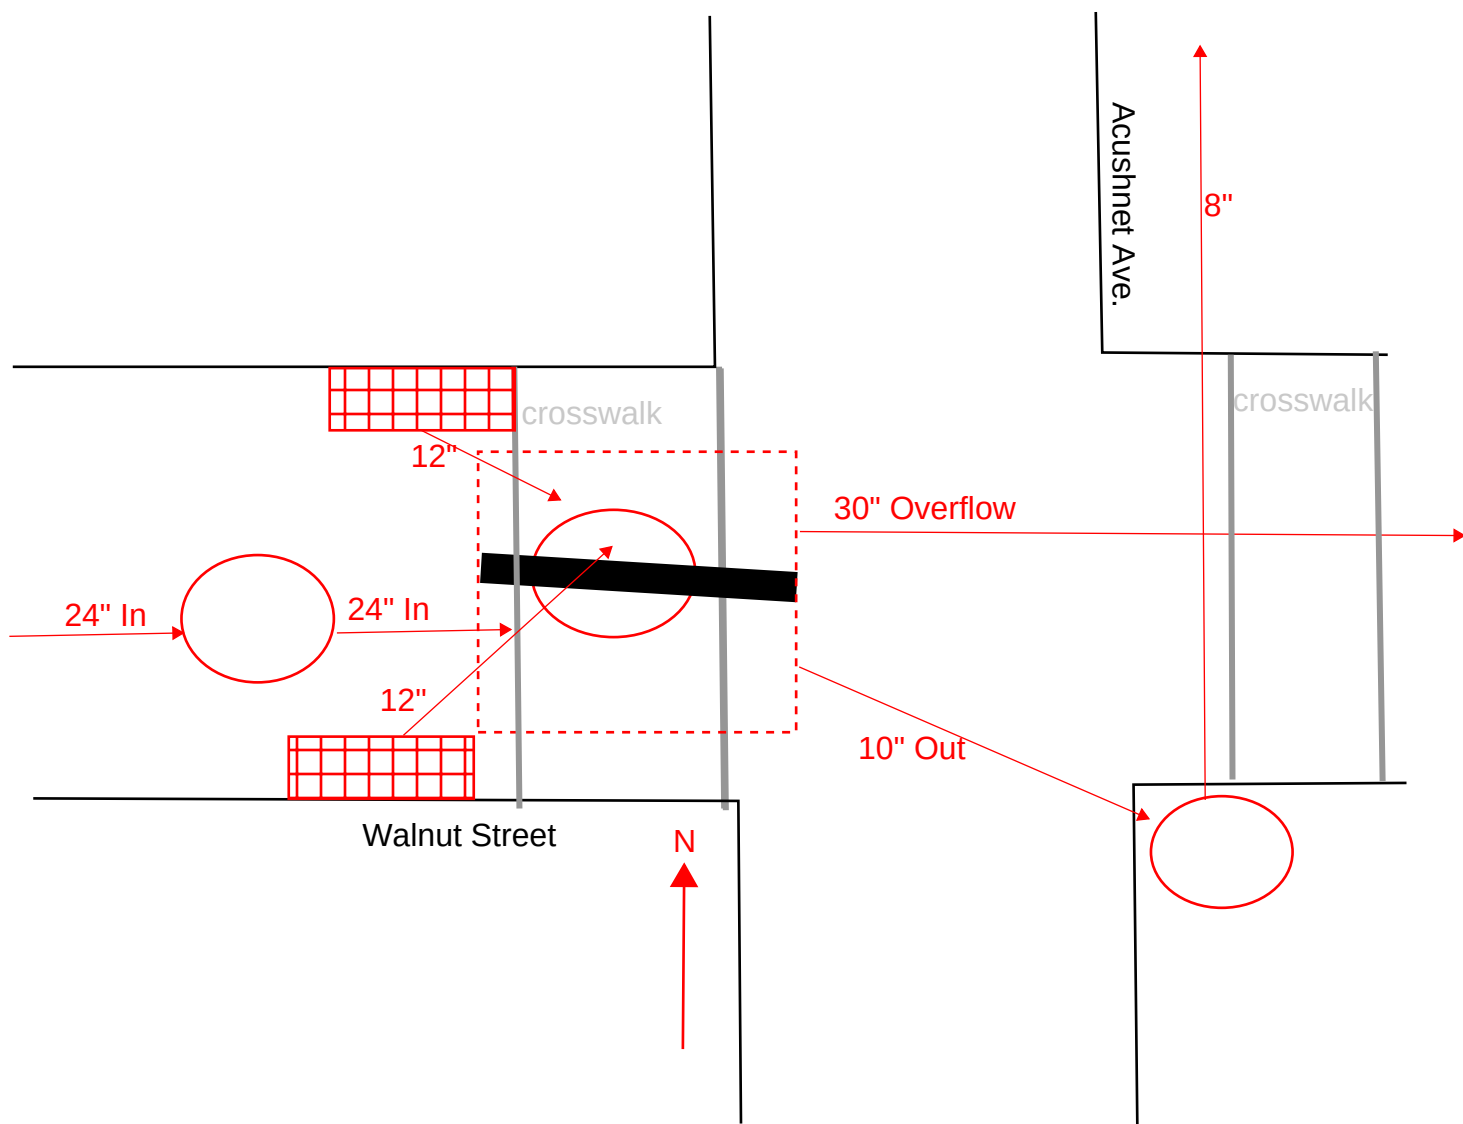



R-032C


R-032D

No Regulator


R-034A/B

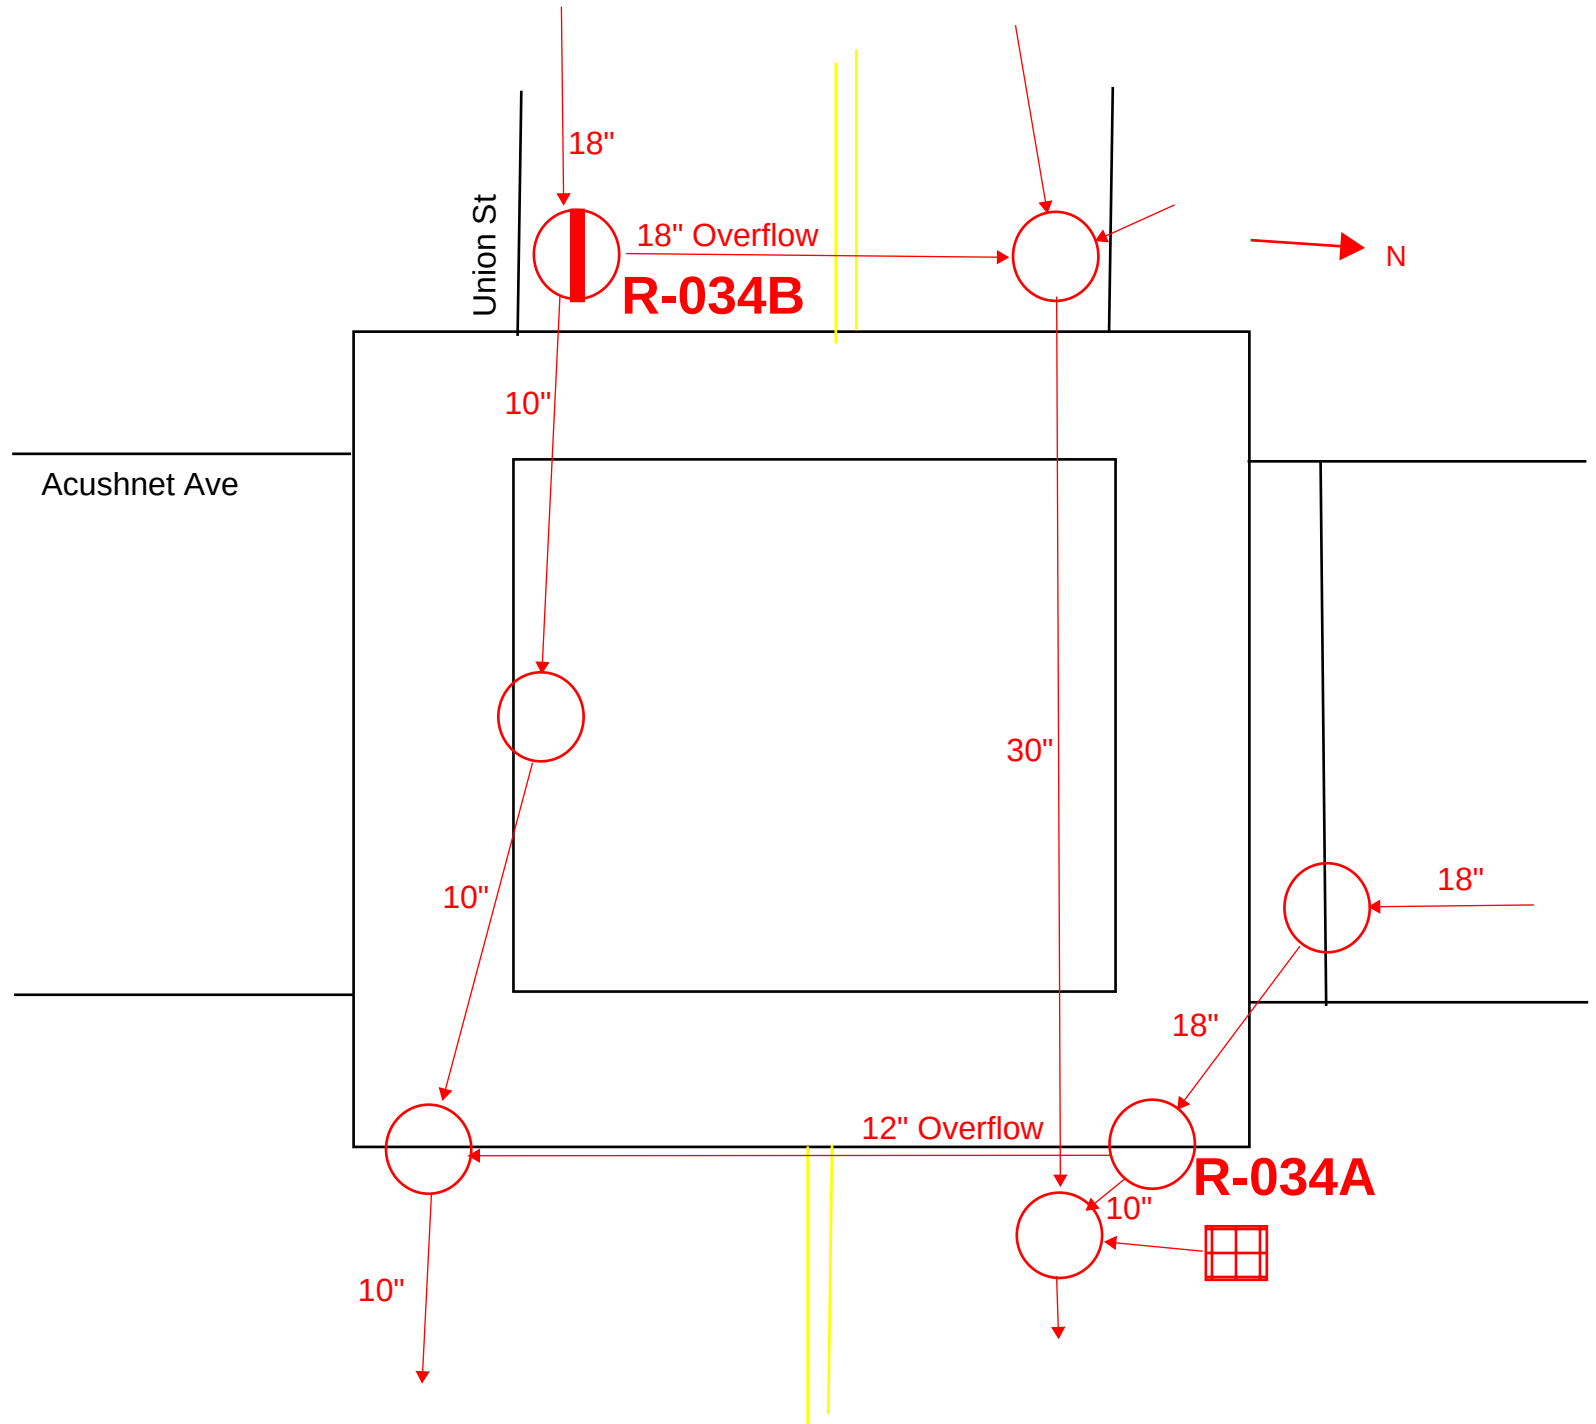

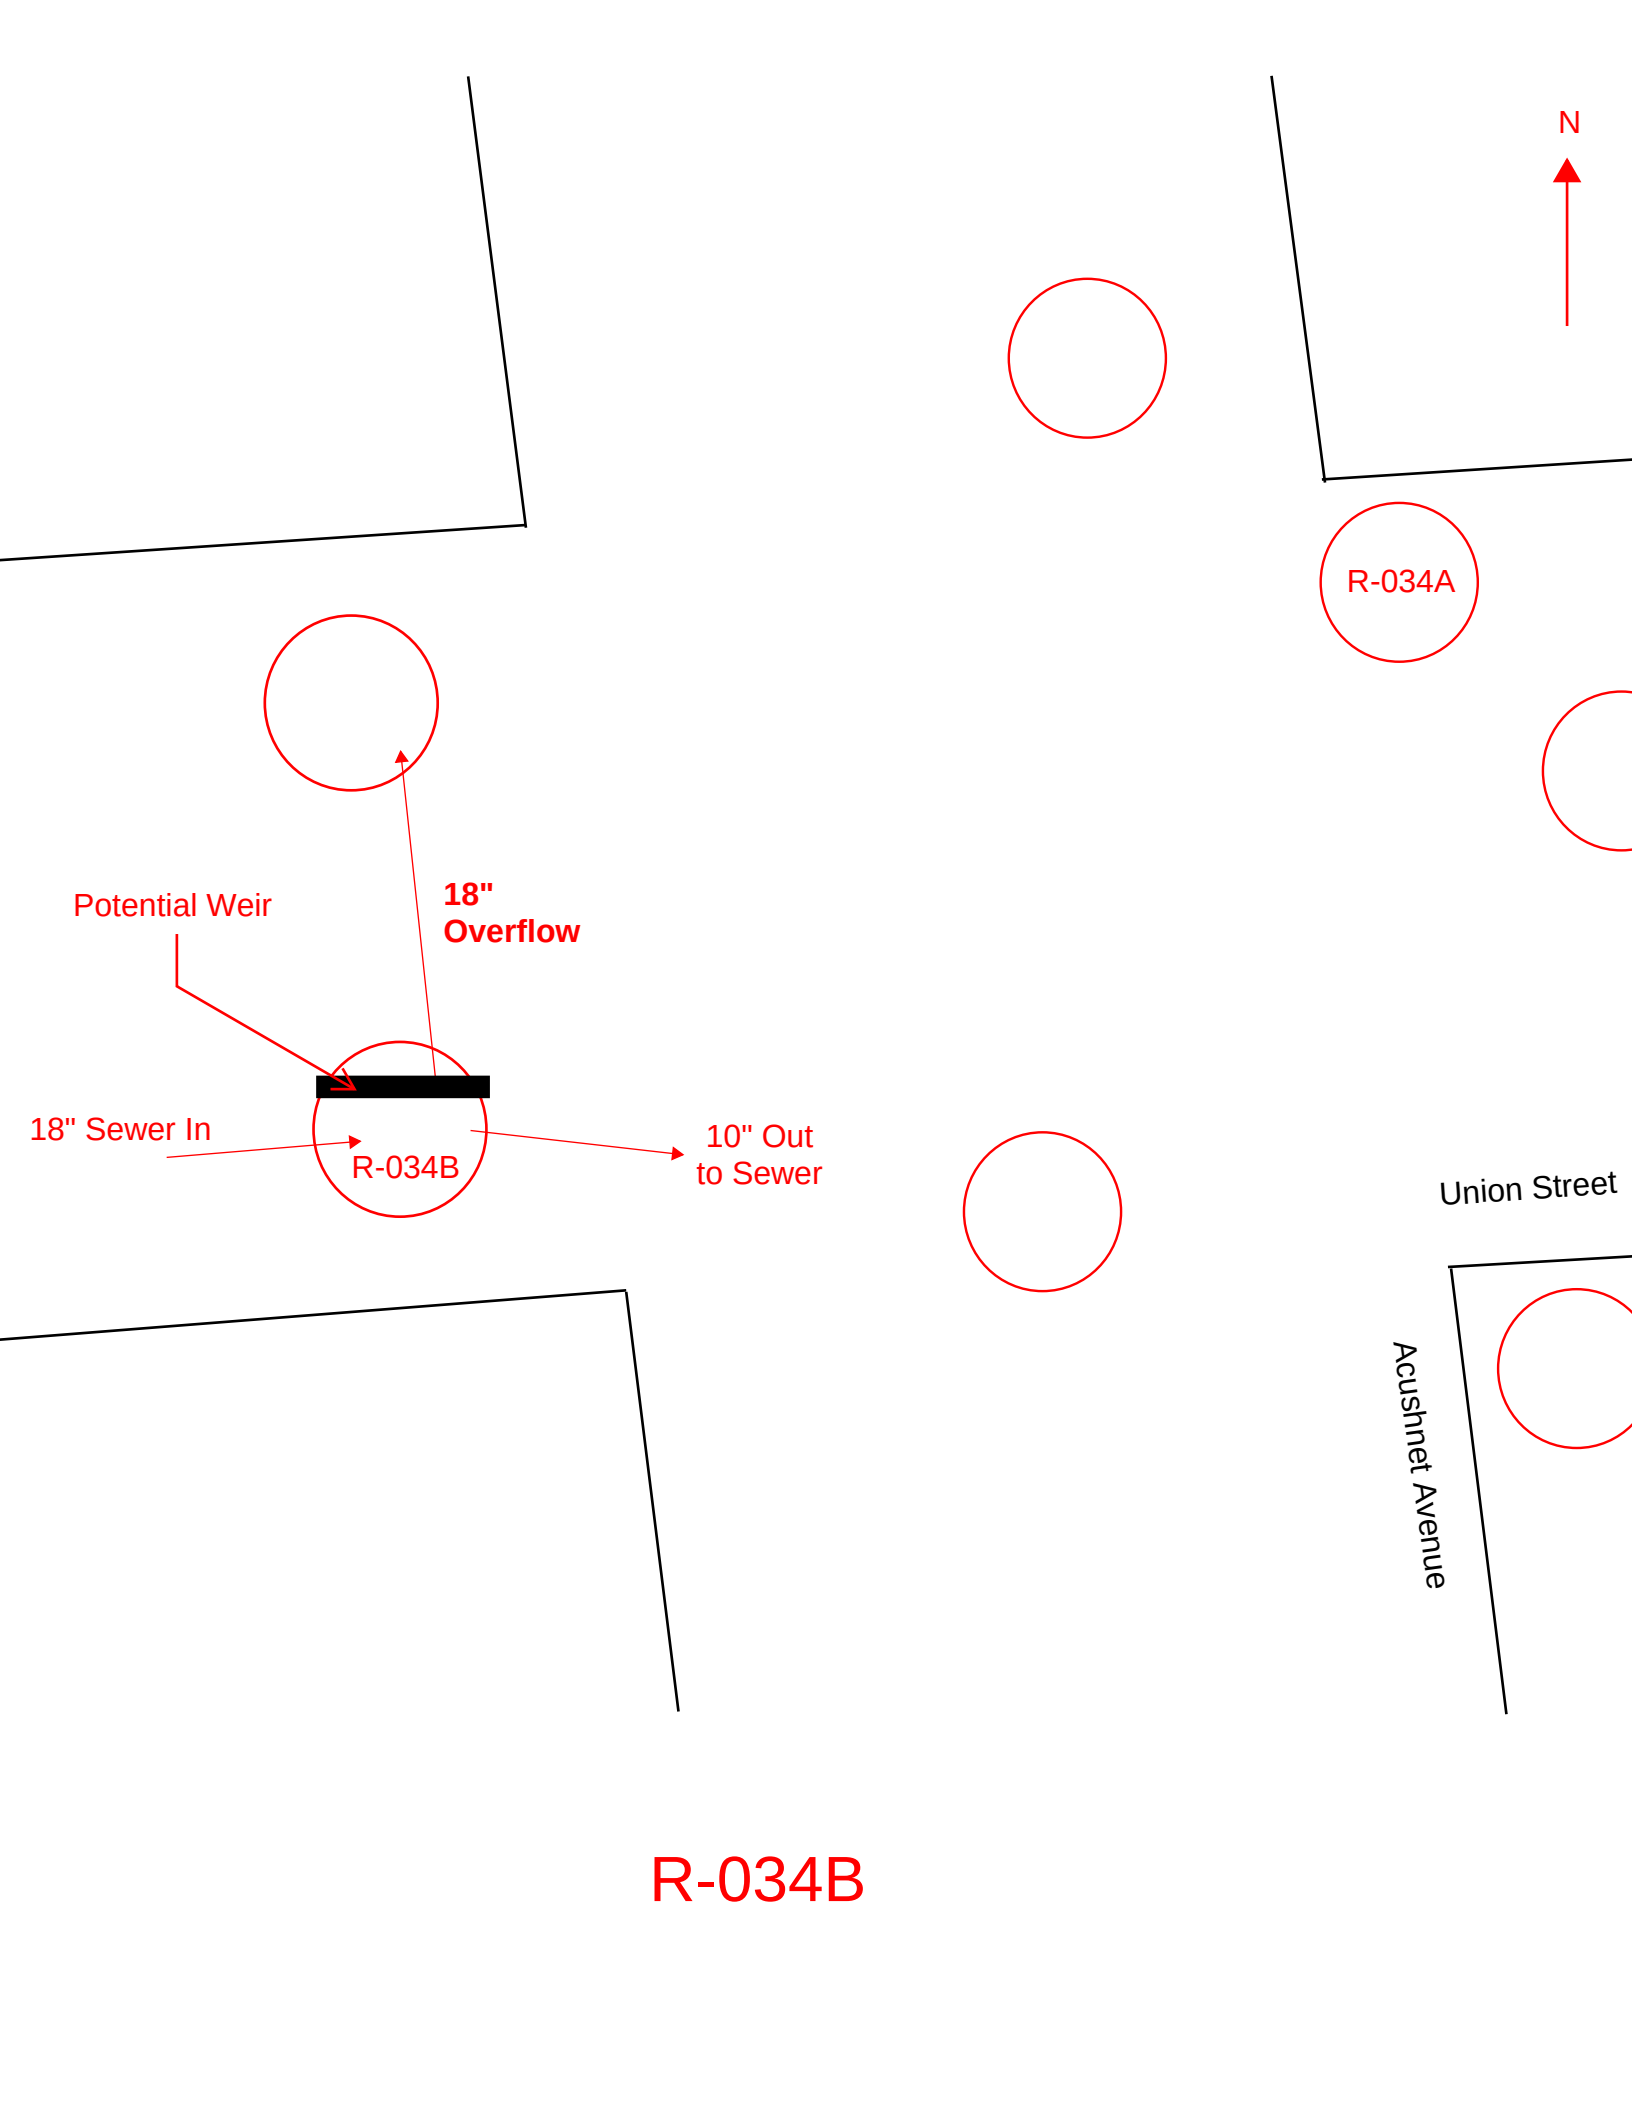


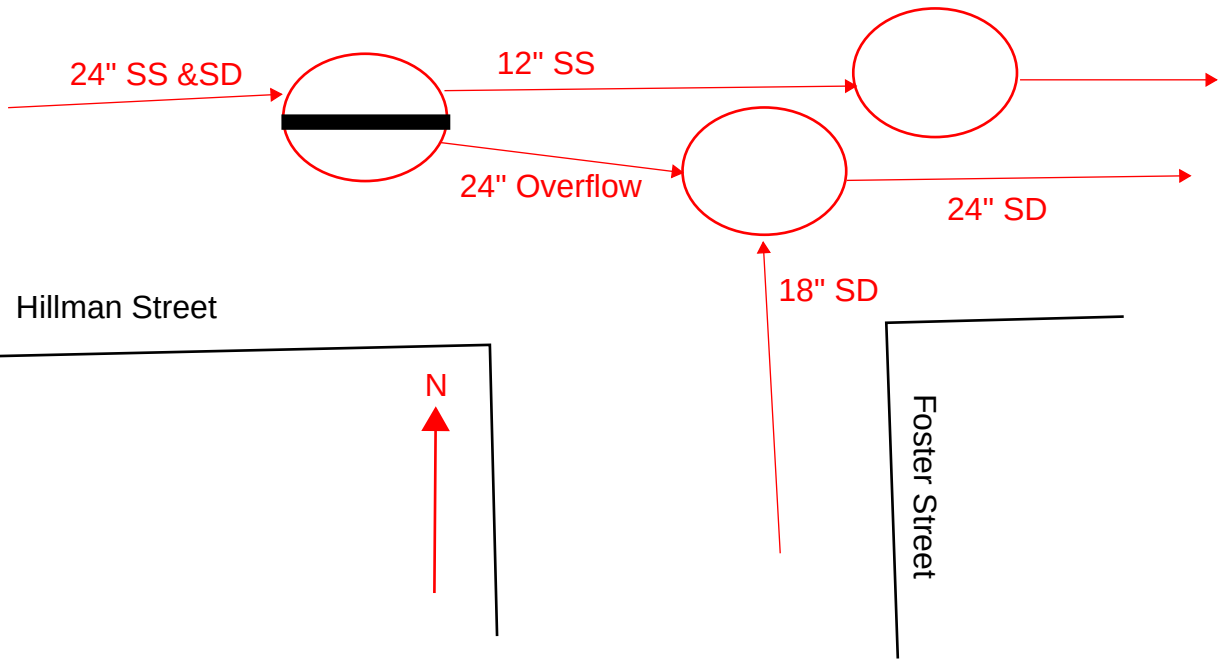


R-035A

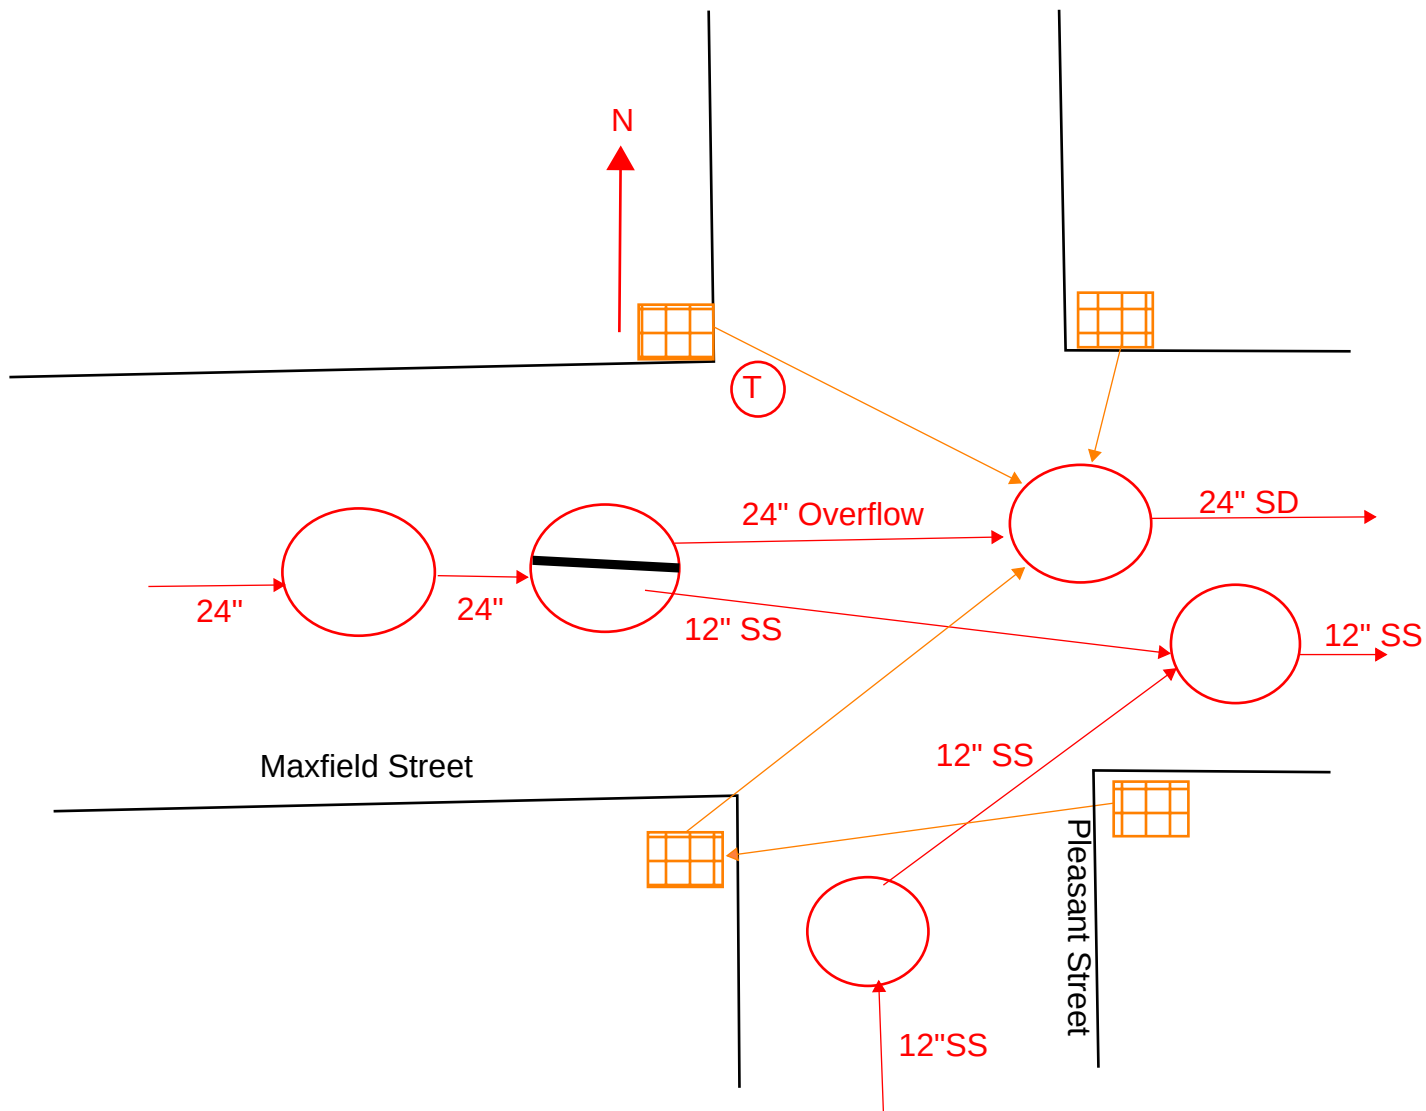


R-035B

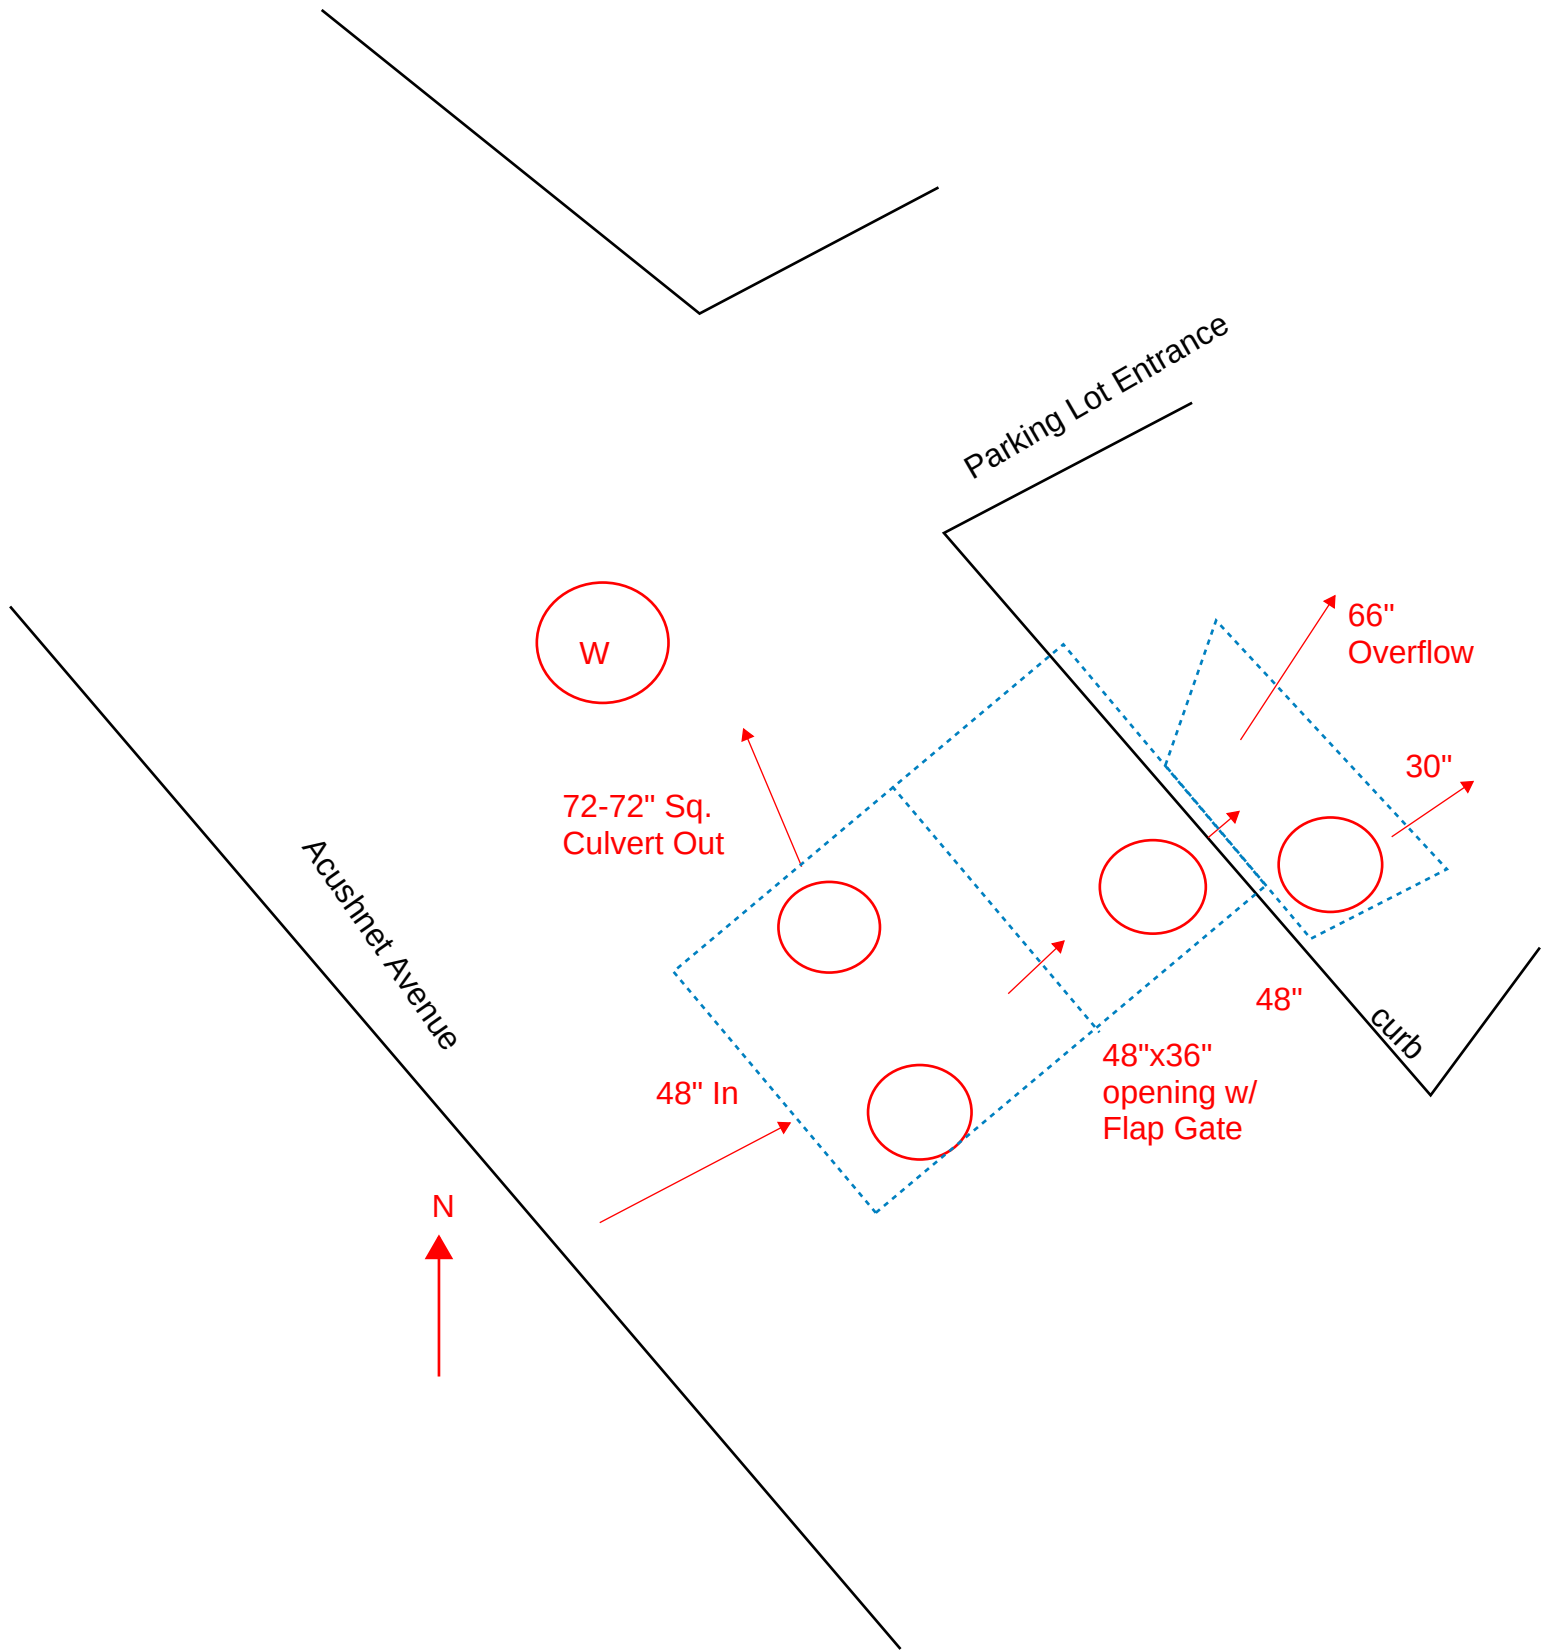

R-035C

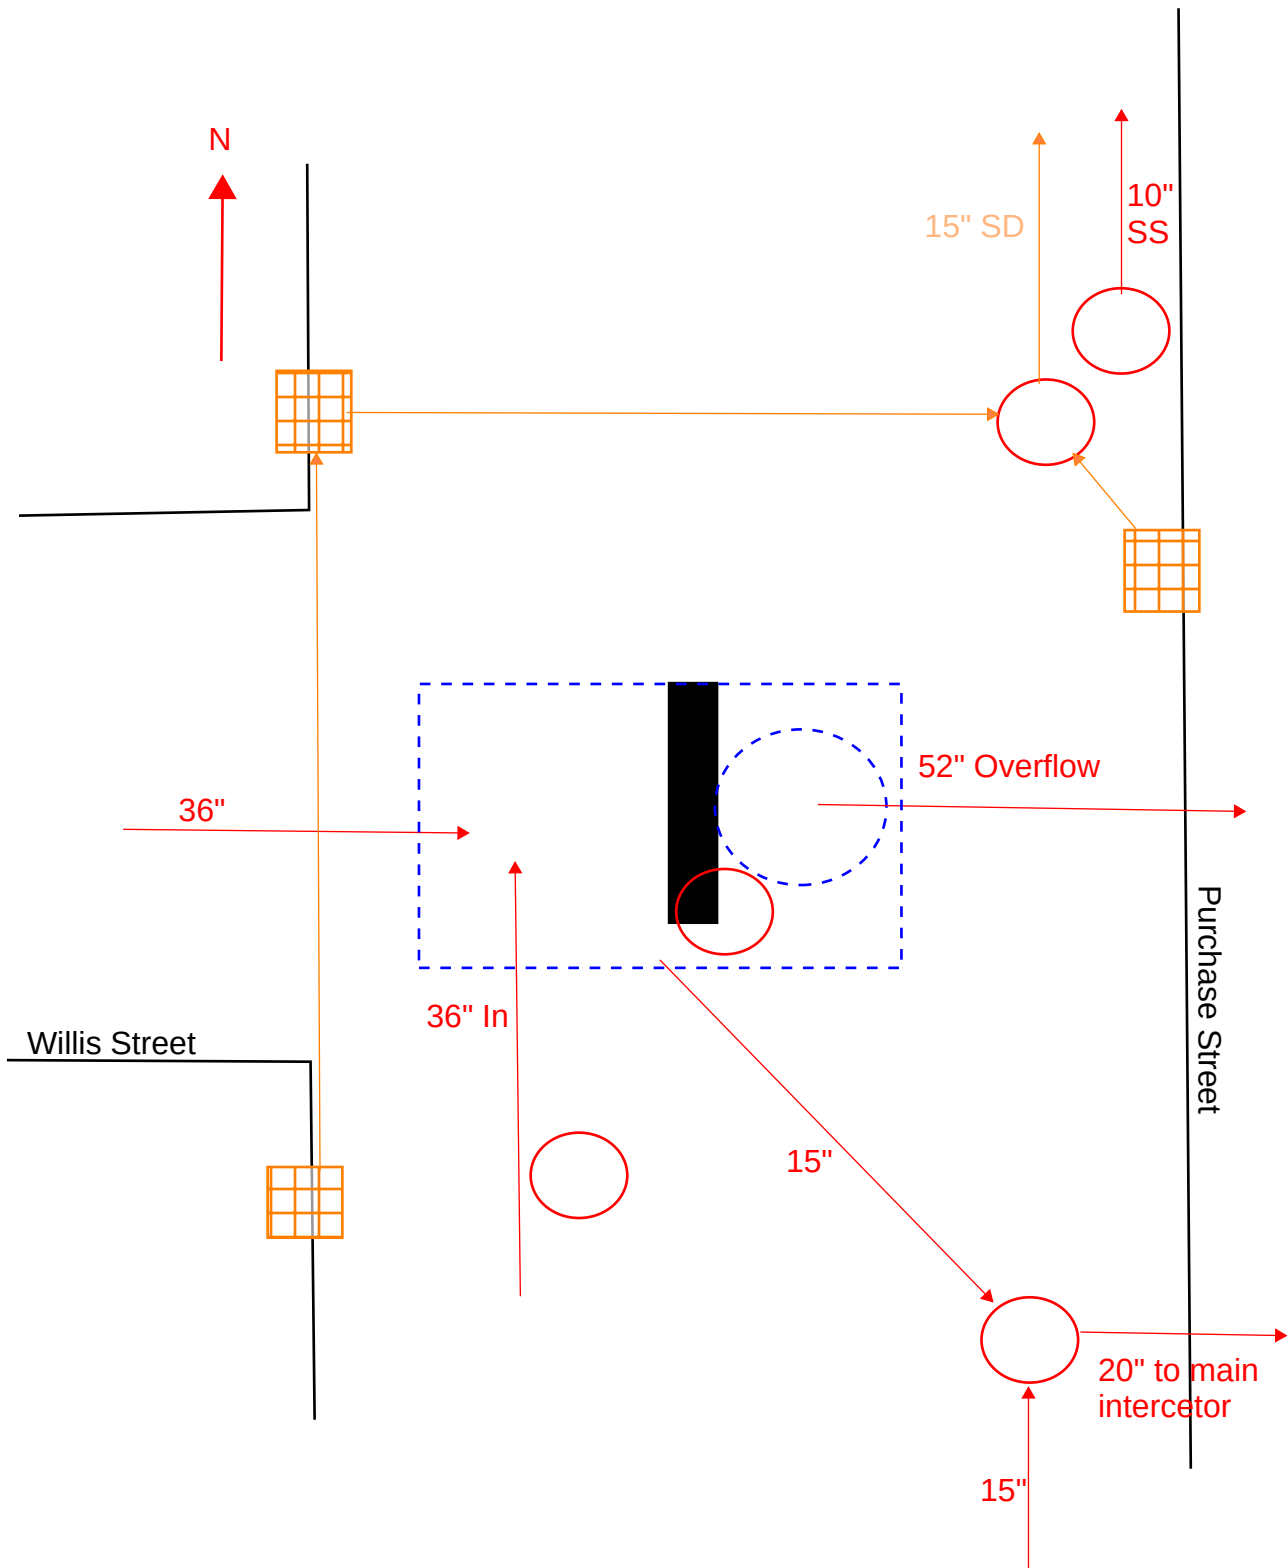

R-036A

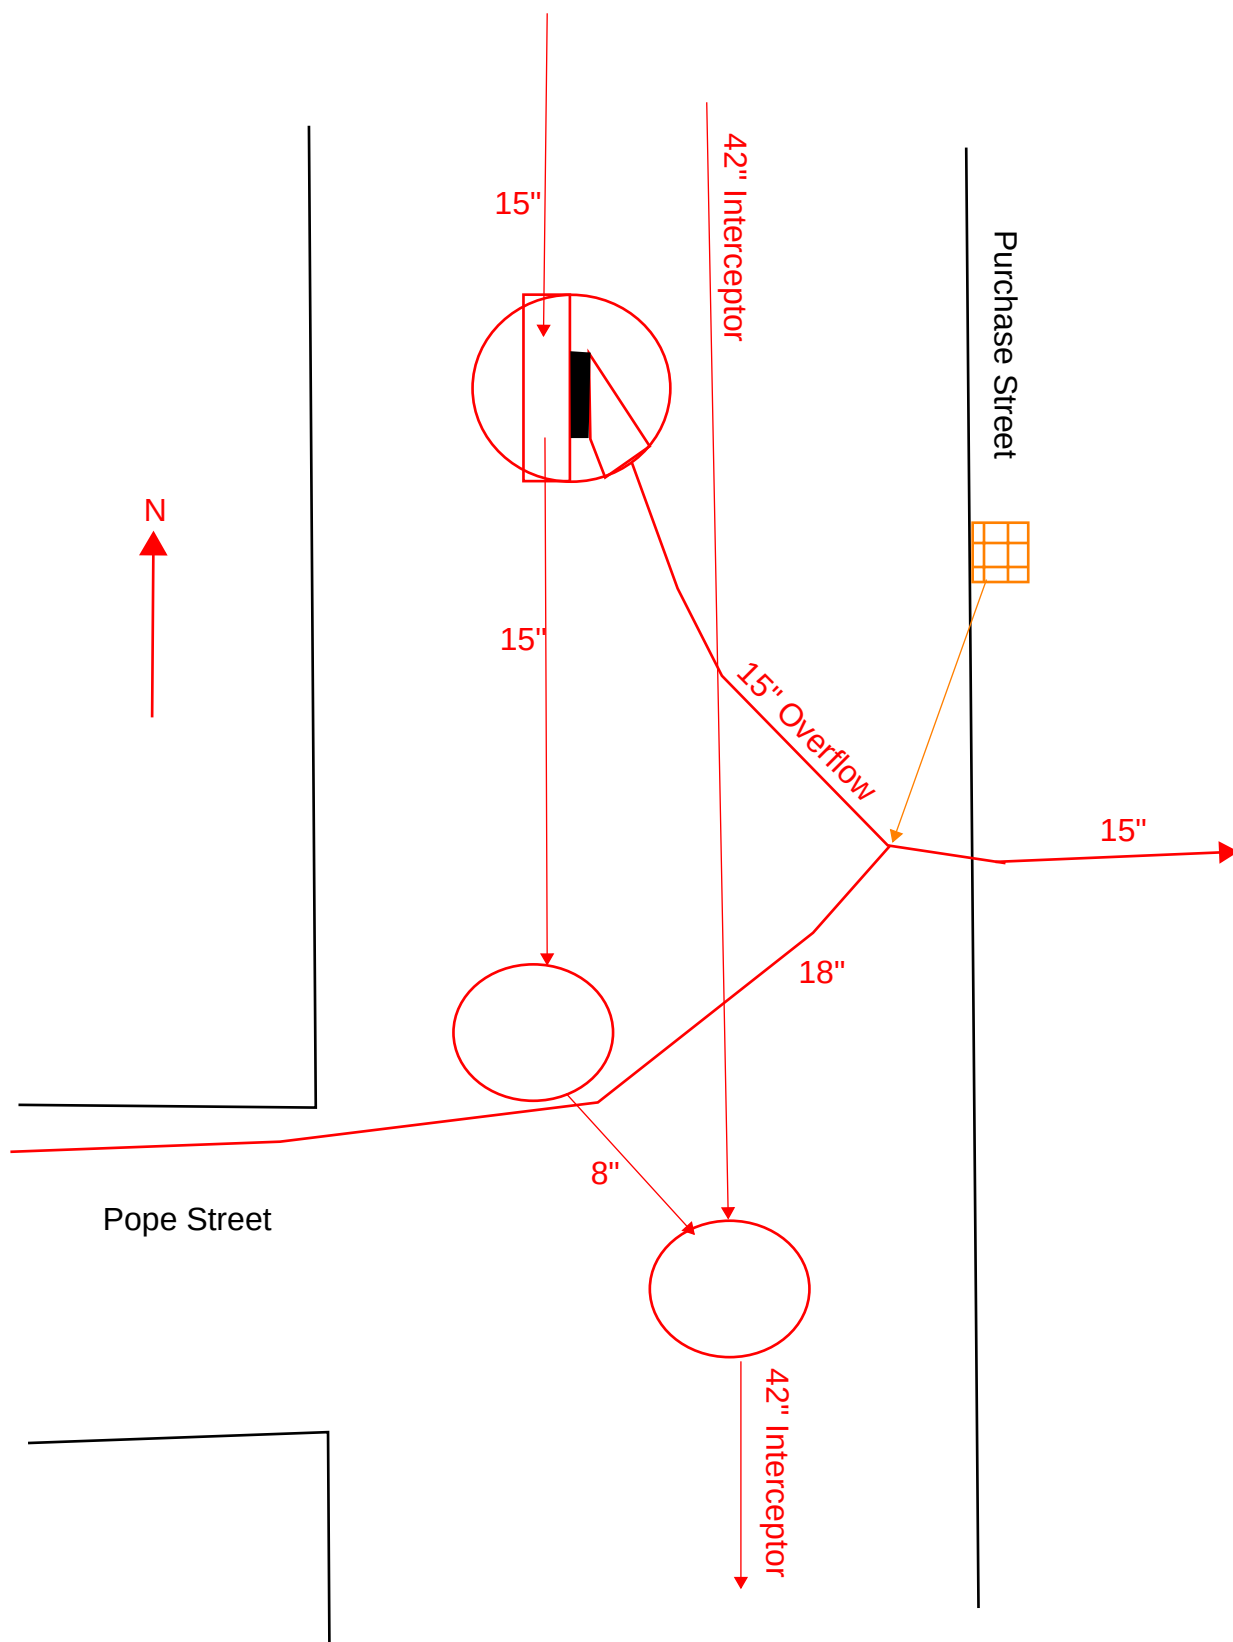


R-037A

Belleville Avenue


N

Coggeshall Street

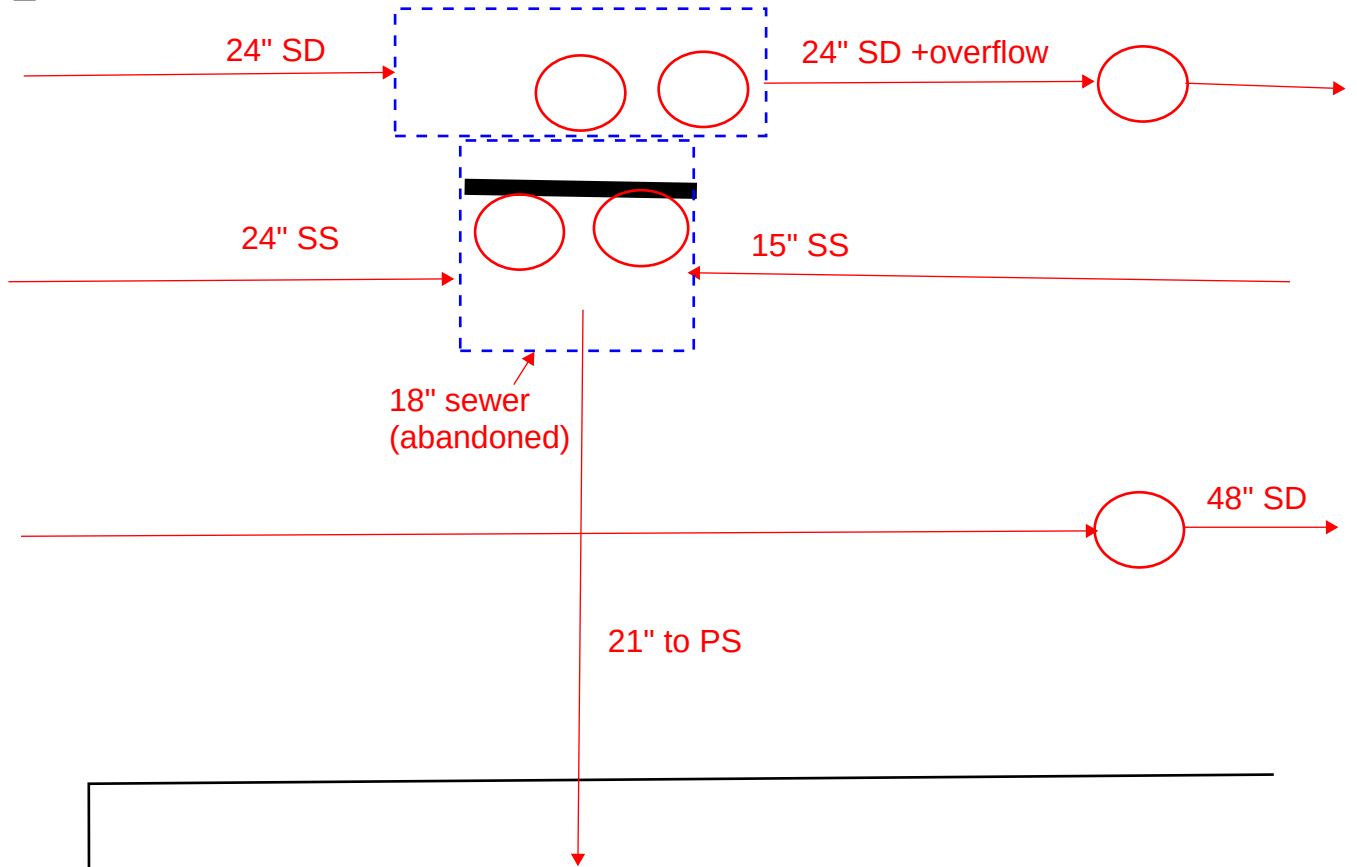


R-040A

- Storm Drain
- Sewer/ Combined
- Regulating Structure

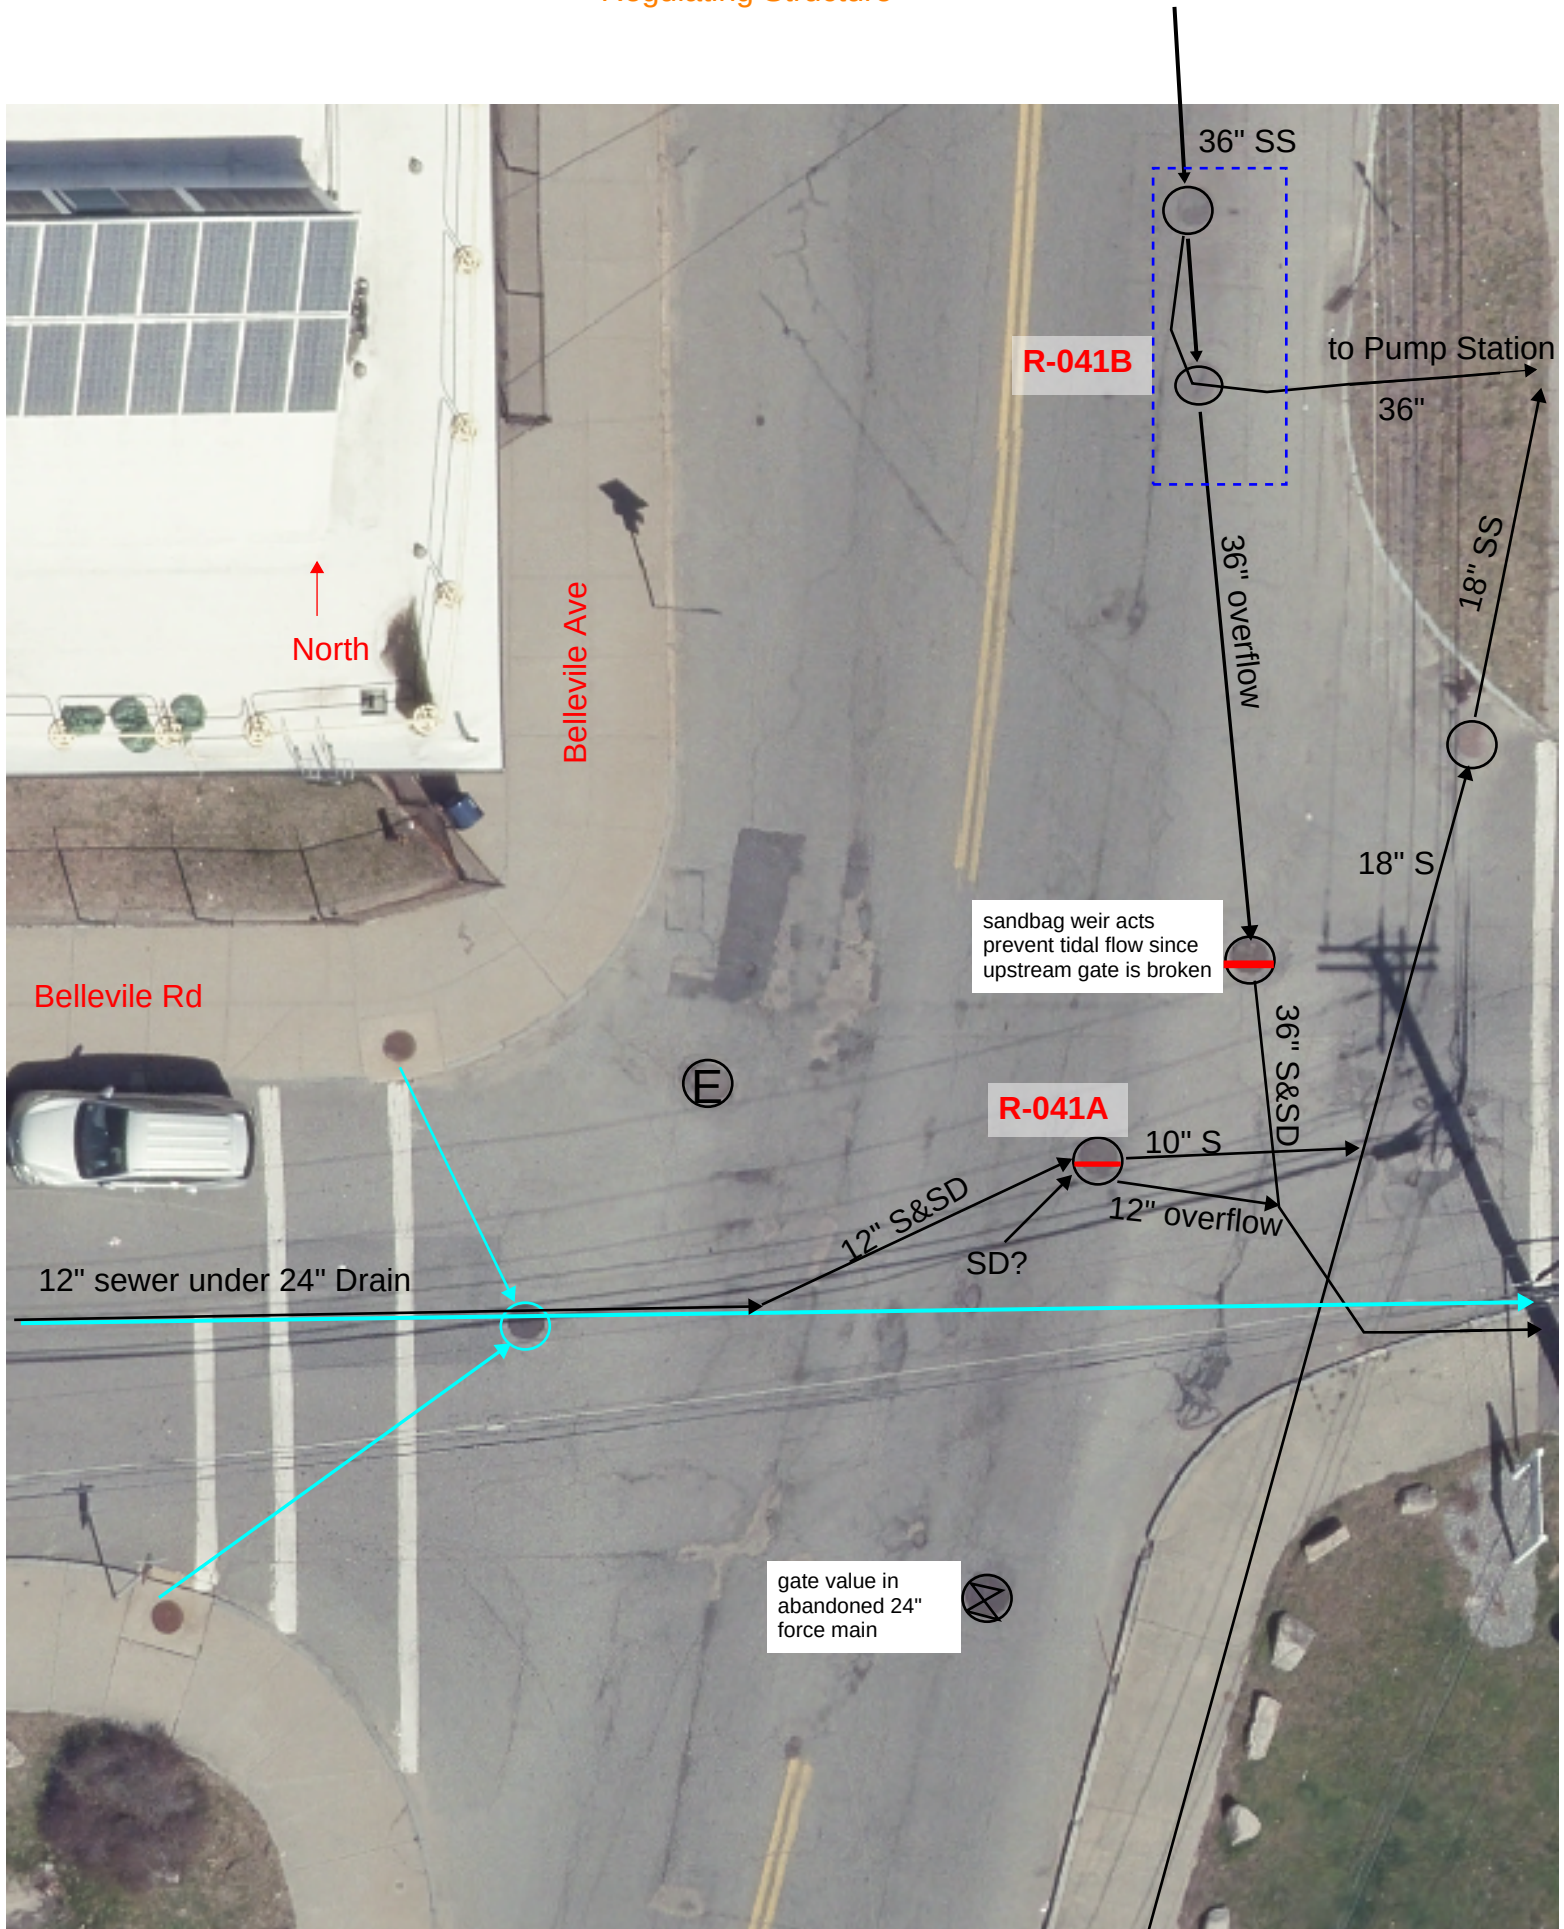

R-041A

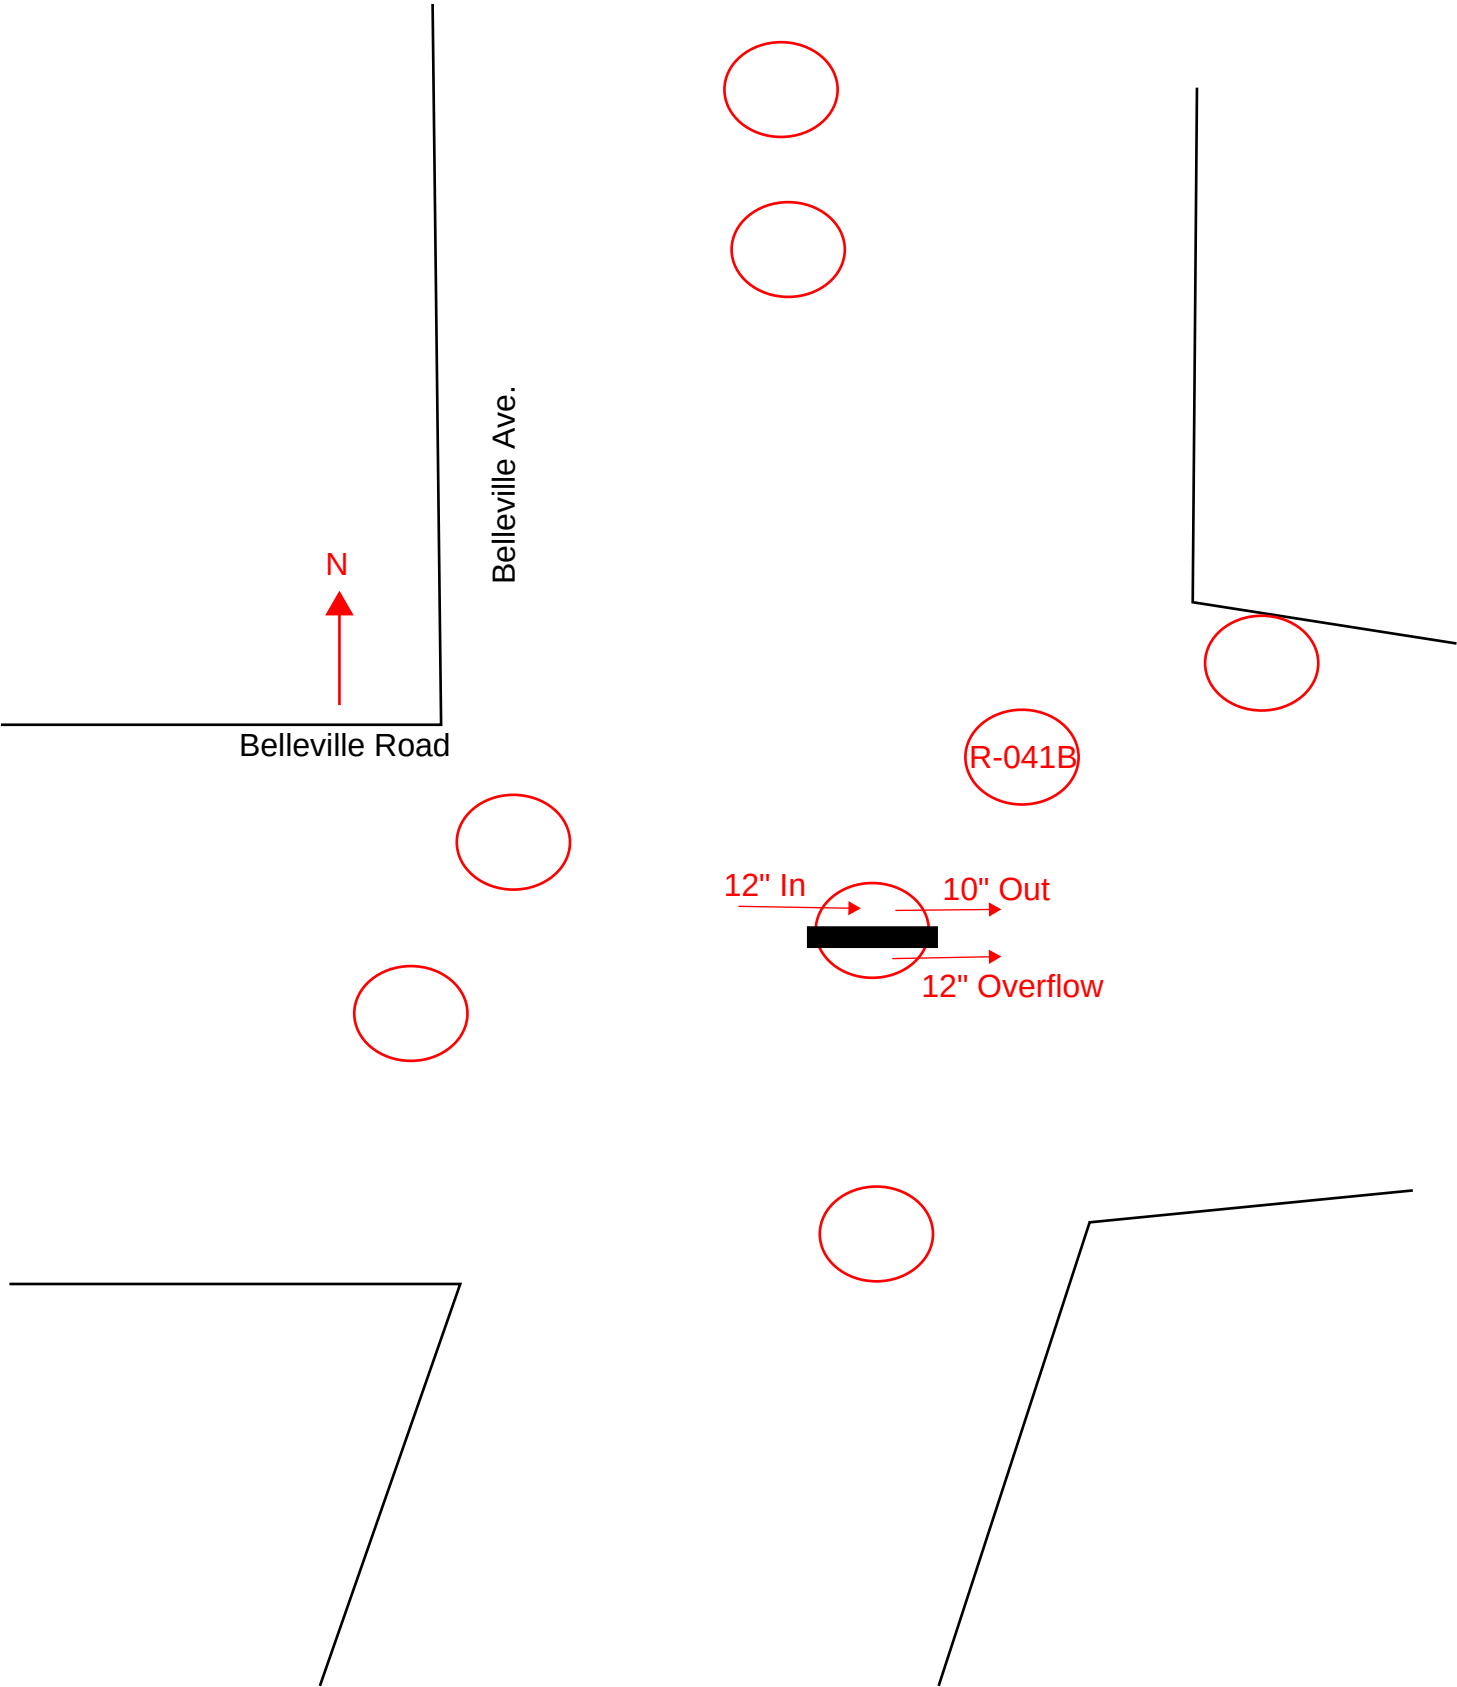

R-041B

