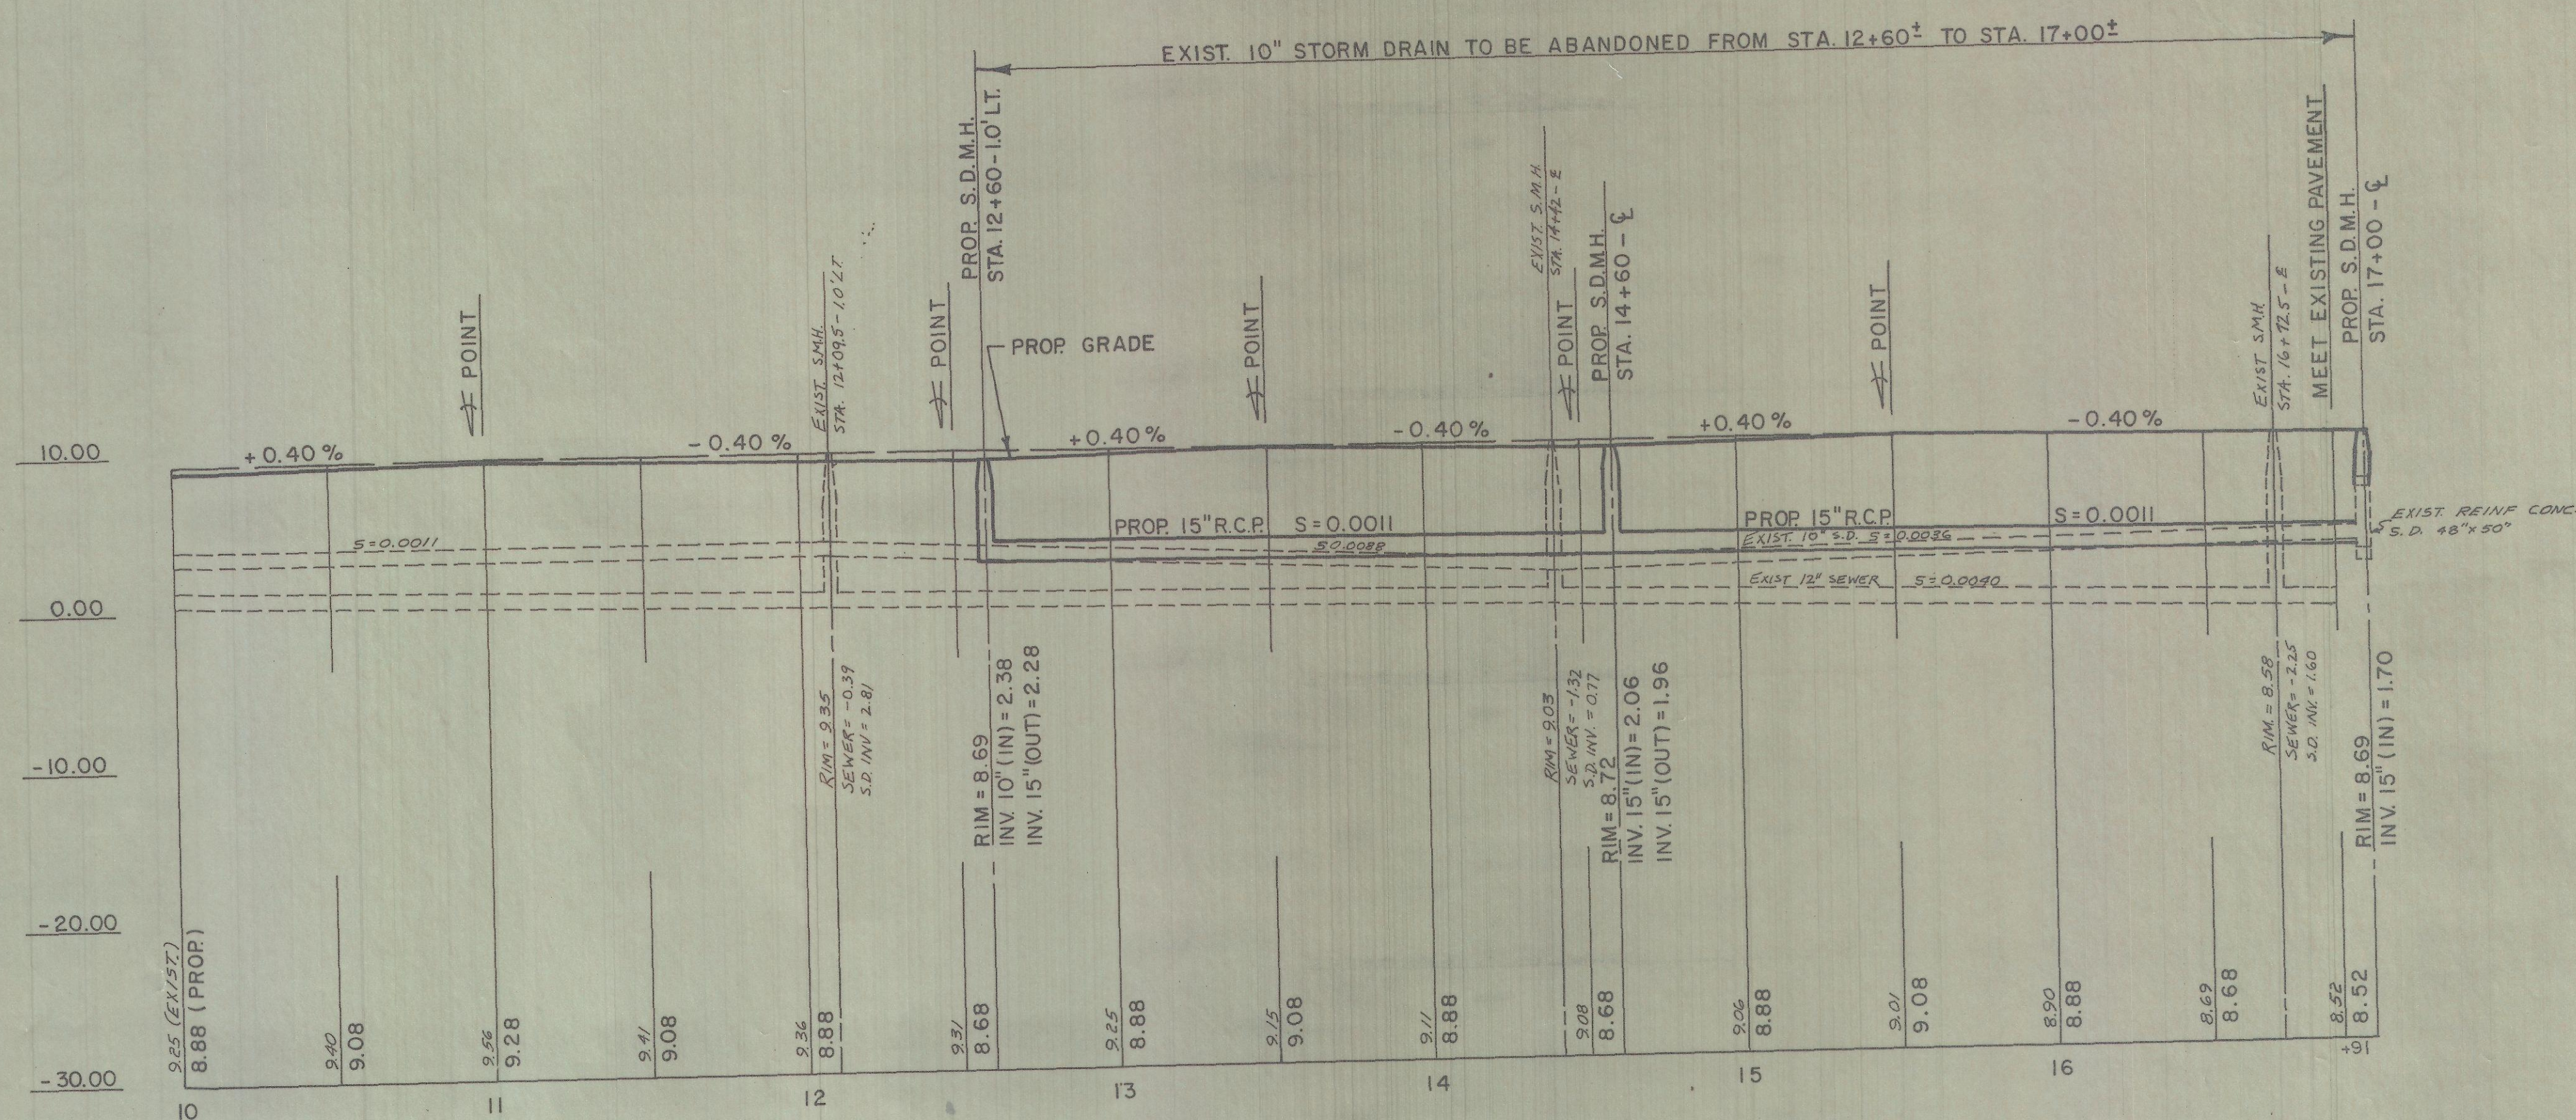
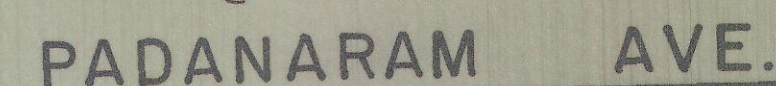


3/1
civil
Richard