




HORIZONTAL 1 IN.= 60 FT.	VERTICAL 1 IN.= 6 FT.
ORDERED	JUNE 17, 1956.
CONSTRUCTION COMMENCED	JULY 19, 1956,
CONSTRUCTION COMPLETED	AUGUST 28, 1956.
AVERAGE CUT	9.94 FT.
COST	\$ 3100.41
AMOUNT ASSESSED	\$ 804.44

COMMISSIONER OF PUBLIC WORKS

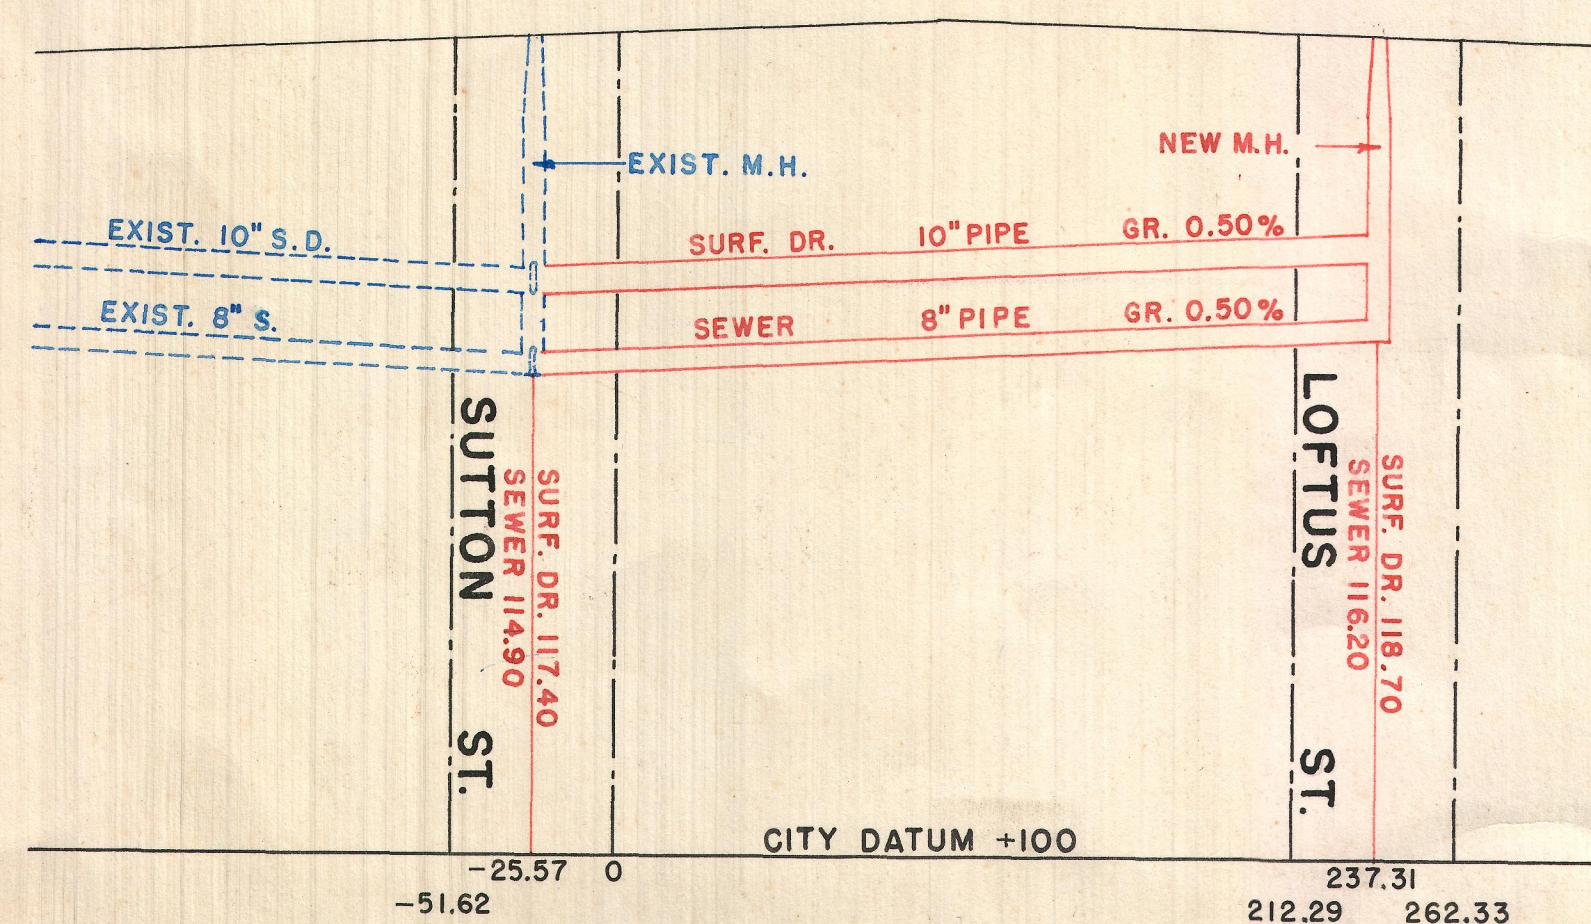

HORIZONTAL 1 IN.=60 FT.	VERTICAL 1 IN.= 6 FT.
ORDERED	MARCH 10, 1955.
CONSTRUCTION COMMENCED	CONTRACT-JOSEPH PERRY.
CONSTRUCTION COMPLETED	AUGUST 31, 1956.
AVERAGE CUT	9.11'
COST	\$ 5,640.48
AMOUNT ASSESSED	\$ 1,392.28

COMMISSIONER OF PUBLIC WORKS

REFERENCE—TOWN BOUND S.E. COR. TAYLOR ST. & COVE ROAD
ELEV. 15.32

