


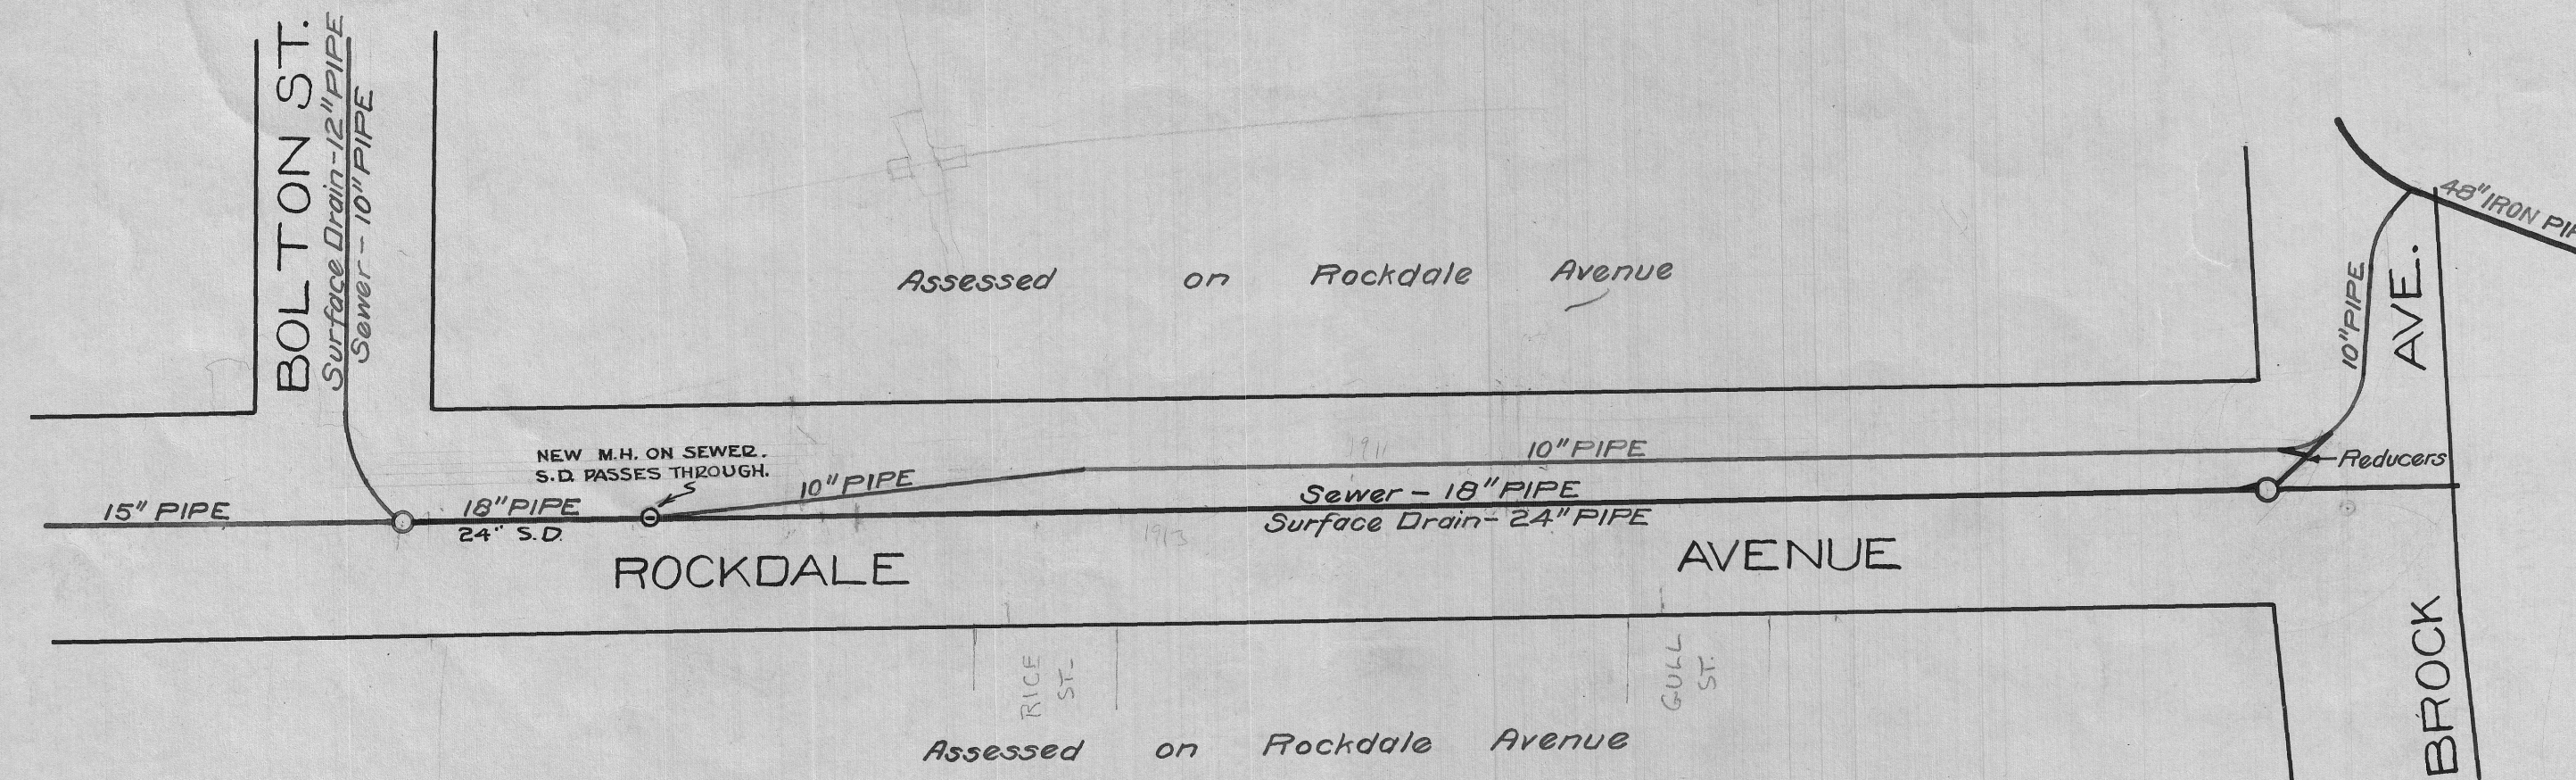

ROCKDALE AVENUE SEWER & SURFACE DRAIN

FROM BROCK AVENUE TO BOLTON ST.

LENGTH

722 feet of glazed pipe 24 inches in diameter

582 feet of glazed pipe 18 inches in diameter

SCALE


Horizontal, 1 inch = 60 feet Vertical, 1 inch = 6 feet

Ordered Aug. 11, 1913
 Construction Commenced Nov. 17, 1913
 Construction Completed Dec. 3, 1913
 Average Cut 8.66 feet
 Ledge Excavated 59 Cu. Yds.
 Cost \$3332.38
 Amount Assessed
 Foreman John Andrews

Field book 411-65

George H. Myers
 CITY ENGINEER.

Detail of Sewer Construction at
 Brock Avenue and Rockdale Avenue
 Scale 1 inch = 4 feet

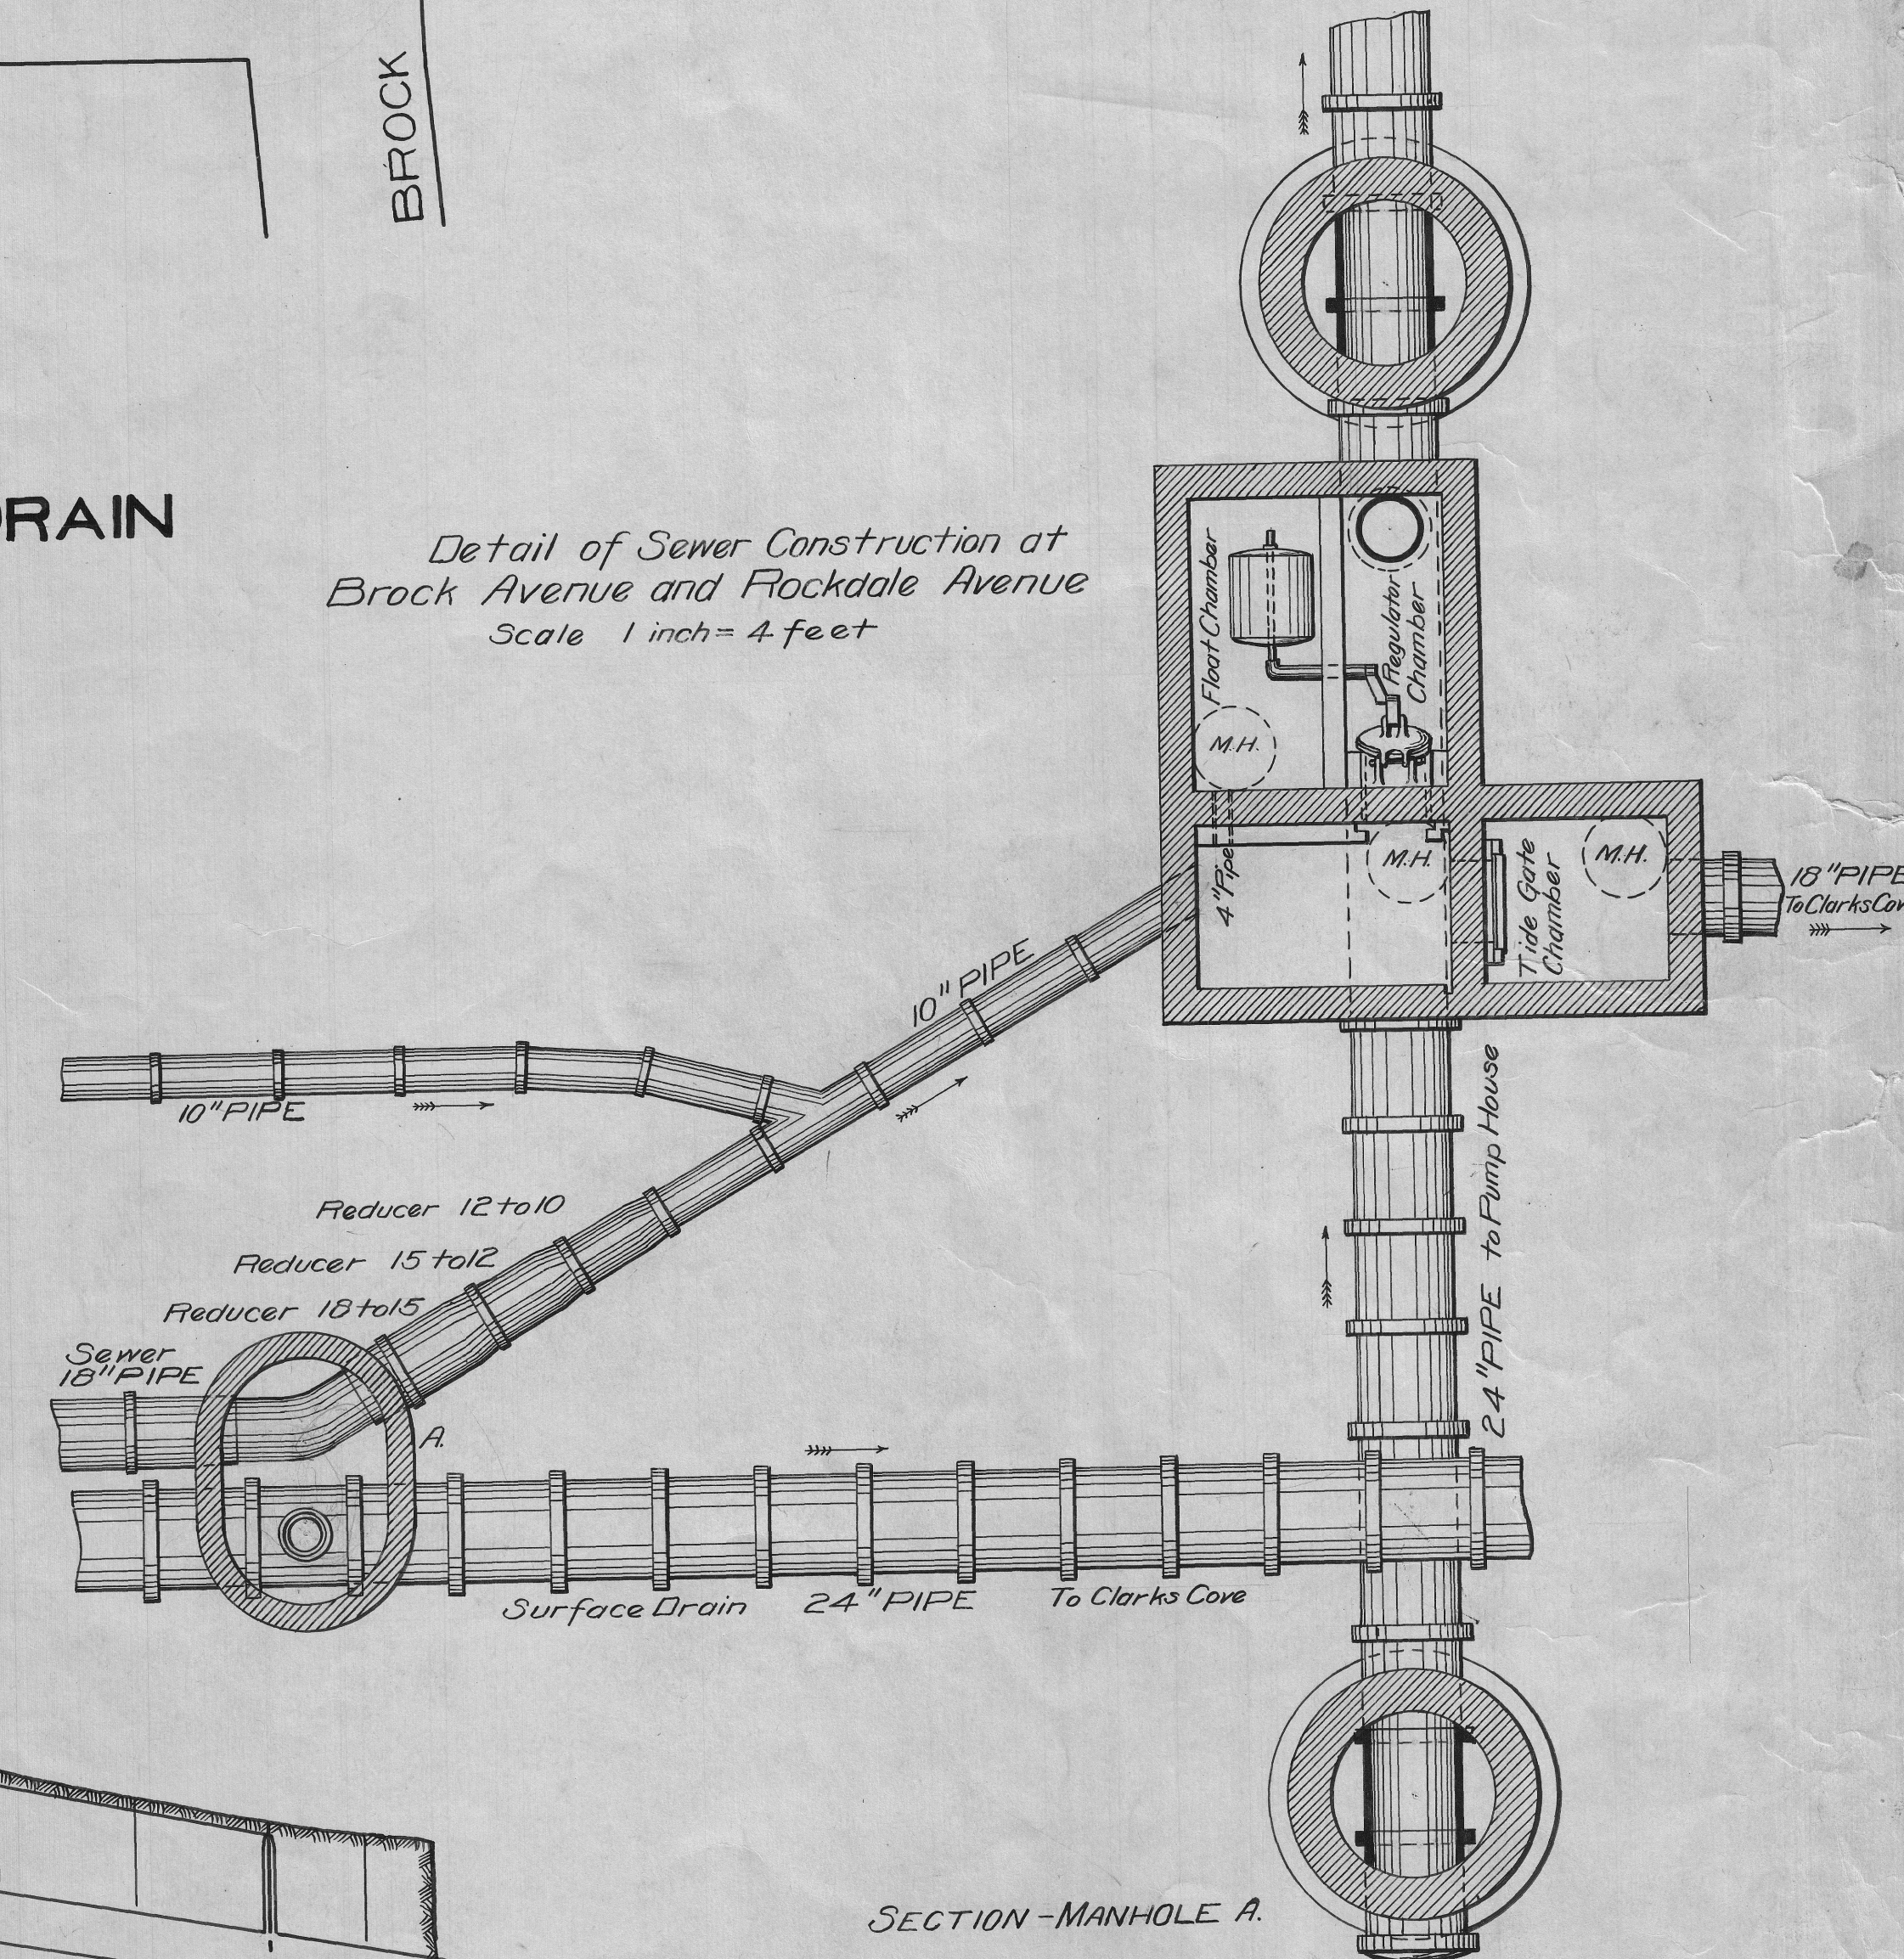

SECTION - MANHOLE A.

