


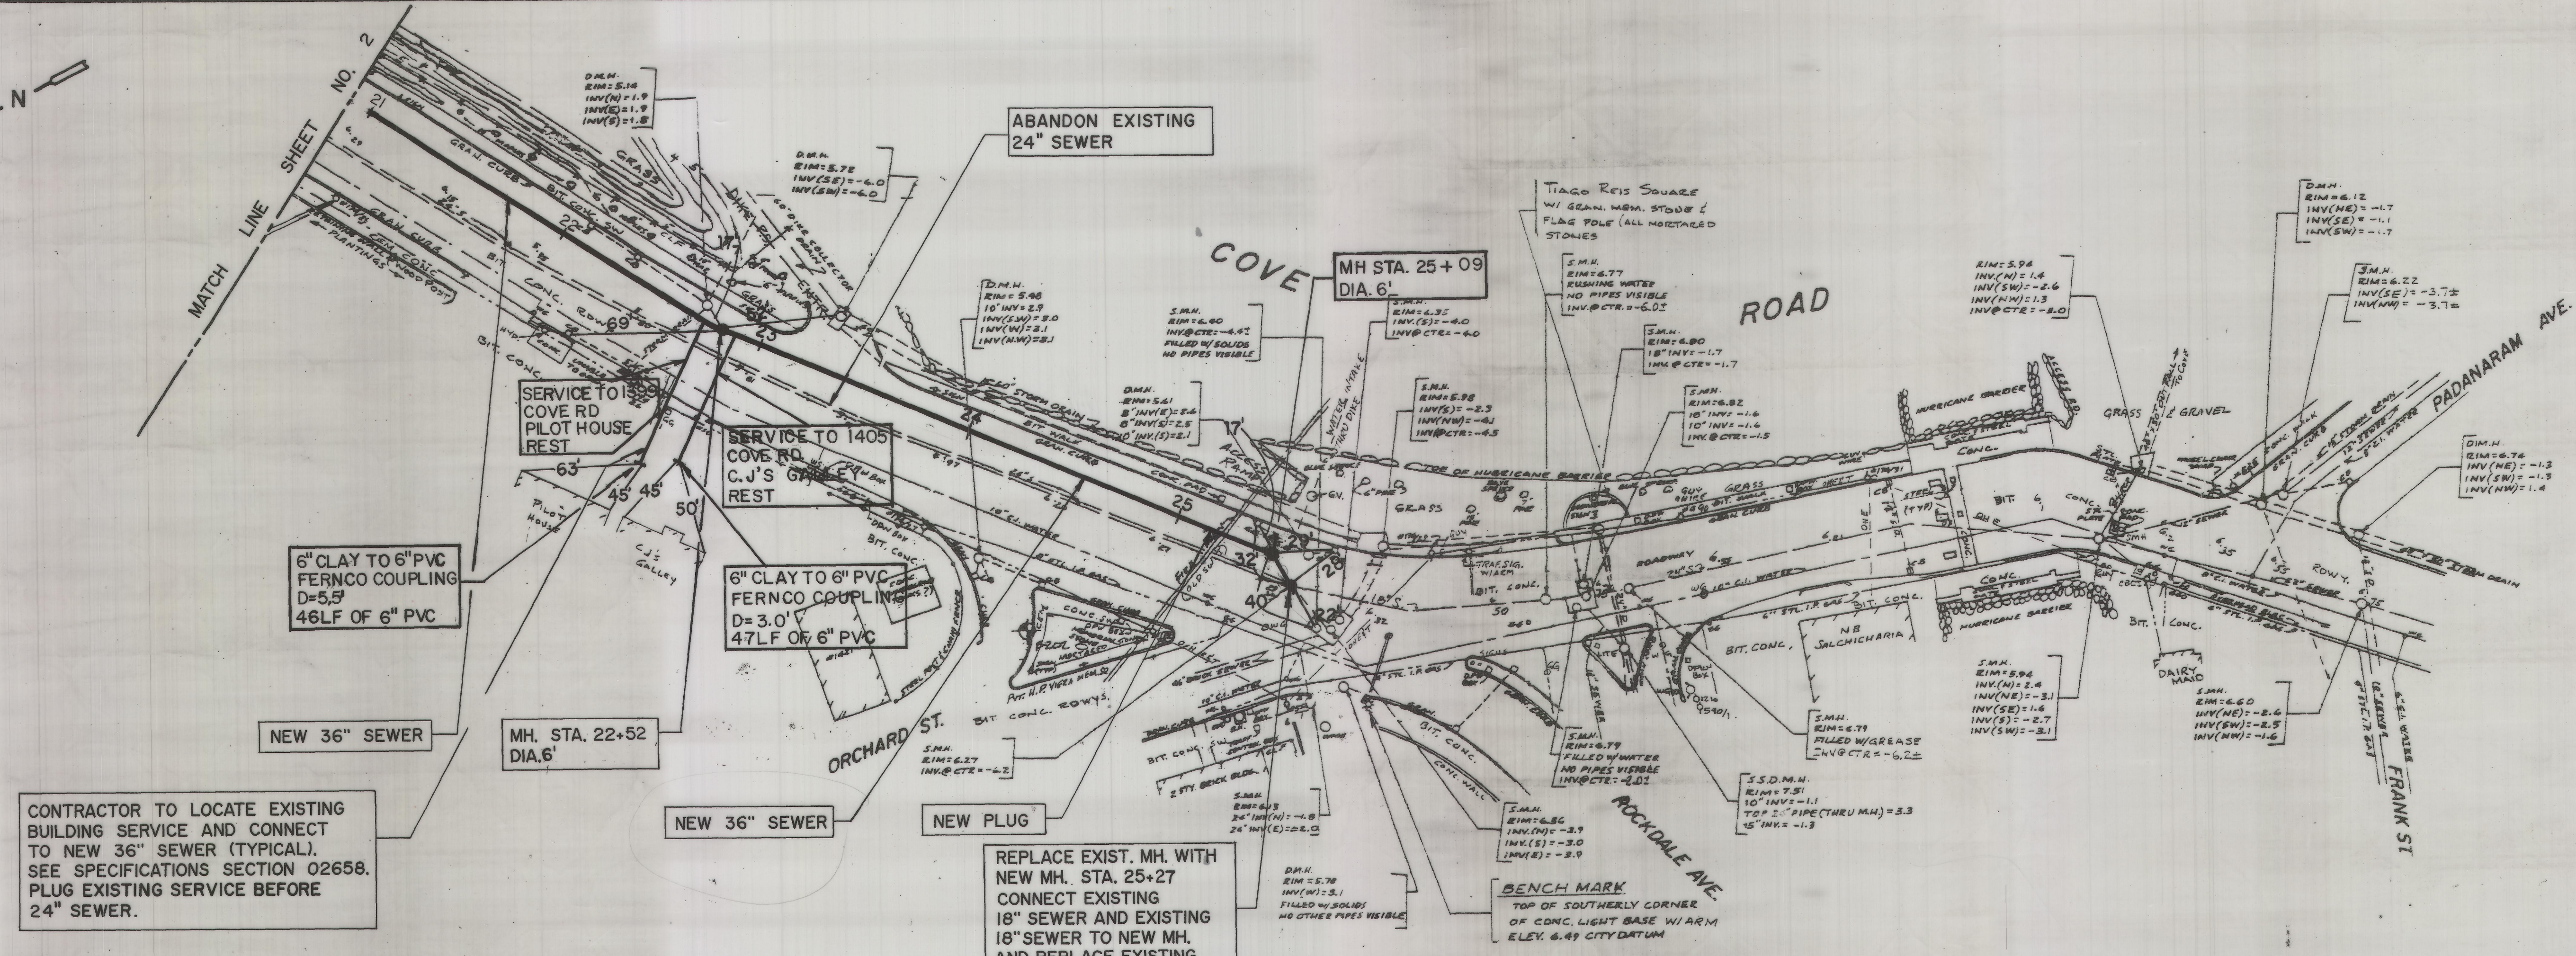


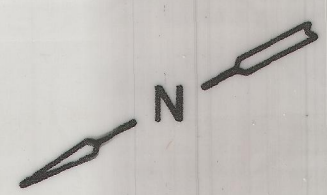


PLAN VIEW
SCALE: 1"=40'

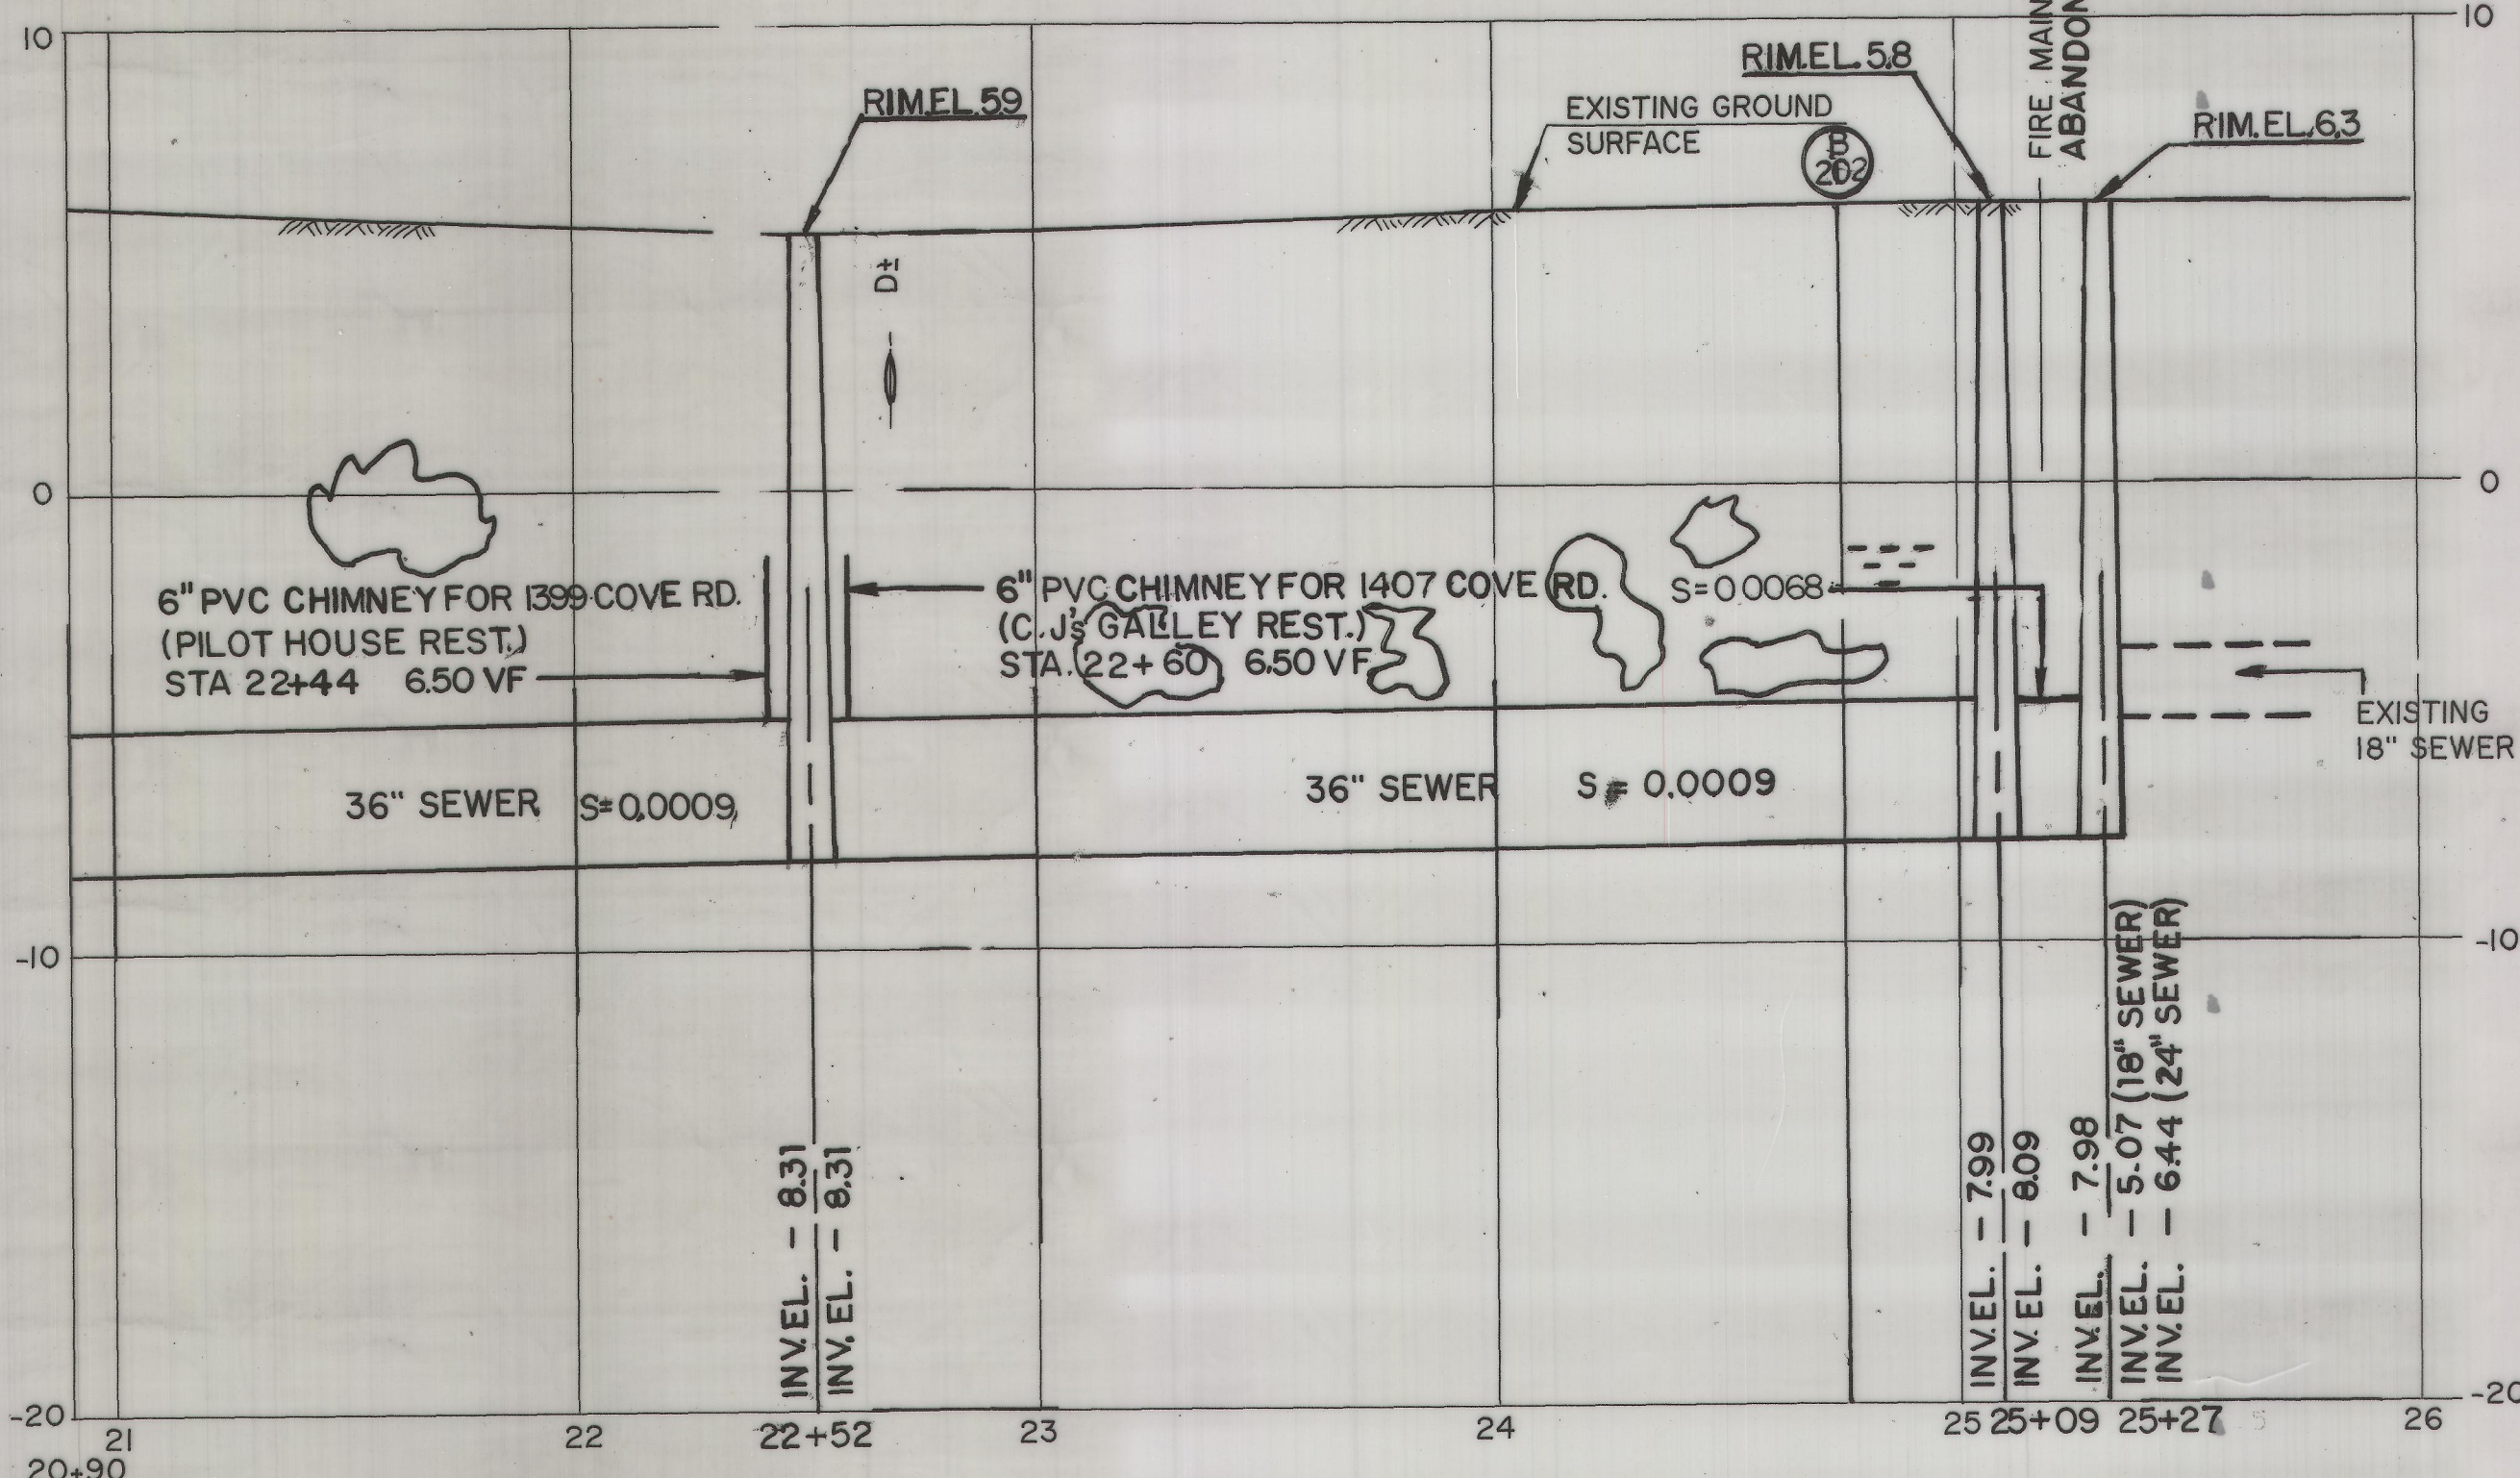

PROFILE COVE ROAD
HORIZ. 1"=40'
VERT. 1"=4'

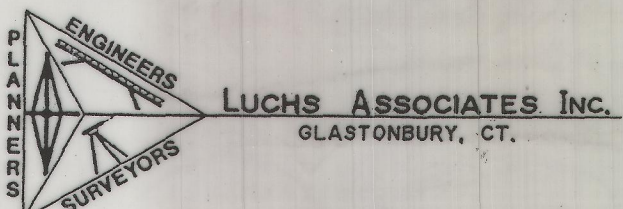

RECORD DRAWING

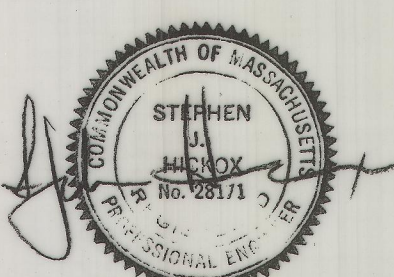

DESIGNED BY: R. JOHNSTON DRAWN BY: N. STANESCU SHEET CHK'D BY: J. LUCHS CROSS CHK'D BY: S. BEYER APPROVED BY: S. HICKOX DATE: JUNE 1995	CAMP DRESSER & MCKEE INC. CITY OF NEW BEDFORD, MASSACHUSETTS WASTEWATER SYSTEM IMPROVEMENTS CONTRACT NO. 9 COVE ROAD INTERCEPTOR	PROJECT NO. 309-49955 SHEET NO. 3
CDM environmental engineers, scientists, planners, & management consultants		