


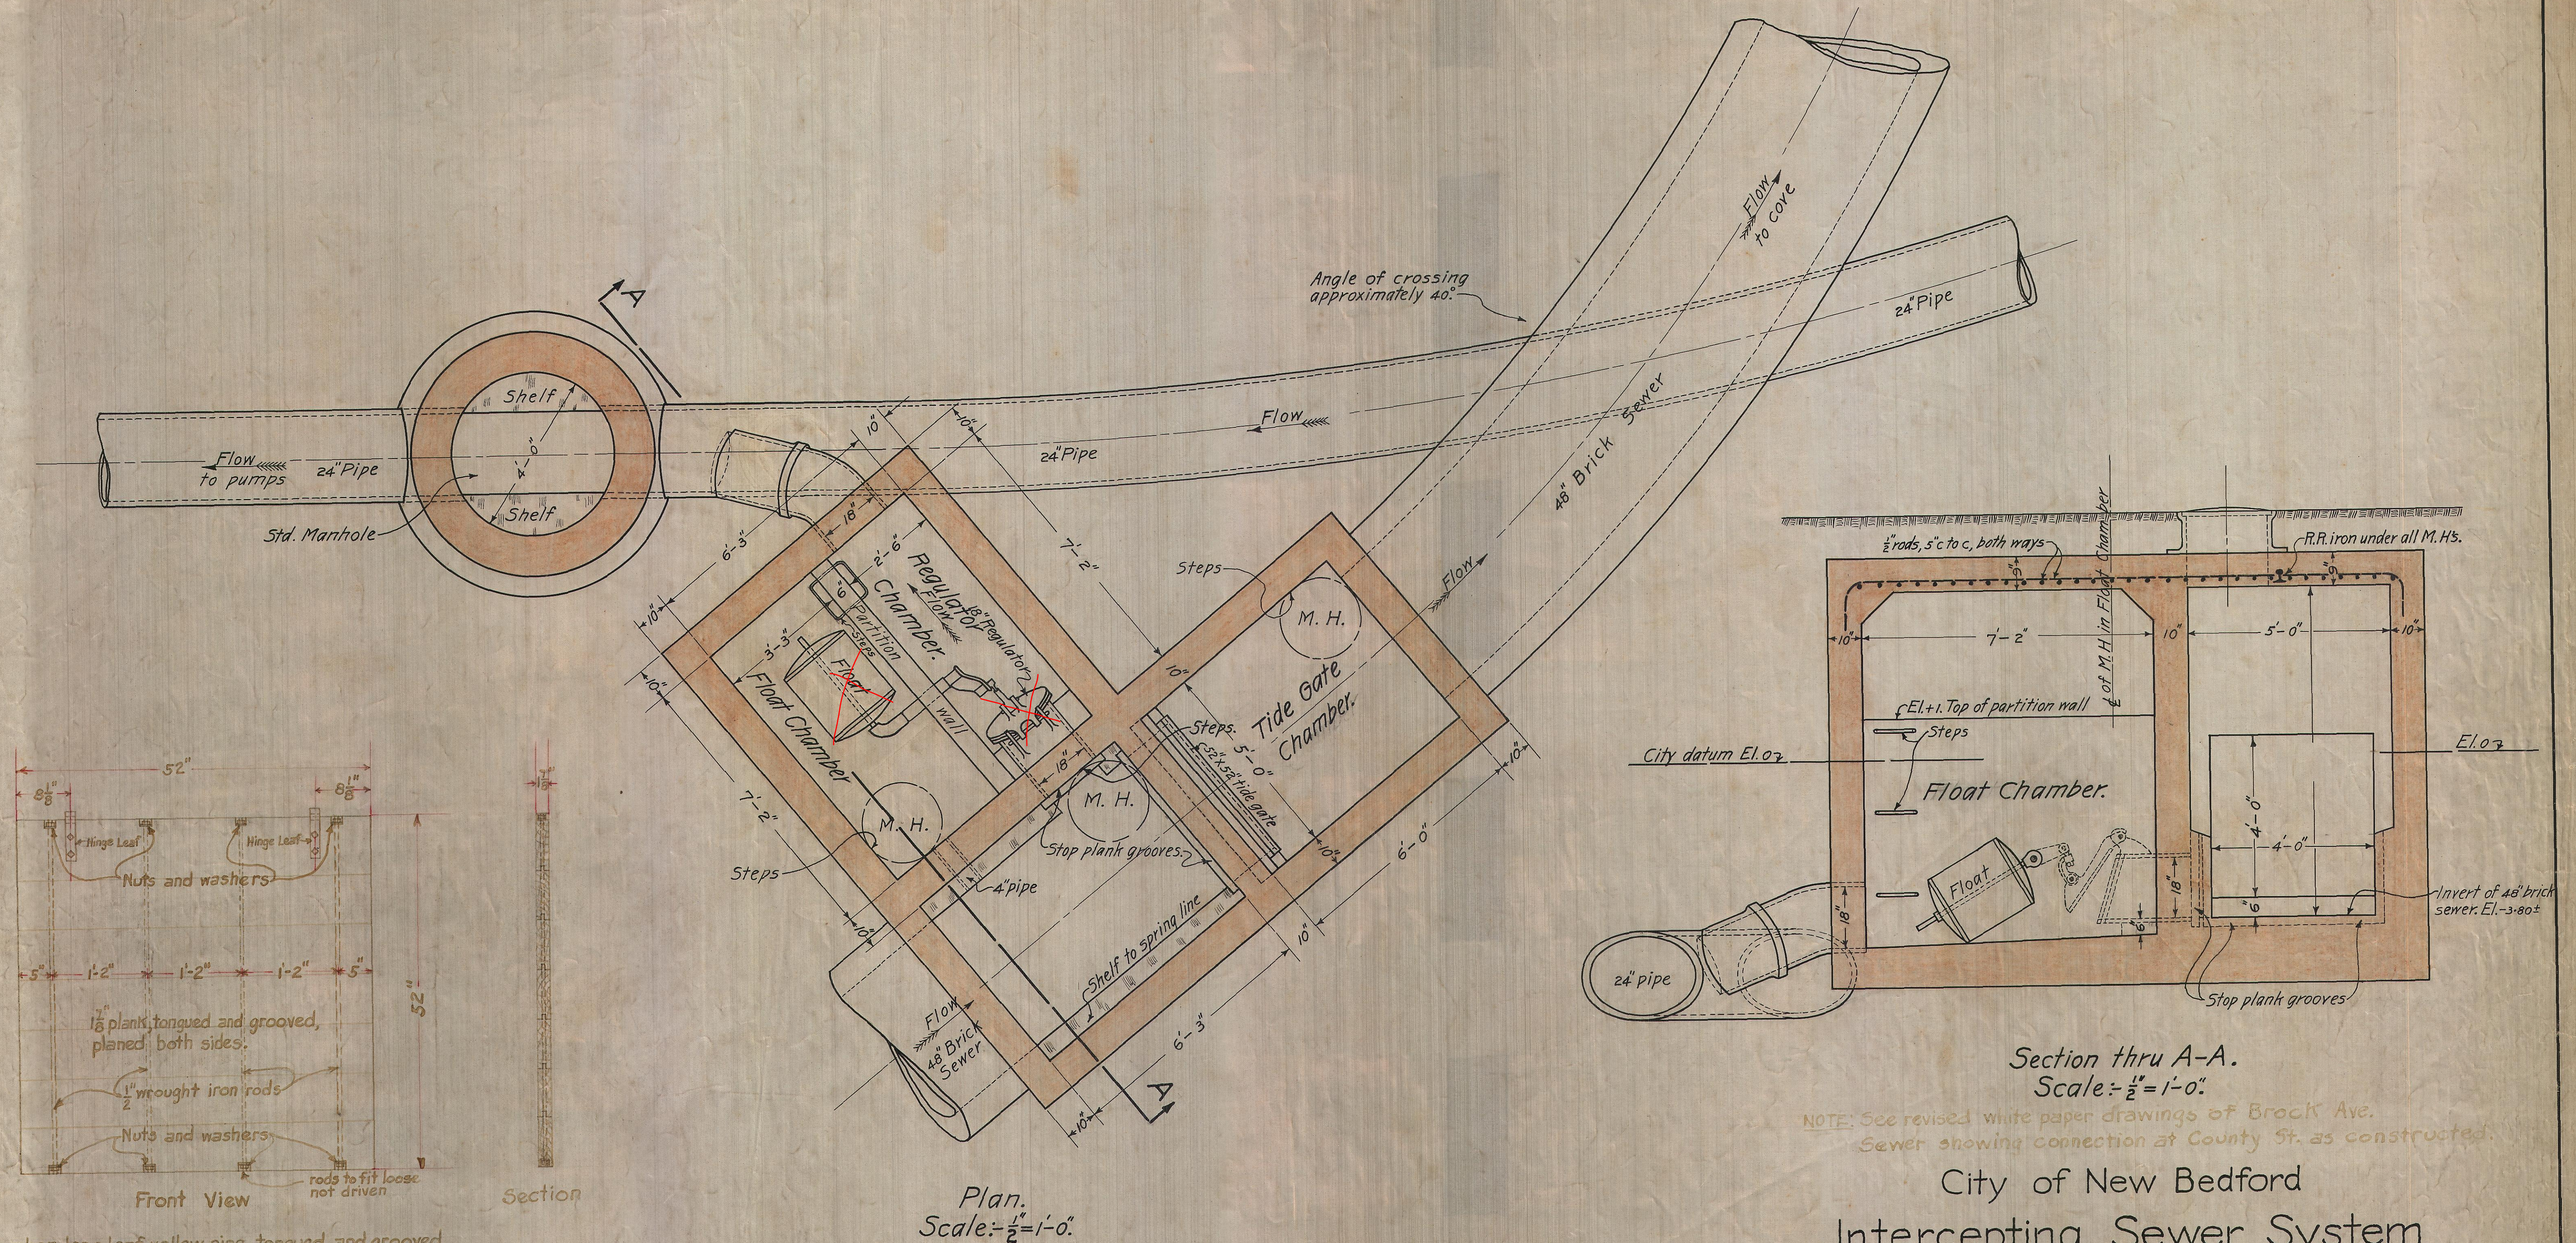

Lumber- long leaf yellow pine, tongued and grooved, free from shakes, sap, loose knots, sound and not kiln dried. Coated with carbolineum.

NEW TIDE GATE,
BROCK AVE. AND ORCHARD ST.
Installed Jan. 15, 1931.
Scale 1" = 1'

City of New Bedford
Intercepting Sewer System
LATERAL CONNECTION
Orchard St. and Cove Road.

Scales as noted. August, 1914.

William F. Williams
Consulting Engineer.