
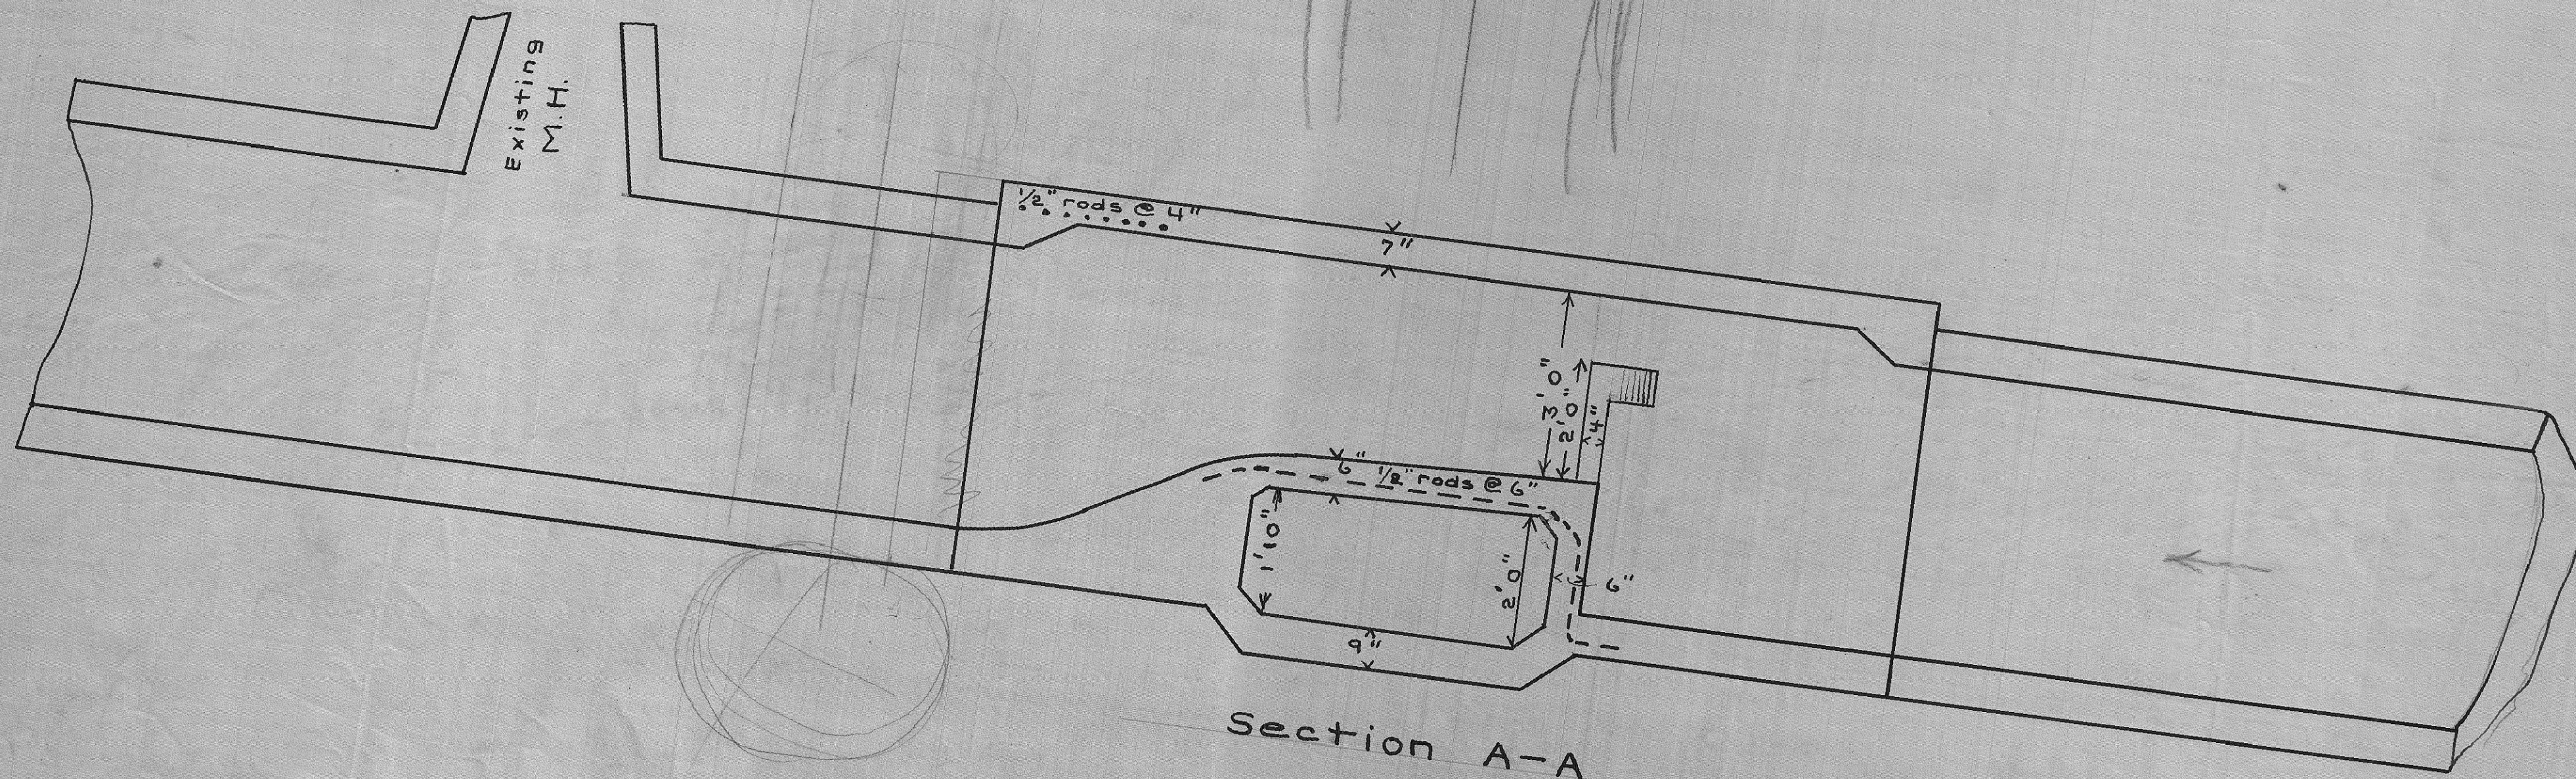


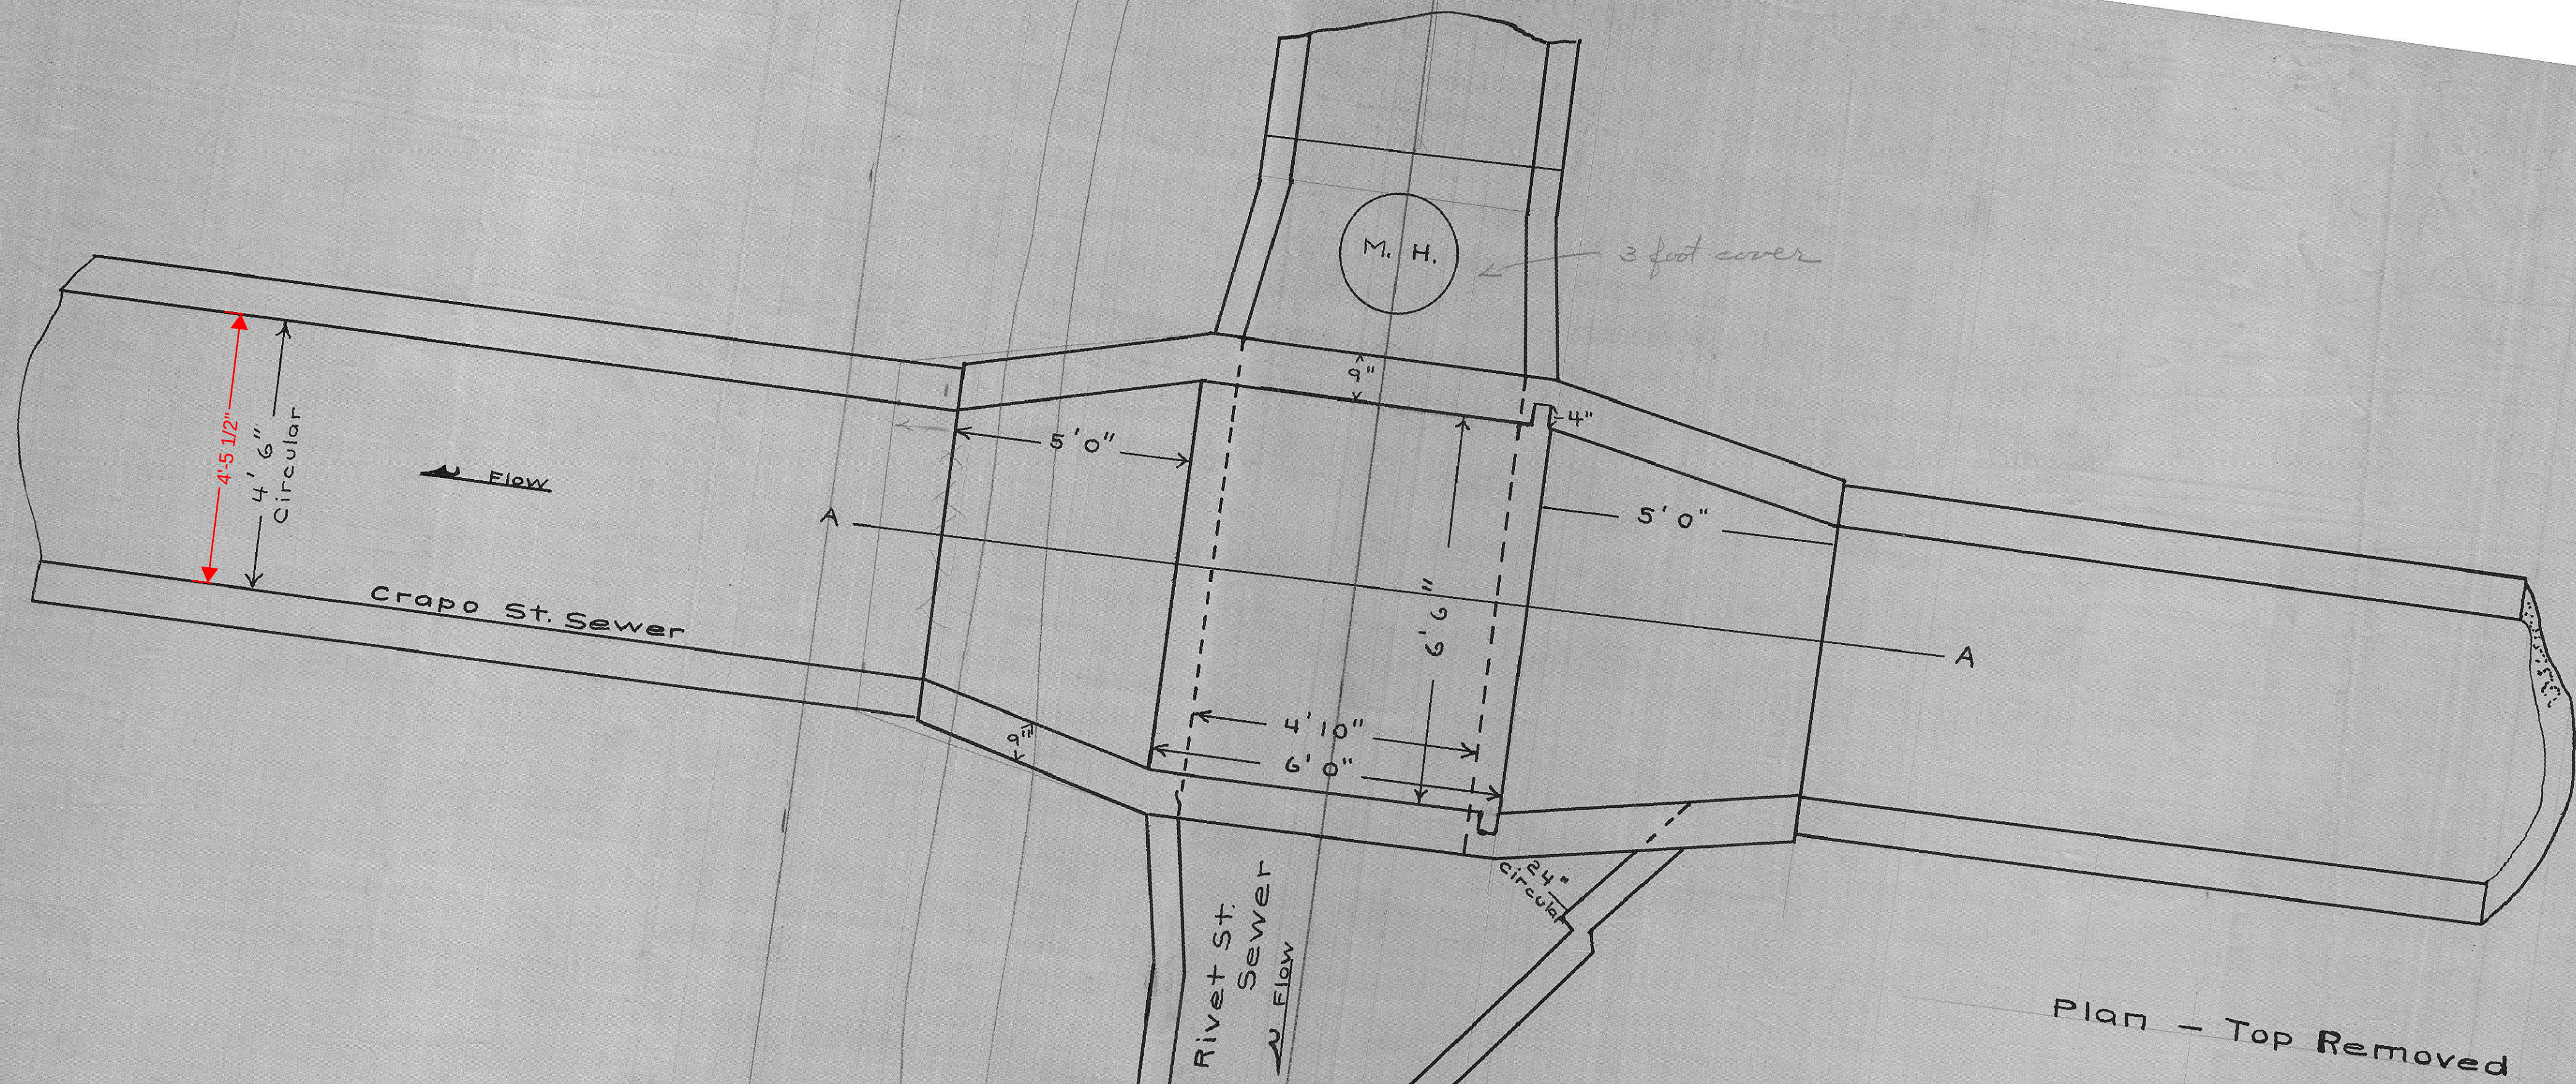

City of New Bedford
 Rivet St. Interceptor
 Crossing at Crapo Street.

Scale 1/2" = 1'-0"