


WEST FRENCH AVENUE AND CAPITOL STREET SEWER
 WEST FRENCH AVENUE - LUCAS STREET TO CAPITOL STREET
 CAPITOL STREET - WEST FRENCH AVENUE EASTERLY 440 FT.

LENGTH
 5675 feet of glazed pipe 15 inches in diameter
 3440 feet of glazed pipe 10 inches in diameter
 SCALE
 Horizontal, 1 inch = 60 feet Vertical 1 inch = 6 ft

Ordered Oct 26, 1910.
 Construction Commenced April 15, 1911.
 Construction Completed April 26, 1911.
 Average Cut 698 feet
 Ledge Excavated Cu Yds.
 Cost \$138,449
 Amount Assessed \$692.25
 Foreman Stephen Downey
 Field book 295 page 34.

William F. Williams
 CITY ENGINEER.

See Intercepting Sewer plans for location of manhole in Capitol St. east of West French Avenue.

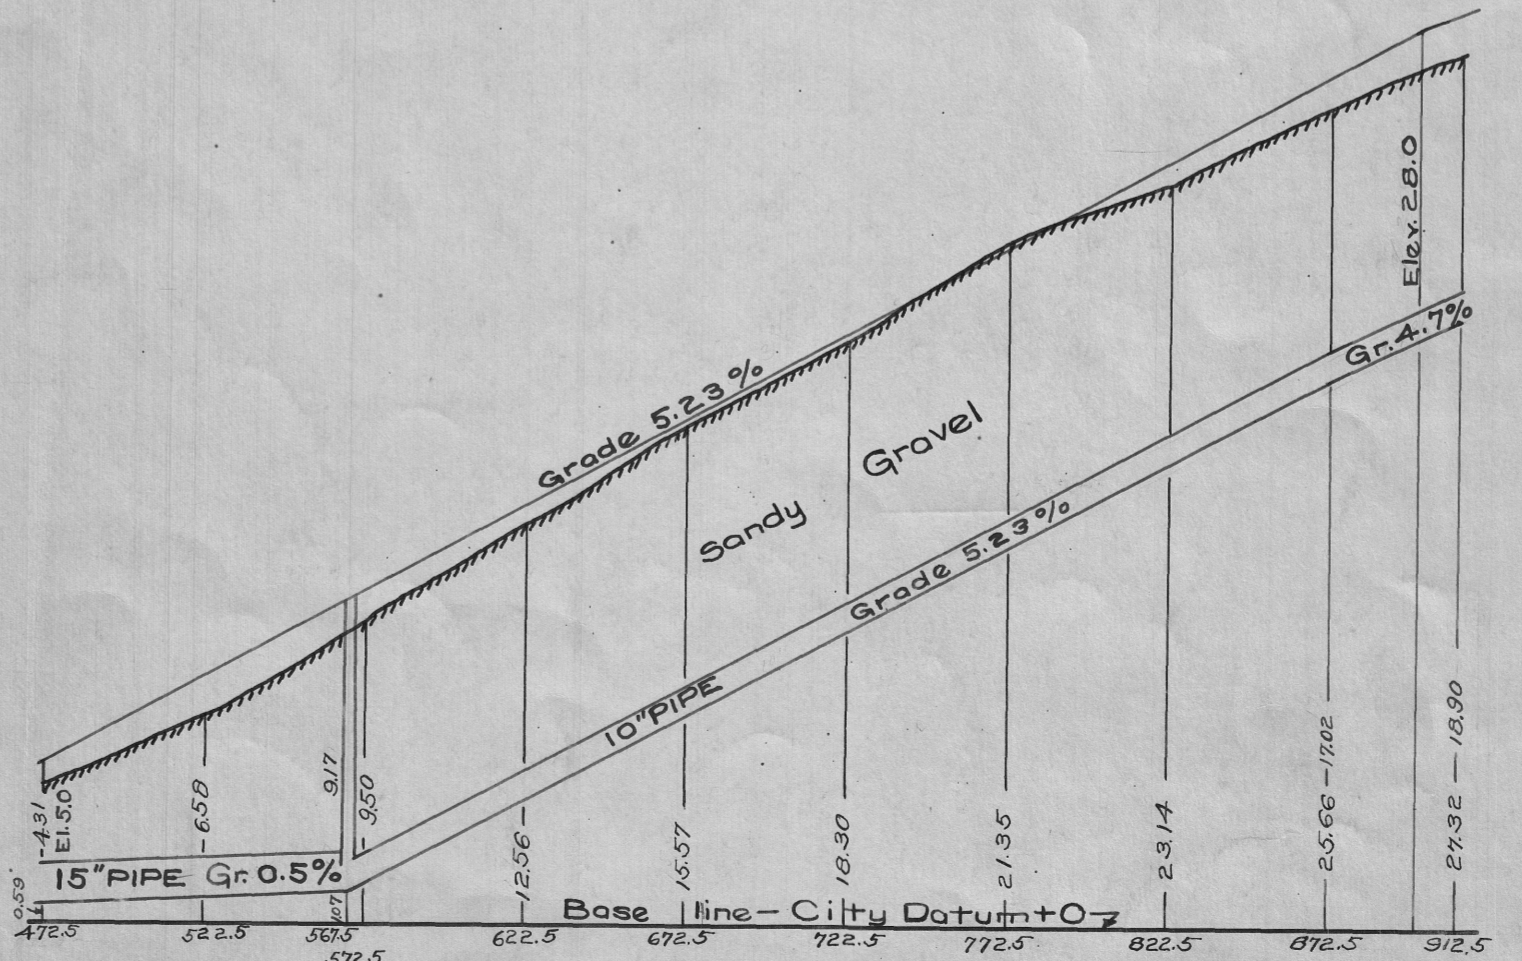

For further details of sewage disposal here see plan No. 2592.