


CLARKS COVE

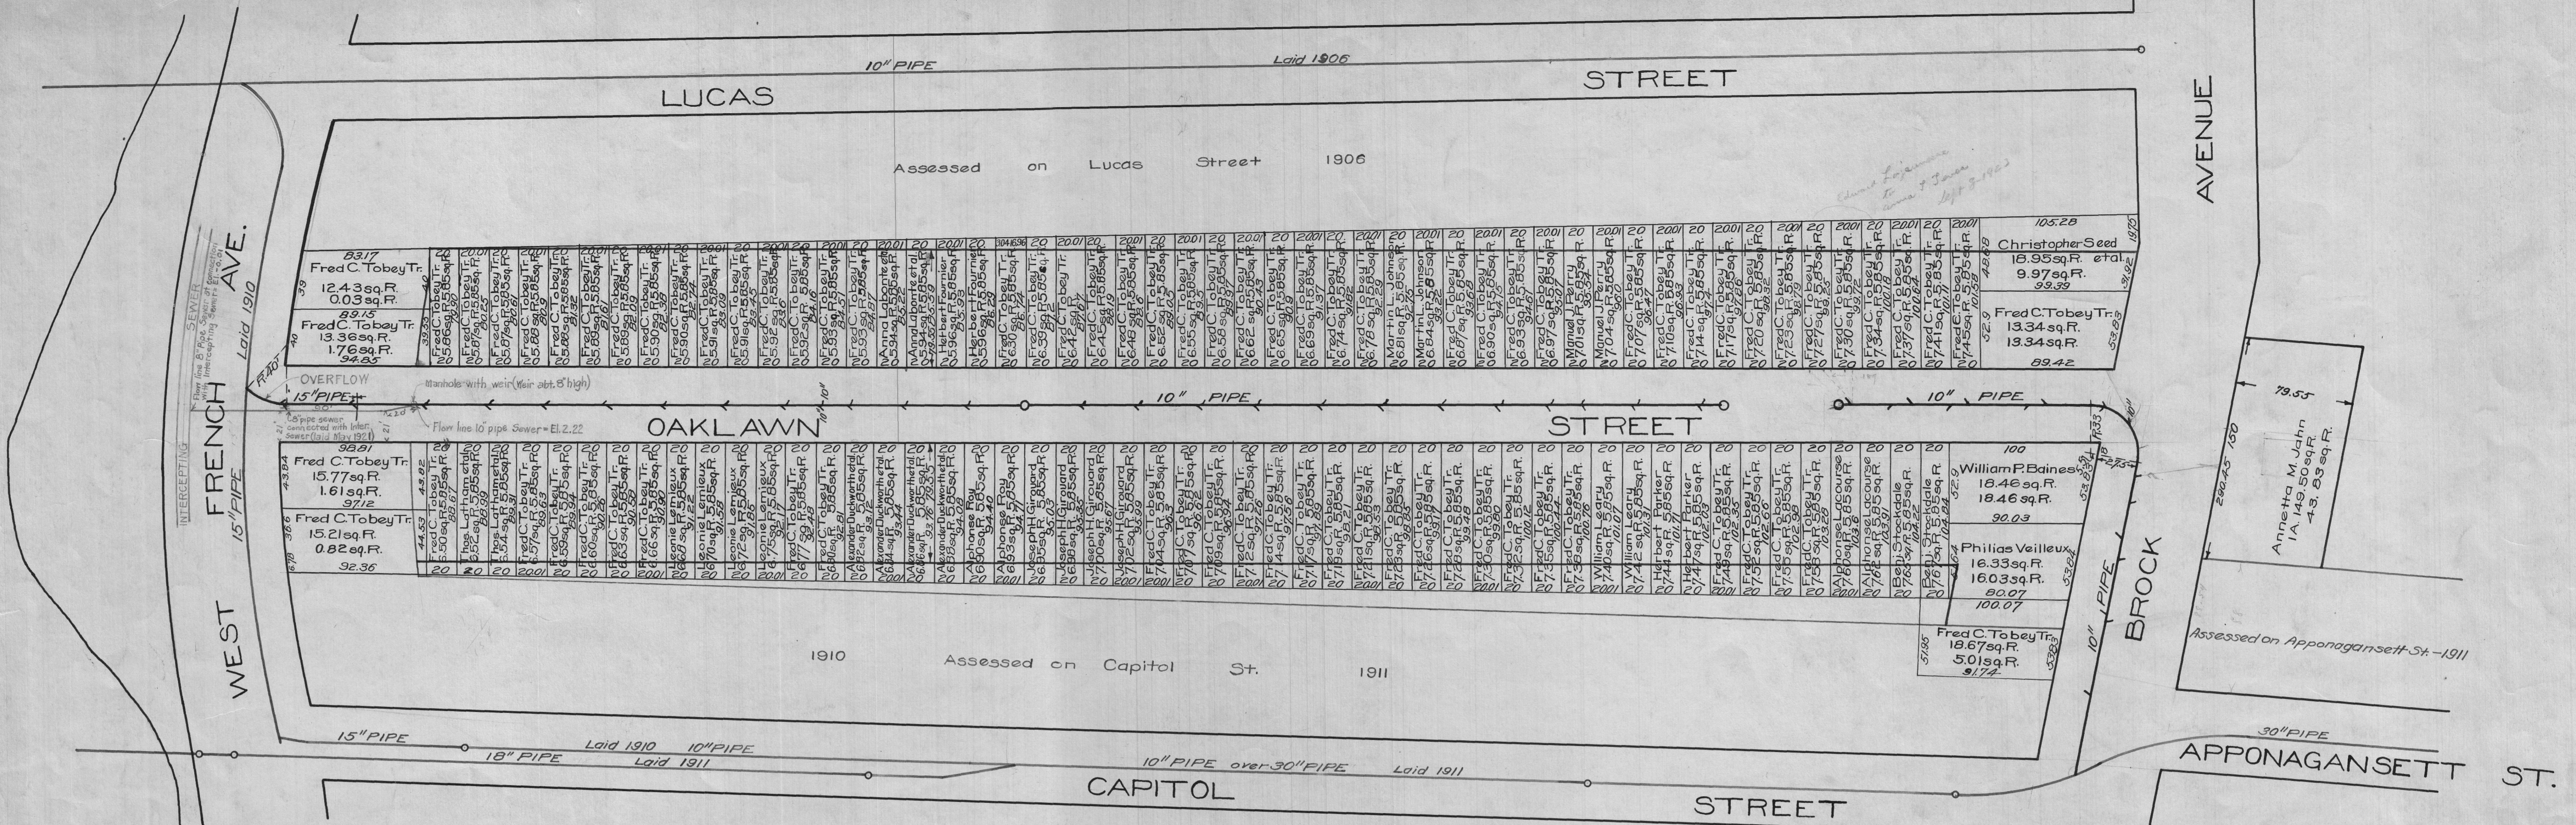


OAKLAWN STREET SEWER
FROM W. FRENCH AV. TO BROCK TO CAPITOL

LENGTH
80 feet of glazed pipe 15 inches in diameter
1352 feet of glazed pipe 10 inches in diameter
SCALE
Horizontal, 1 inch = 60 feet Vertical, 1 inch = 6 feet

Ordered Sept. 12, 1912
Construction Commenced Dec. 17, 1912
Construction Completed Feb. 3, 1913
Average Cut 9.68 feet
Ledge Excavated NONE
Cost \$4258.82
Amount Assessed \$2129.41
Foreman John Andrews

Field Book 411-17
CITY ENGINEER

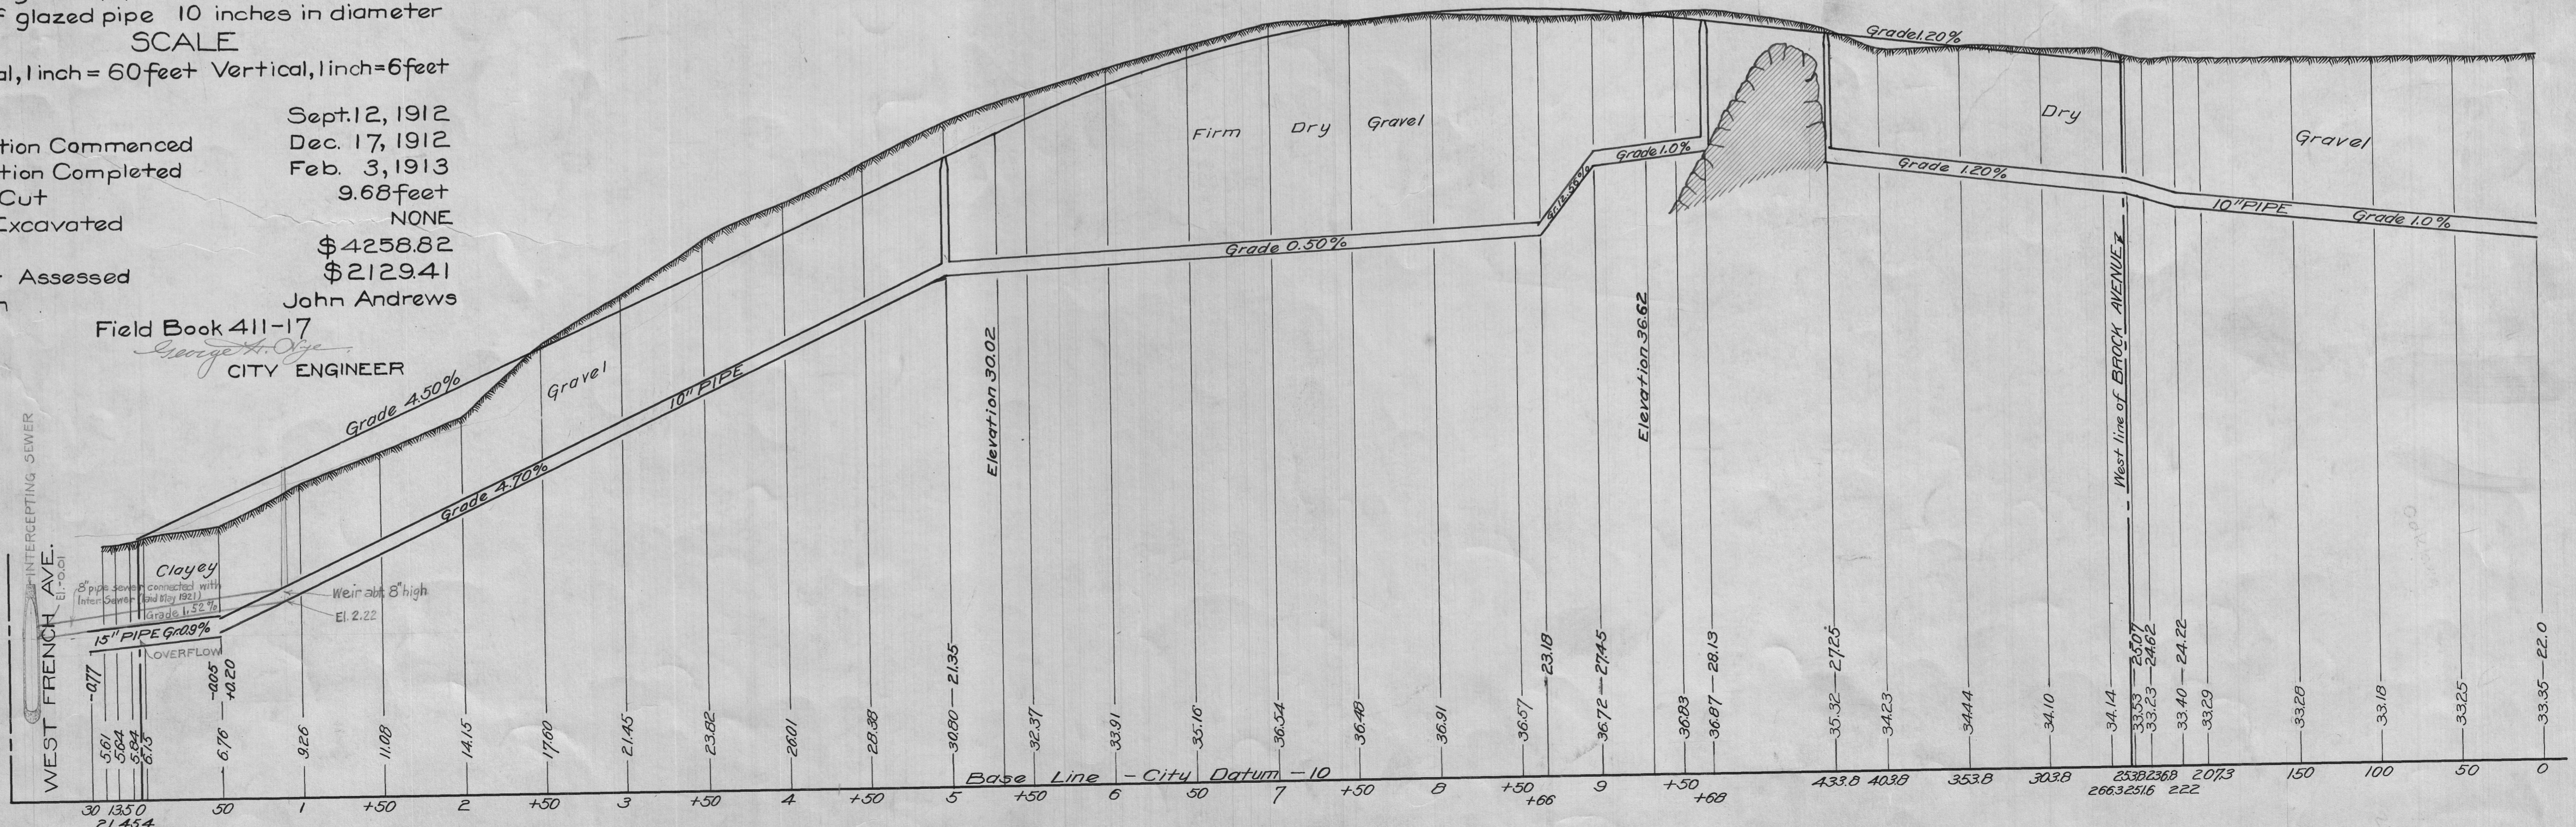

WEST FRENCH AVE. 15" PIPE 0.08%
OVERFLOW
Weir abt 8" high
El. 21.22

Clayey
15" PIPE 0.08%
OVERFLOW

Grade 4.50%

Grade 4.70%

Grade 0.50%

Grade 1.20%

Grade 1.0%

Grade 1.0%

