


SECTION 1

SECTION 2

SECTION 3

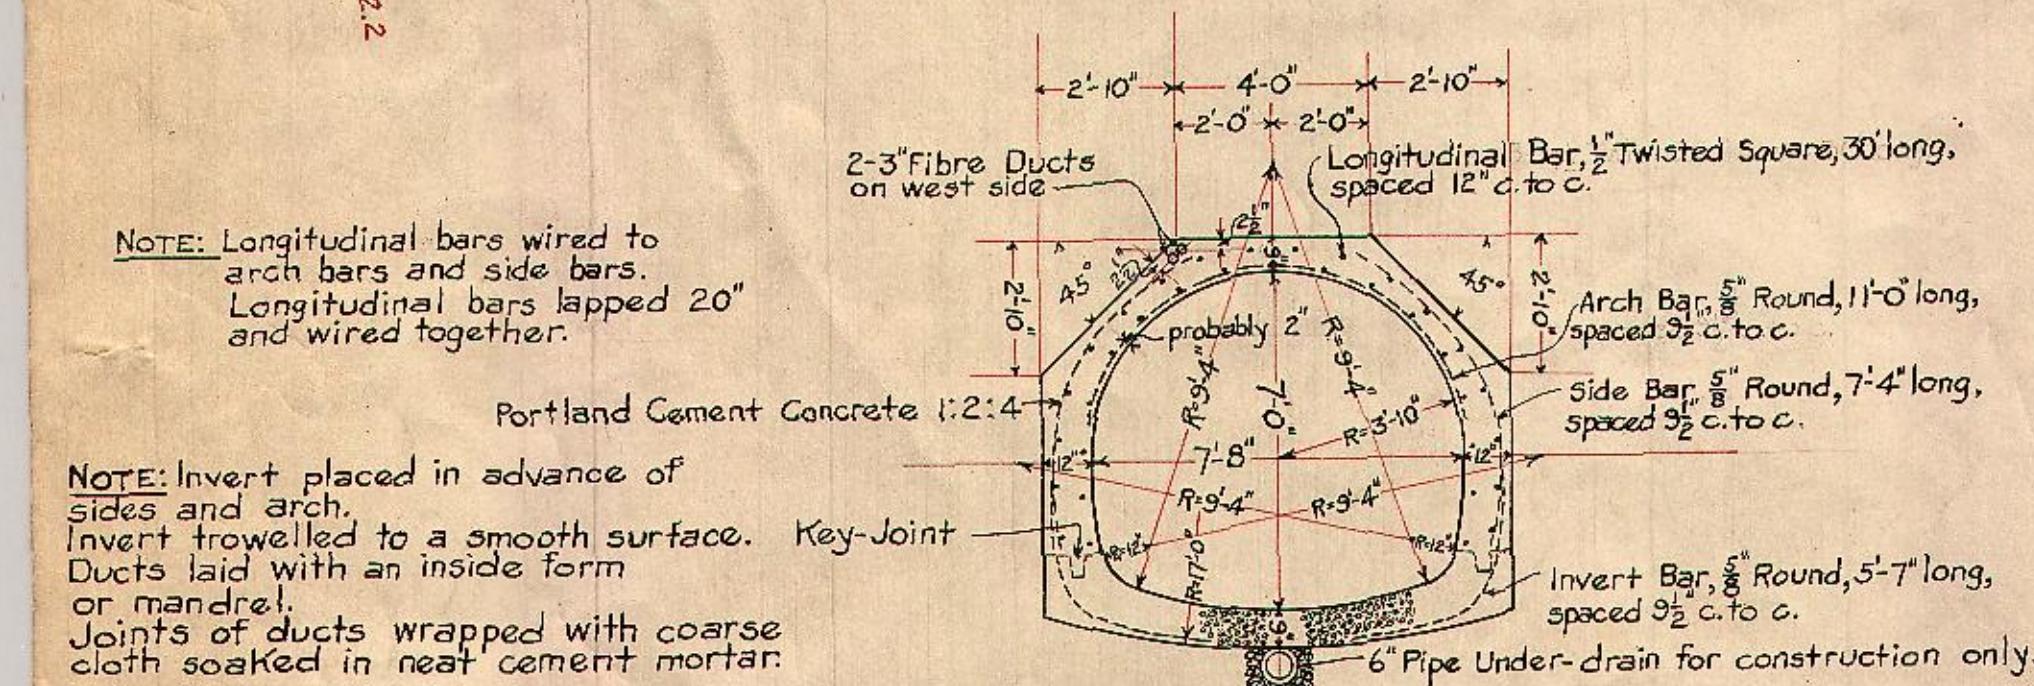

**SECTION OF 7'-0"X7'-8" REINFORCED CONCRETE SEWER
STA. 96+00-STA. 108+00**

SCALE 1:4

SECTION 2

SECTION 3

SECTION 4

SECTION 245

</