



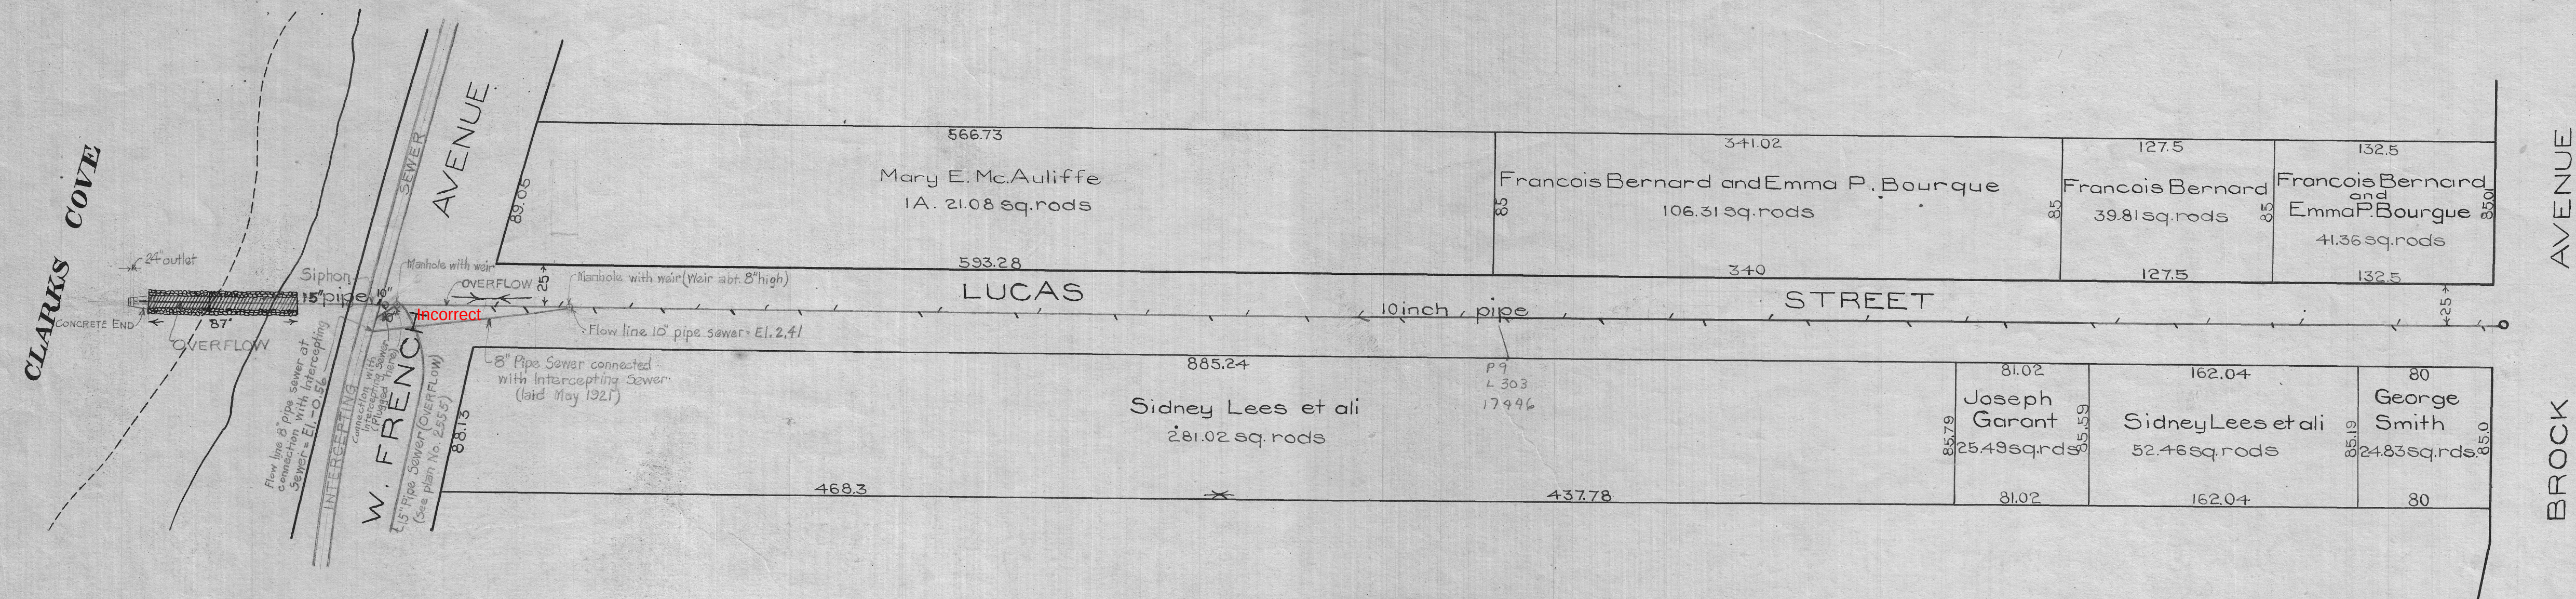

**LUCAS STREET SEWER**  
 FROM 120th W. of W. FRENCH AVE. TO BROCK AVE.  
 LENGTH  
 200.0 feet of glazed pipe 15 inches in diameter  
 1206.5 " " " " " " " " " " " "  
 1406.5 " " " " " " " " " " " "  
 SCALE  
 Horizontal, 1 inch = 60 feet. Vertical, 1 inch = 6 feet

Ordered May 10, 1906  
 Construction Commenced May 26, 1906  
 Average Cut 7.9 feet  
 Ledge Excavated None  
 Cost \$3471.18  
 Amount Assessed \$1735.59  
 Foreman William Leary  
 Field-book 211, pages 36, 37

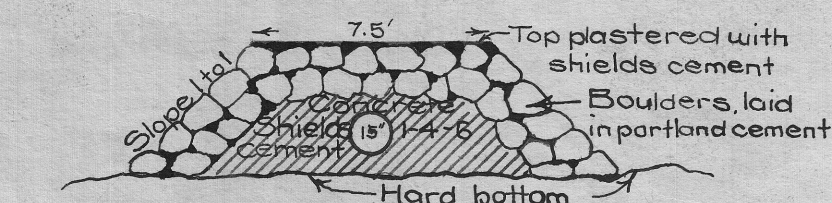

SECTION AT MOUTH OF SEWER  
 Scale, 1 inch = 6 feet

*William F. Williams*  
 CITY ENGINEER

