

CLARKS COVE

WEST

C.L. OF

INTERCEPTING FRENCH

AVENUE

OAKLAWN ST

CAPITOL ST

CALUMET ST

AQUIDNECK ST

BELLEVUE ST

PLAN

NOTE: Name WEST FRENCH AVENUE changed to RODNEY FRENCH BOULEVARD, Sept. 10, 1923.

NOTE: For record of branches in 8" Pipe Sewer in Calumet St. see N.B. 360-58.

AUTHORITY OF CHAP. 474, ACTS OF 1910.
SEWAGE DISPOSAL
NEW BEDFORD, MASS.
INTERCEPTING SEWER
STA. 83+50 - STA. 96+00

SCALES: PLAN 1"=40' PROFILE 1"=40' HORIZ. 1"=40' VERT. 1"=4'

SEPT. 1920.

SECTION 2

SECTION OF 7'-0"X7'-8" REINFORCED CONCRETE SEWER
STA. 83+46.65 - STA. 96+00
SCALE 1"=4'

7'-0"X7'-8" REINFORCED CONCRETE SEWER

CITY DATUM - ELEVATION 0.07


GRADE 0.0003' PER FOOT

PROFILE


SHEET 9 OF 9

NOTE: Longitudinal bars wired to arch bars and side bars. Longitudinal bars lapped 20" and wired together.

NOTE: Invert placed in advance of sides and arch. Invert trowelled to a smooth surface. Ducts laid with an inside form or mandrel. Joints of ducts wrapped with coarse cloth soaked in neat cement mortar.

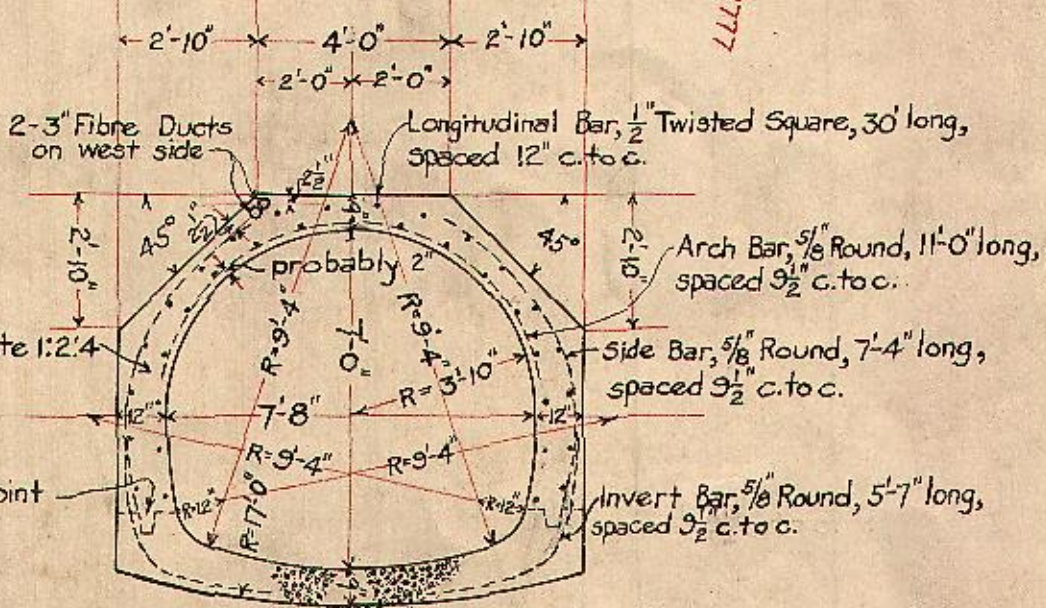

Manholes in Capitol St. (as located Nov. 1930)
East of E. Line
Rodney French Boulevard (W.)
North of S. Line
Capitol St.
76'
87'
95.5'
14.5'
19.5'
25.0'

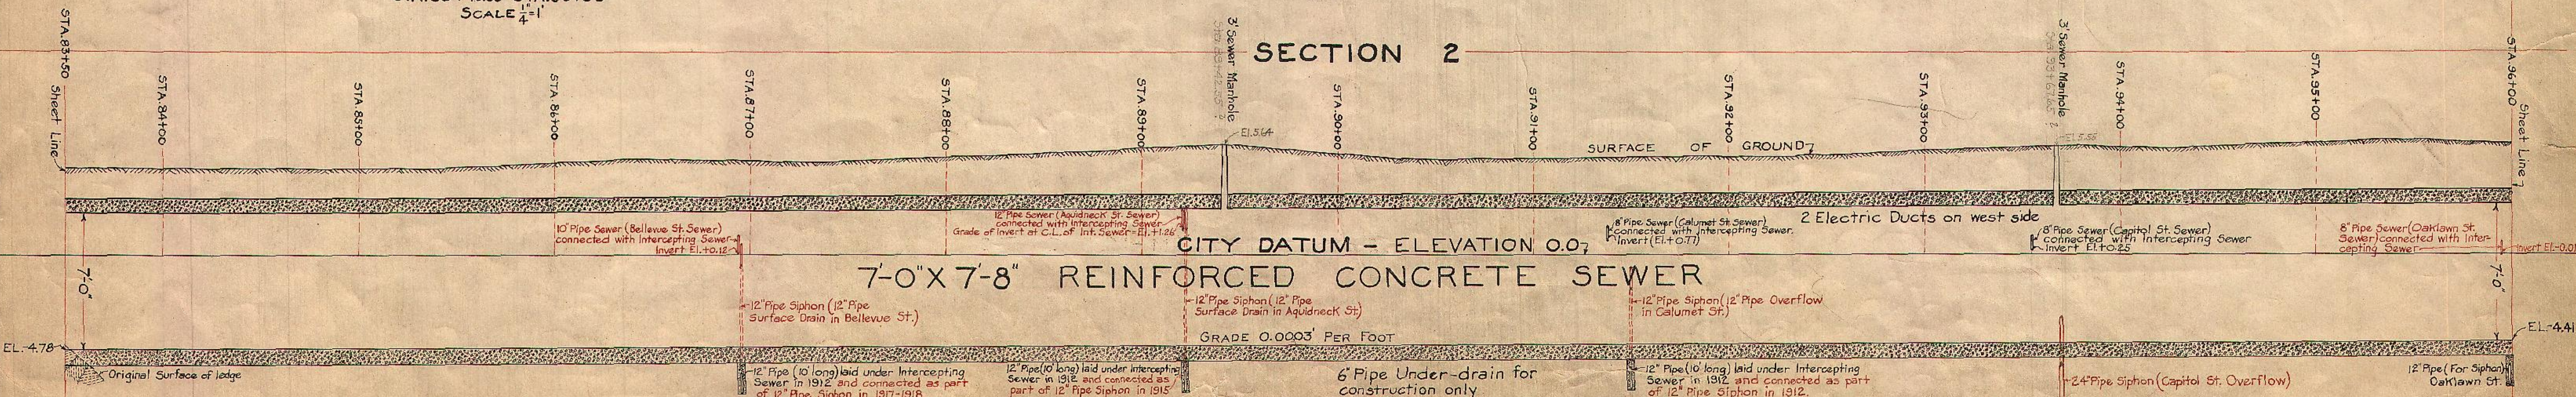

For details of Bellevue St. Sewer and Surface Drain see plan No. 2777.

12" Pipe (10' long) laid under Intercepting Sewer in 1912 and connected as part of 12" Pipe Siphon in 1917-1918. For details of Aquidneck St. Sewer and Surface Drain see plan No. 2732.

6" Pipe Under-drain for construction only.

For details of Calumet St. Sewer and Overflow see plan No. 2653.

For details of Capitol St. Sewer and Overflow see plan No. 2592.