



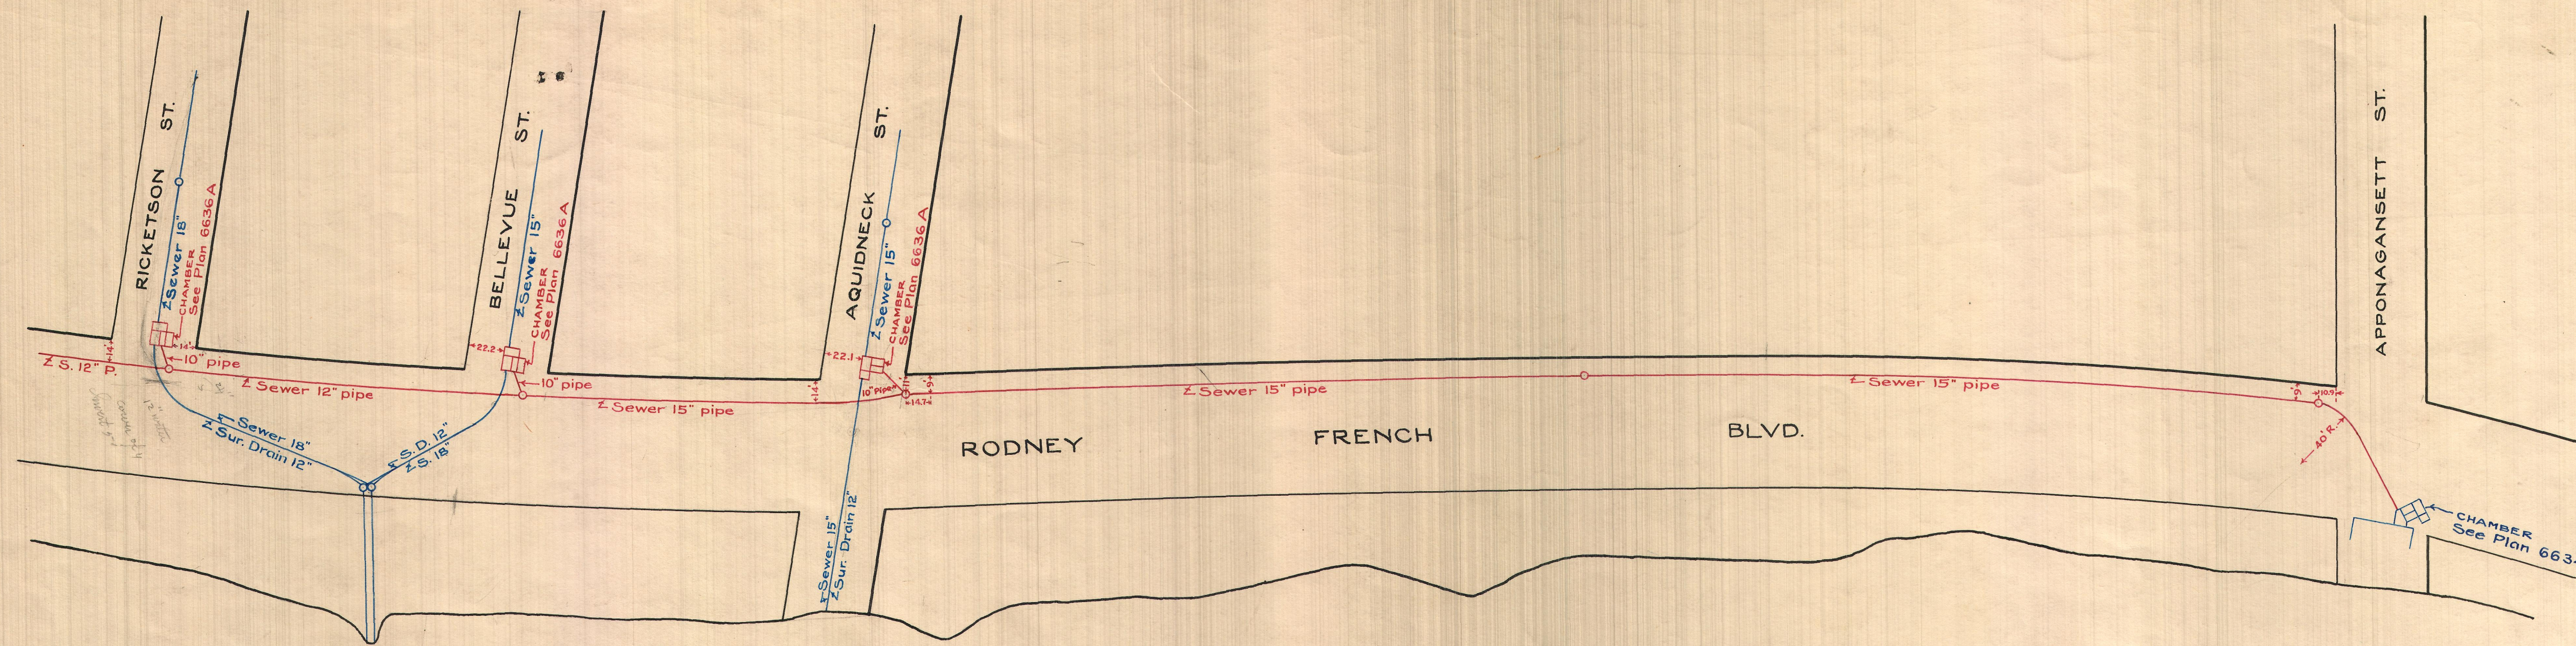

INTERCEPTING SEWER SYSTEM
SEWER
RODNEY FRENCH BOULEVARD

SCALE
Horizontal:- 1 inch=60 feet Vertical:- 1 inch=6 feet
BUILT UNDER C.W.A.
1934
PLAN MADE 1942

Patrick J. Foley
COMMISSIONER

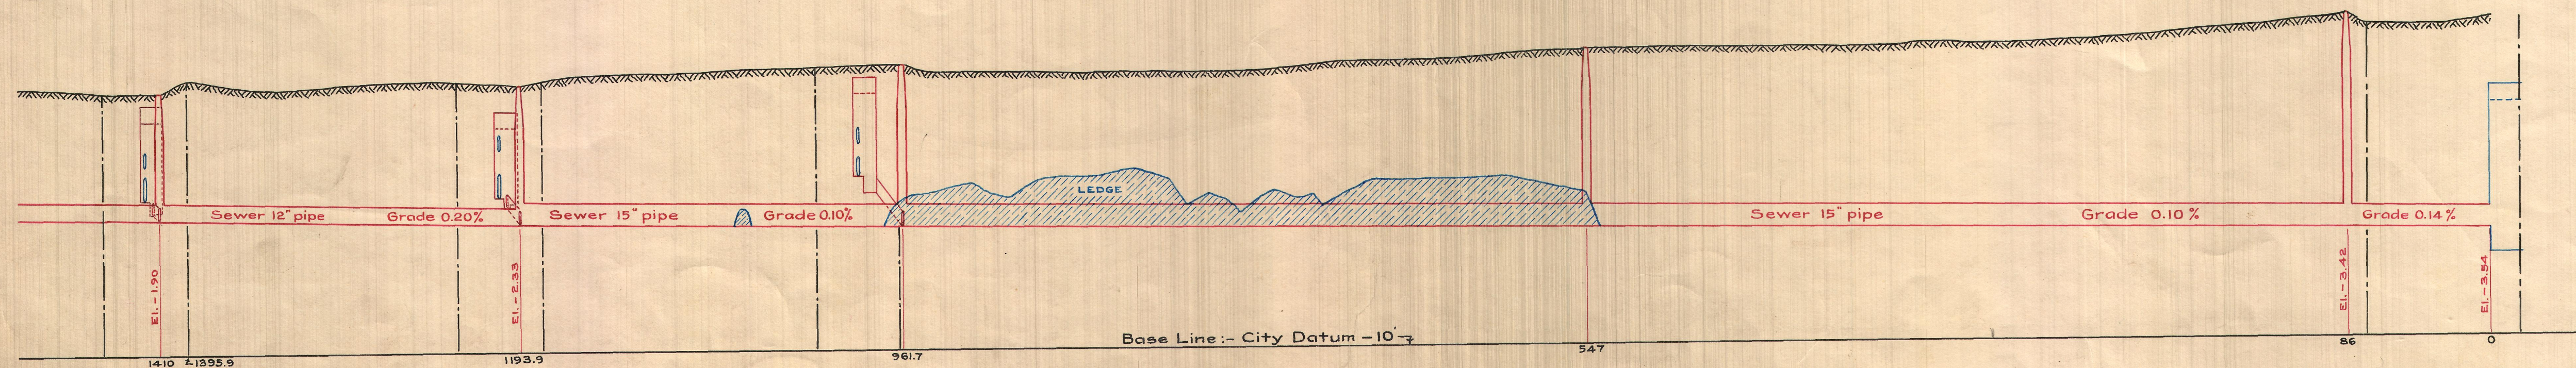

6636