




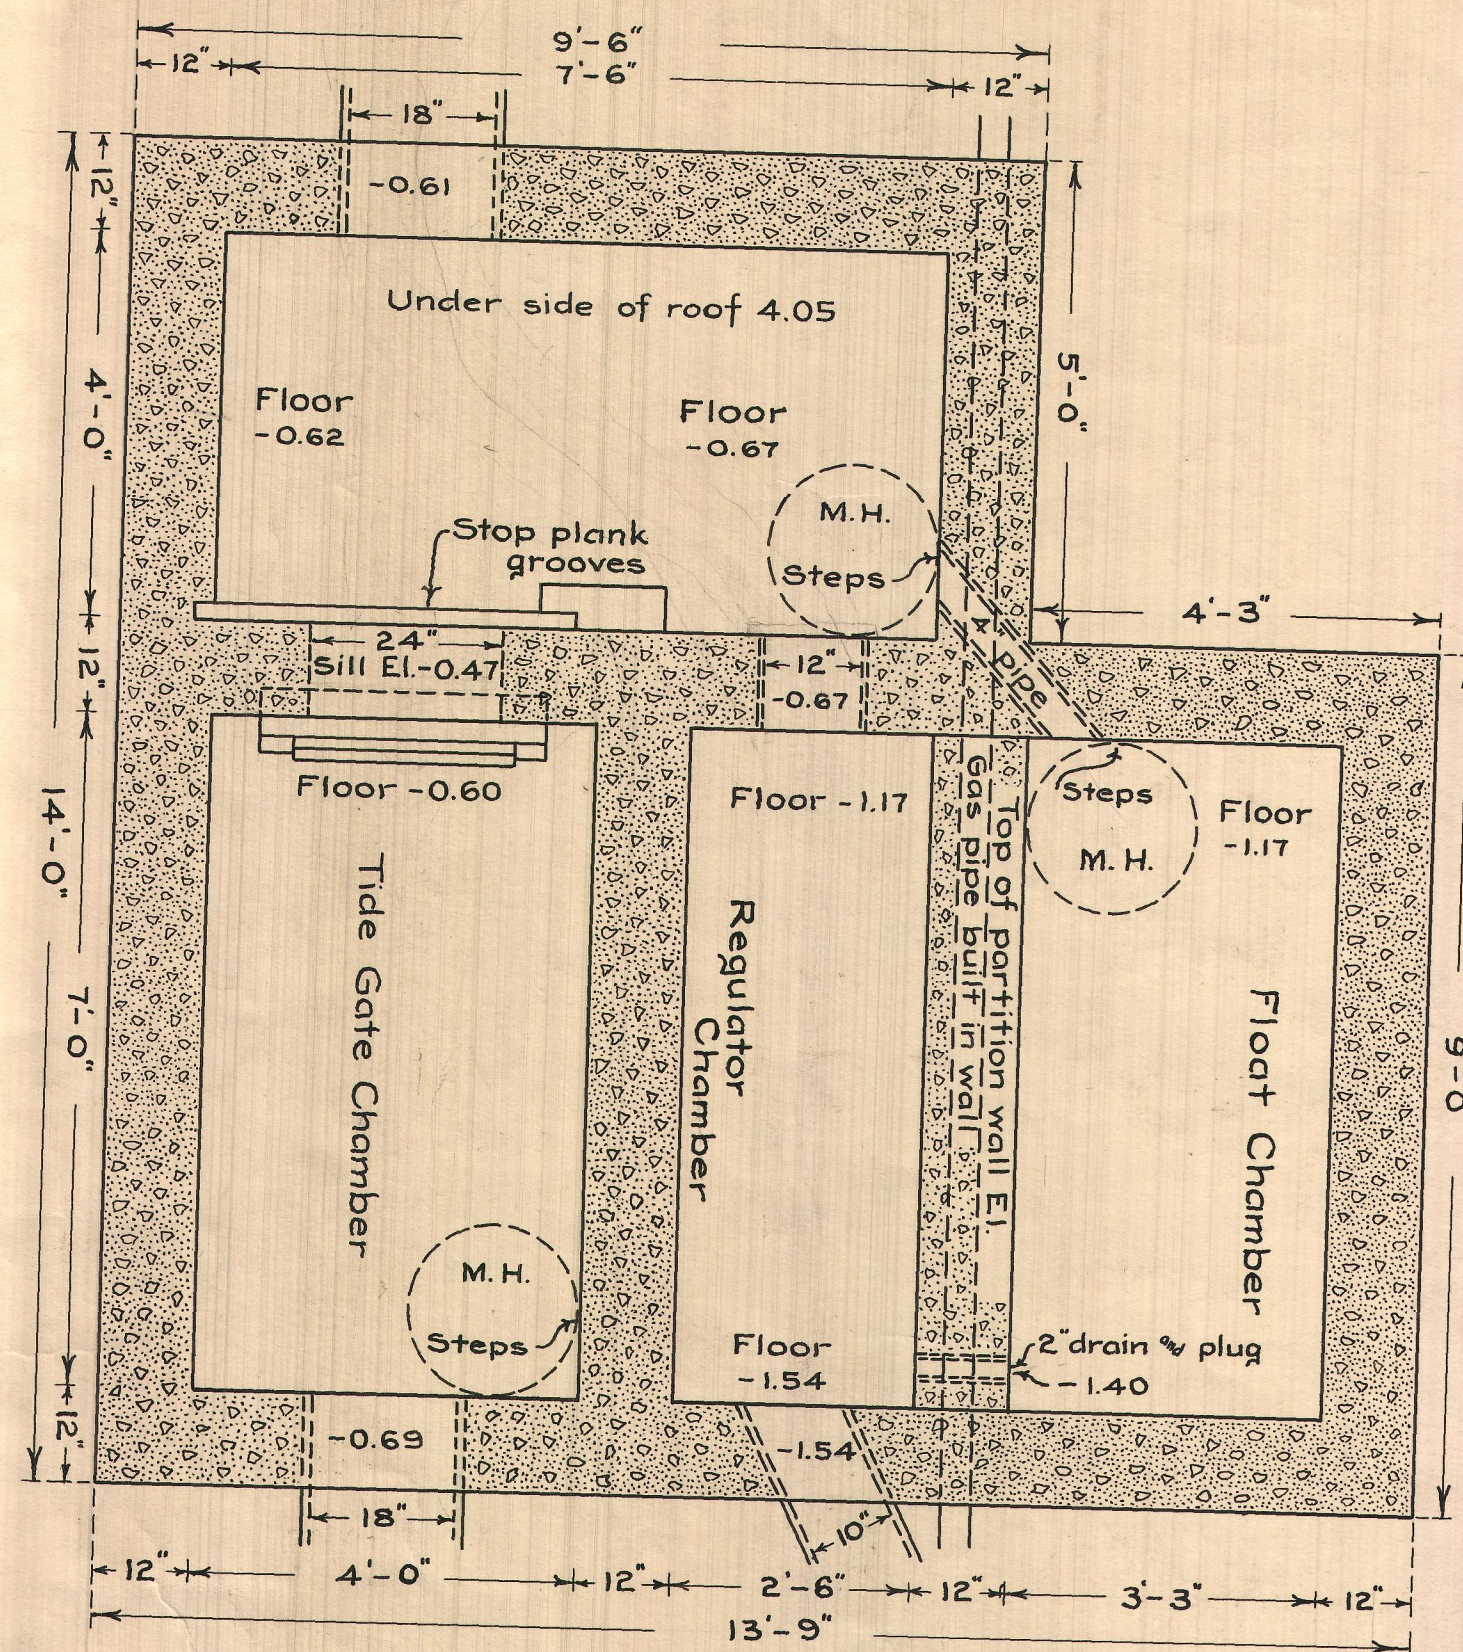

PLAN OF CHAMBER
AT
RICKETSON STREET
SCALE 1 IN. = 2 FT.

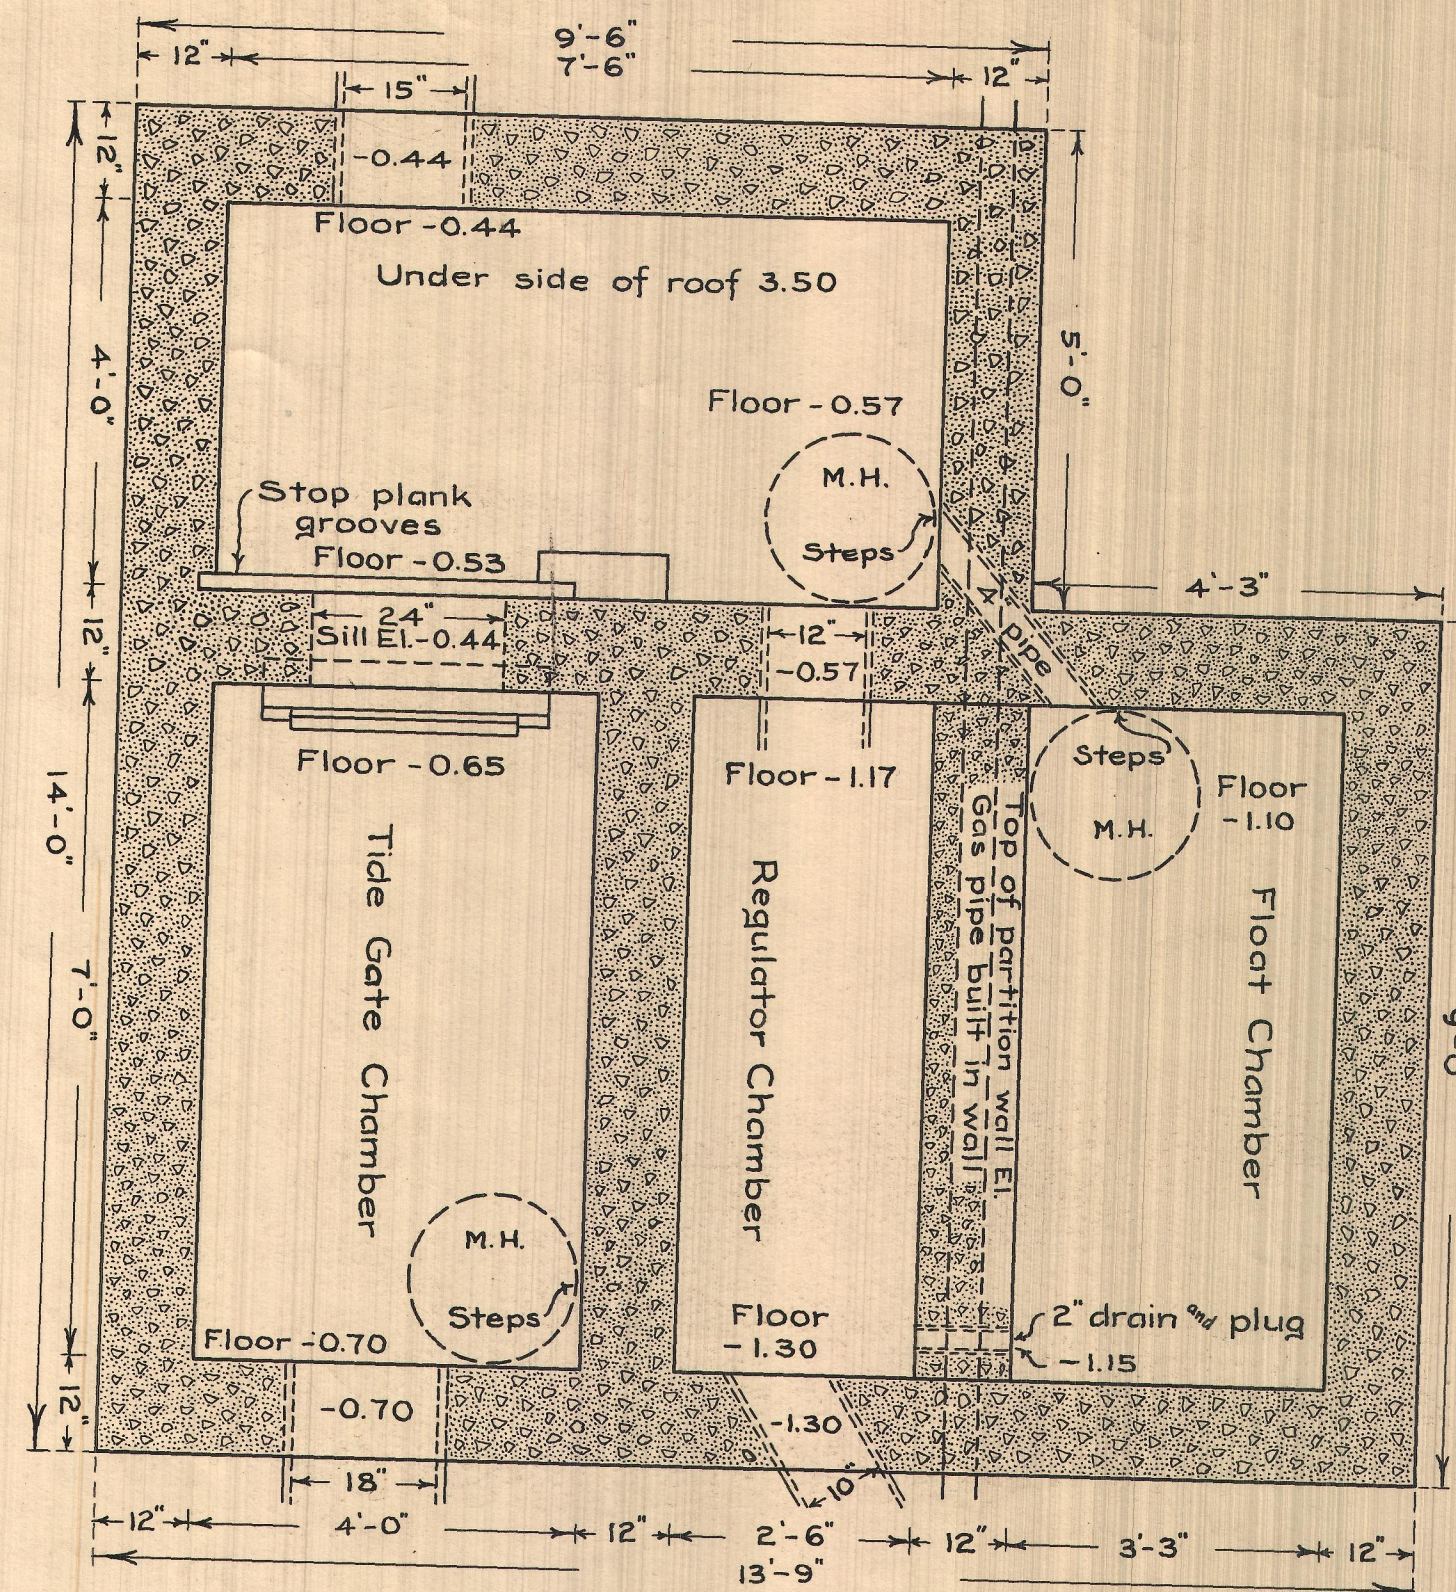

PLAN OF CHAMBER
AT
BELLEVUE STREET
SCALE 1 IN. = 2 FT.

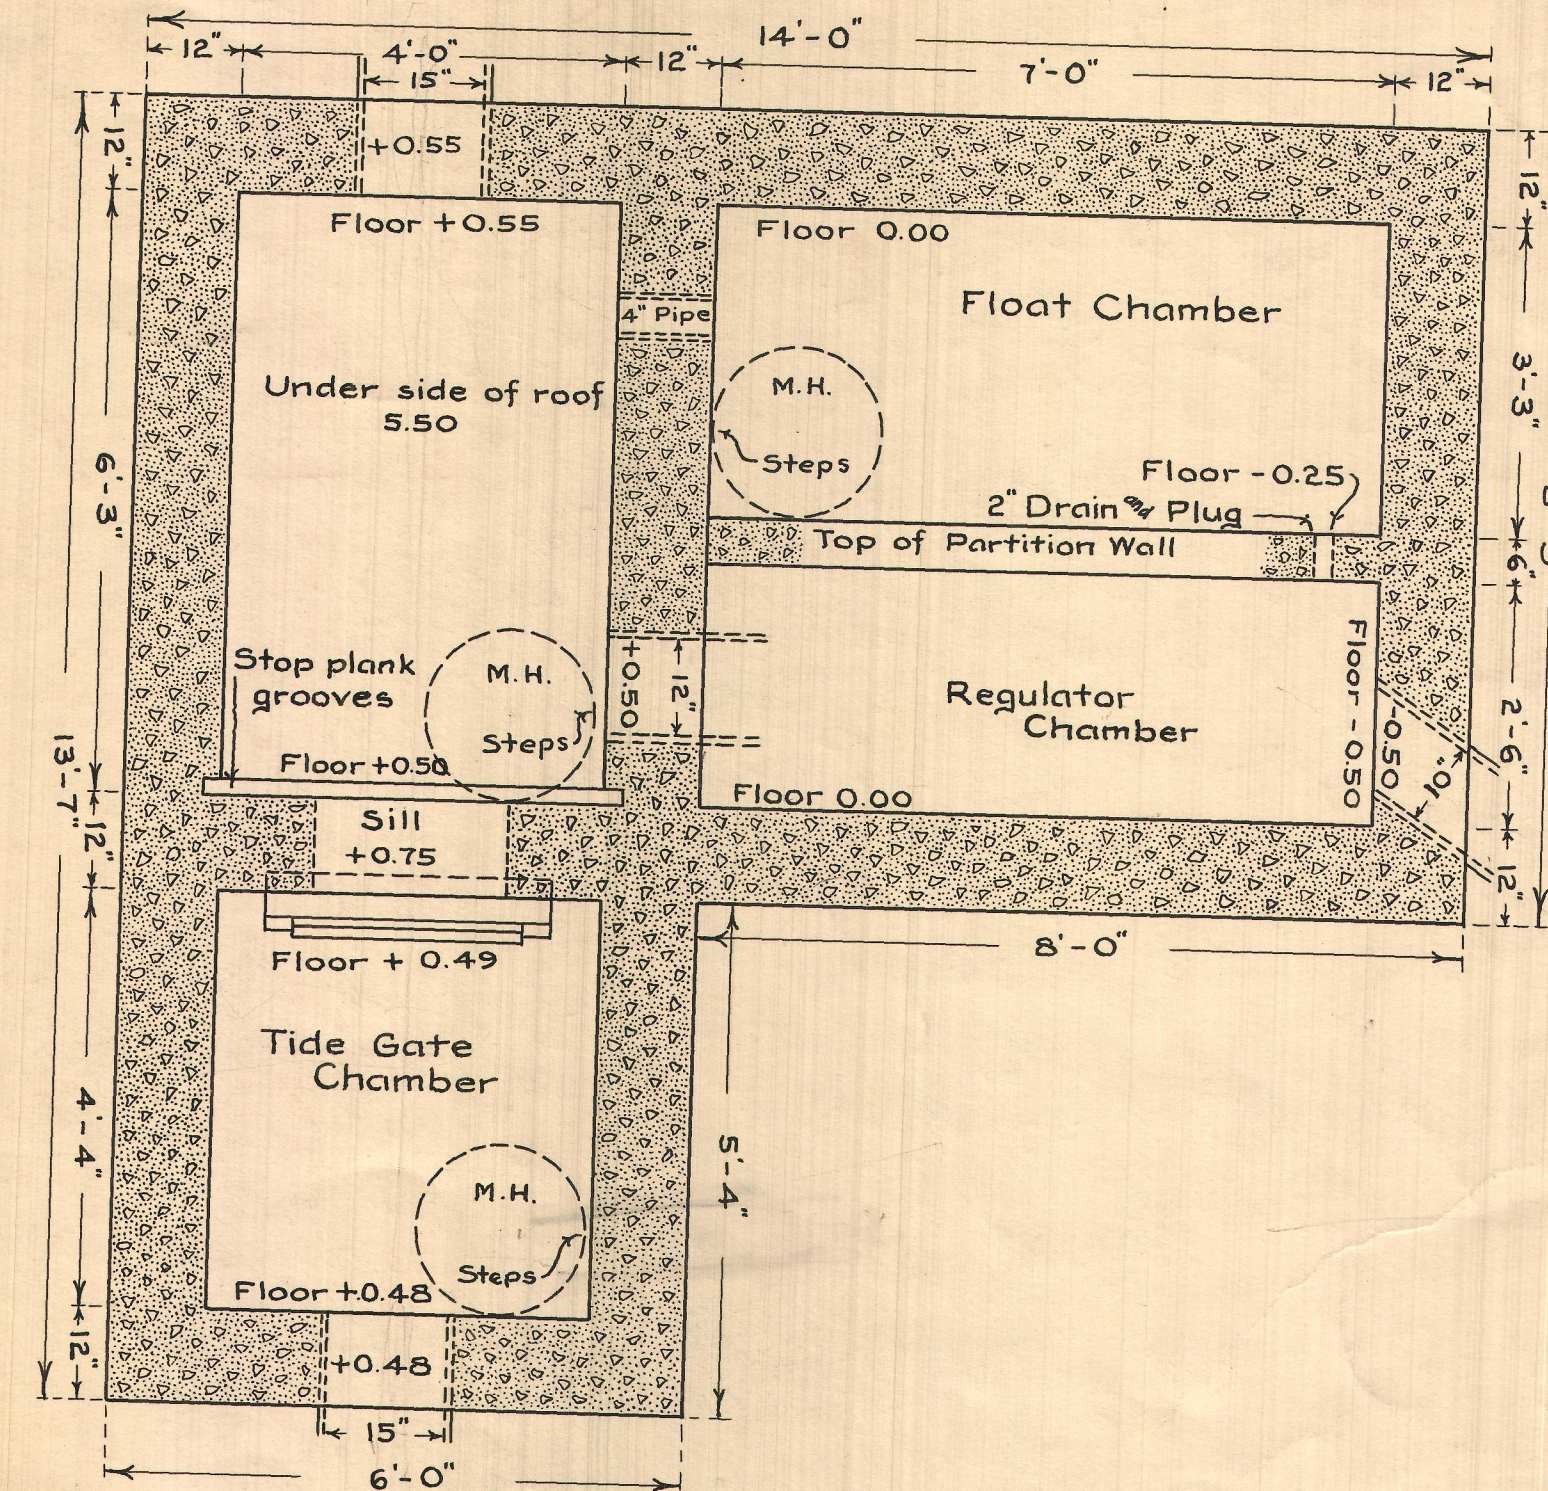

PLAN OF CHAMBER
AT
AQUIDNECK STREET
SCALE 1 IN. = 2 FT.

INTERCEPTING SEWER SYSTEM SEWER RODNEY FRENCH BOULEVARD

BUILT UNDER C.W.A.

1934

PLAN MADE 1943

Patrick J. Foley
COMMISSIONER