




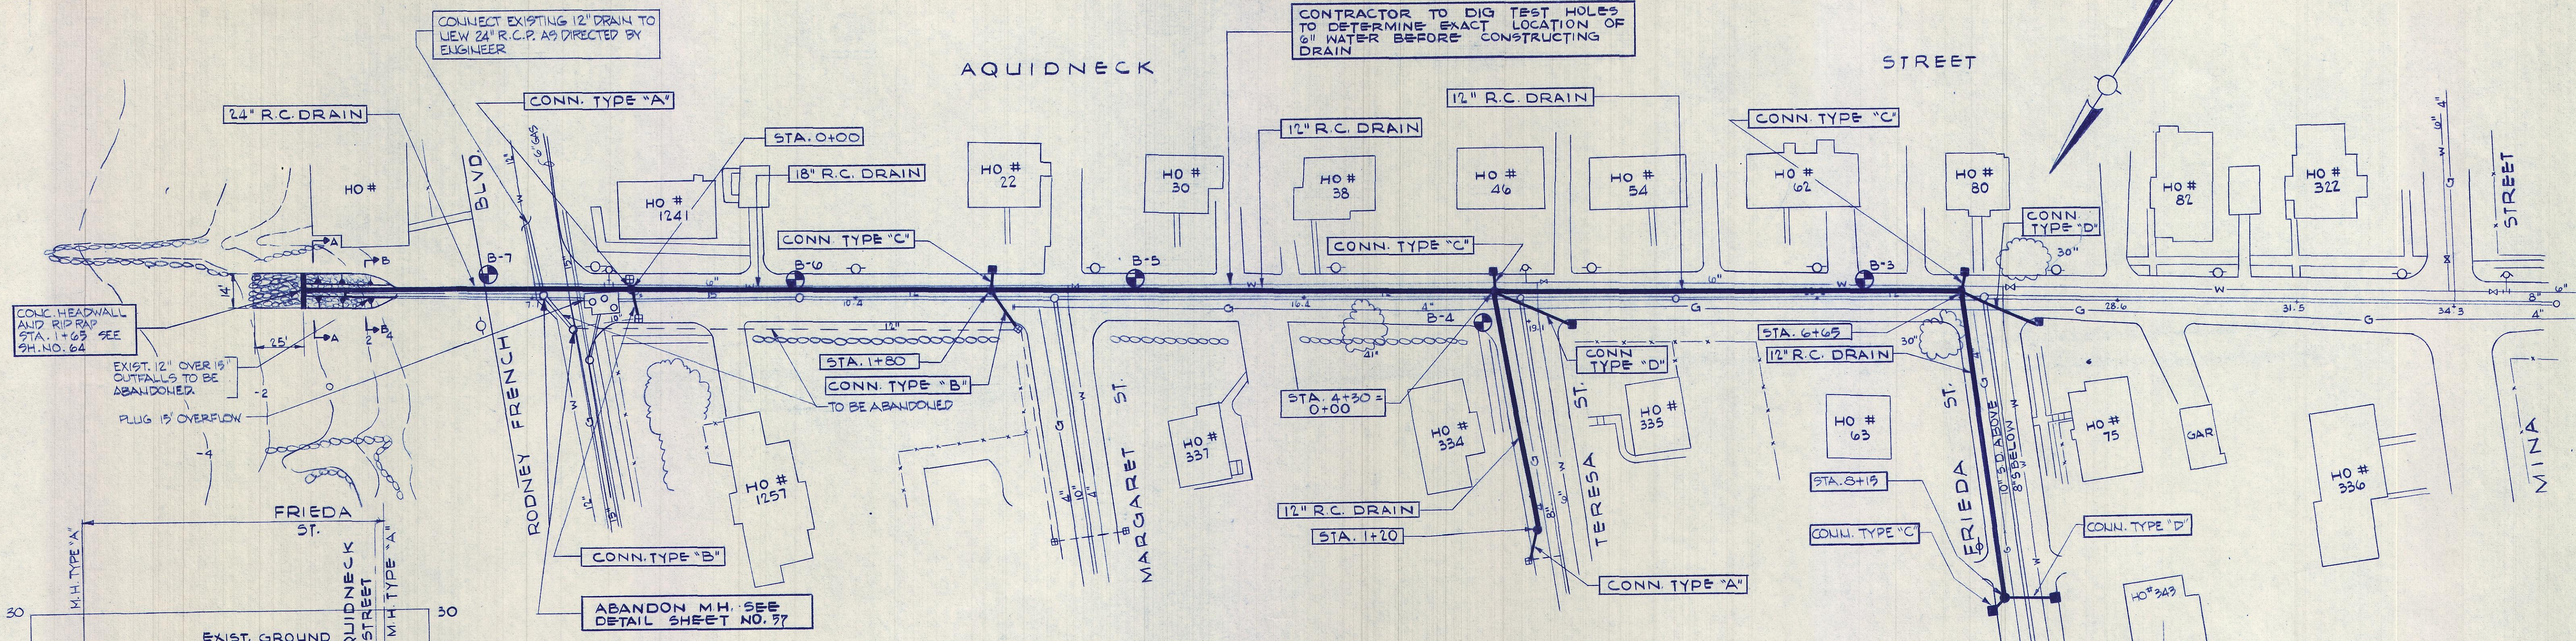



PLAN
SCALE: 1" = 40'

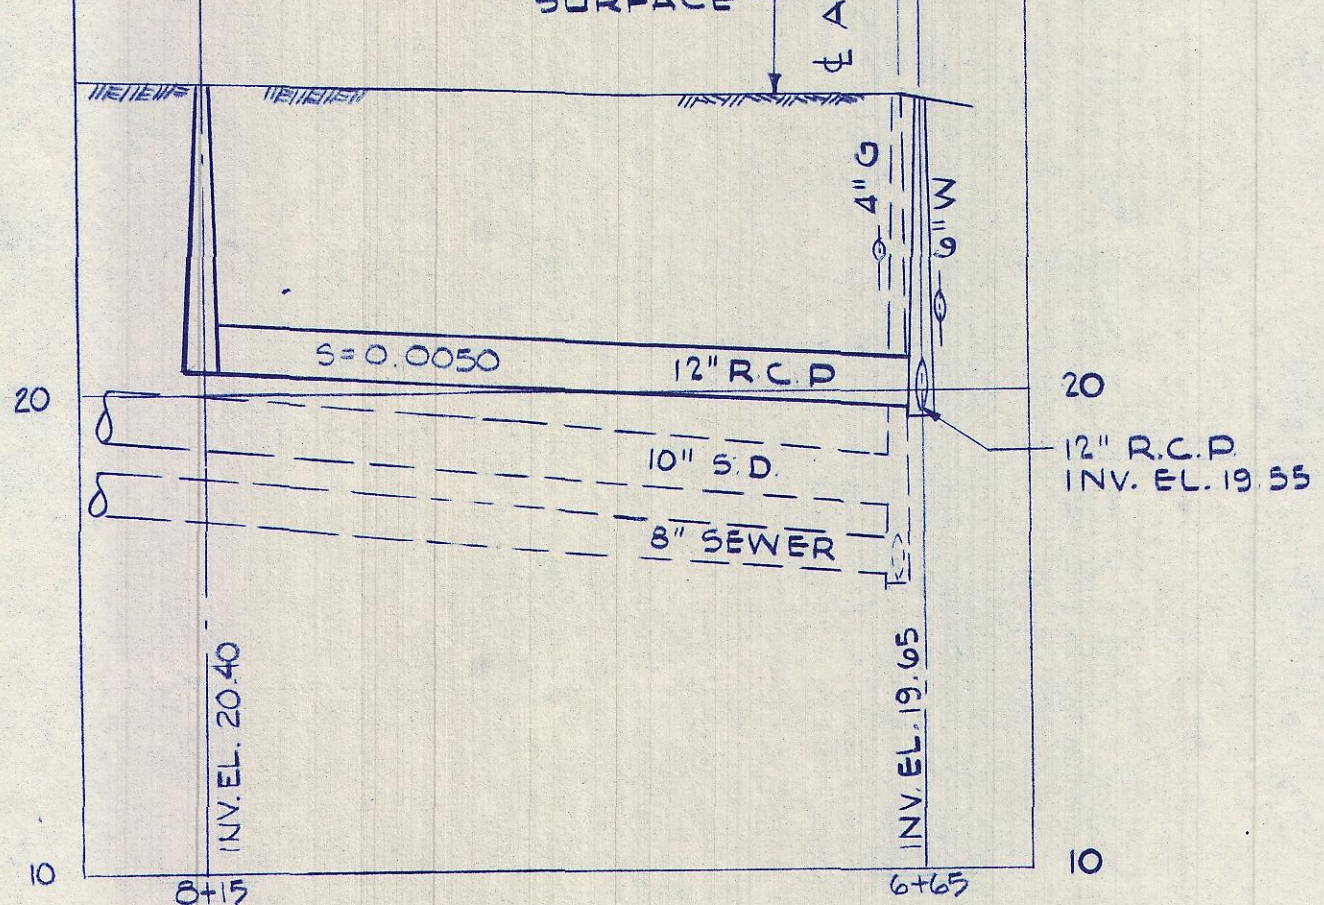


PROFILE
SCALE: HOR. 1" = 40'
VERT. 1" = 4'

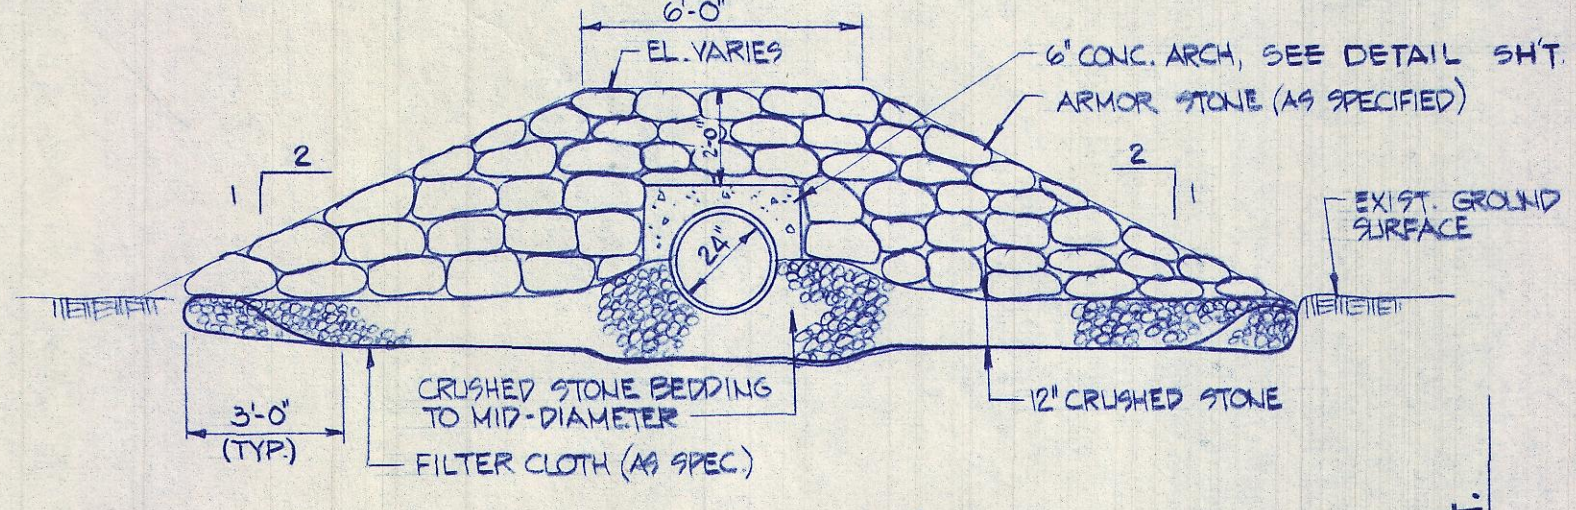

SECTION A-A
SCALE: 1/4" = 1'-0"

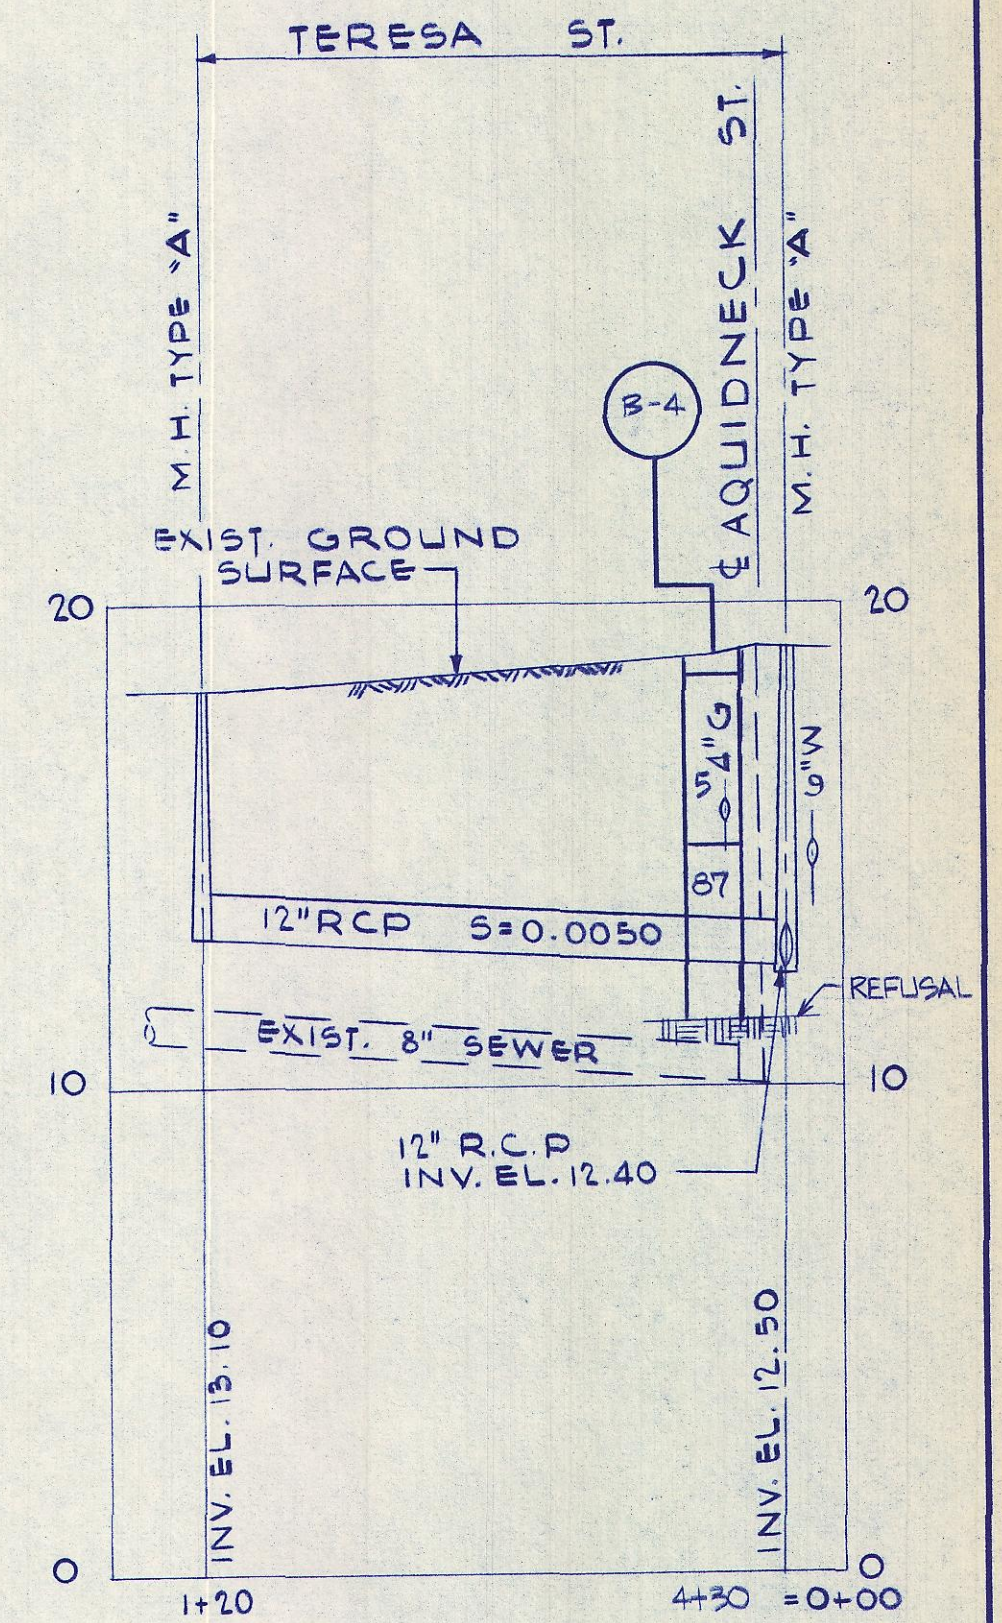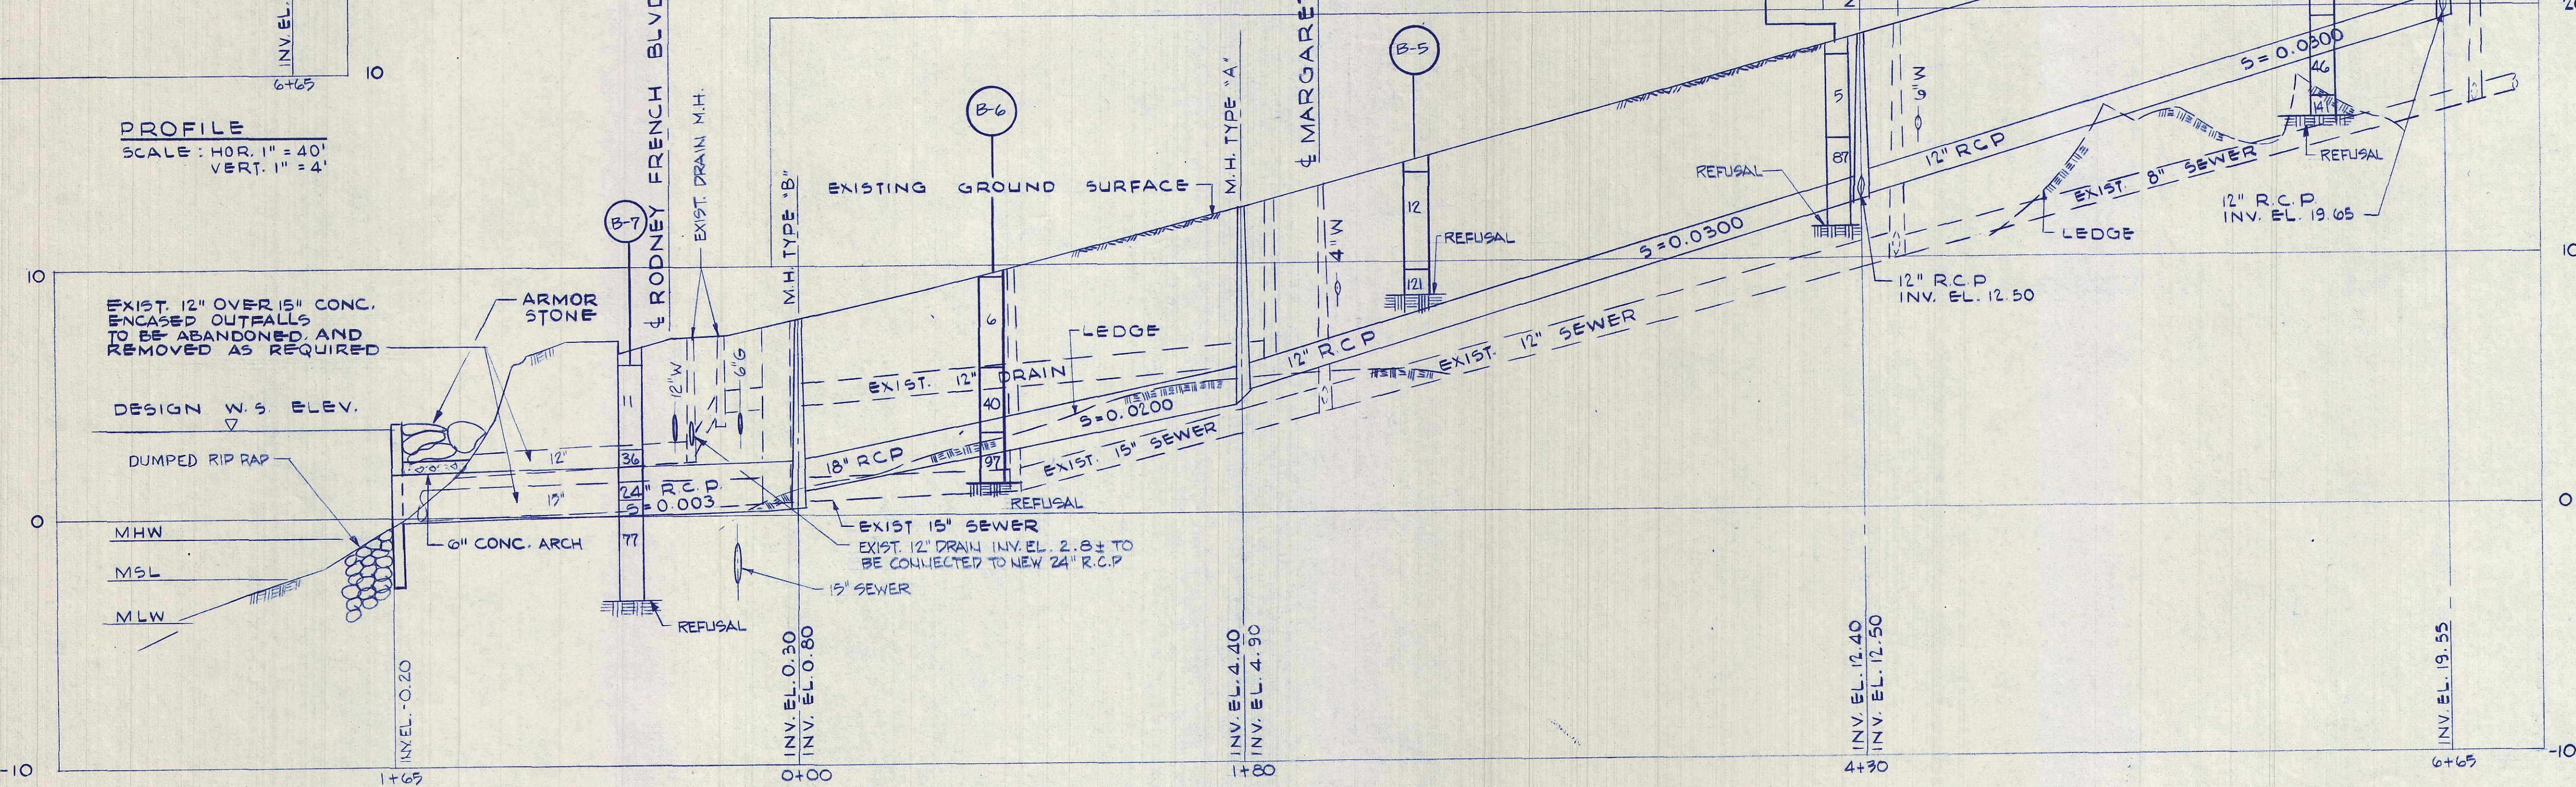

PROFILE
SCALE: HOR. 1" = 40'
VERT. 1" = 4'

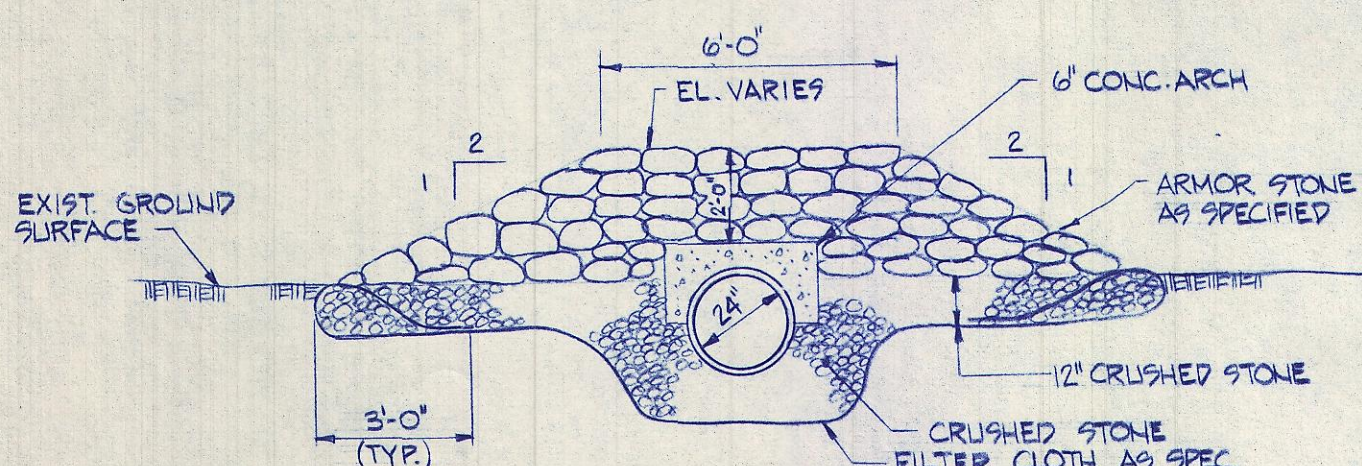

SECTION B-B
SCALE: 1/4" = 1'-0"

PROFILE
SCALE: HOR. 1" = 40'
VERT. 1" = 4'

Approved by:	Date	Name
Structural		
Electrical		
HVAC		
Project Engineer	1/4/77	J.P. Sforzini
Project Manager	1/4/77	W. R. B. Jr.



Date	Ch'k'd.	Revision
Designed by: NTC/TPS		
Drawn by: B.G.		
Checked by: W.H.R.		
Approved by: W.C.F.		
Date: SEPTEMBER 1977		
Scale: AS NOTED		

CITY OF NEW BEDFORD, MASSACHUSETTS
DEPARTMENT OF PUBLIC WORKS
DRAINAGE WORKS IMPROVEMENTS
CLARKS POINT SEPARATION-EAST SIDE

AQUIDNECK ST.

CAMP DRESSER & McKEE Inc.
Consulting Engineers
Boston, Mass.

SHEET NO. 37
309-28381