



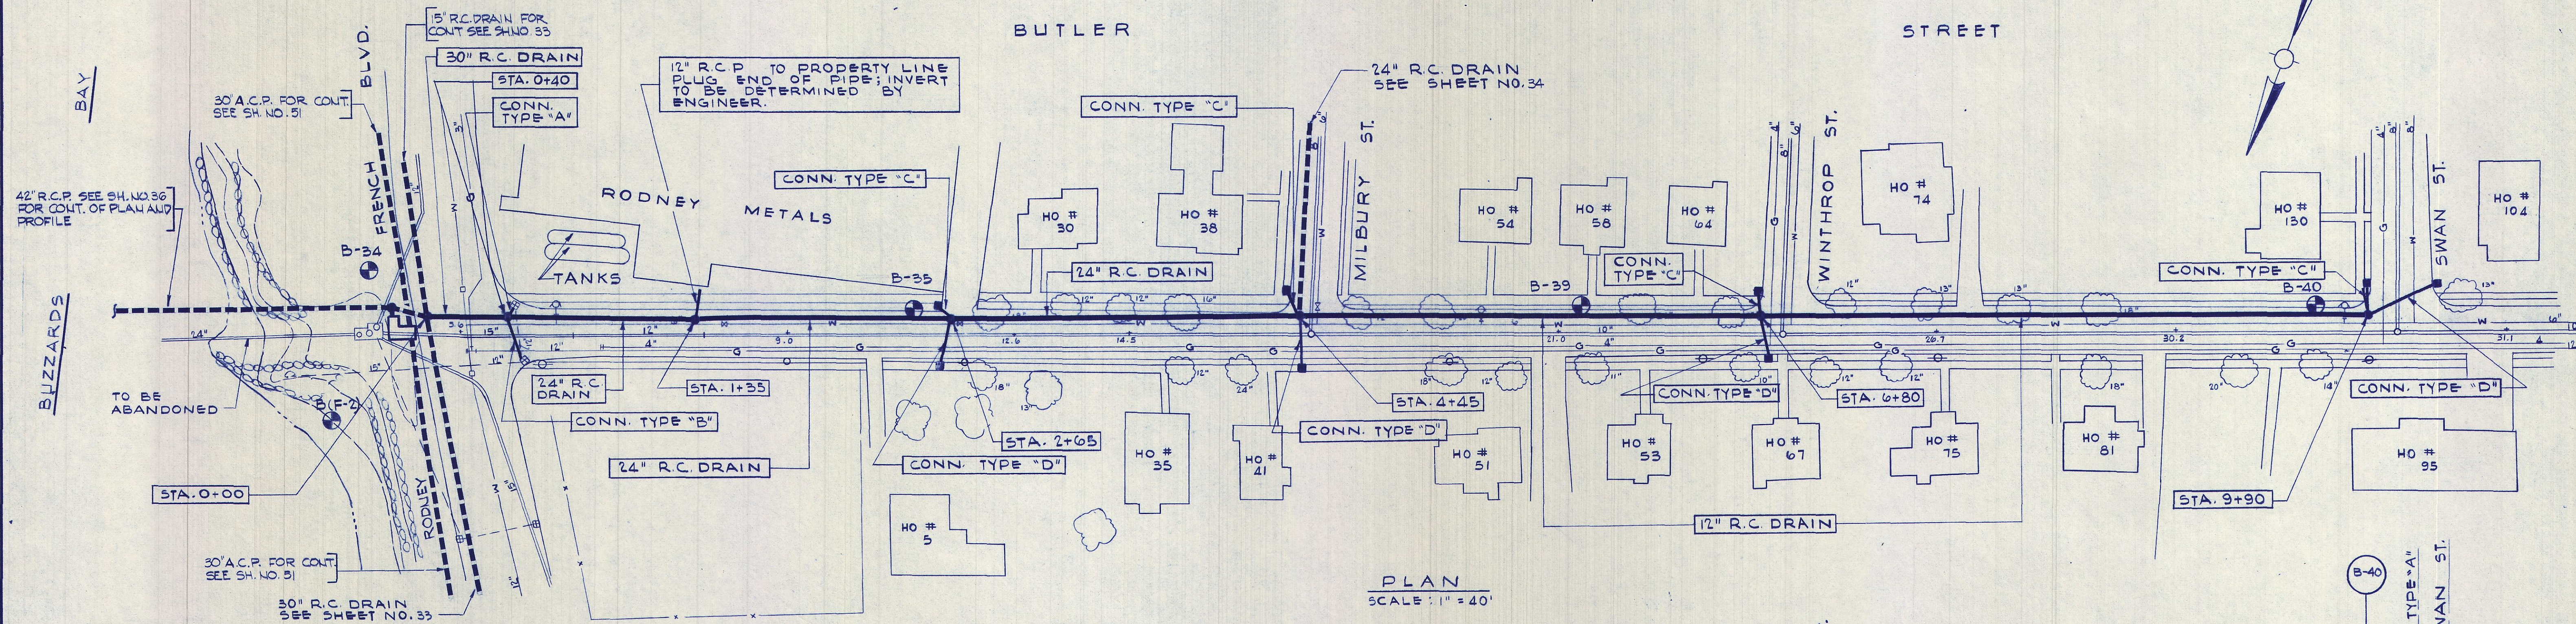


PLAN
SCALE: 1" = 40'

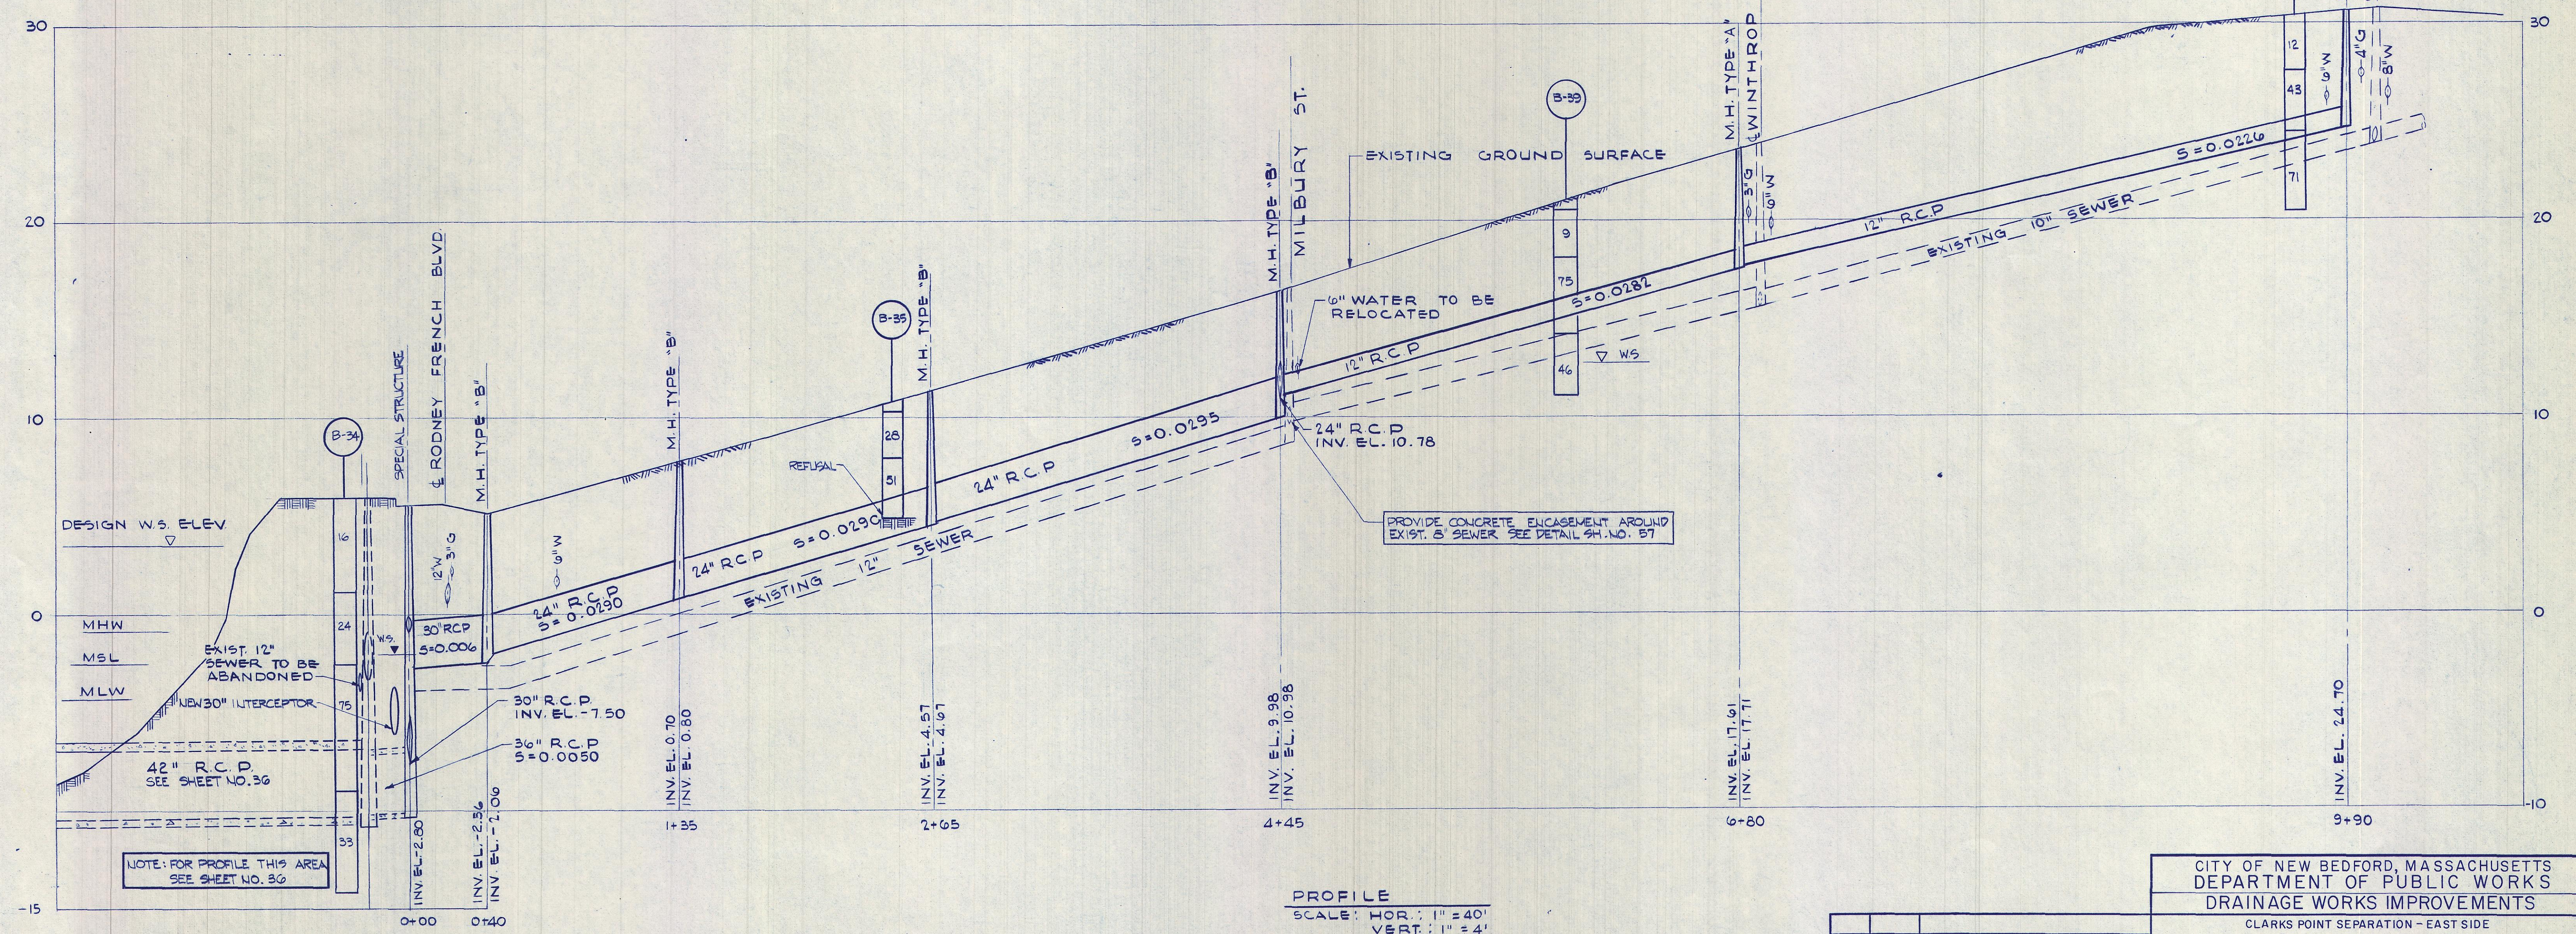

PROFILE
SCALE: HOR.: 1" = 40'
VERT.: 1" = 4'

Approved by:	Date	Name
Structural		
Electrical		
HVAC		
Project Engineer	1/4/79	J.P.S. [Signature]
Project Manager	1/4/79	W. [Signature]

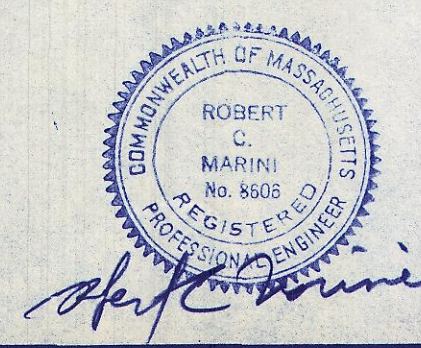

Date	Ch'kd.	Revision
Designed by:	W.T.C.	
Drawn by:	B.G.	
Checked by:	W.H.R.	
Approved by:	W.C.F.	
Date:	SEPTEMBER 1977	
Scale:	AS NOTED	

CITY OF NEW BEDFORD, MASSACHUSETTS
DEPARTMENT OF PUBLIC WORKS
DRAINAGE WORKS IMPROVEMENTS
CLARKS POINT SEPARATION - EAST SIDE

BUTLER STREET

CAMP DRESSER & McKEE Inc.
Consulting Engineers
Boston, Mass.

SHEET NO.
31
309-28375