


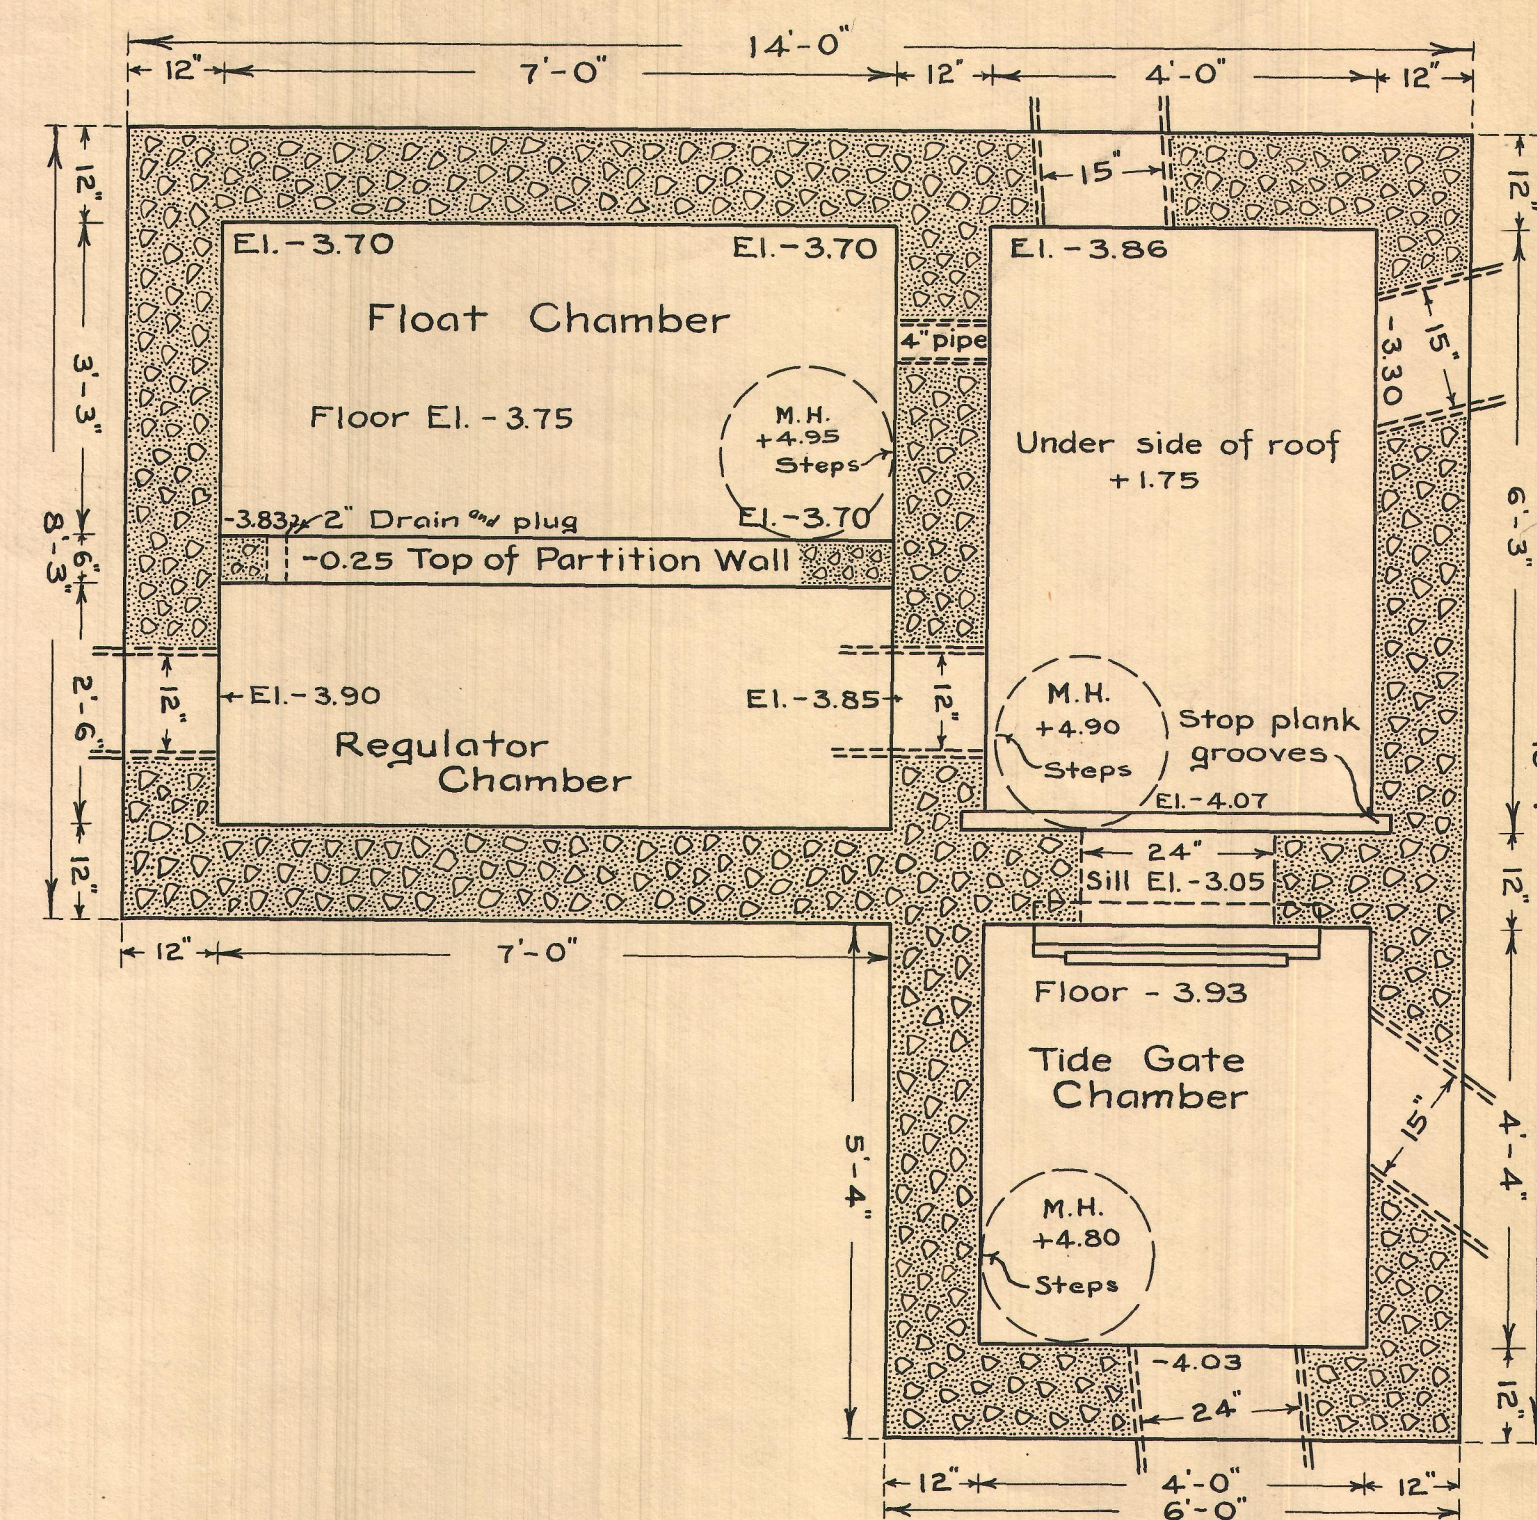

PLAN OF CHAMBER  
AT  
BUTLER ST.  
SCALE 1 IN. = 2 FT.

INTERCEPTING SEWER SYSTEM  
SEWER  
RODNEY FRENCH BOULEVARD

BUILT UNDER C.W.A.

1934

PLAN MADE 1943

Patrick J. Foley  
COMMISSIONER