

### FREDERICK STREET SEWER

E. FRENCH AVE. - NORMAN ST. TO FREDERICK ST.  
 FREDERICK ST. - E. FRENCH AVE. TO BROCK AVE.

LENGTH



- 861 feet of glazed pipe 18 inches in diameter
- 430 feet of glazed pipe 15 inches in diameter
- 8673 feet of glazed pipe 10 inches in diameter

SCALE

Horizontal, 1 inch = 60 feet Vertical, 1 inch = 6 ft.

Ordered Nov. 25, 1910  
 Construction Commenced May 5, 1911  
 Construction Completed June 6, 1911  
 Average Cut 880 feet  
 Ledge Excavated 0 Cu Yds.  
 Cost \$5383.56  
 Amount Assessed \$2691.78  
 Foreman William Smith  
 Field book 2.95 page 37

*William F. Williams*  
 CITY ENGINEER

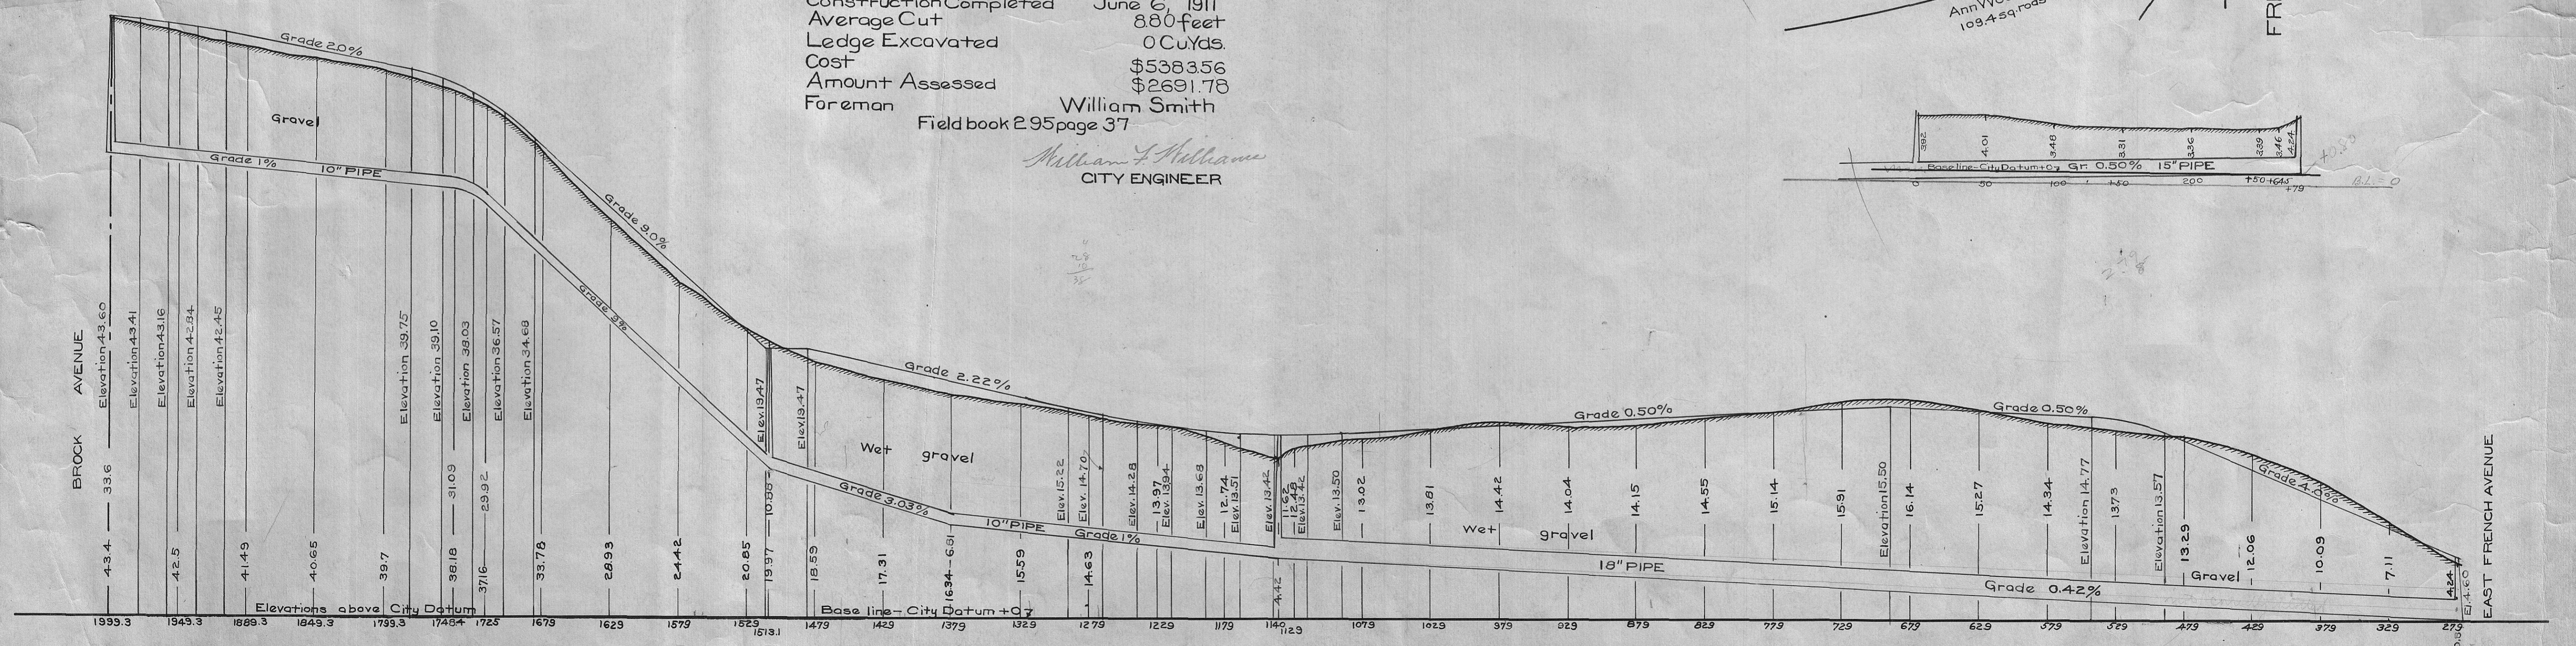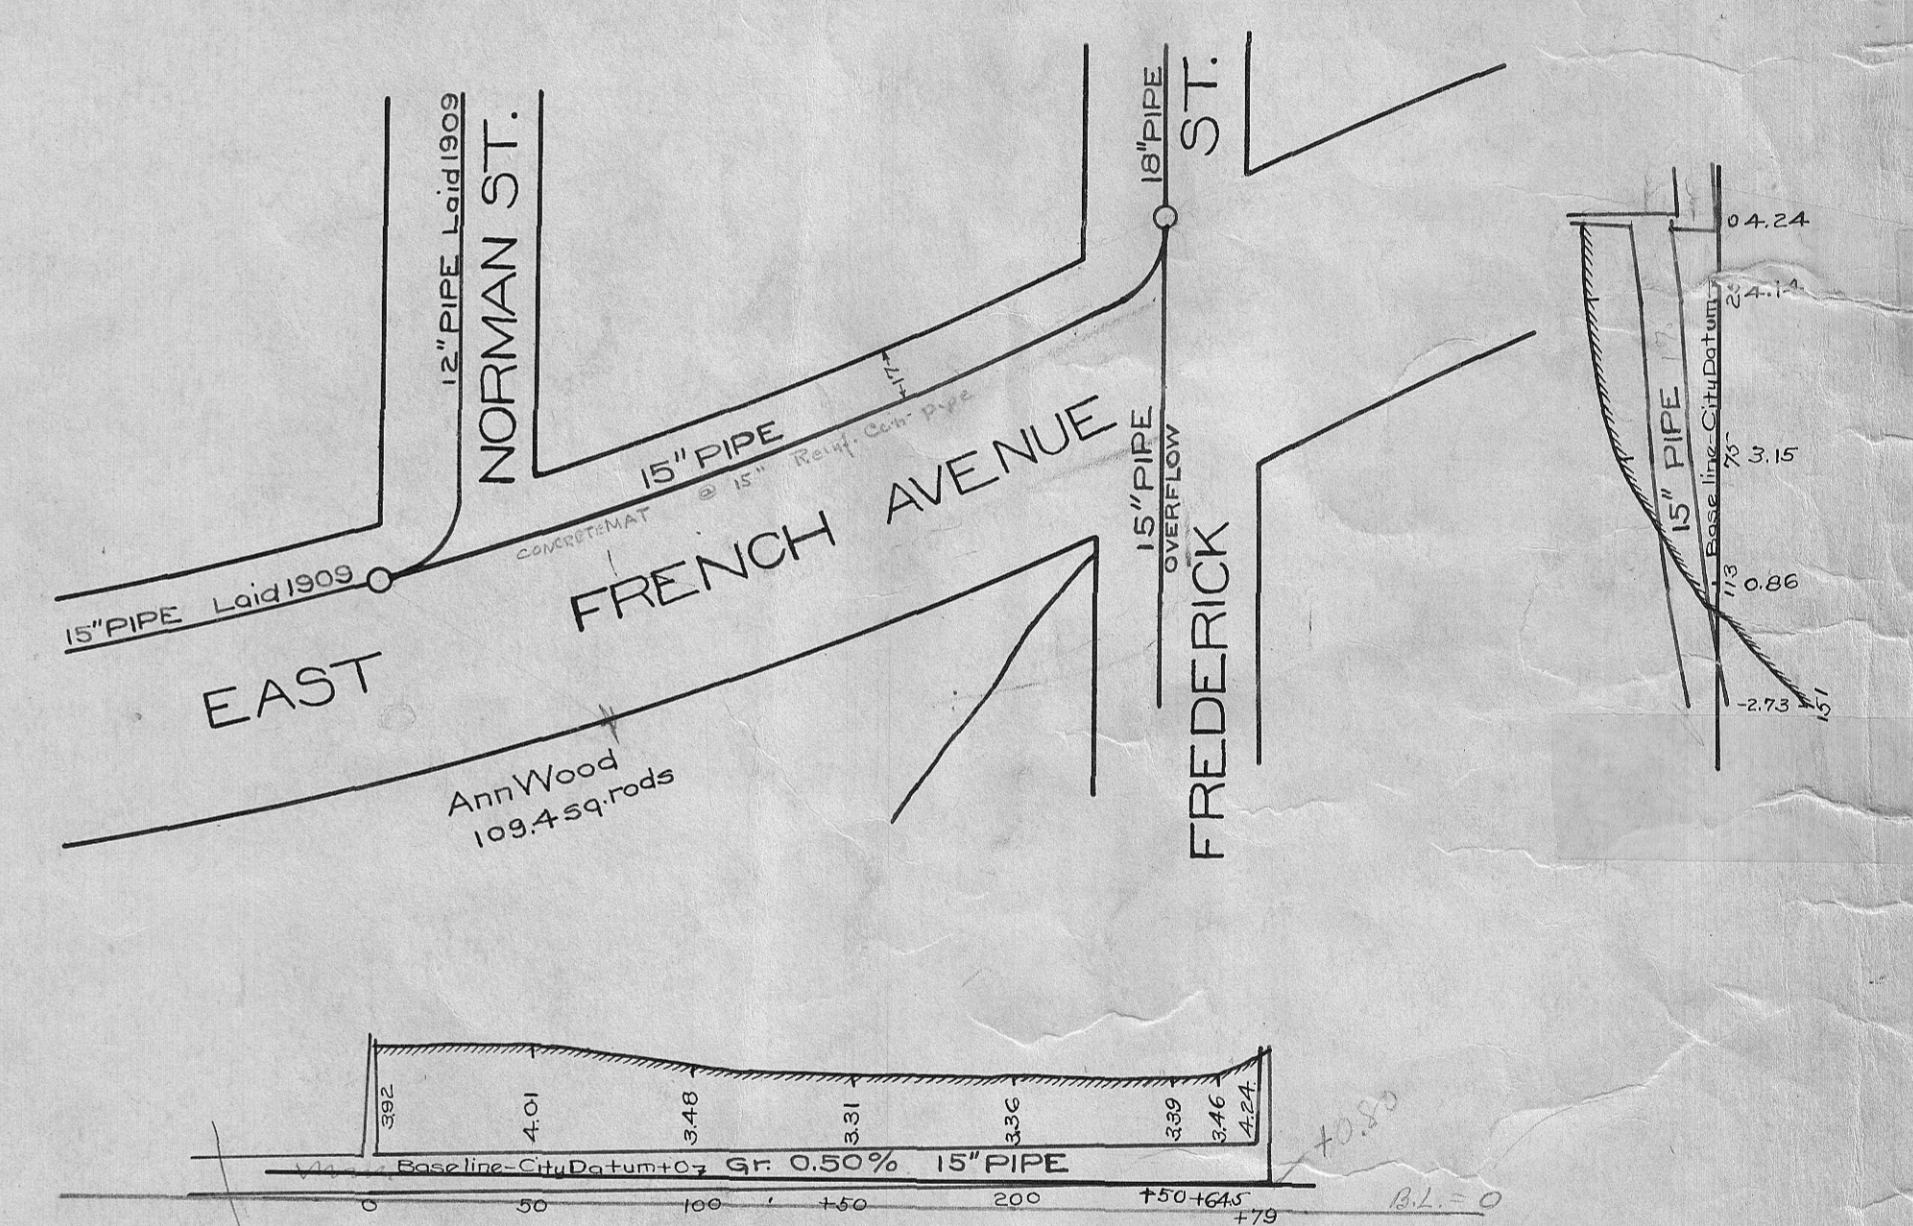

89.41  
 4.5  
 84.91

110.1  
 16  
 94.1

# 2556