

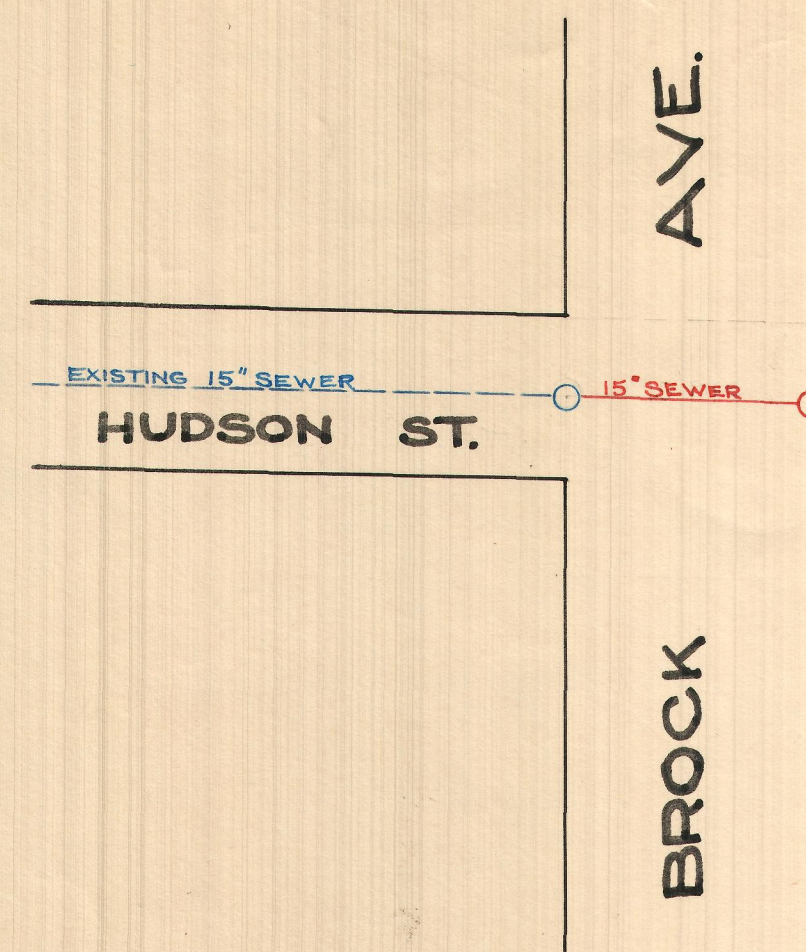


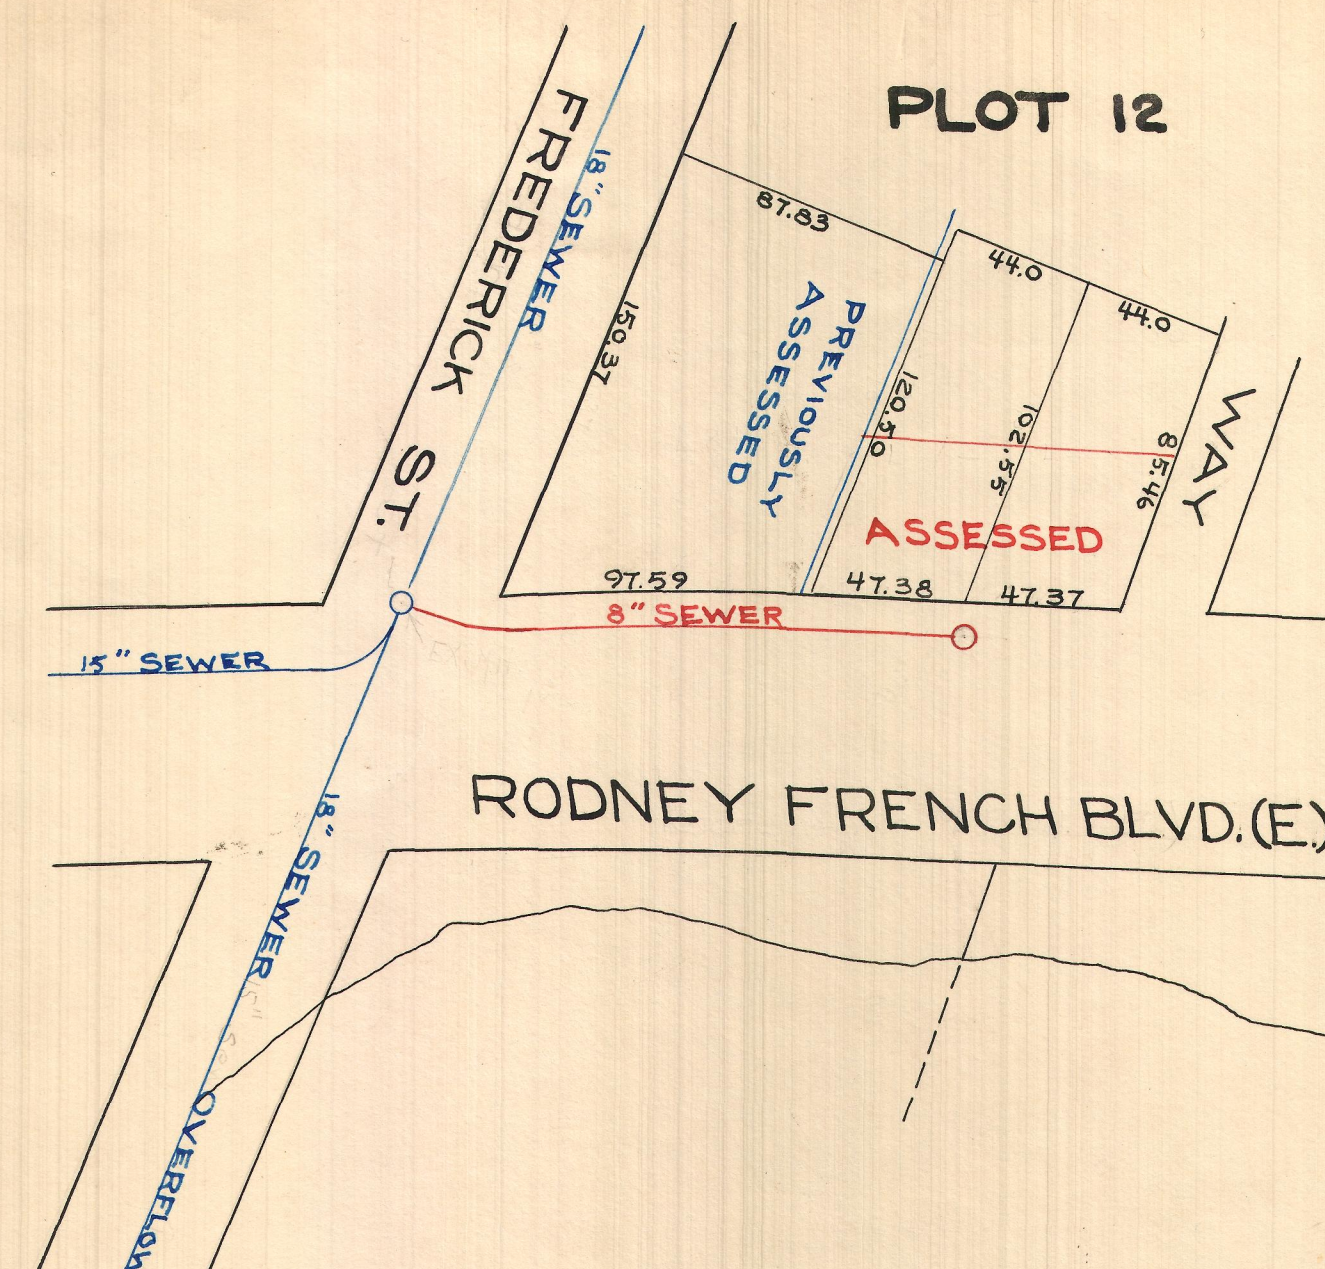

EXTENSION of HUDSON ST. SEWER
 CONSTRUCTION COMMENCED AUGUST 12, 1952
 CONSTRUCTION COMPLETED SEPTEMBER 1, 1952
 AVERAGE CUT 11.43 FEET

COMM. OF PUBLIC WORKS

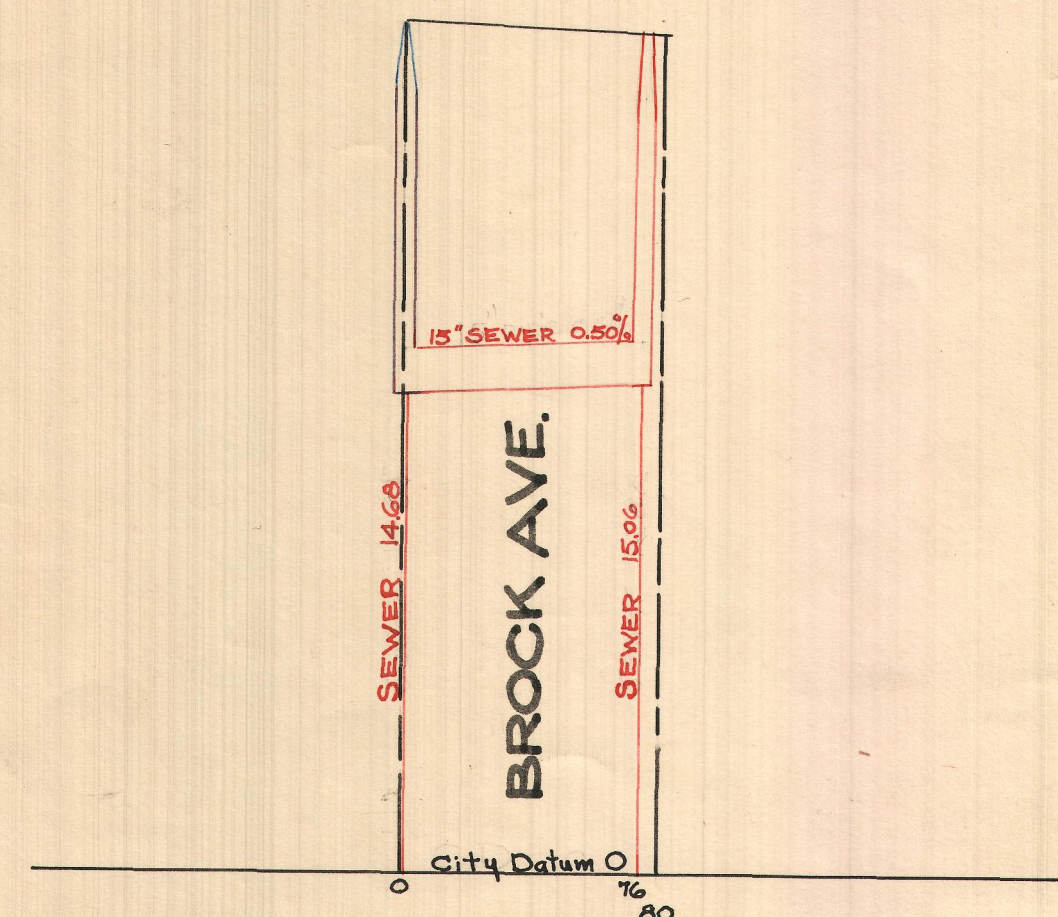

RODNEY FRENCH BLVD. EAST SEWER
 Horizontal - 1 inch = 60 feet
 Vertical - 1 inch = 6 feet
 Ordered July 7, 1952
 Construction Commenced August 8, 1952
 Construction Completed August 17, 1952
 Average Cut 2.85 Feet
 Cost \$480.56
 Amount Assessed \$200.88

COMMISSIONER OF PUBLIC WORKS

