
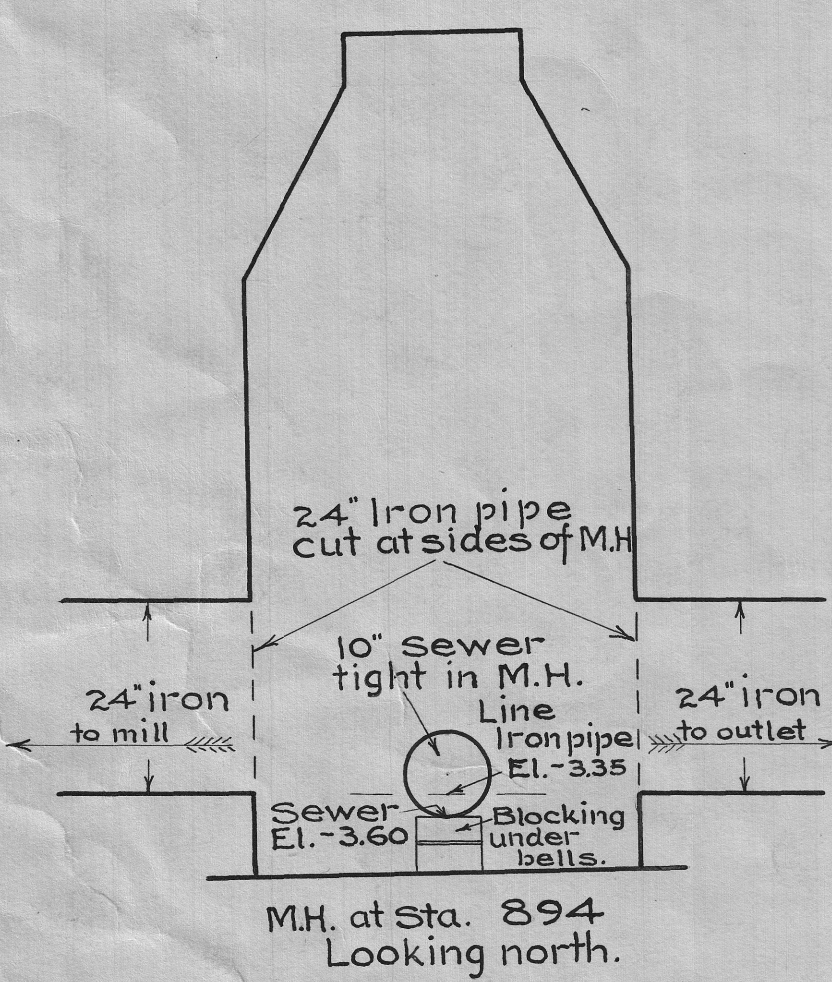


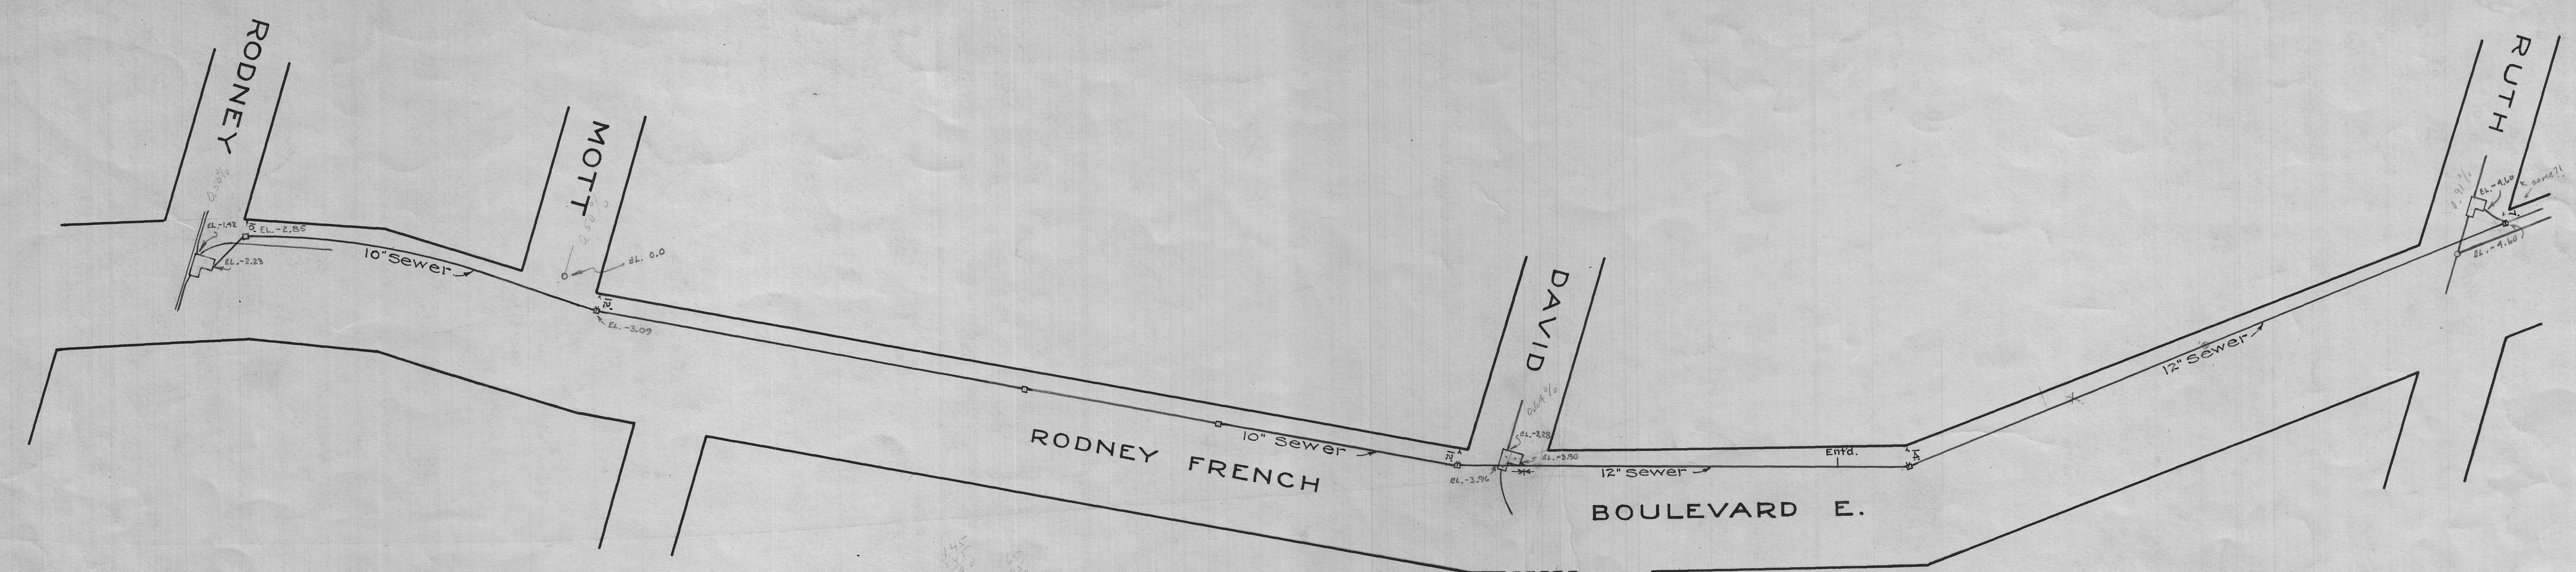

ENTRANCE FEE REQUIRED
SEWER
RODNEY FRENCH BOULEVARD E.
RUTH ST. TO RODNEY ST.

SCALE
Horizontal; 1 inch = 60 feet. Vertical; 1 inch = 6 feet.

Built by C.W.A.
Commenced Nov. 4, 1933
Completed Mar. 16, 1934
Average Cut 8.35 feet
Cost \$12,267.39

CARD

George H. Dy
CITY ENGINEER

