




BOOK 2 page 8
William F. Williams
City Engineer

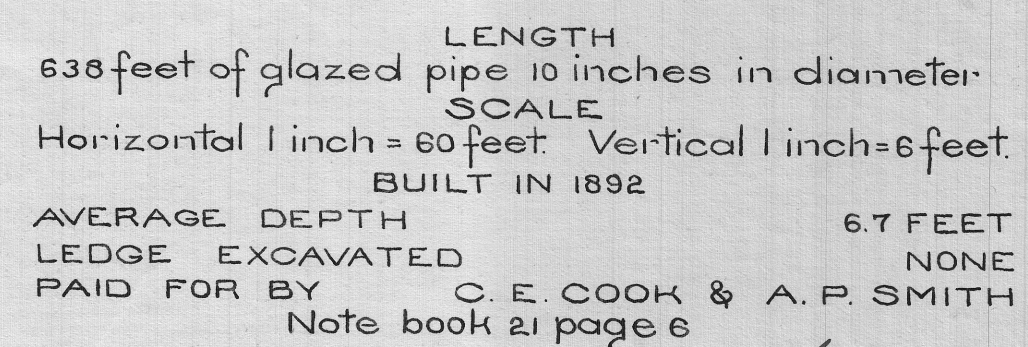