



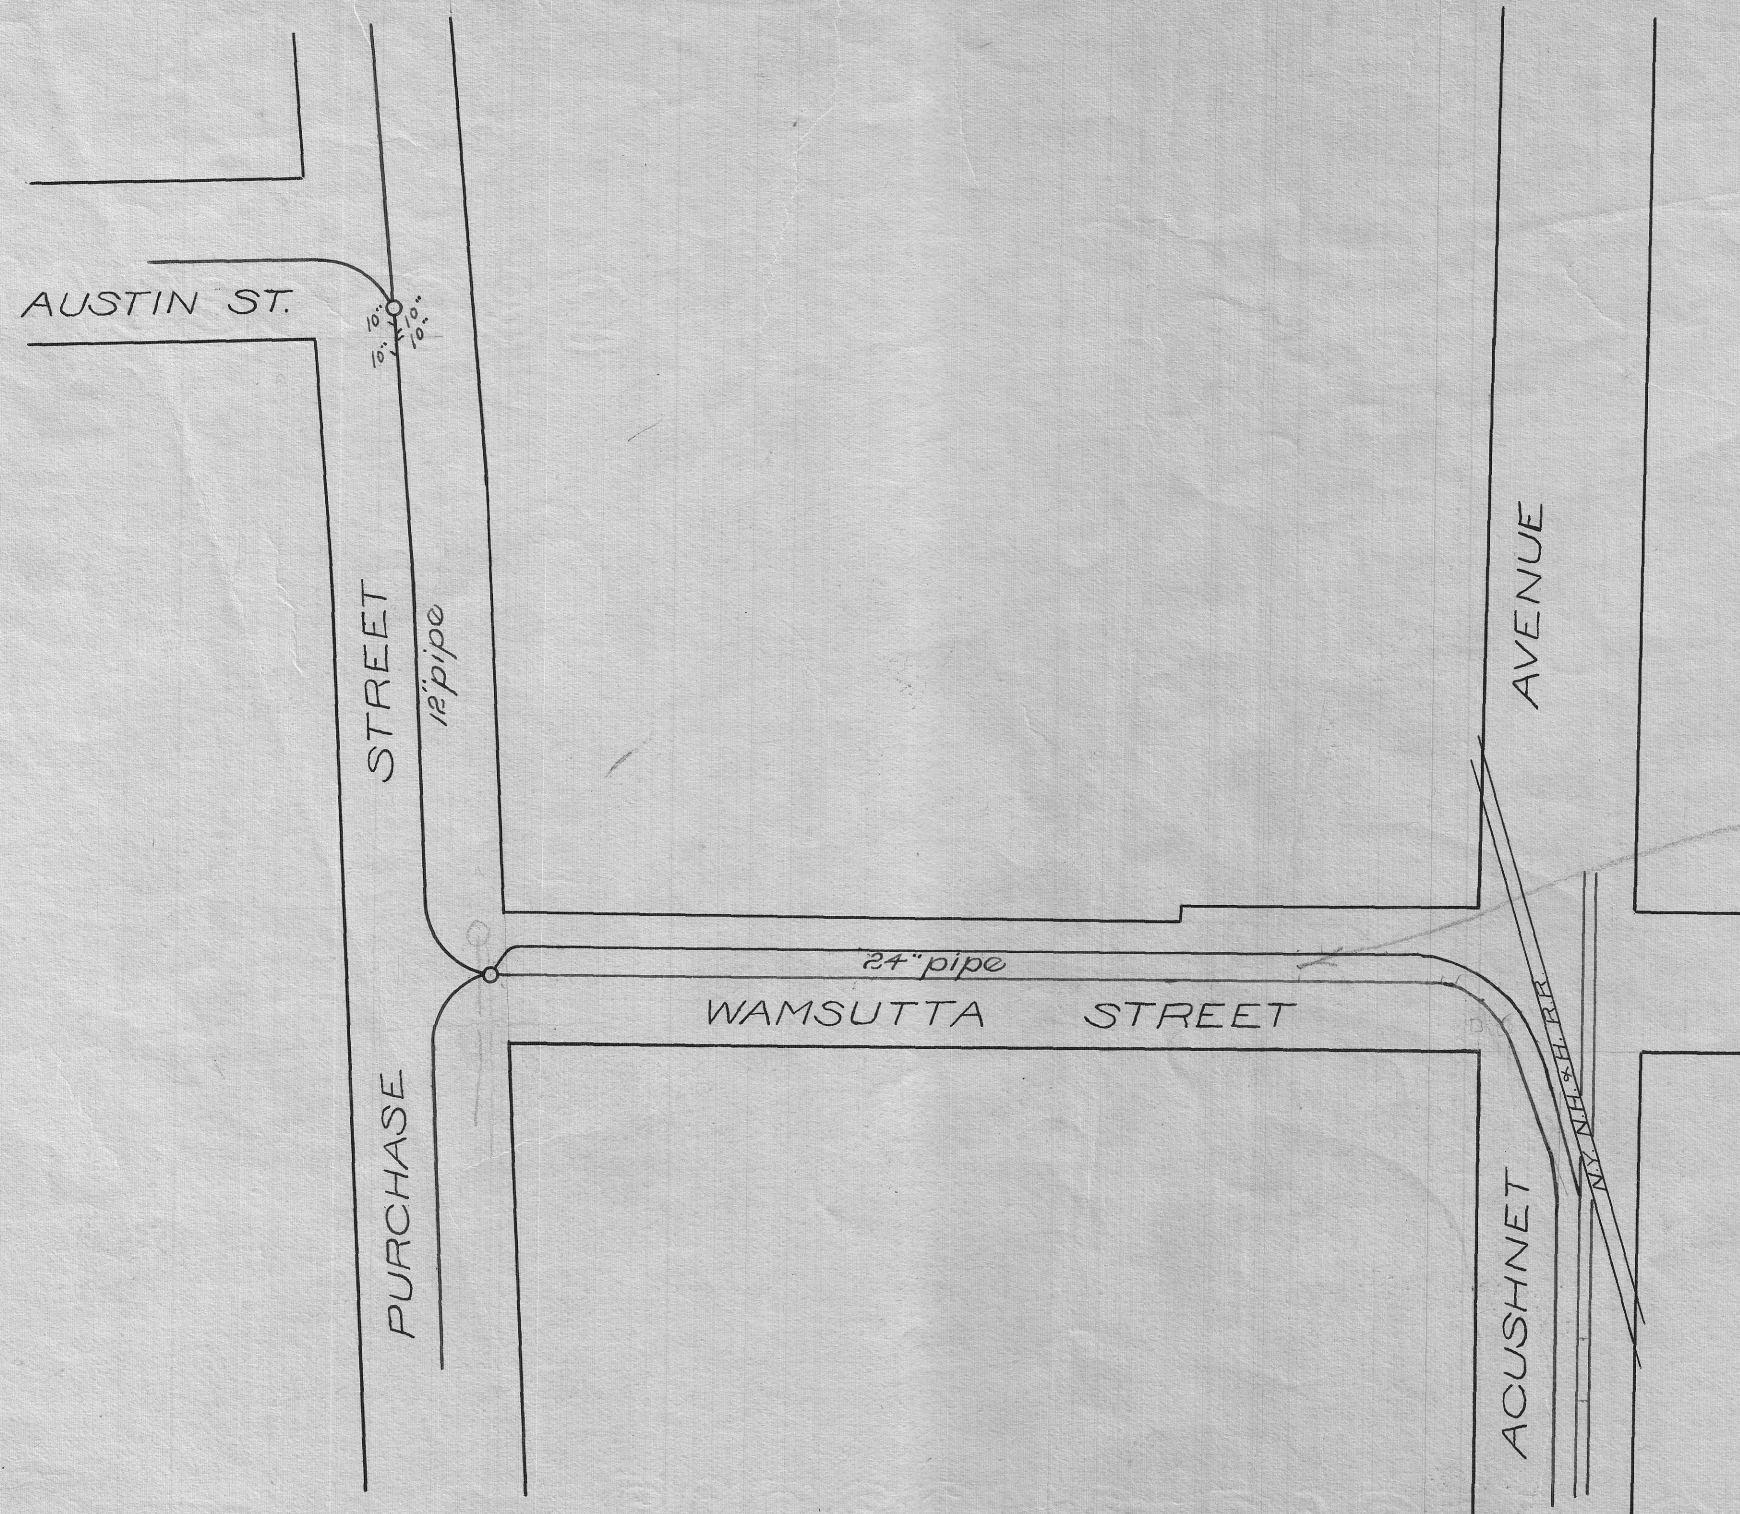

614-7
 LENGTH
 2255 feet of glazed pipe 12x24 inches in diameter
 REFERENCE
 Boundstone S.E. Cor. Purchase x Wamsutta Elev. 28.72
 SCALE
 Horizontal 1 inch = 60 feet Vertical 1 inch = 6 feet
 ORDERED AUG. 26, 1897.
 CONSTRUCTION COMMENCED OCT. 1, 1897.
 AVERAGE DEPTH 10.11 FEET
 LEDGE EXCAVATED NONE
 COST Including Merrimac St. \$74,452.21
 NOT ASSESSED
 FOREMAN JOHN GIFFORD

Note book 103 page 36.

William T. Williams
 City Engineer.

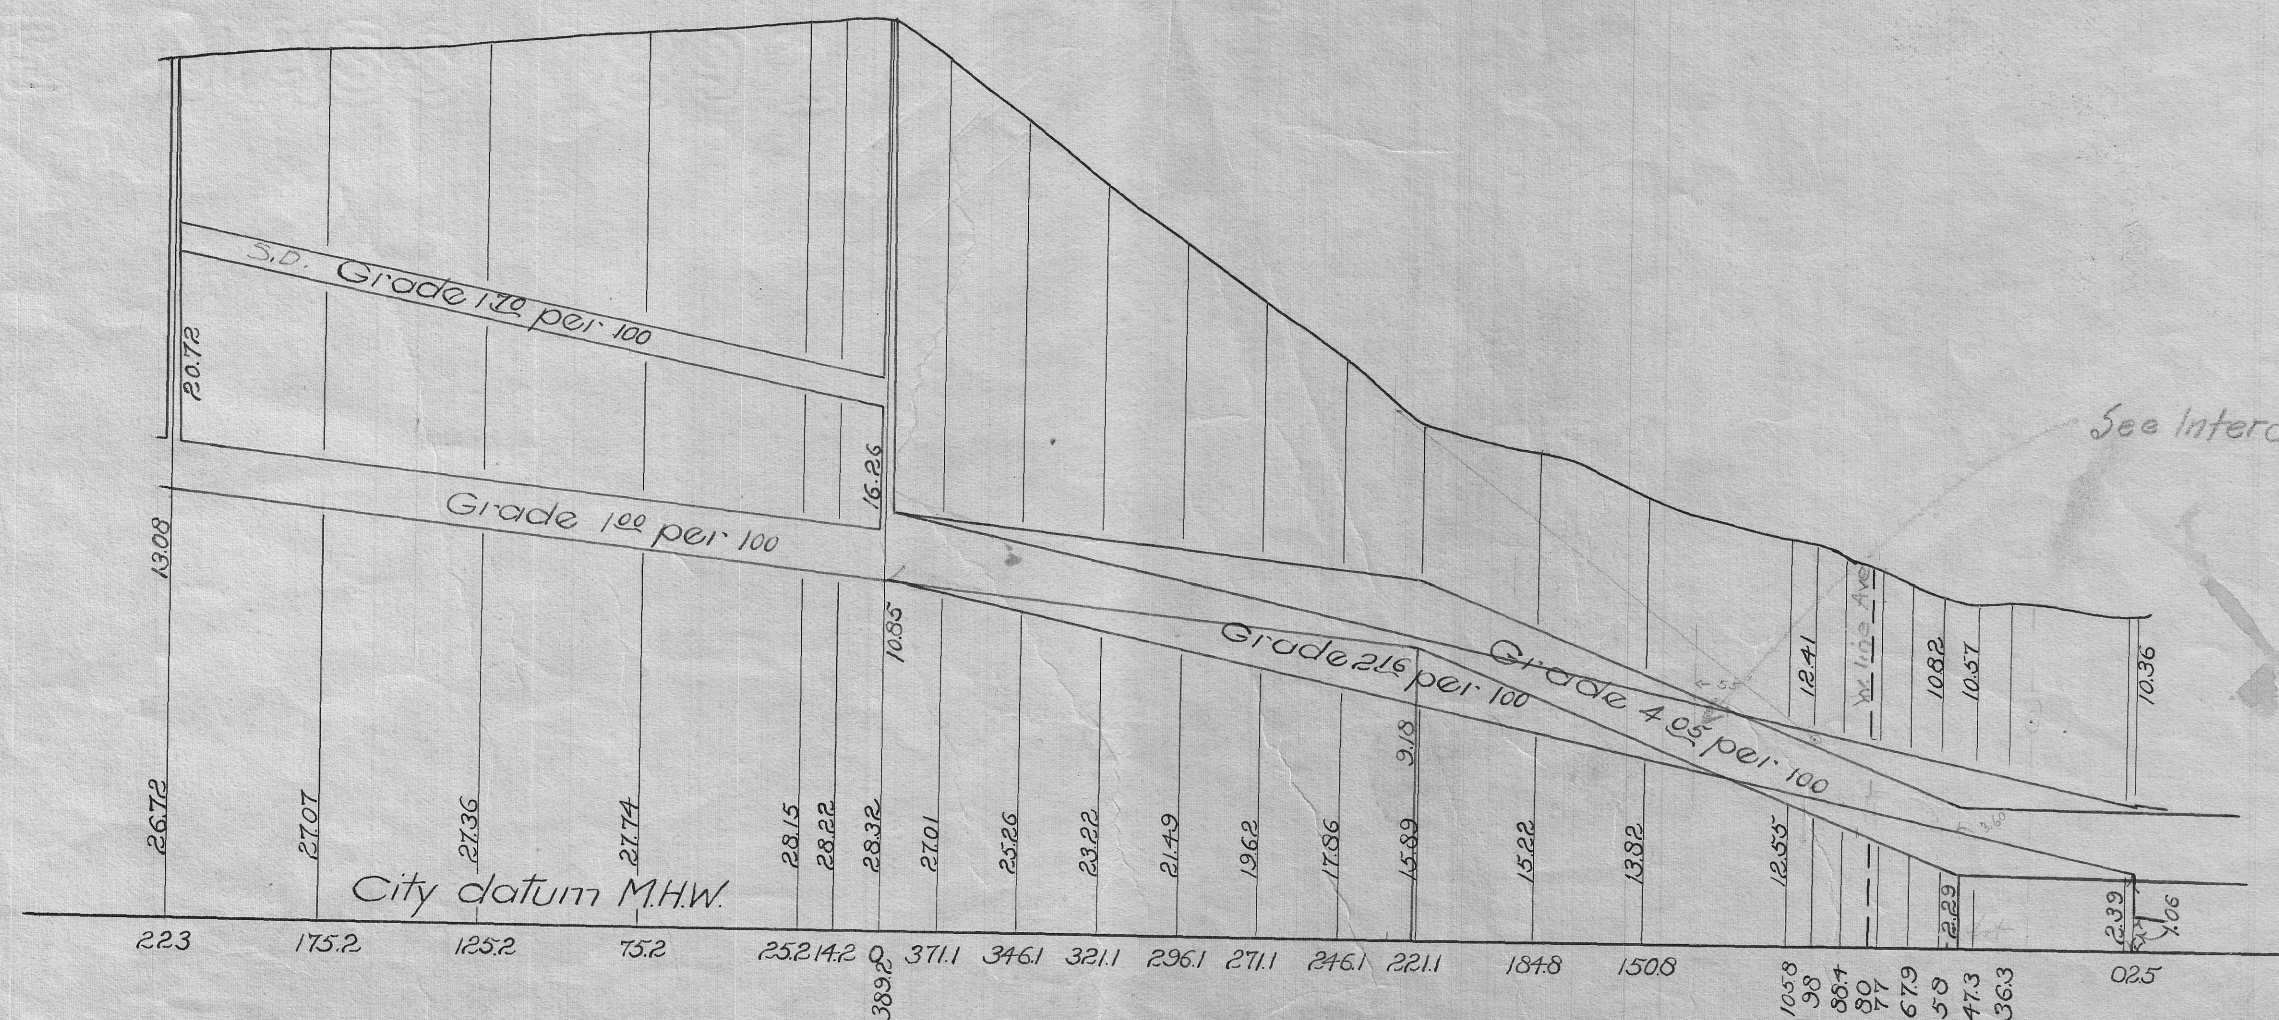

See Intercepting Sewer Plans.