
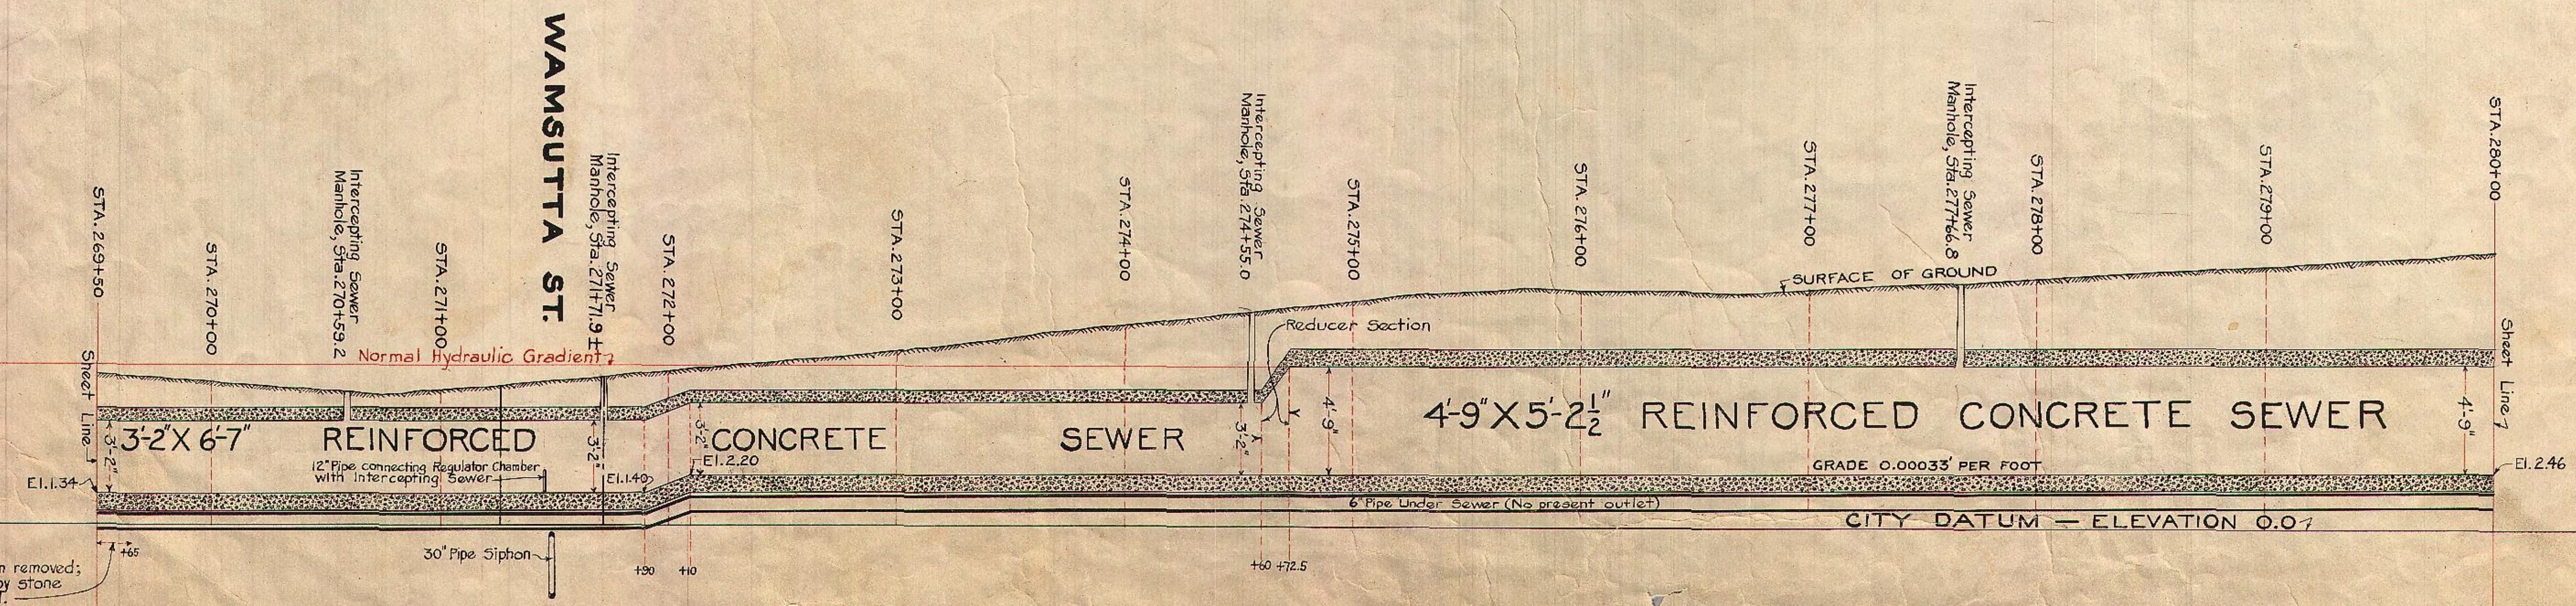
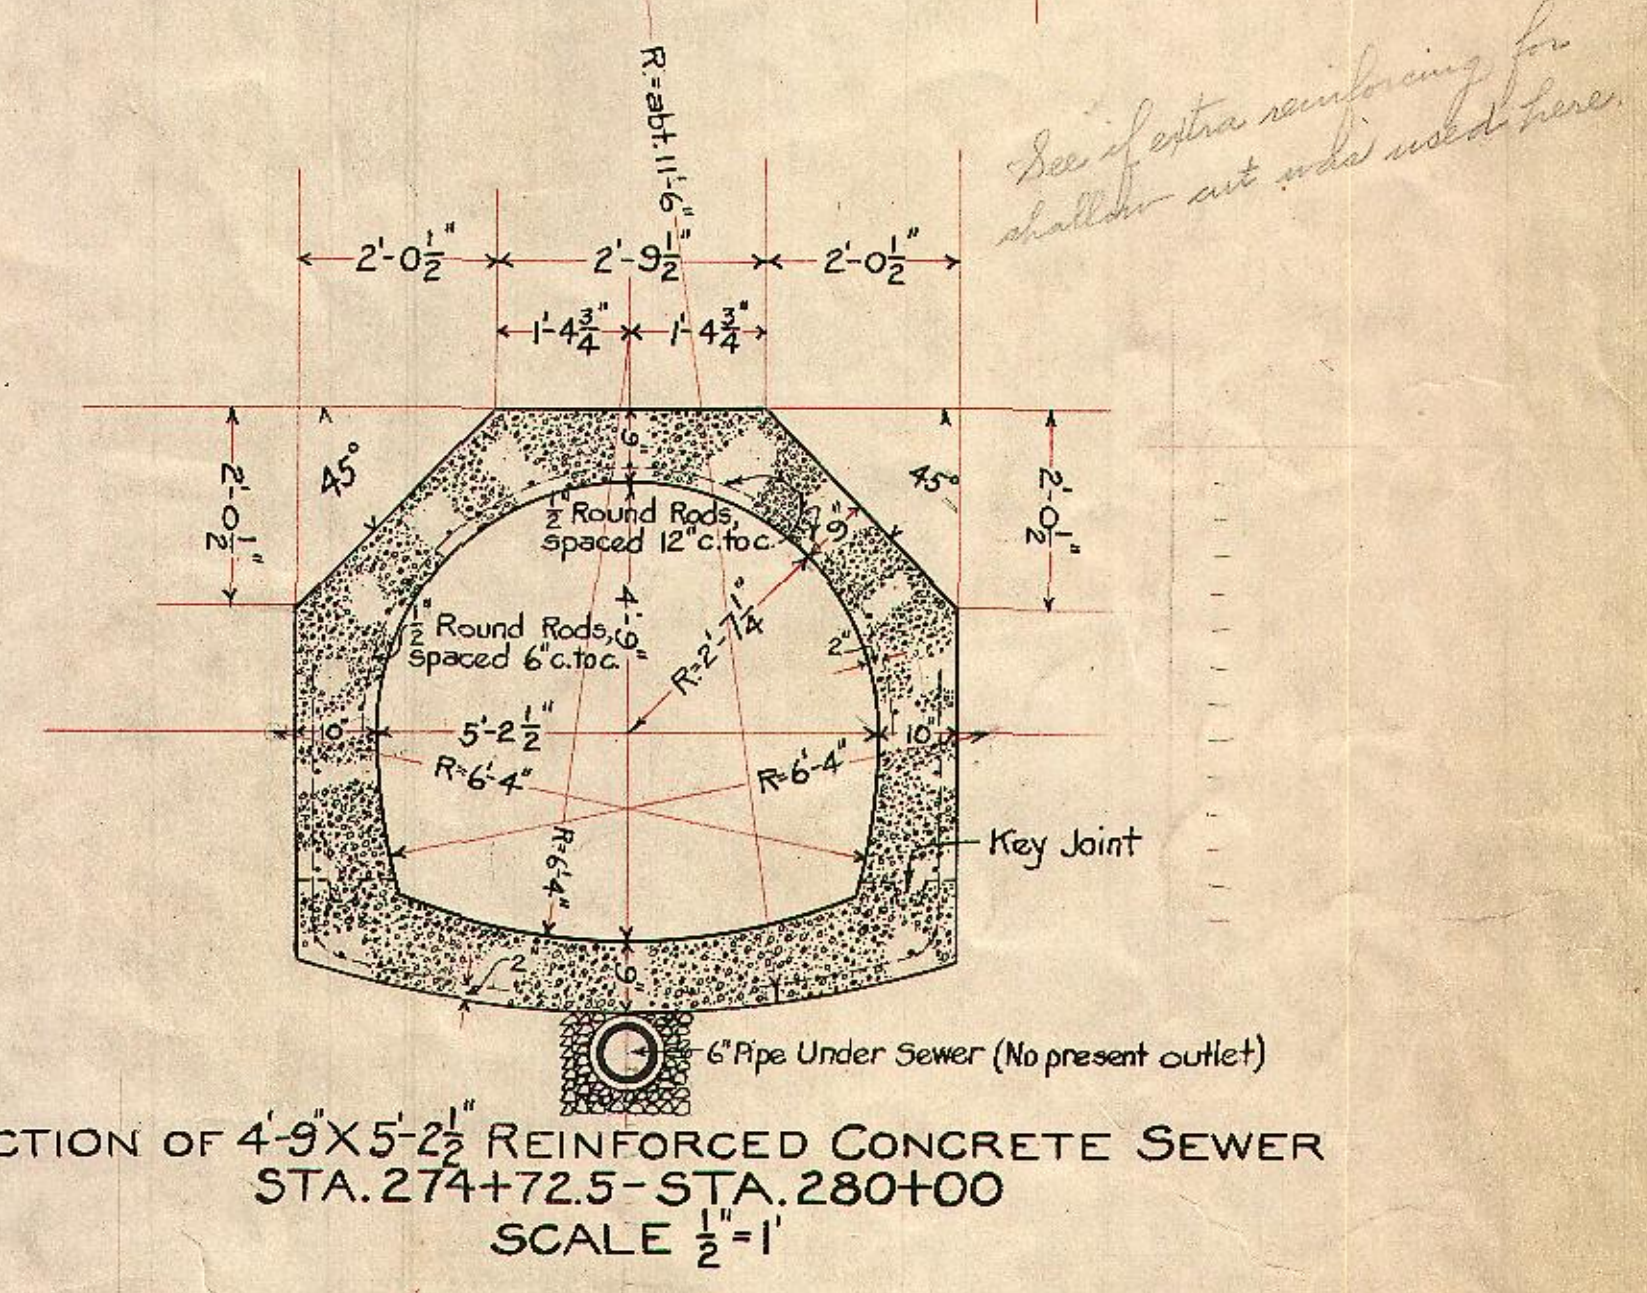


PLAN

AUTHORITY OF CHAP. 474, ACTS OF 1910. **SEWAGE DISPOSAL NEW BEDFORD MASS. INTERCEPTING SEWER STA. 269+50-STA. 280+00**

SCALE: PLAN 1"=40'
 PROFILE 1"=4' (Hor. 1"=40', Ver. 1"=4')

SEPT. 1920.
 NOTE: STA. 143+66.65 LINE BACK-
 STA. 143+74.86 LINE AHEAD.

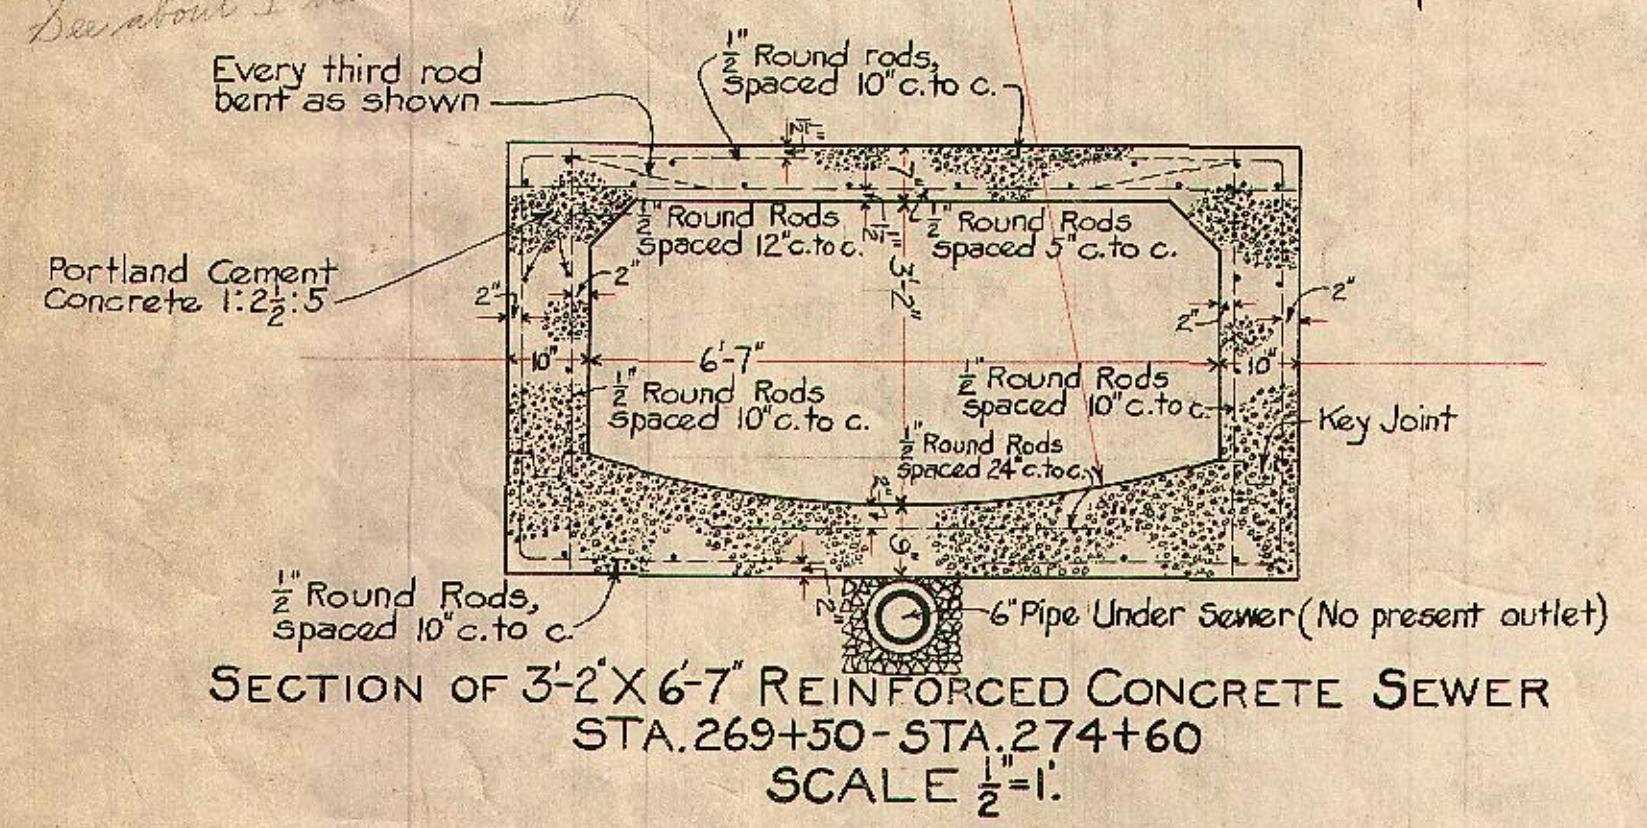

PROFILE