
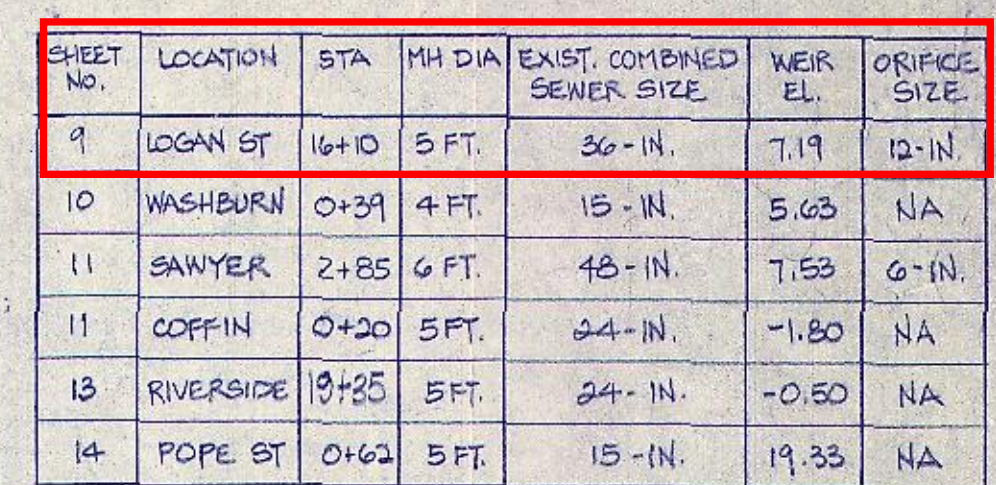
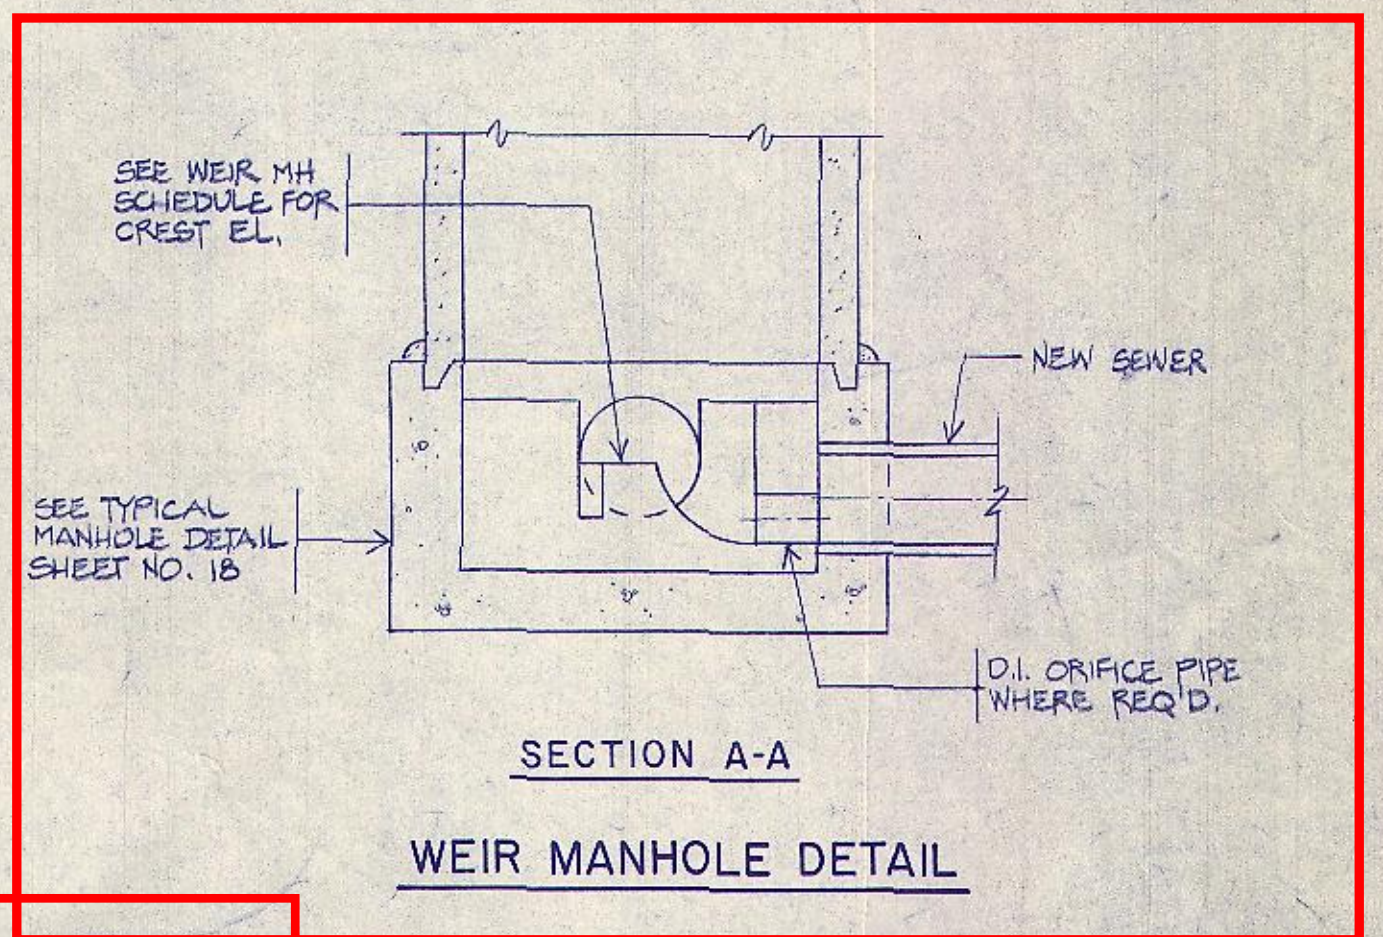
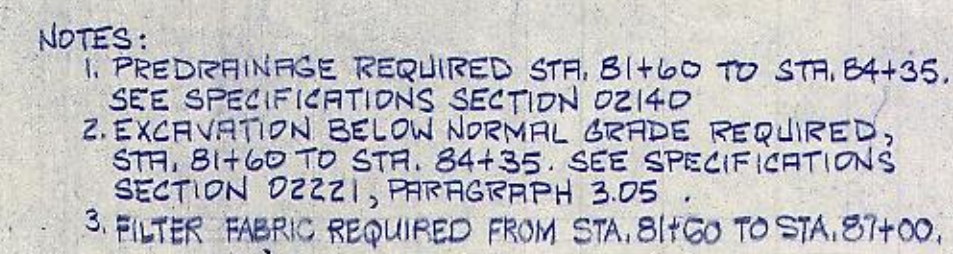


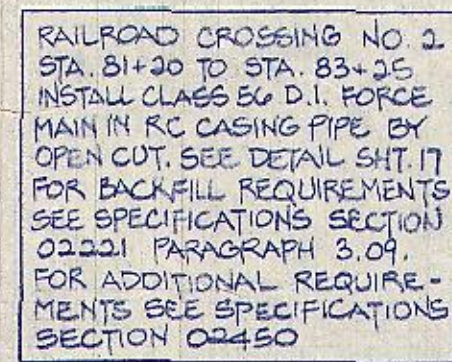

CITY OF NEW BEDFORD, MASSACHUSETTS	
BELLEVILLE AVENUE FORCE MAIN EXTENSION	
CONTRACT NO. 5	
RAILROAD YARD AND ACUSHNET AVENUE	
CAMP DRESSER & McKEE INC. Ten Cambridge Center Cambridge, Massachusetts 02142	CDM environmental engineers, scientists planners, & management consultants
	SHEET NO. 8 309-47807