
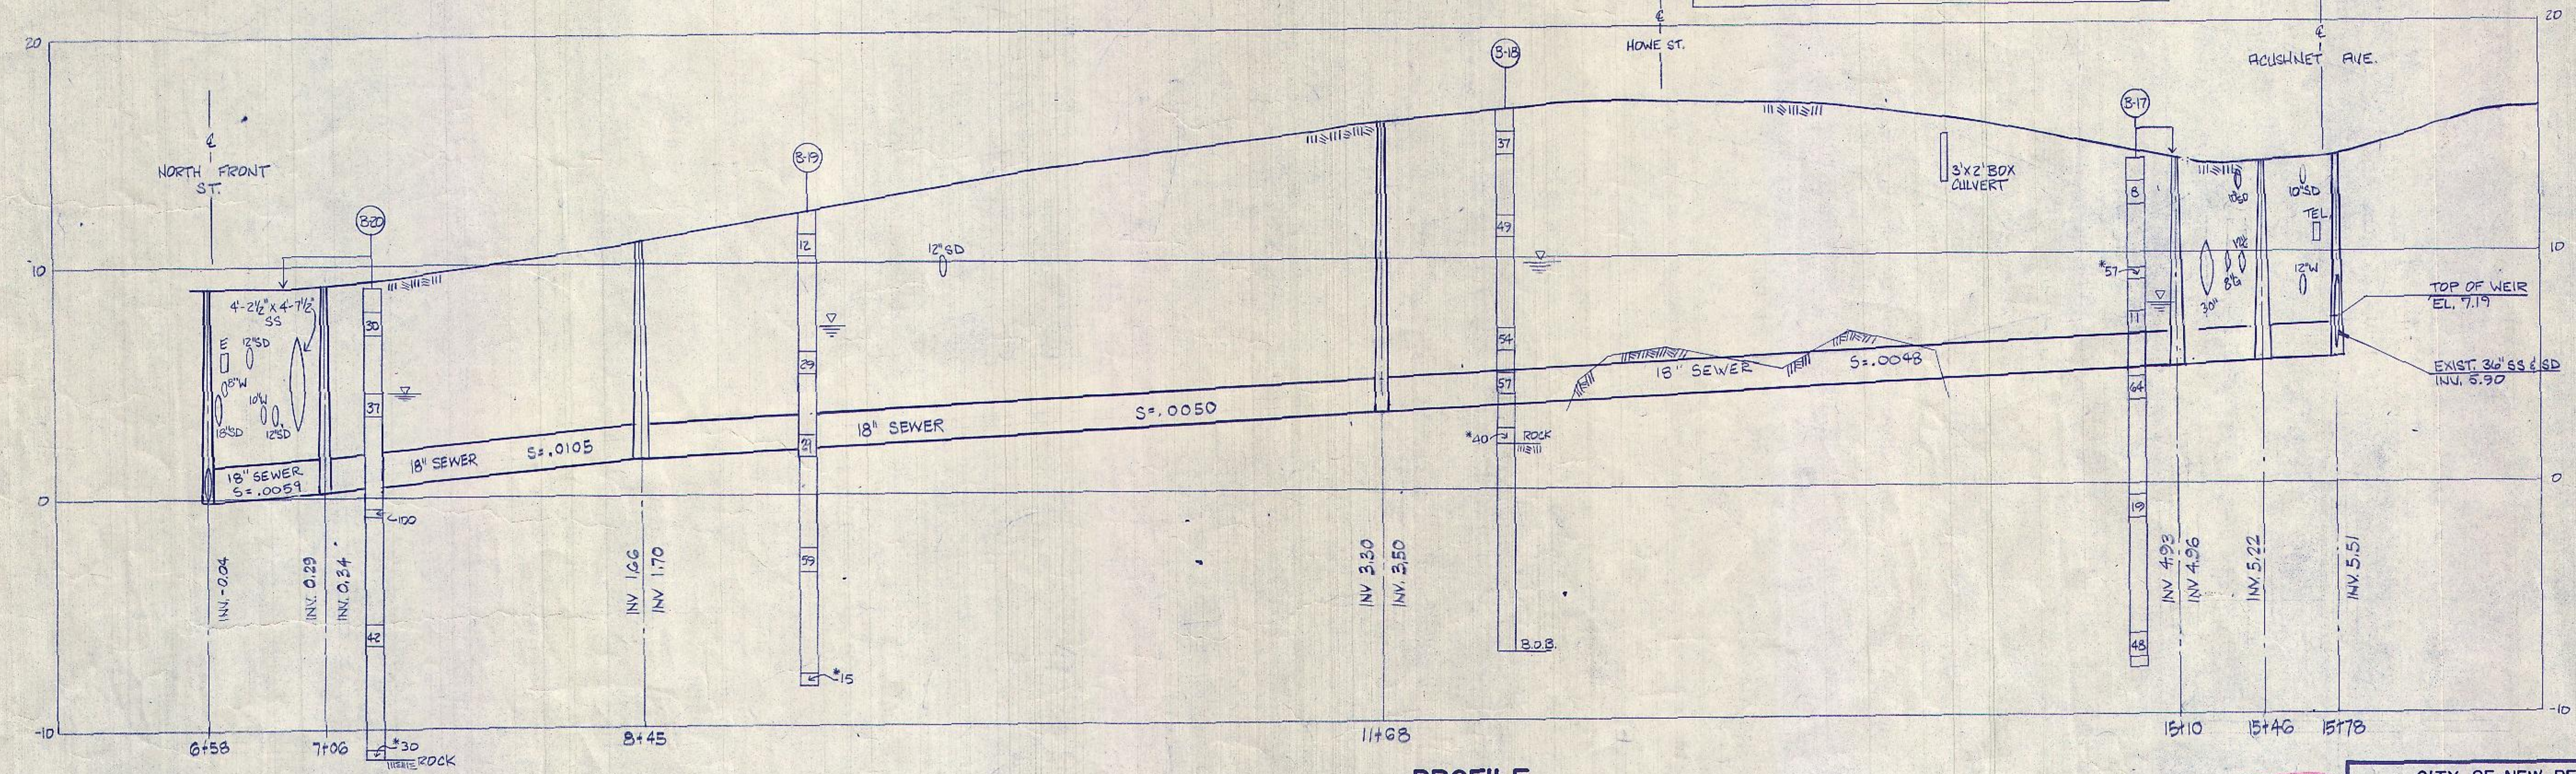


PROJECT MANAGER	Approved by:	Date:
PROJECT ENGINEER	Approved by:	Date:
PLUMBING	Approved by:	Date:
HVAC	Approved by:	Date:
INSTRUMENTATION	Approved by:	Date:
ELECTRICAL	Approved by:	Date:
STRUCTURAL	Approved by:	Date:
ARCHITECTURAL	Approved by:	Date:

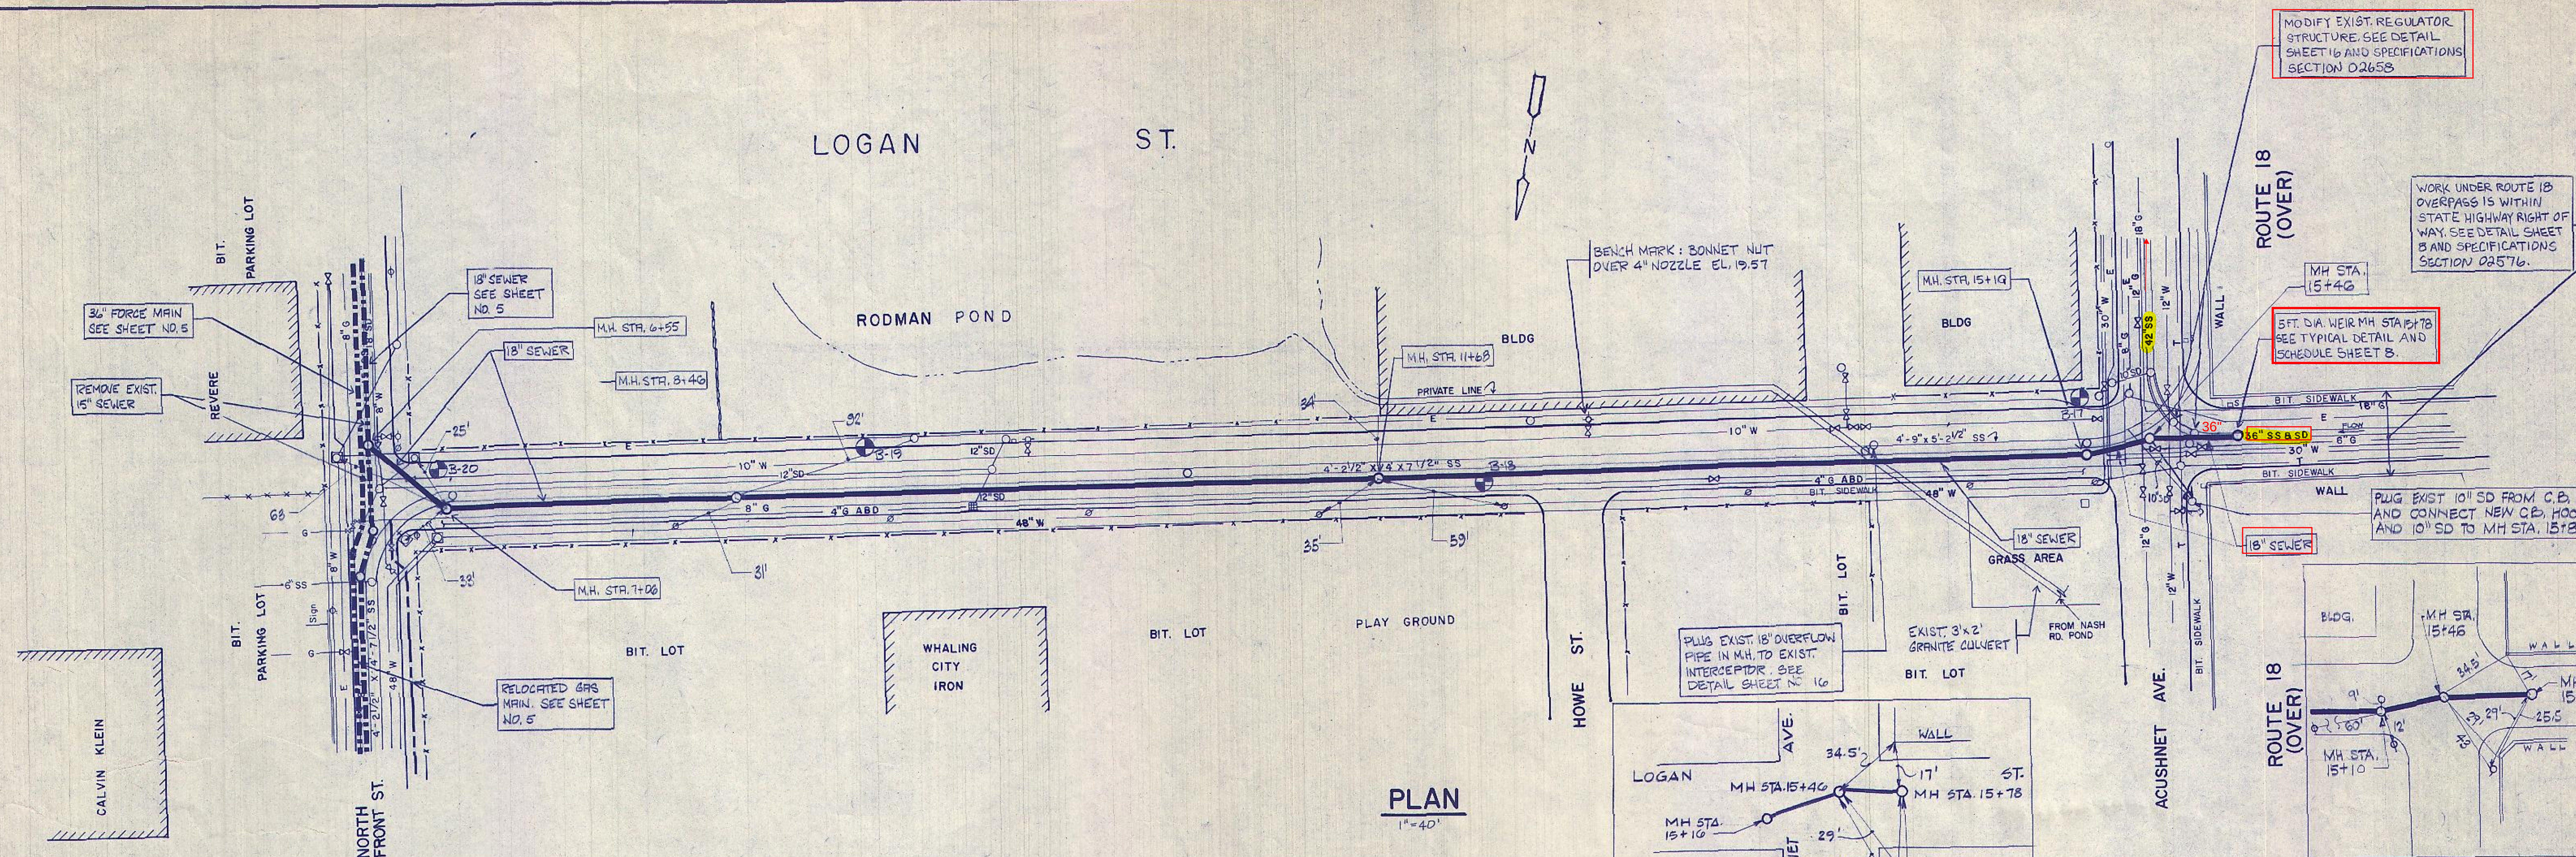

NOTES:
 1. PRELIMINARY REQUIRED STA. 6+55 TO STA. 16+20.
 2. SEE SPECIFICATIONS SECTION 02140.
 3. USE OF MOVABLE TRENCH BRACING IS PROHIBITED STA. 12+00 TO STA. 12+50. SEE SPECIFICATIONS SECTION 02221, PARAGRAPH 3.03.
 4. FILTER FABRIC REQUIRED STA. 6+55 TO STA. 16+20. SEE SPECIFICATIONS SECTION 02221, PARAGRAPH 3.06.

PROFILE
 HOR. 1"=40'
 VER. 1"=4'

RECORD DRAWING

CITY OF NEW BEDFORD, MASSACHUSETTS
 BELLEVILLE AVENUE FORCE MAIN EXTENSION

CONTRACT NO. 5

LOGAN STREET

CAMP DRESSER & McKEE INC.
 Ten Cambridge Center
 Cambridge, Massachusetts 02142

CDM
 environmental engineers, scientists,
 planners, & management consultants

Date	Ch'k'd.	Revision
7/94		REVISED FOR RECORD DRAWINGS
Designed by:	SAB/RGZ	
Drawn by:	JJB	Date: MAY 1991
Checked by:	SAB	
Approved by:	SJH	Scale: AS SHOWN

