


For details of this sewer see S.B. 1-315
136" Brick Sewer

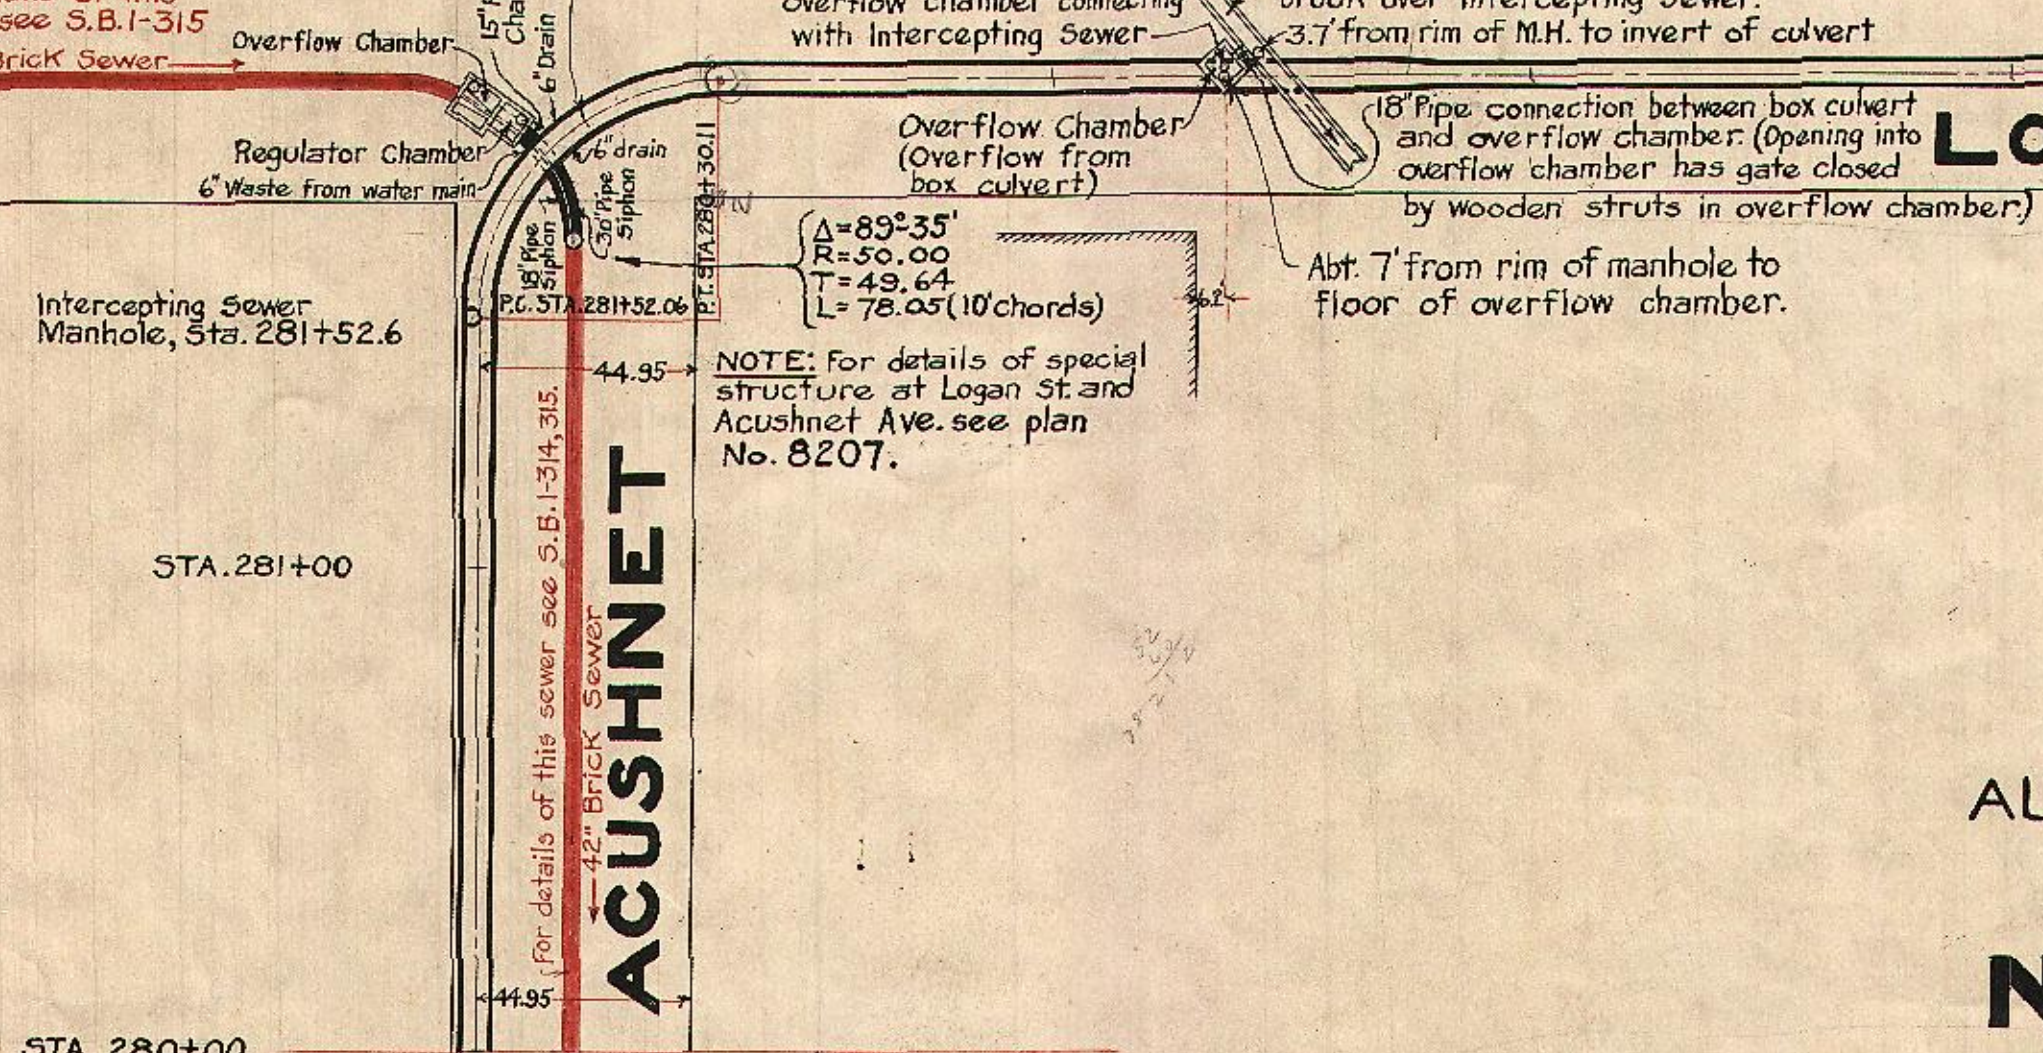

CONCRETE SEWER		10' UNDER SEWER*	
STATION	REMARKS	W.	NORTH FRONT ST.
280+00	18" stub on top of 3' east of 5' of 4-story building of Wamsutter Mills 5' e. of Logan St. and Acushnet Ave. (Enters Manhole)	22.7	26.2 (8' Ent. This is entrance into concrete sewer above branch in under sewer)
280+44.0	6" stub on top of arch		
280+76.4	6" " " " "		
280+105.8	6" " " " "		
280+124.0	6" " " " "		
280+130.8	6" " " " "		
280+140.0	6" " " " "		
280+170.0	6" " " " "		
280+173.0	6" " " " "		
280+176.0	6" " " " "		
280+180.0	6" " " " "		
280+183.0	6" " " " "		
280+186.0	6" " " " "		

*No present outlet.

NOTE: All measurements shown for under sewer branches in North Front St. are on center line of street.
Ends of under sewer branches are 3.1' from center line.


AUTHORITY OF CHAP. 474, ACTS OF 1910.
**SEWAGE DISPOSAL
NEW BEDFORD, MASS.
INTERCEPTING SEWER
STA. 280+00-STA. 292+00**

SCALES: PLAN 1"=40'
PROFILE 1"=40'
SEPT. 1920.


NOTE: STA. 143+66.65 LINE BACK= STA. 143+74.86 LINE AHEAD.

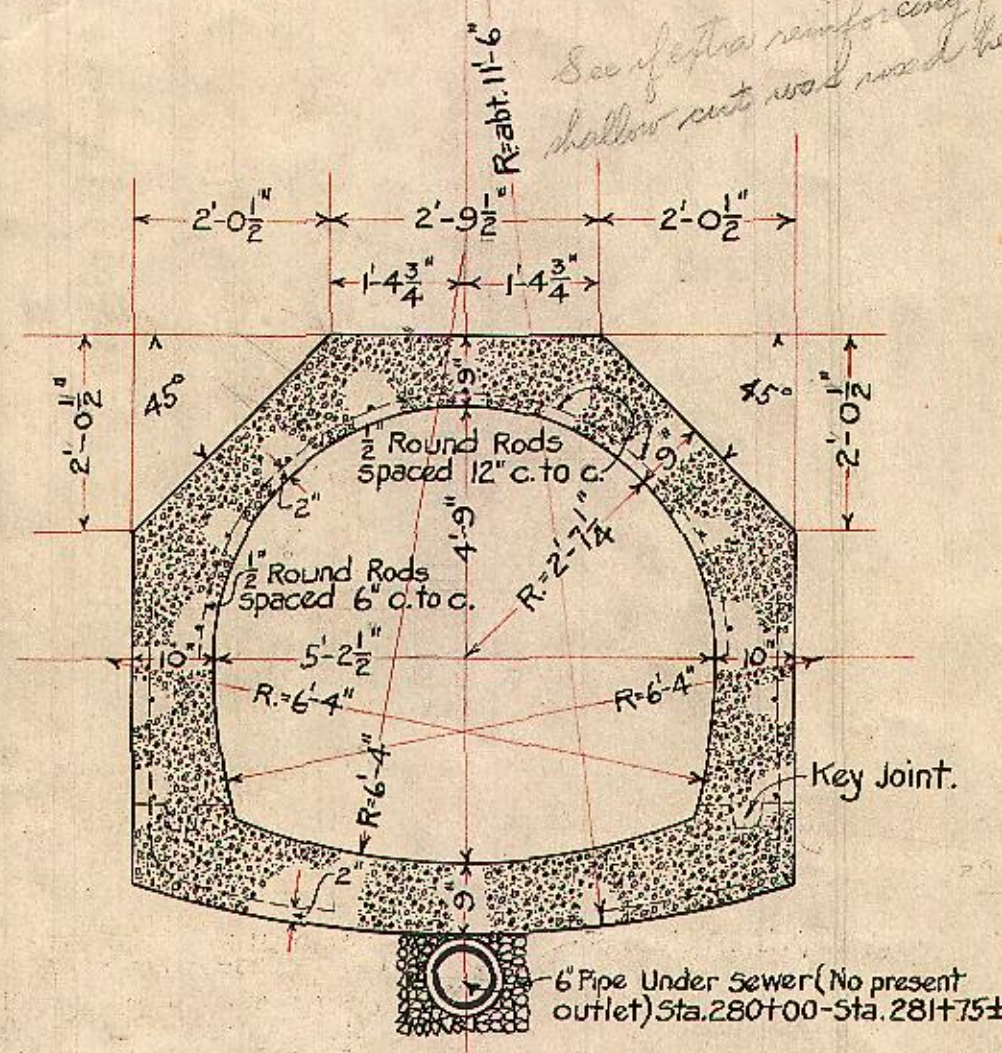

SECTION OF 4'-9" X 5'-2 1/2" REINFORCED CONCRETE SEWER
STA. 280+00-STA. 283+70
SCALE 1/2"=1'

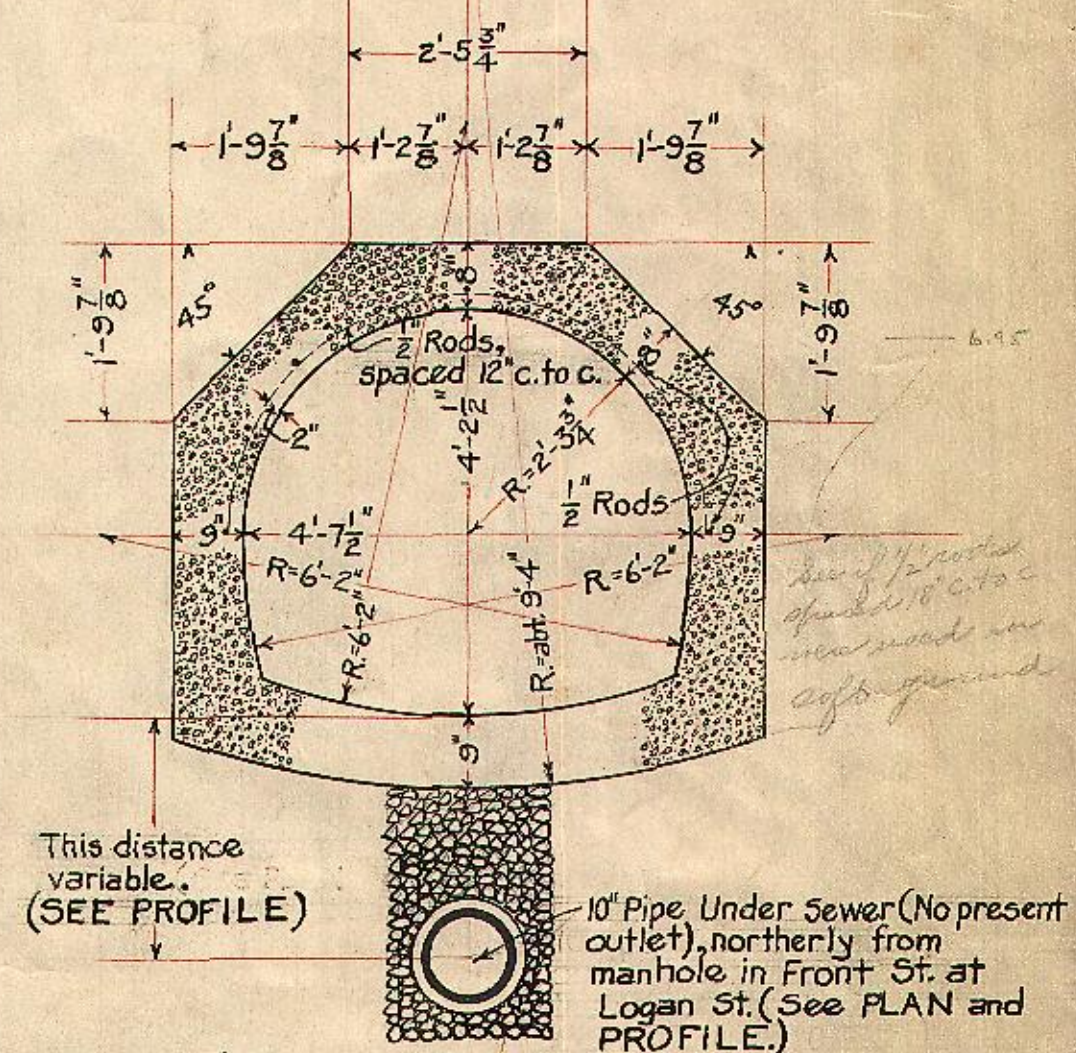

SECTION OF 4'-2 1/2" X 4'-7 1/2" REINFORCED CONCRETE SEWER
STA. 283+80-STA. 292+00
SCALE 1/2"=1'

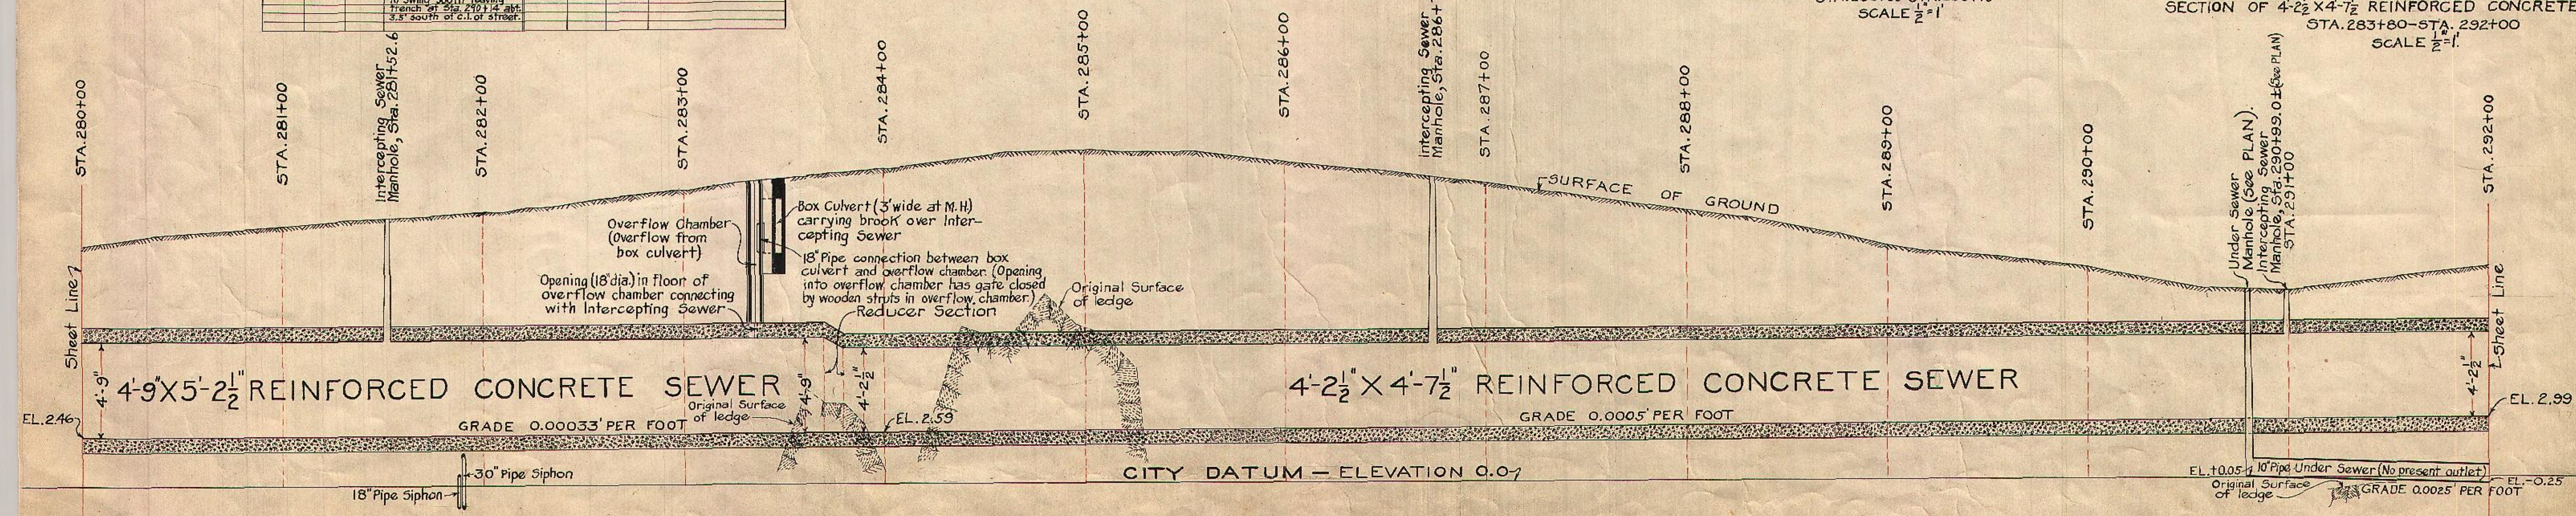

PROFILE