
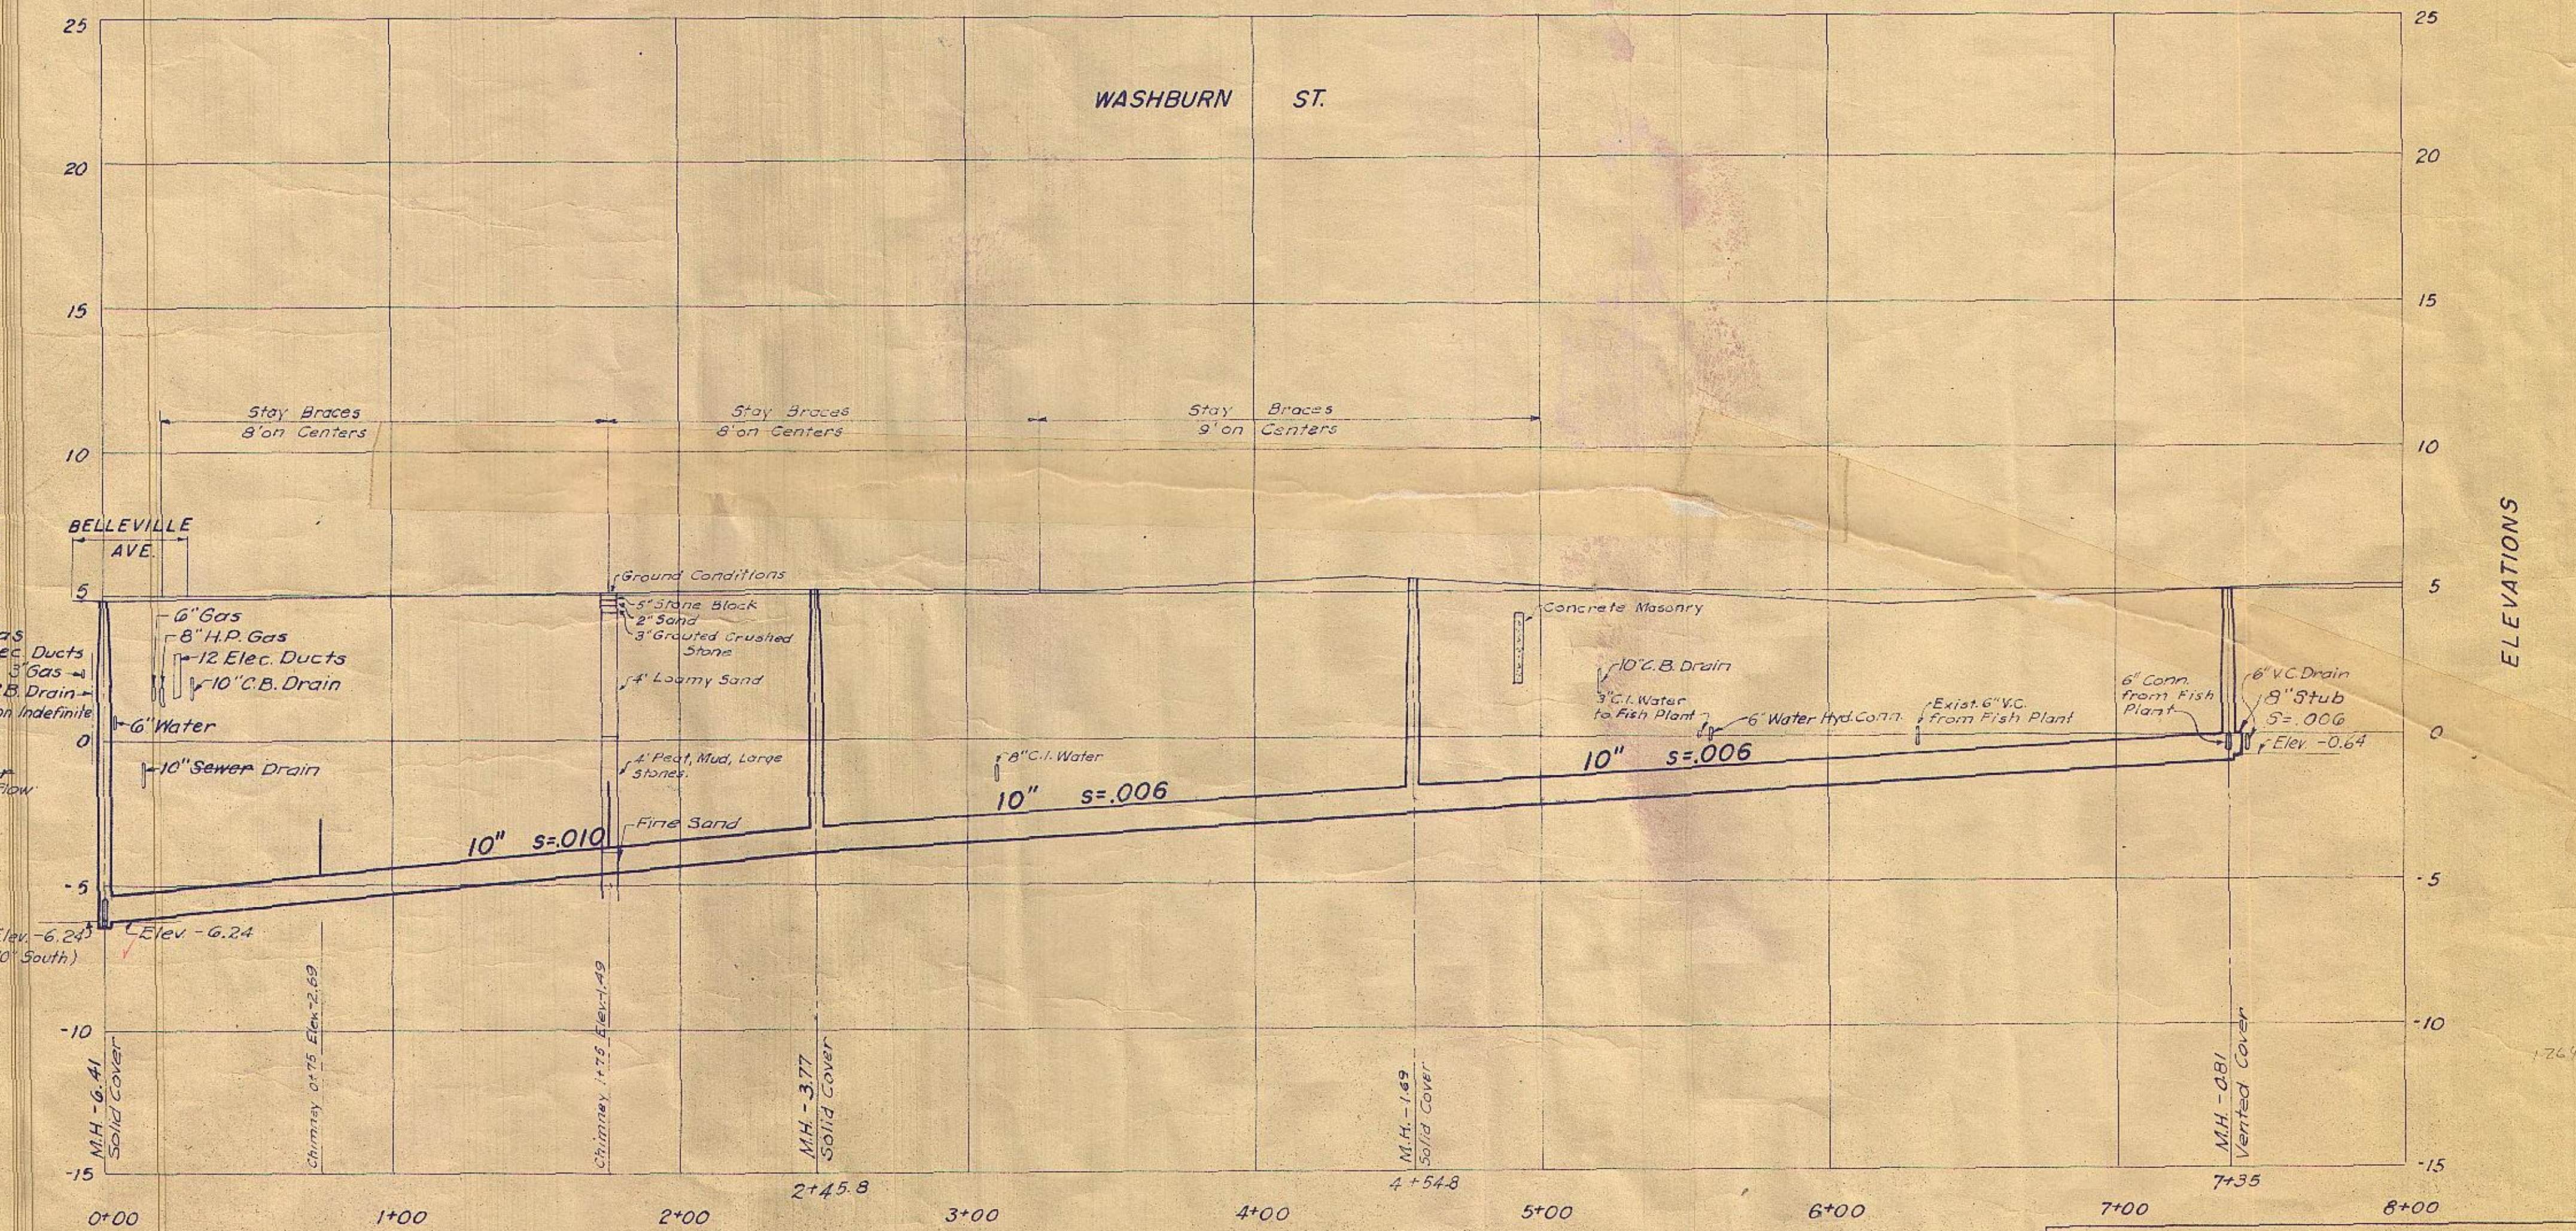
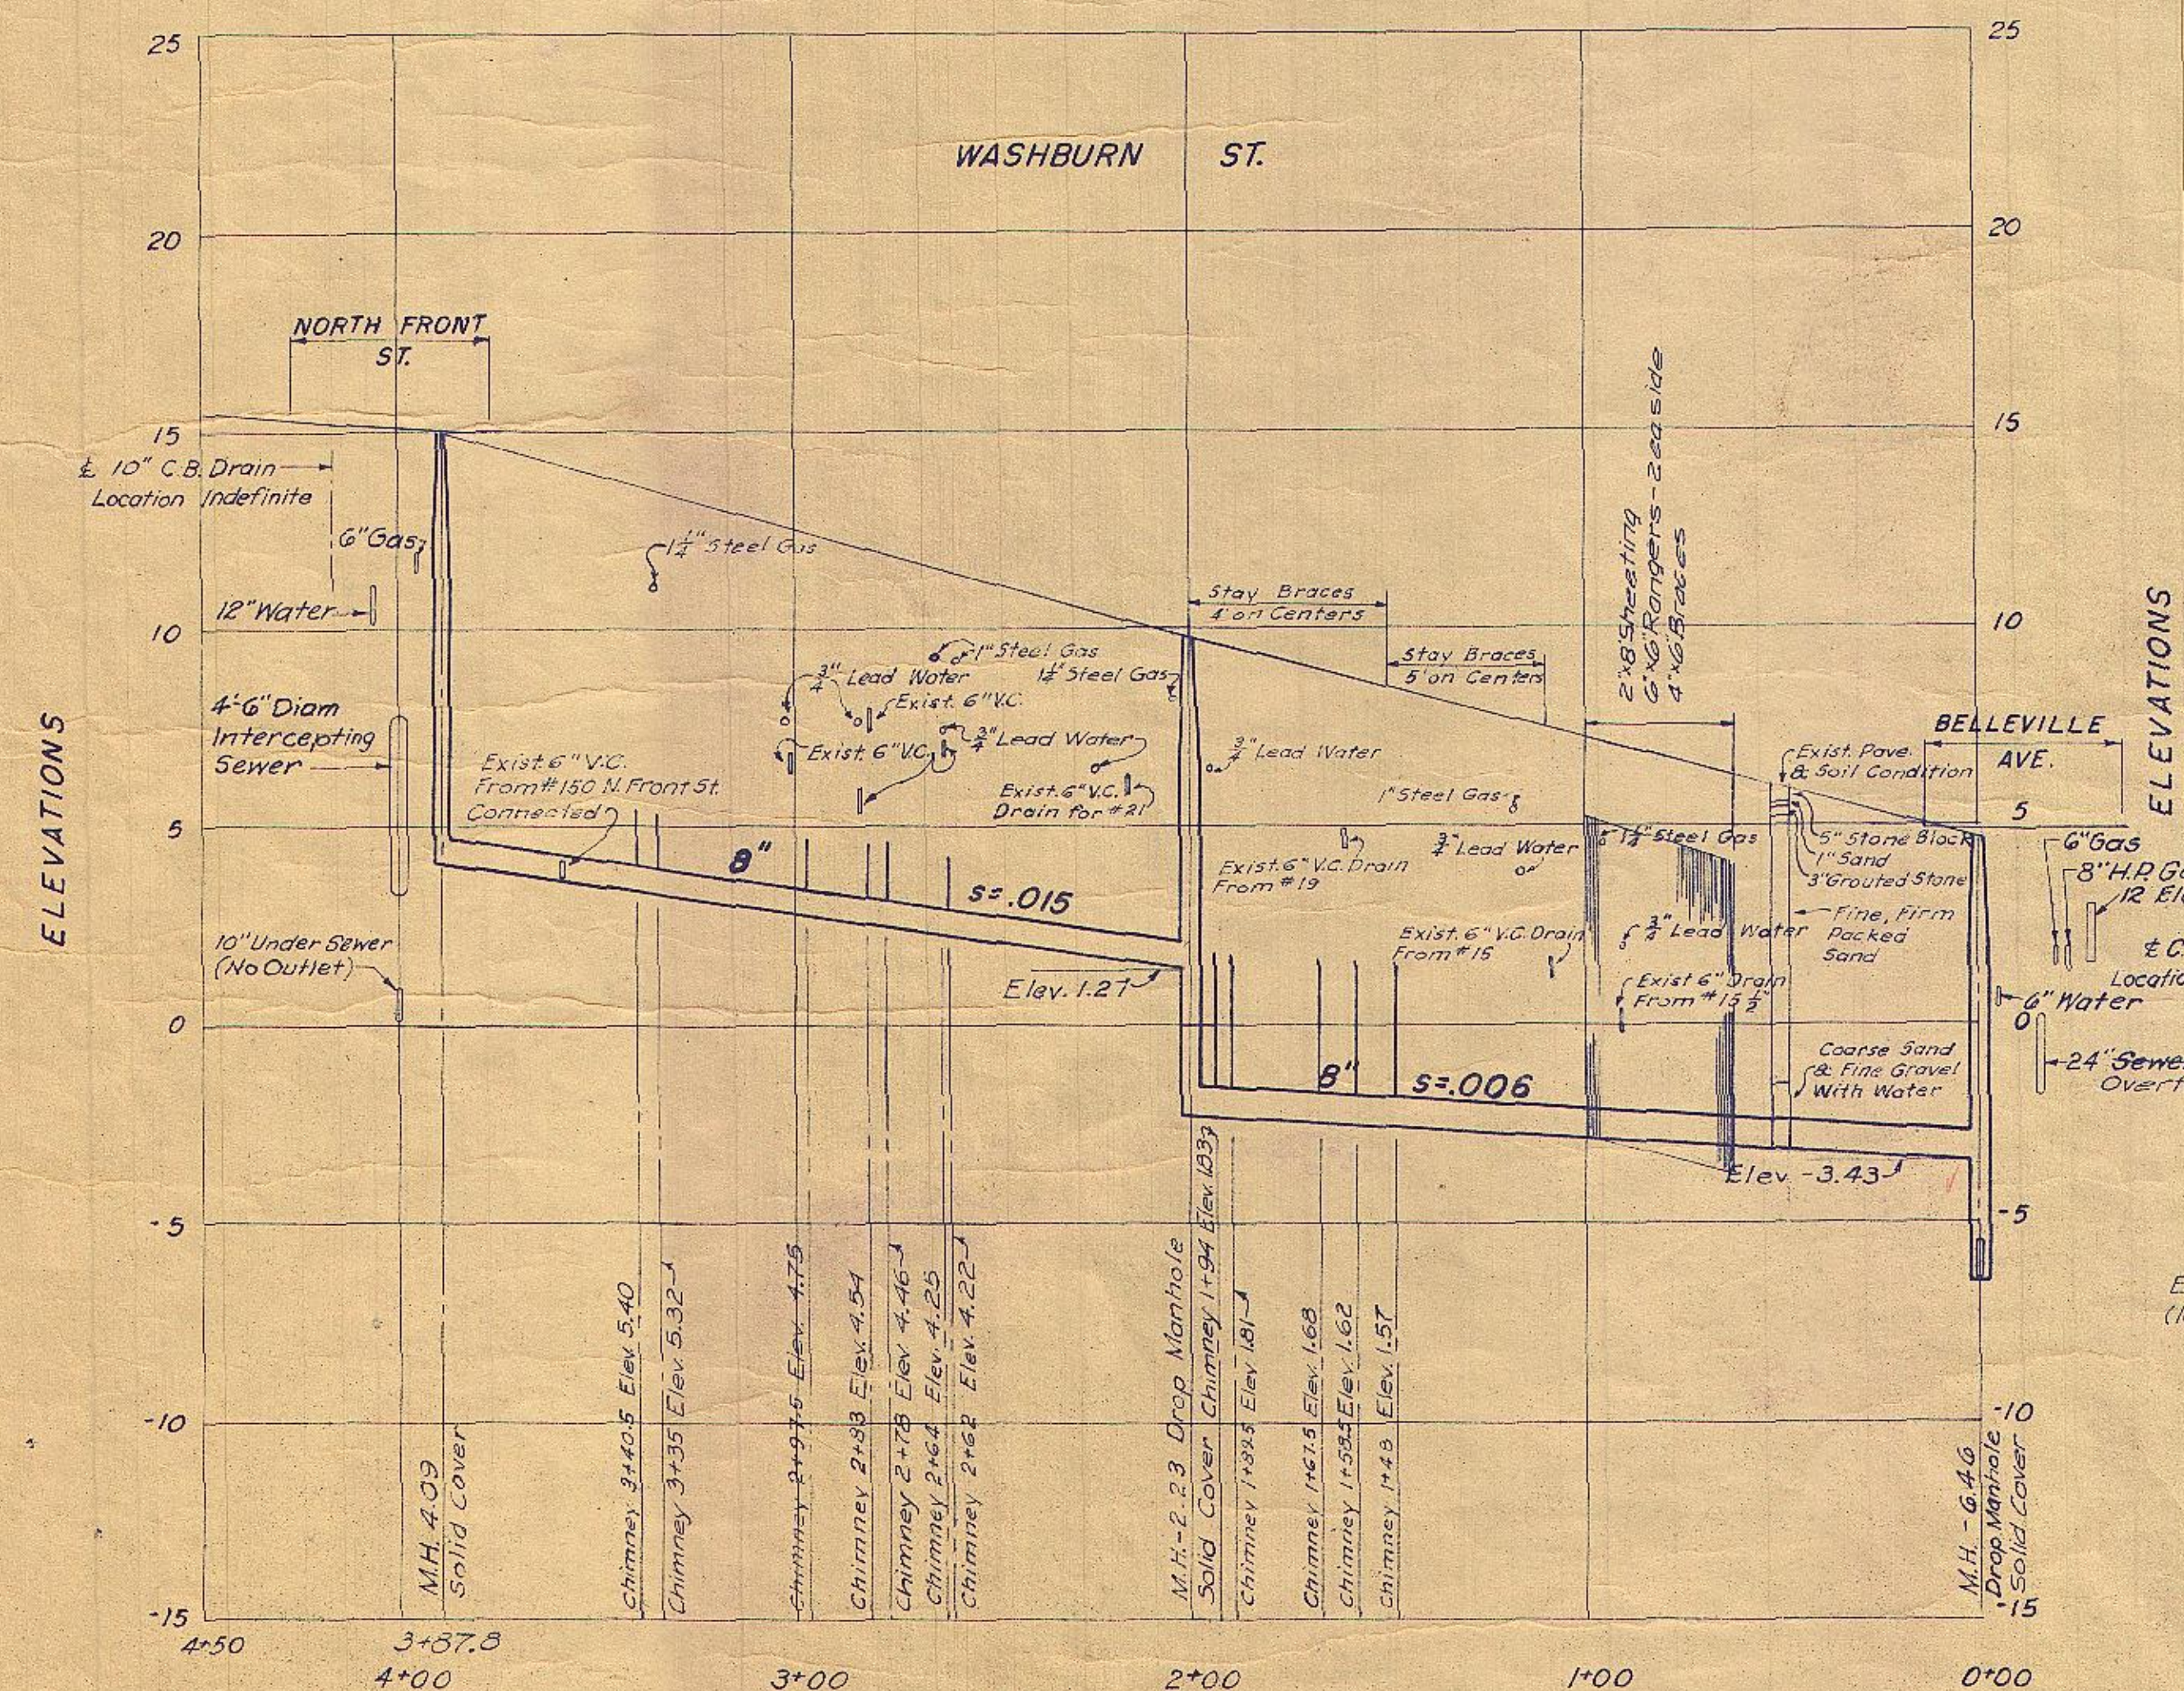


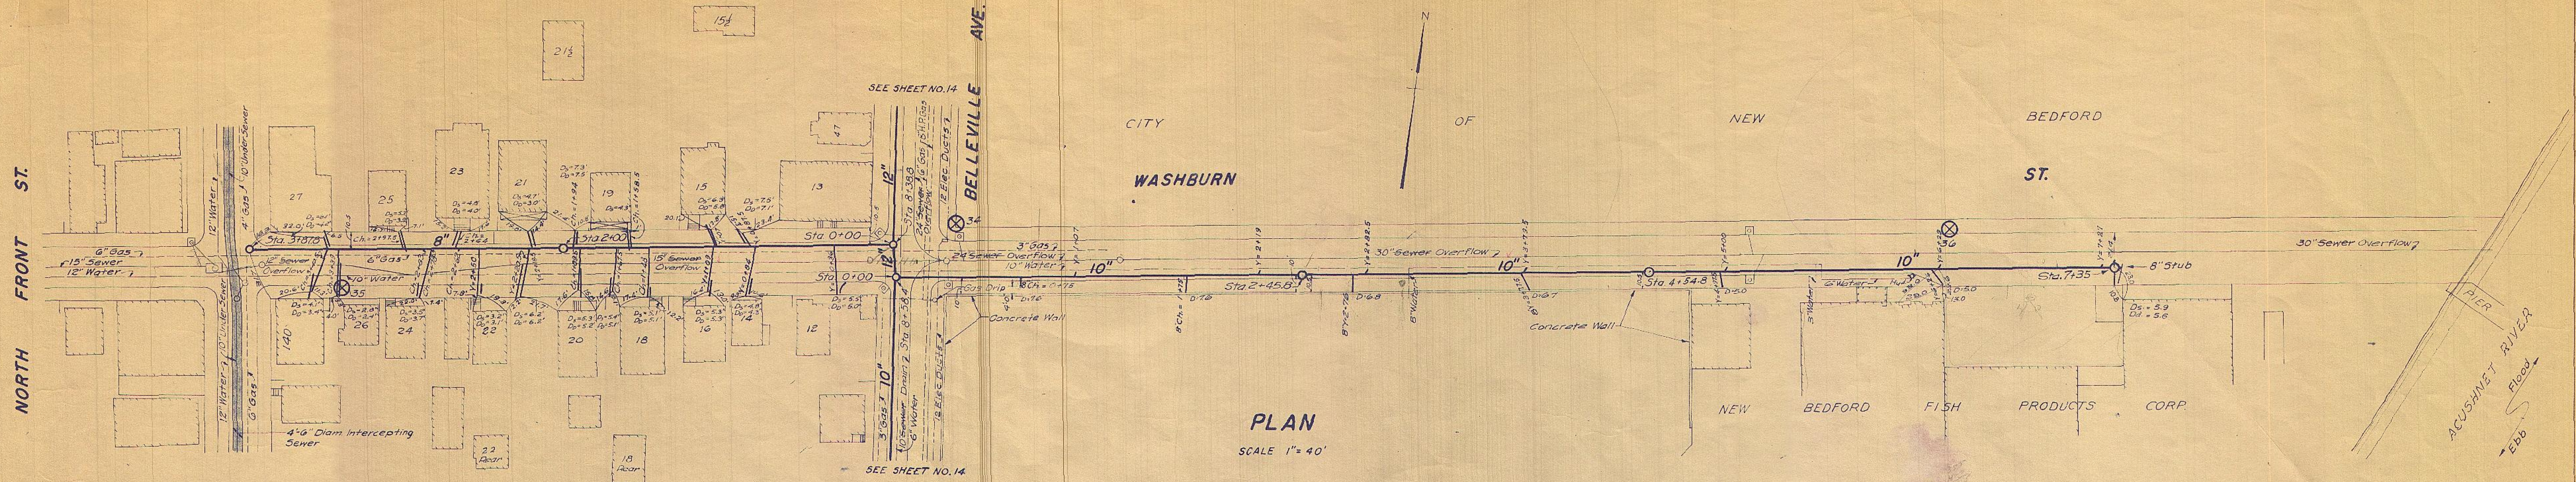

FOR DETAILS, GENERAL NOTES AND LEGEND SEE SHEET NO. 29 AND SHEET NO. 33

REV. NO.	DATE	DESCRIPTION	MADE BY	CHK. BY	APP. BY
1	2-15-1	Revised as built.	BLS	GCC	H
2	2-15-1	Revised as built.	BLS	GCC	H

NEW BEDFORD, MASSACHUSETTS
DEPARTMENT OF PUBLIC WORKS

ADDITIONS TO INTERCEPTING SEWER SYSTEM
SEWERS

WASHBURN ST. (BELLEVILLE AVE. TO NORTH FRONT ST.)
WASHBURN ST. (East of BELLEVILLE AVE.)

SCALE AS NOTED OCT 1948
FAY, SPOFFORD & THORNDIKE, ENGINEERS, BOSTON, MASS.

DES. C.R.S. TR. F.M.
DR. G.R. CHK. G.C.C., G.S.M., G.R.S.

APPROVED R.W. Home
FILE NO. Jn-1
PLAN NO. 22

CONTRACT DRAWING SHEET NO. 15 OF 33