
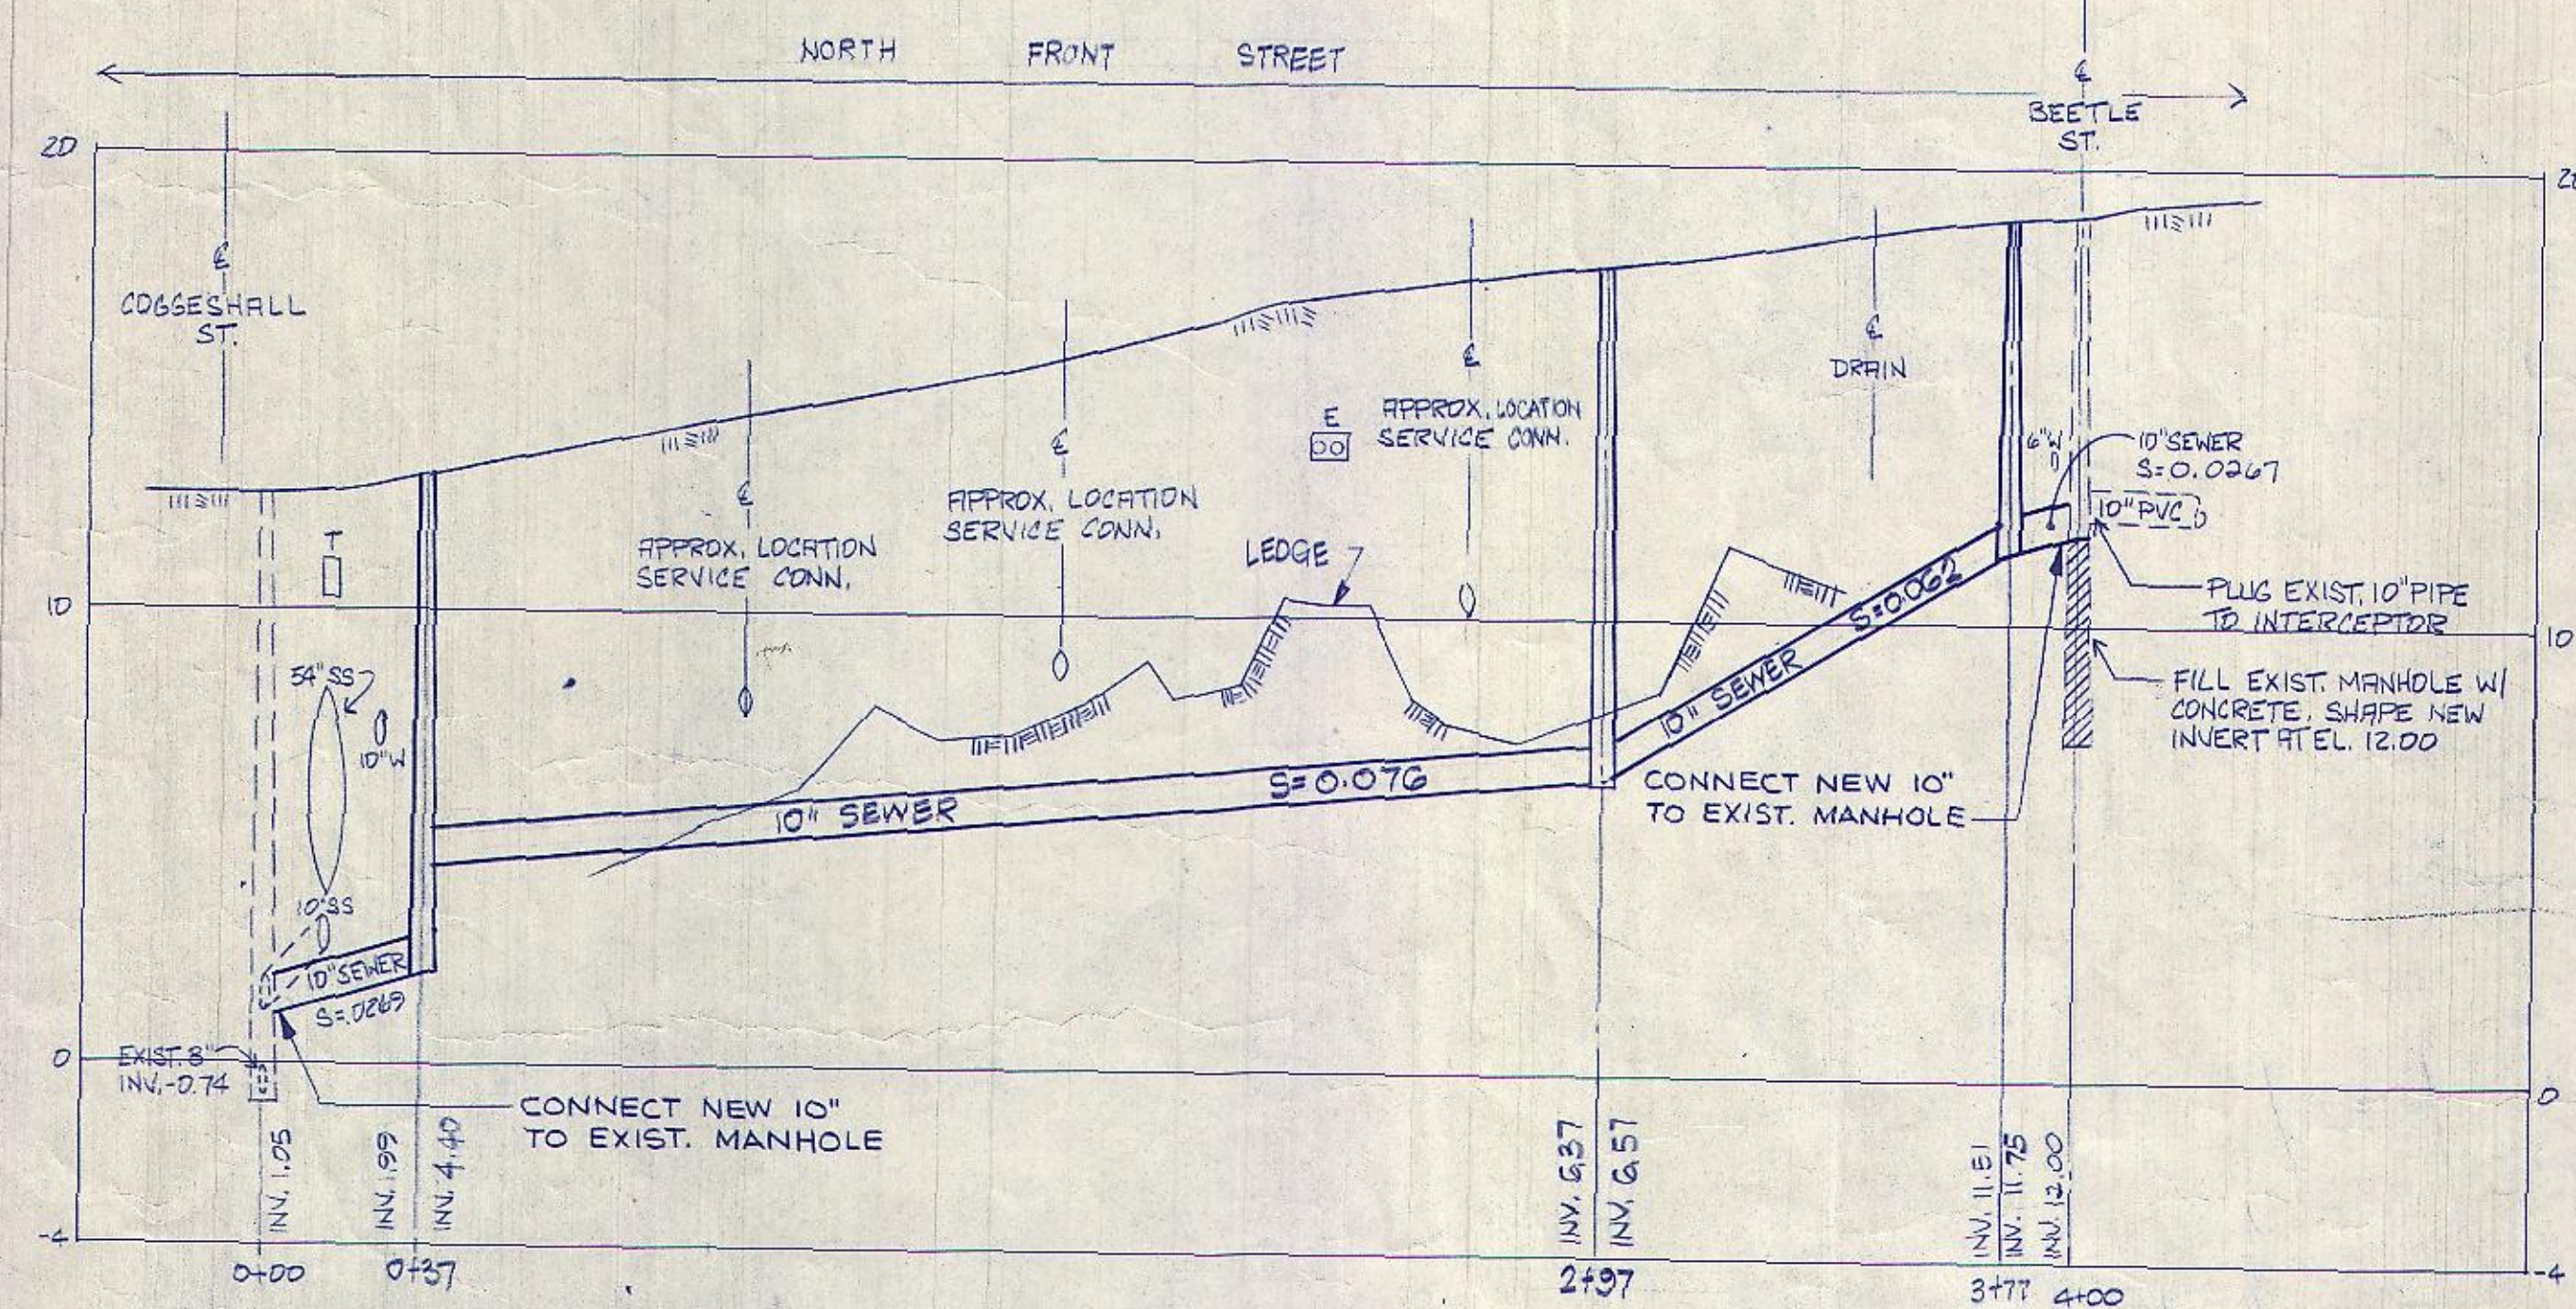
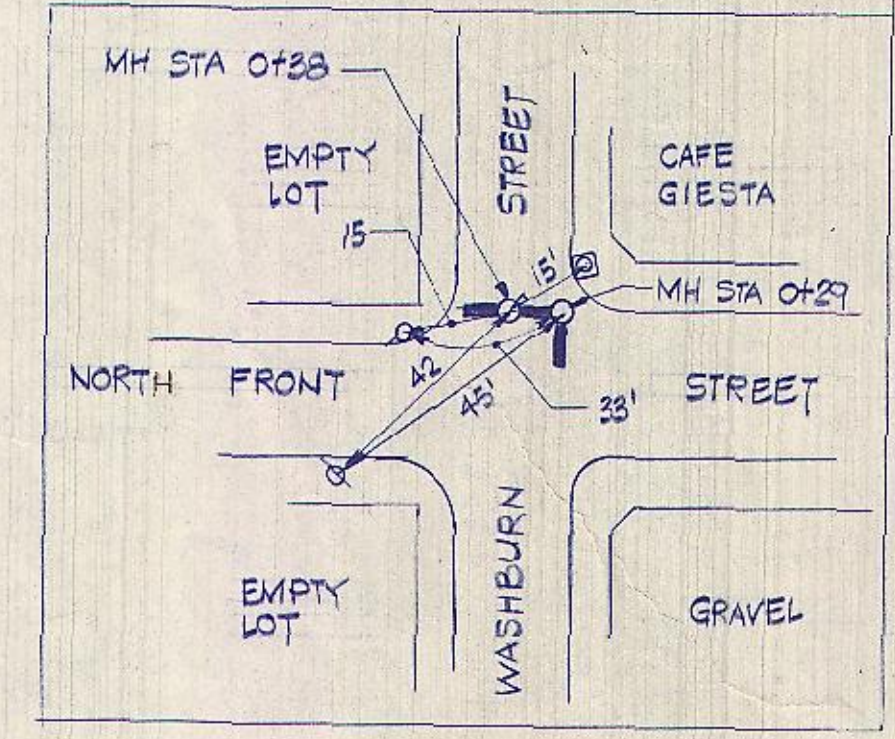
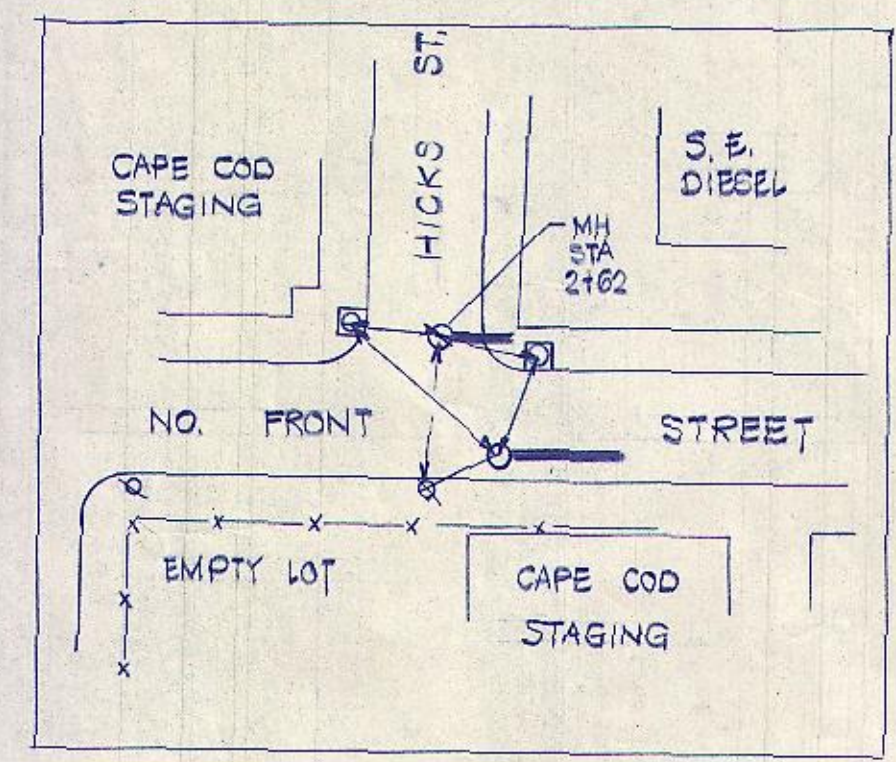
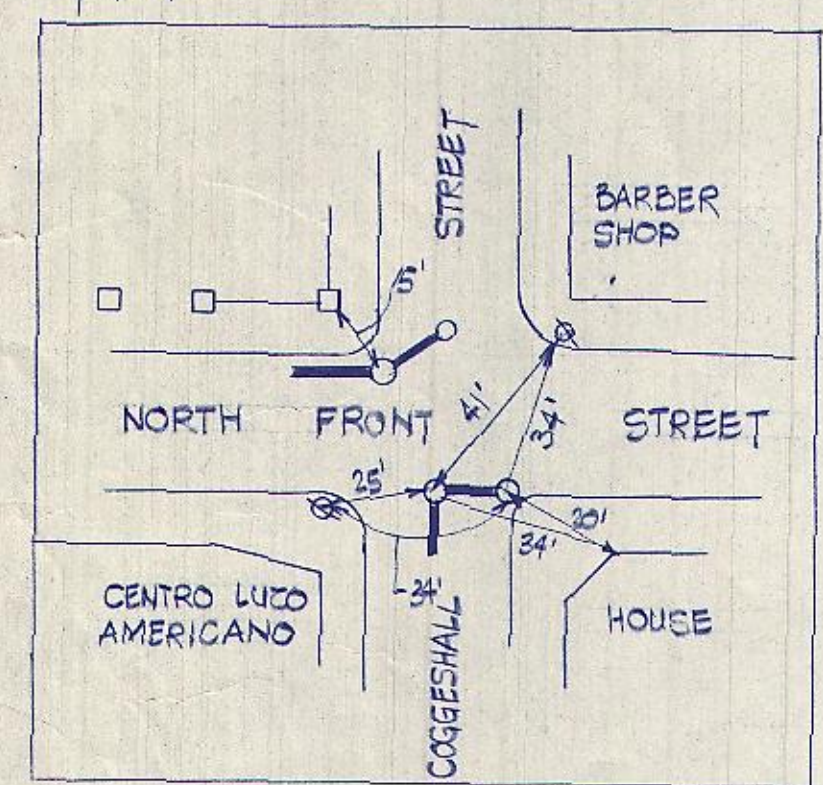




PROJECT MANAGER
 PROJECT ENGINEER
 PLUMBING
 HVAC
 INSTRUMENTATION
 ELECTRICAL
 STRUCTURAL
 ARCHITECTURAL

Approved by: _____ Date: _____
 Approved by: _____ Date: _____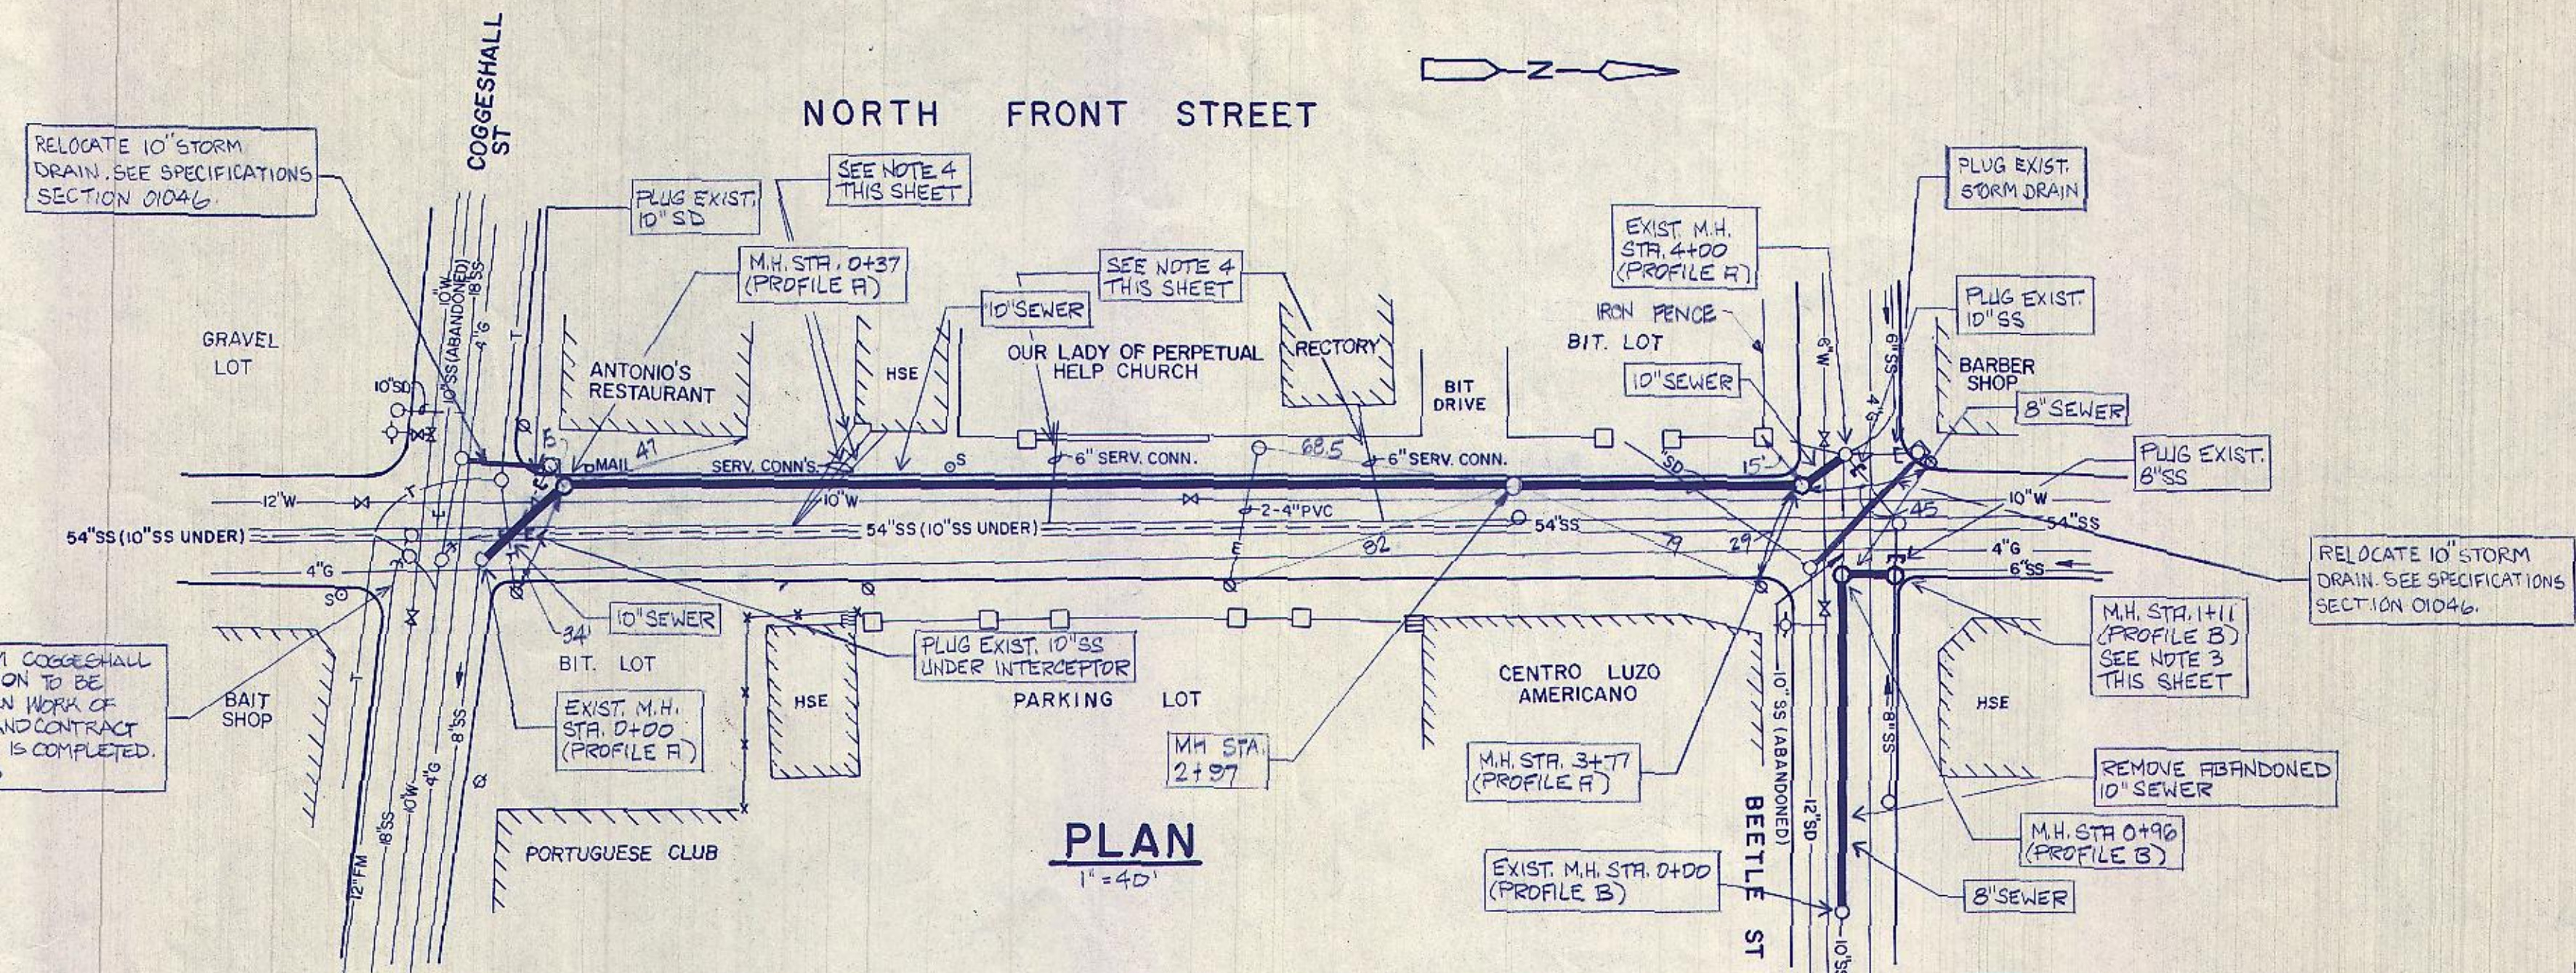
PROFILE A
 NORTH FRONT STREET
 HOR: 1"=40'
 VER: 1"=4'

- NOTES:
1. PRELIMINARY REQUIRED STA. 0+80 TO STA. 2+61 (NORTH FRONT ST. FROM HICKS ST. TO WASHBURN ST.) SEE SPECIFICATIONS SECTION 02.40.
 2. USE OF MOVABLE TRENCH BRACING IS PROHIBITED. STA. 0+90 TO STA. 2+61 (NORTH FRONT ST. FROM HICKS ST. TO WASHBURN ST.) SEE SPECIFICATIONS SECTION 02.21, PARAGRAPH 3.03.
 3. CONTRACTOR TO DIG TEST PIT TO LOCATE EXIST. 6" SEWER CONNECTION WITH EXIST. 8" SEWER.
 4. CONTRACTOR TO DIG TEST PITS TO DETERMINE THE LOCATIONS OF ALL BUILDING SERVICE CONNECTIONS PRIOR TO PROCEEDING UPSTREAM OF STA. 0+35. CONTRACTOR SHALL CONNECT BUILDING SERVICES INTO NEW 10" SEWER.
 5. CONTRACTOR TO DIG TEST PITS TO LOCATE SERVICE CONNECTIONS FROM BUILDINGS ON EAST SIDE OF NORTH FRONT STREET PRIOR TO CONSTRUCTING 8" SEWER. CONTRACTOR SHALL CONNECT BUILDING SERVICES INTO NEW 8" SEWER.

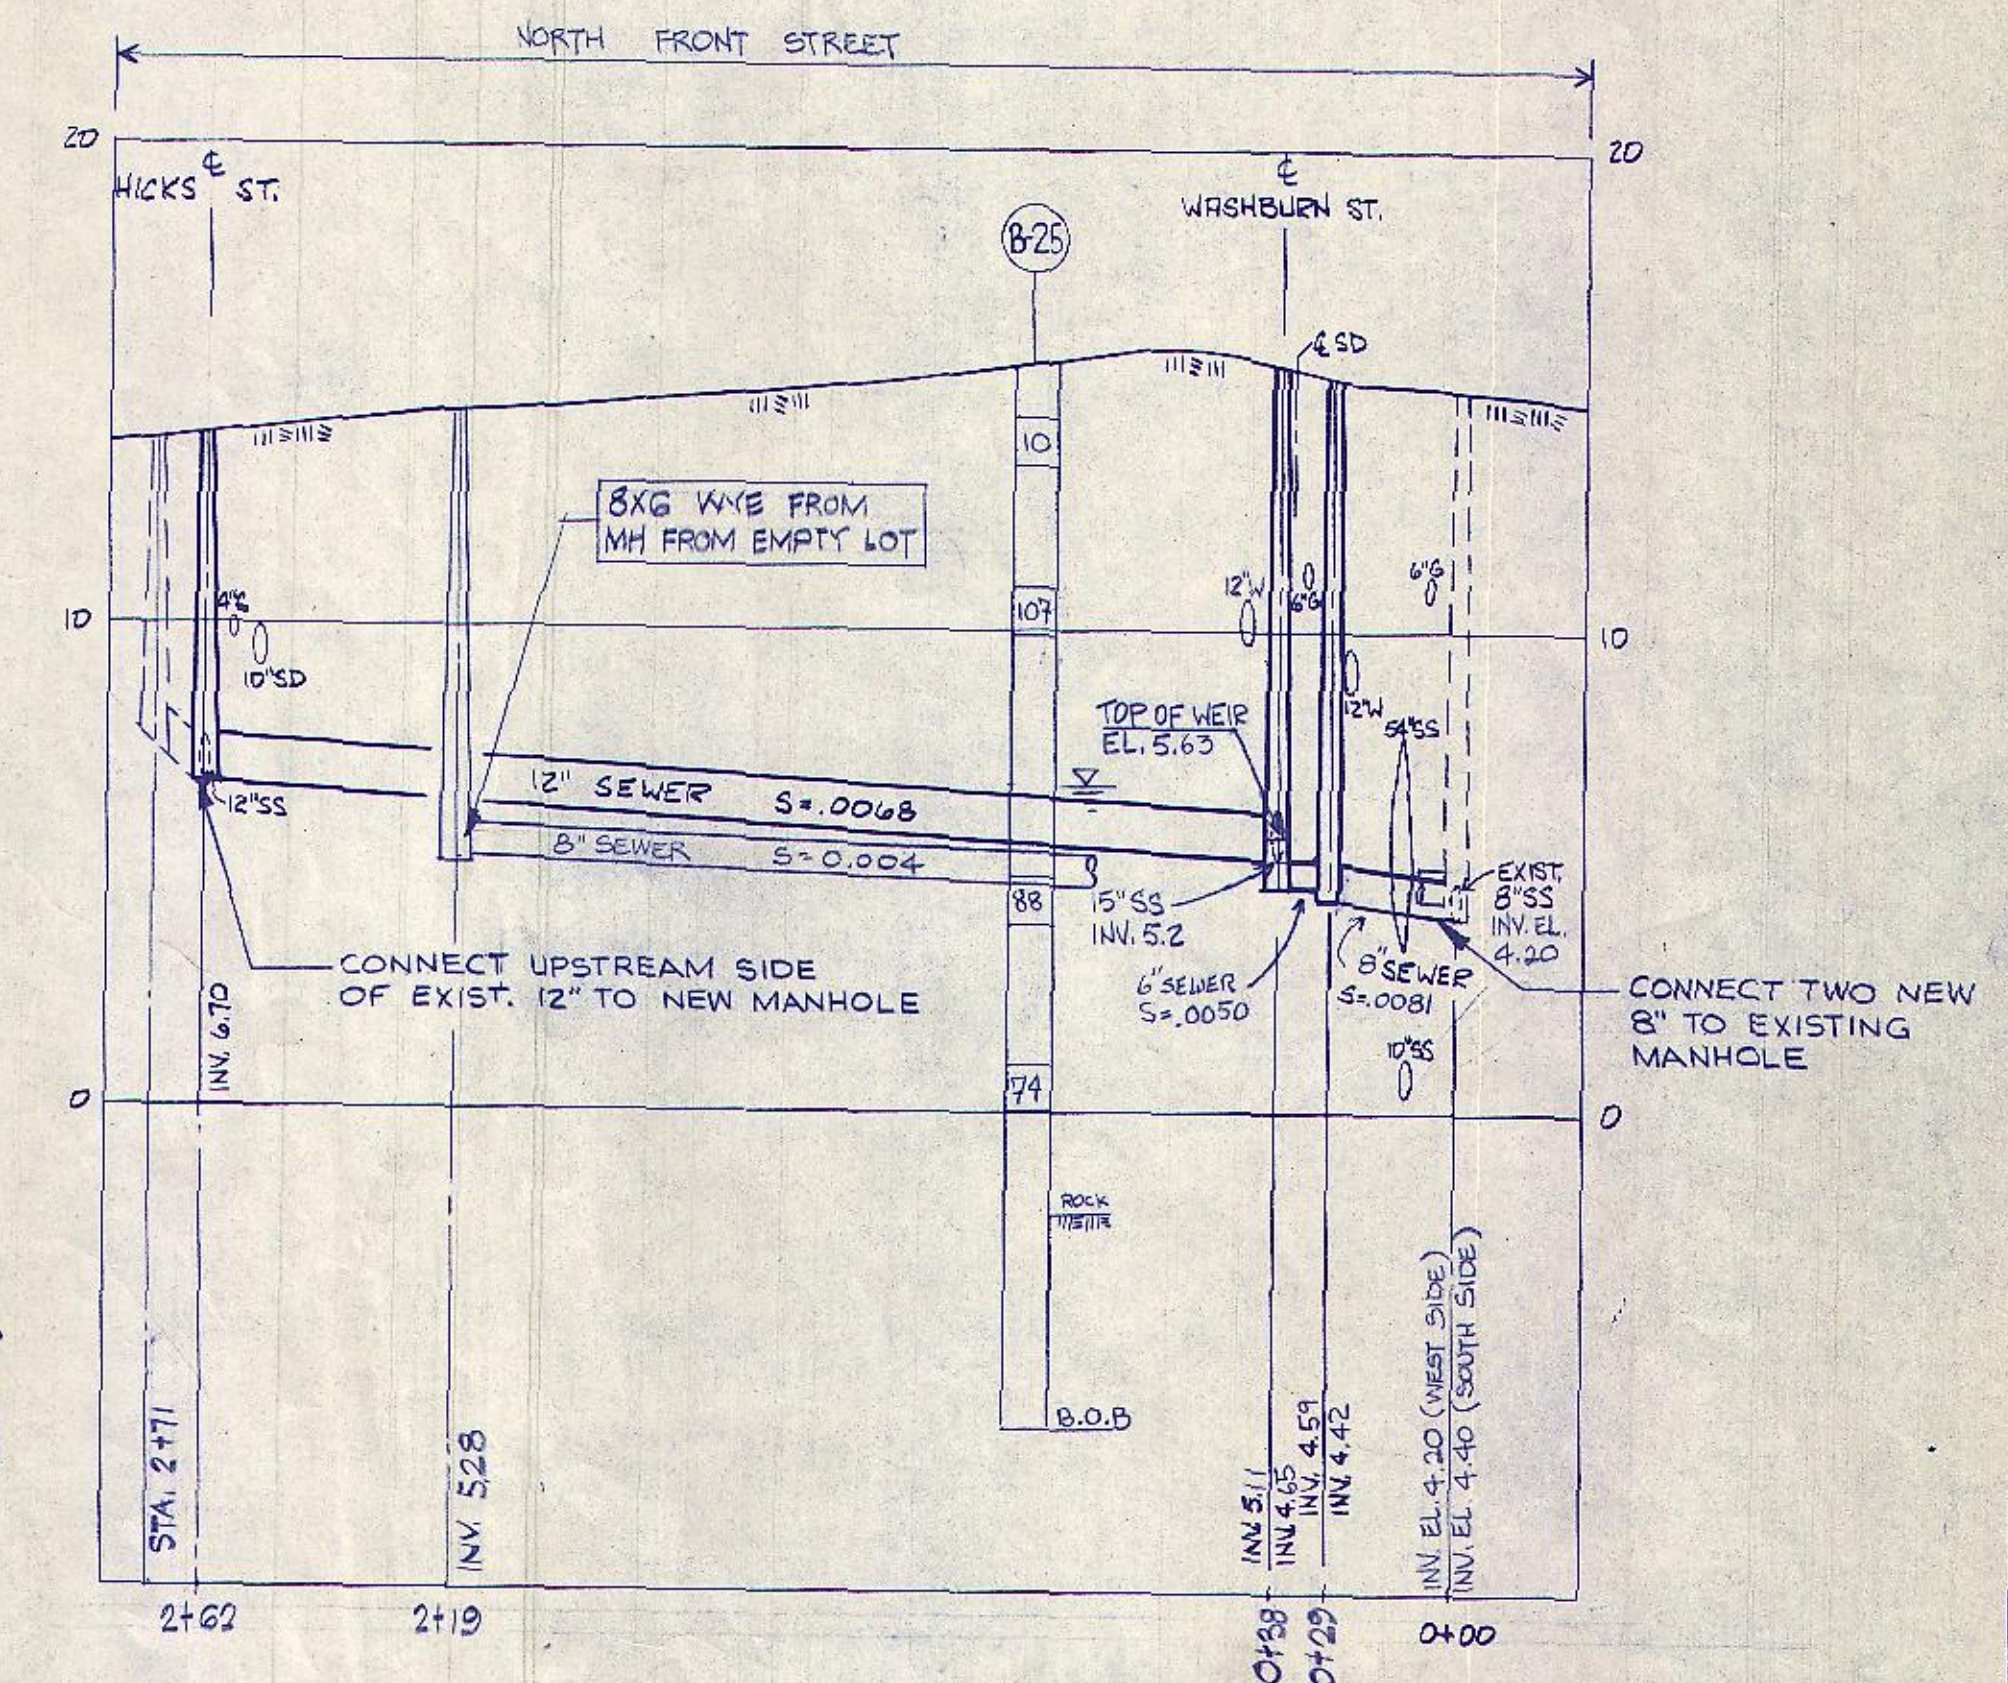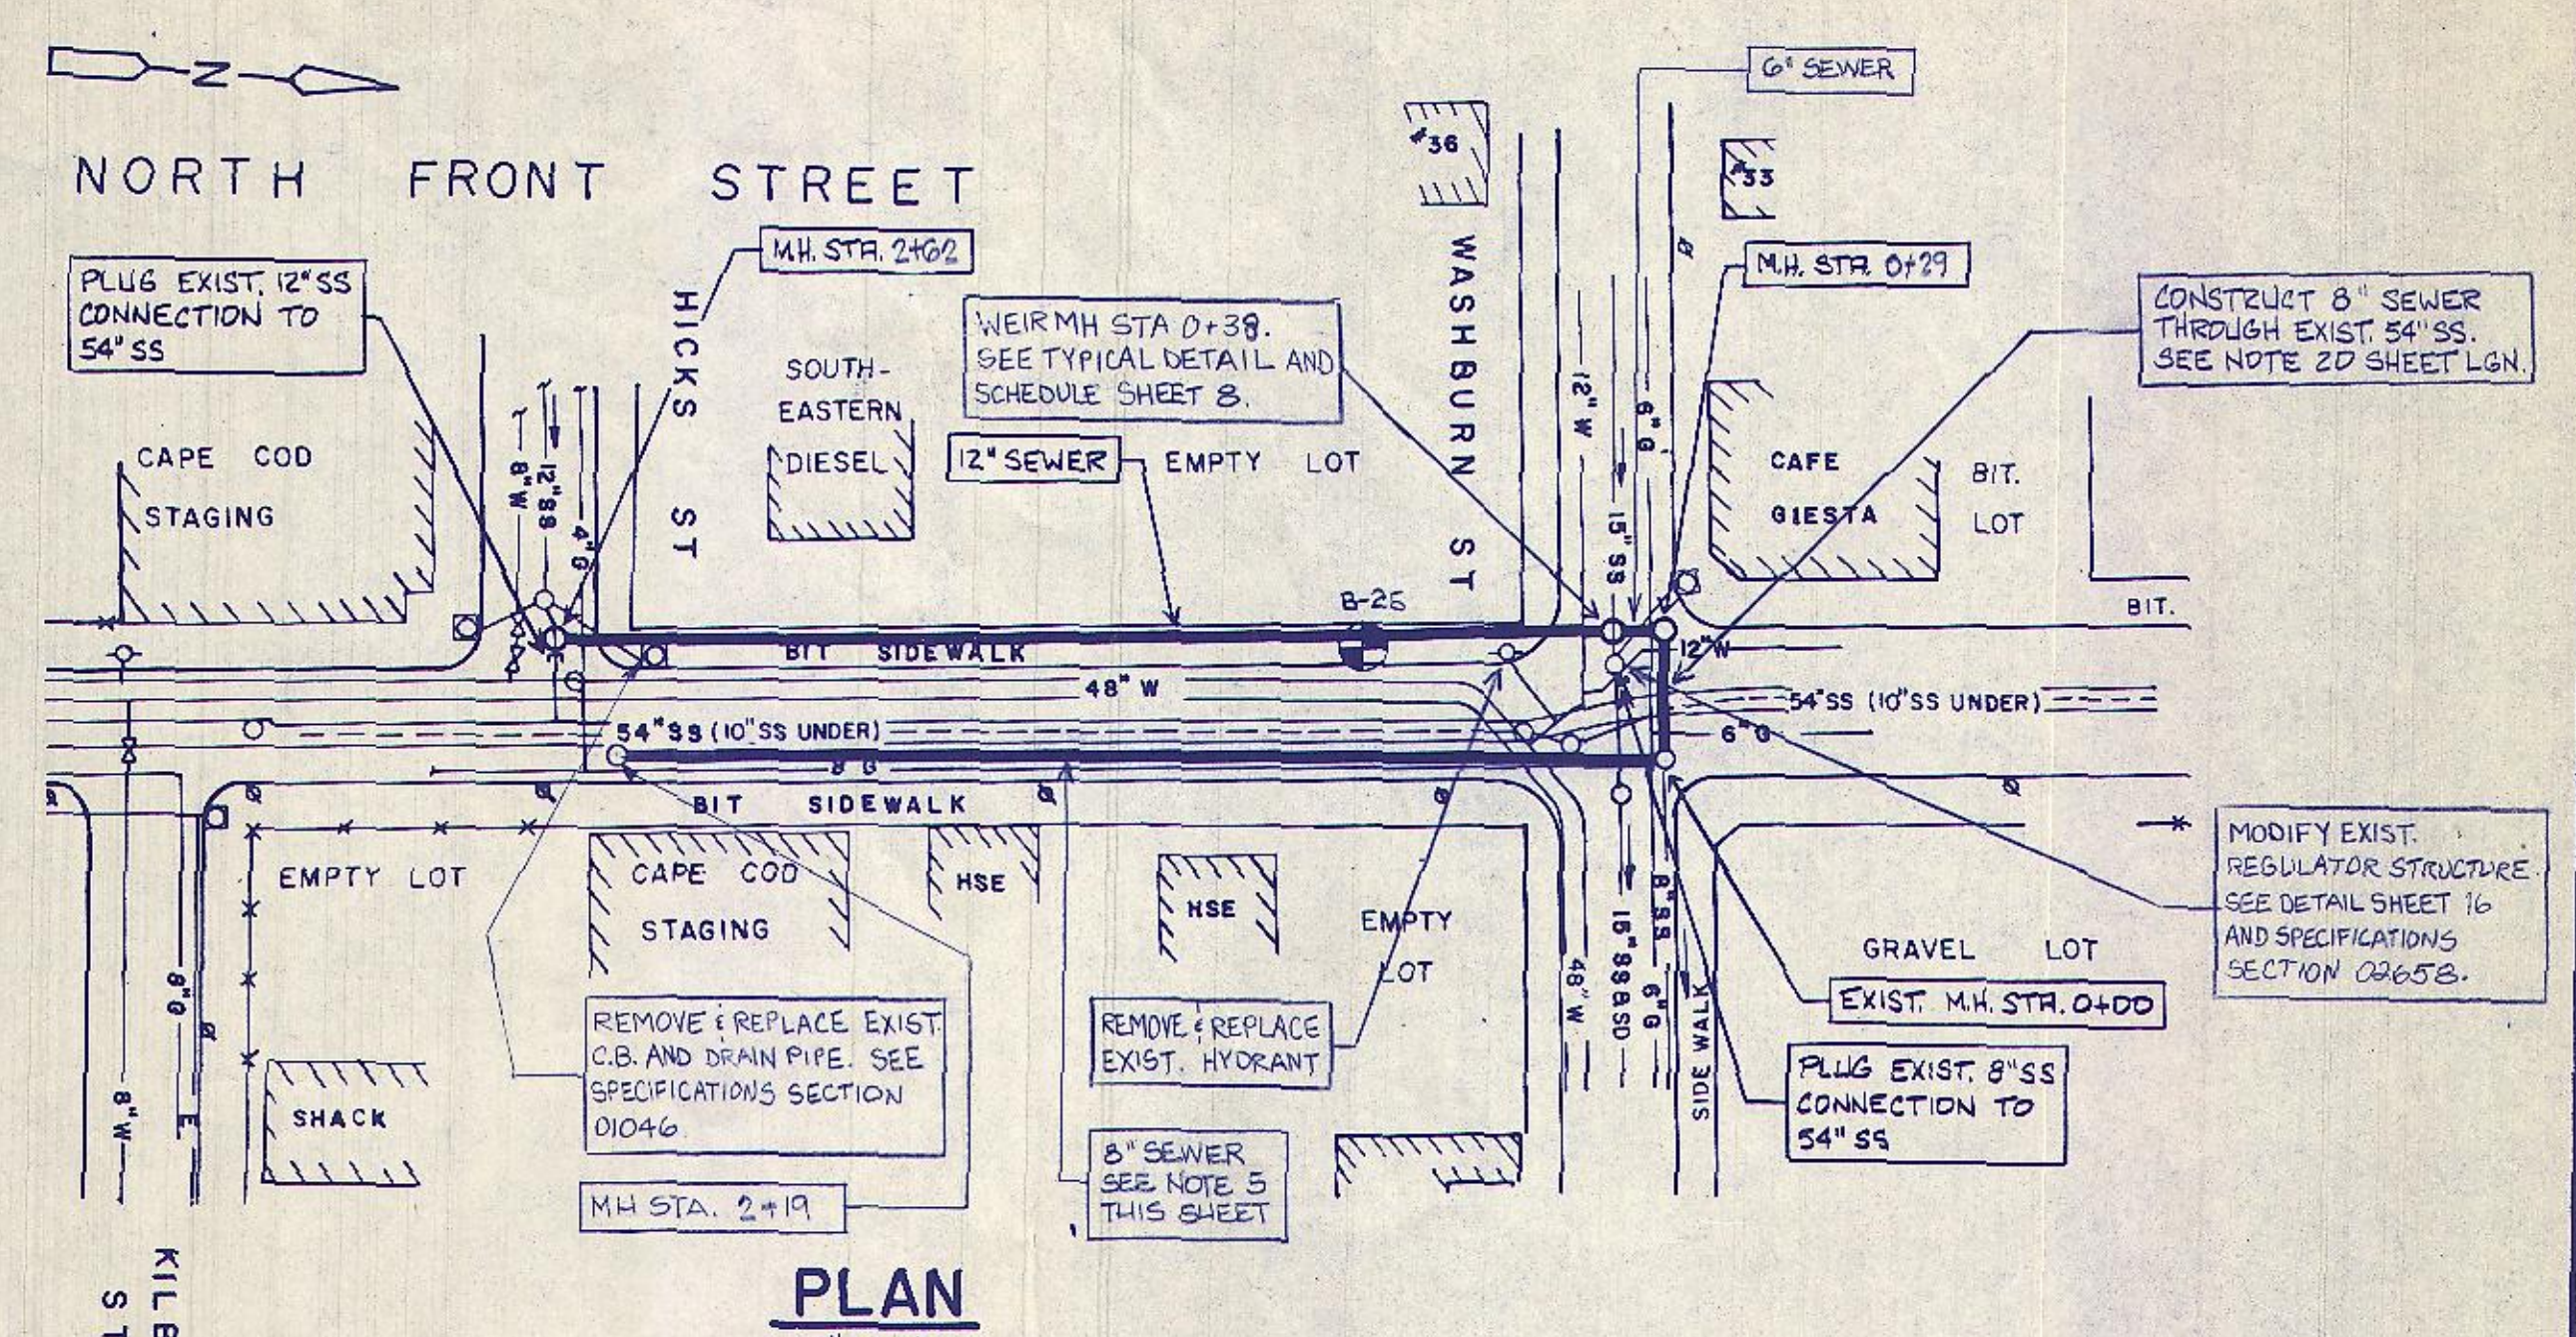

PROFILE B
 BEETLE STREET
 HOR: 1"=40'
 VER: 1"=4'

PROFILE
 HOR: 1"=40'
 VER: 1"=4'

RECORD DRAWING



Date	Ch'd.	Revision
7/94		REVISED FOR RECORD DRAWINGS
Designed by:	SAB/AGZ	
Drawn by:	JJB	
Checked by:	SAB	
Approved by:	SJH	
Date:	MAY 1991	
Scale:	AS SHOWN	

CITY OF NEW BEDFORD, MASSACHUSETTS
 BELLEVILLE AVENUE FORCE MAIN EXTENSION
 CONTRACT NO. 5
NORTH FRONT STREET
 CAMP DRESSER & McKEE INC.
 Ten Cambridge Center
 Cambridge, Massachusetts 02142
CDM
 environmental engineers, scientists,
 planners, & management consultants
 SHEET NO. 10
 309-47809