




PROJECT MANAGER	Approved by: _____ Date: _____
PROJECT ENGINEER	Approved by: _____ Date: _____
PLUMBING	Approved by: _____ Date: _____
HVAC	Approved by: _____ Date: _____
INSTRUMENTATION	Approved by: _____ Date: _____
ELECTRICAL	Approved by: _____ Date: _____
STRUCTURAL	Approved by: _____ Date: _____
ARCHITECTURAL	Approved by: _____ Date: _____

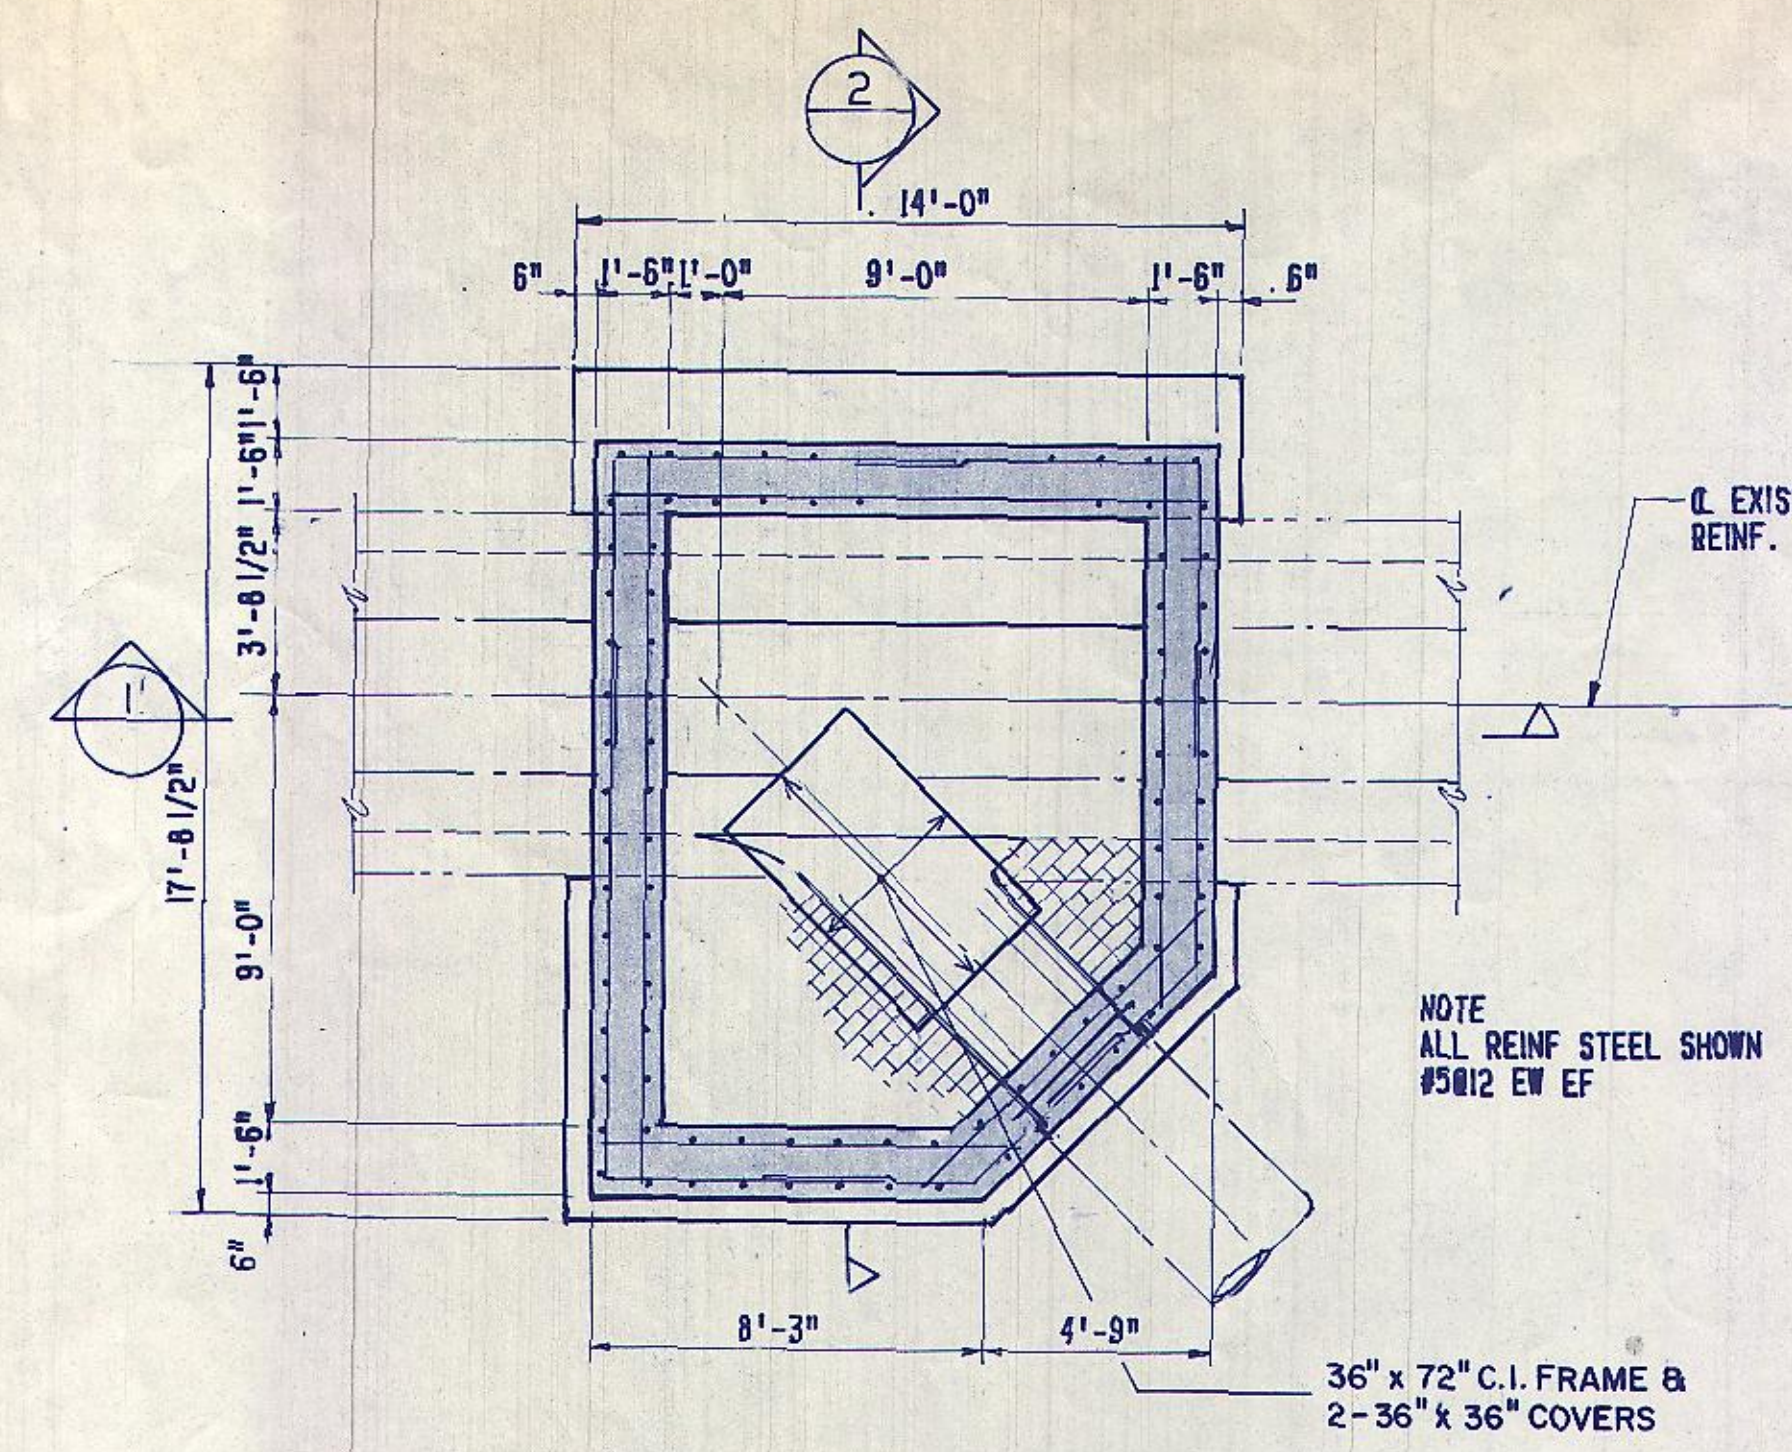


PLAN
SCALE: 1/4" = 1'-0"

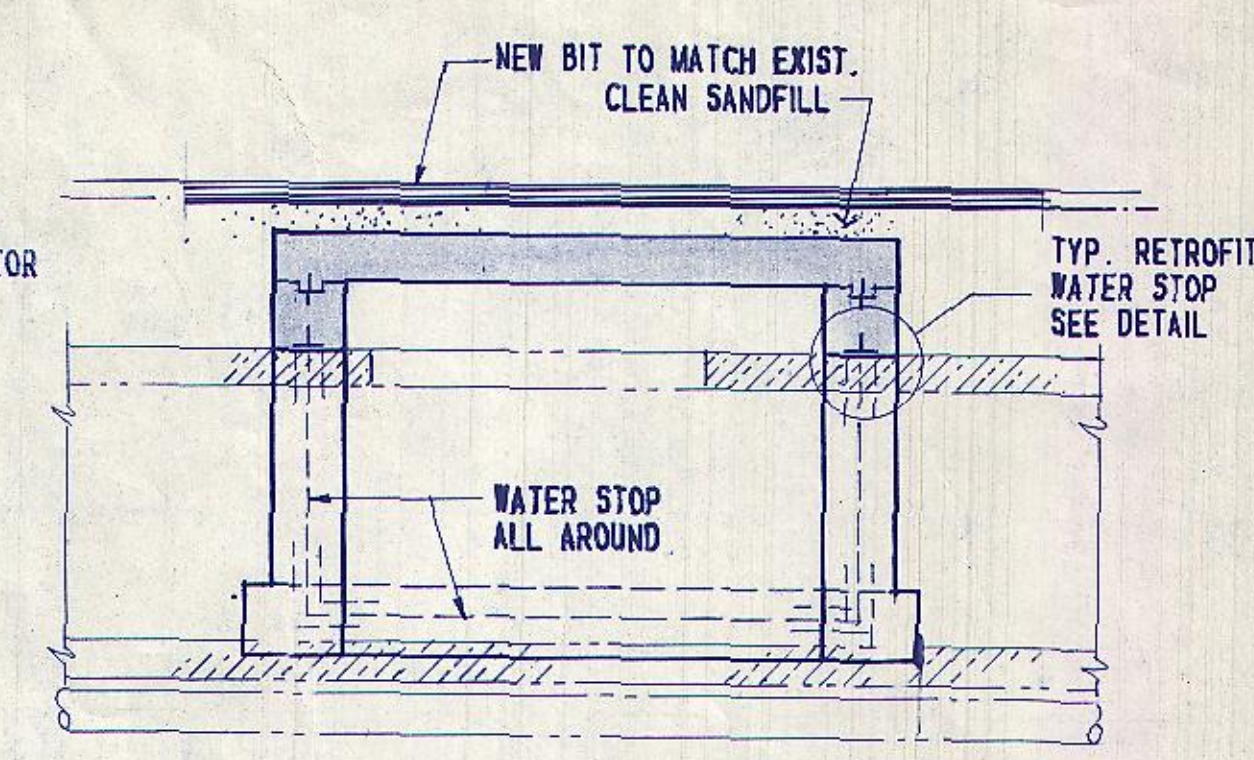


SECTION 1
SCALE: 1/4" = 1'-0"

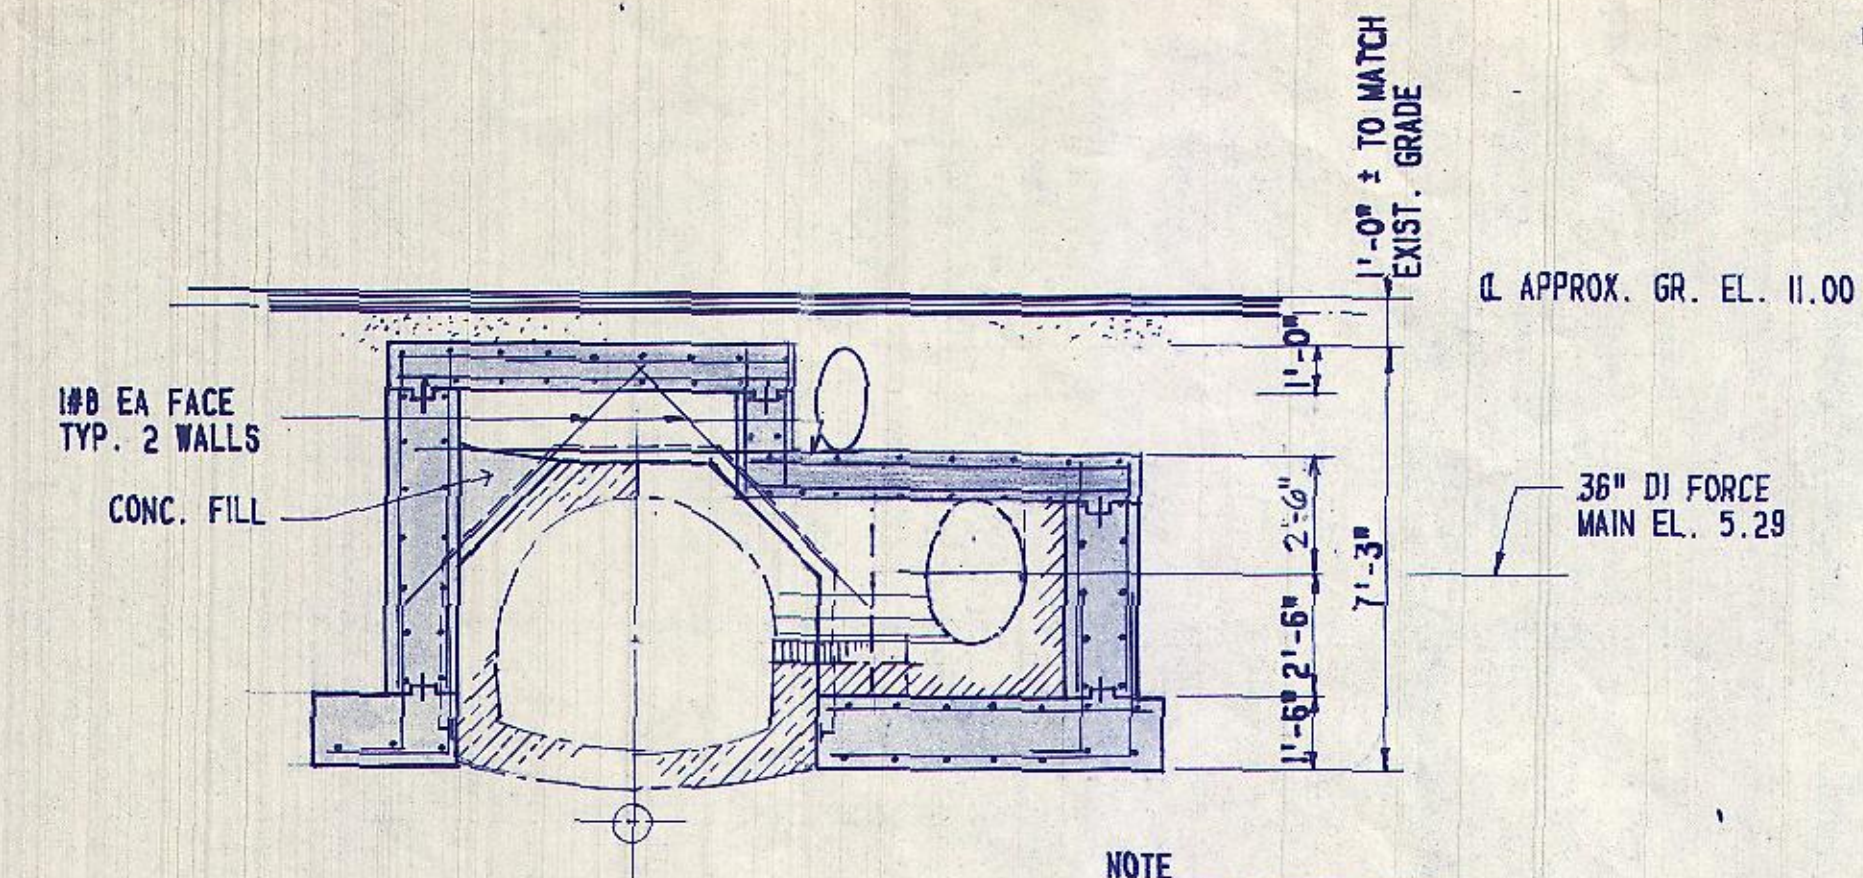

SECTION 2
SCALE: 1/4" = 1'-0"

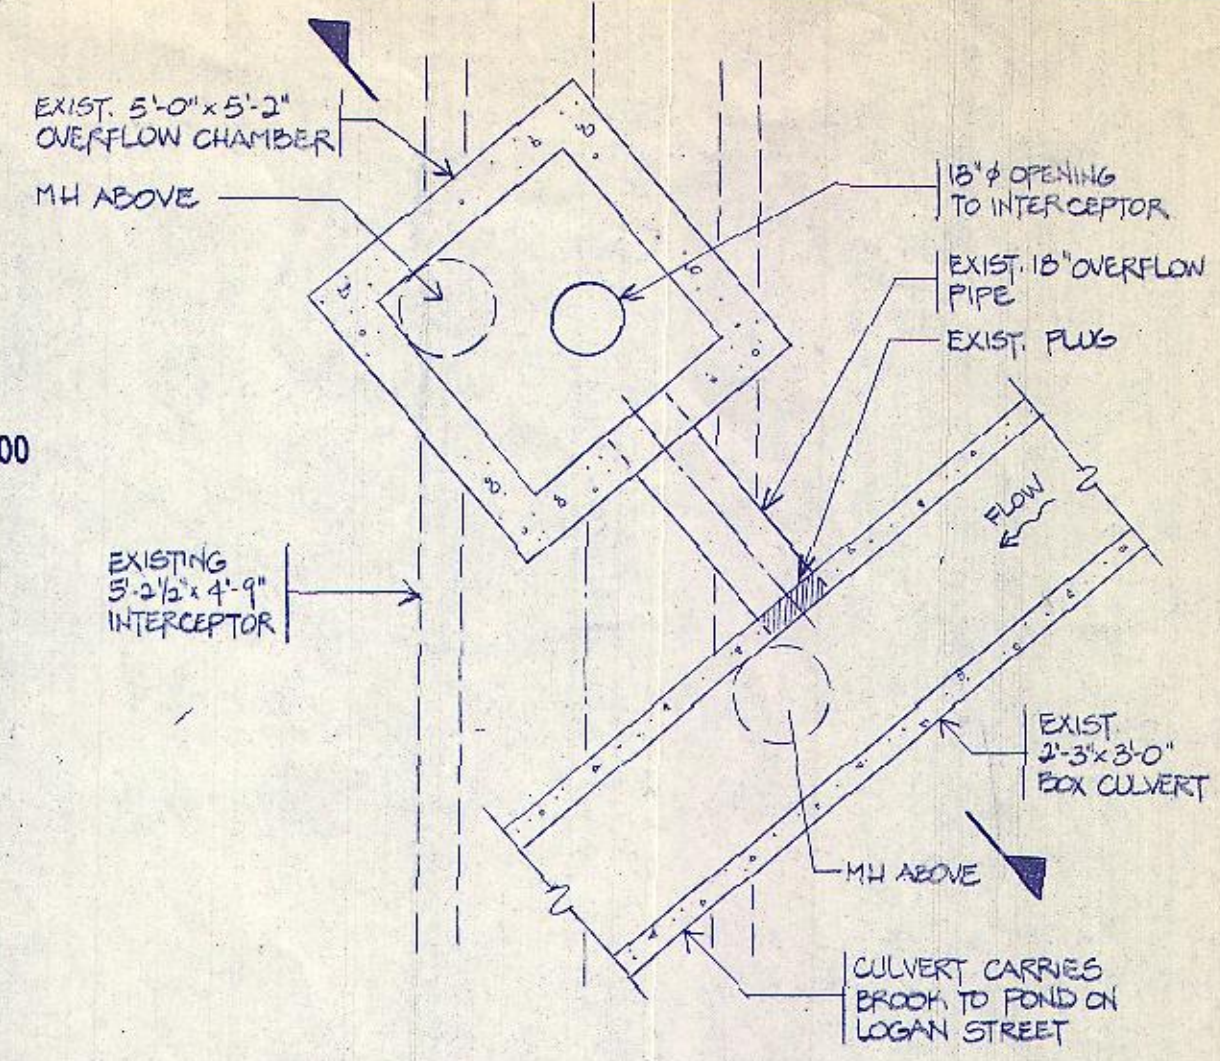


PLAN

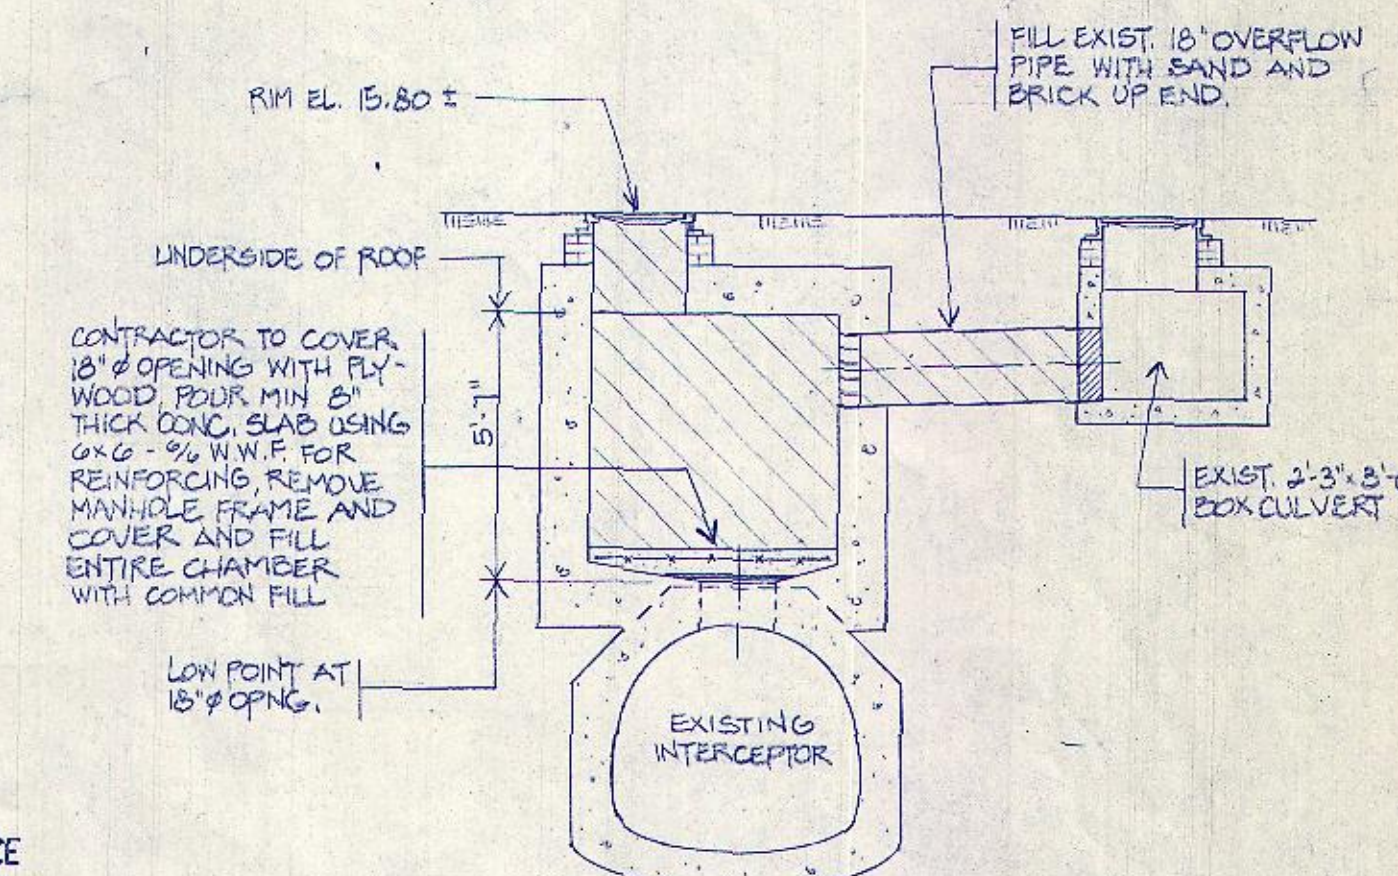


SECTION

LOGAN STREET OVERFLOW CHAMBER
SCALE: 1/4" = 1'-0"

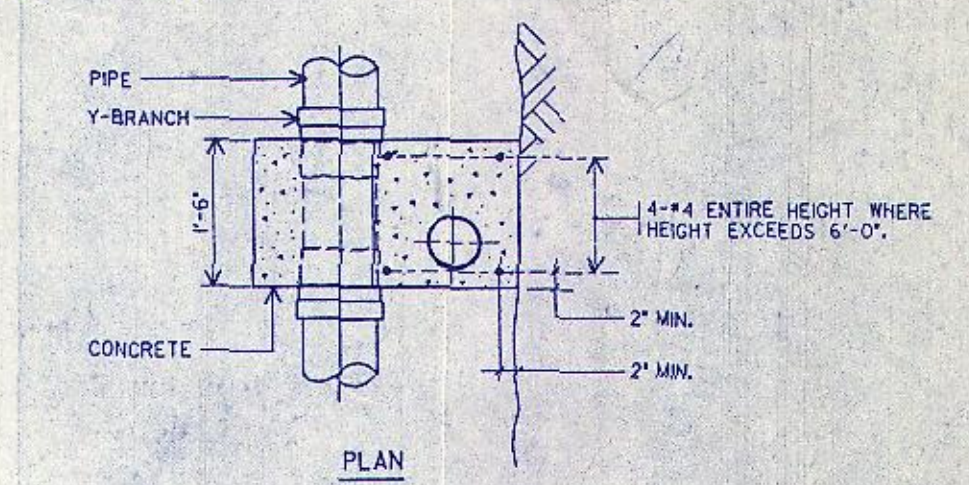


PLAN

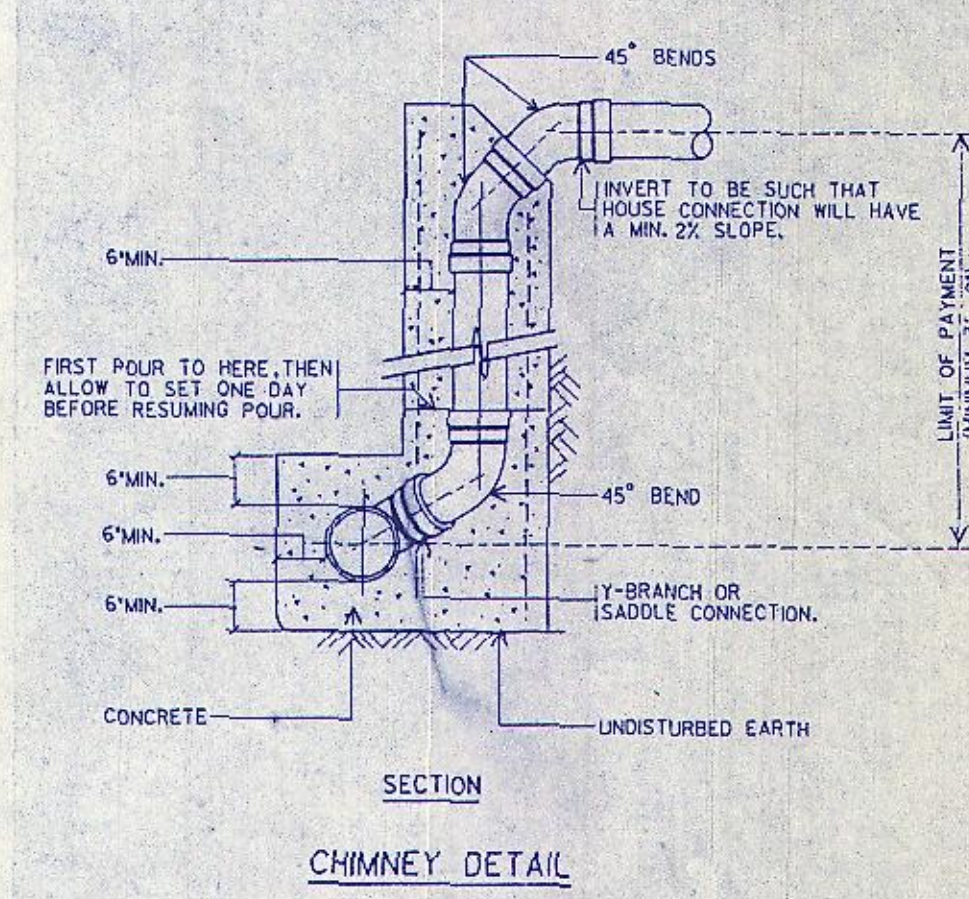


SECTION


CHIMNEY DETAIL

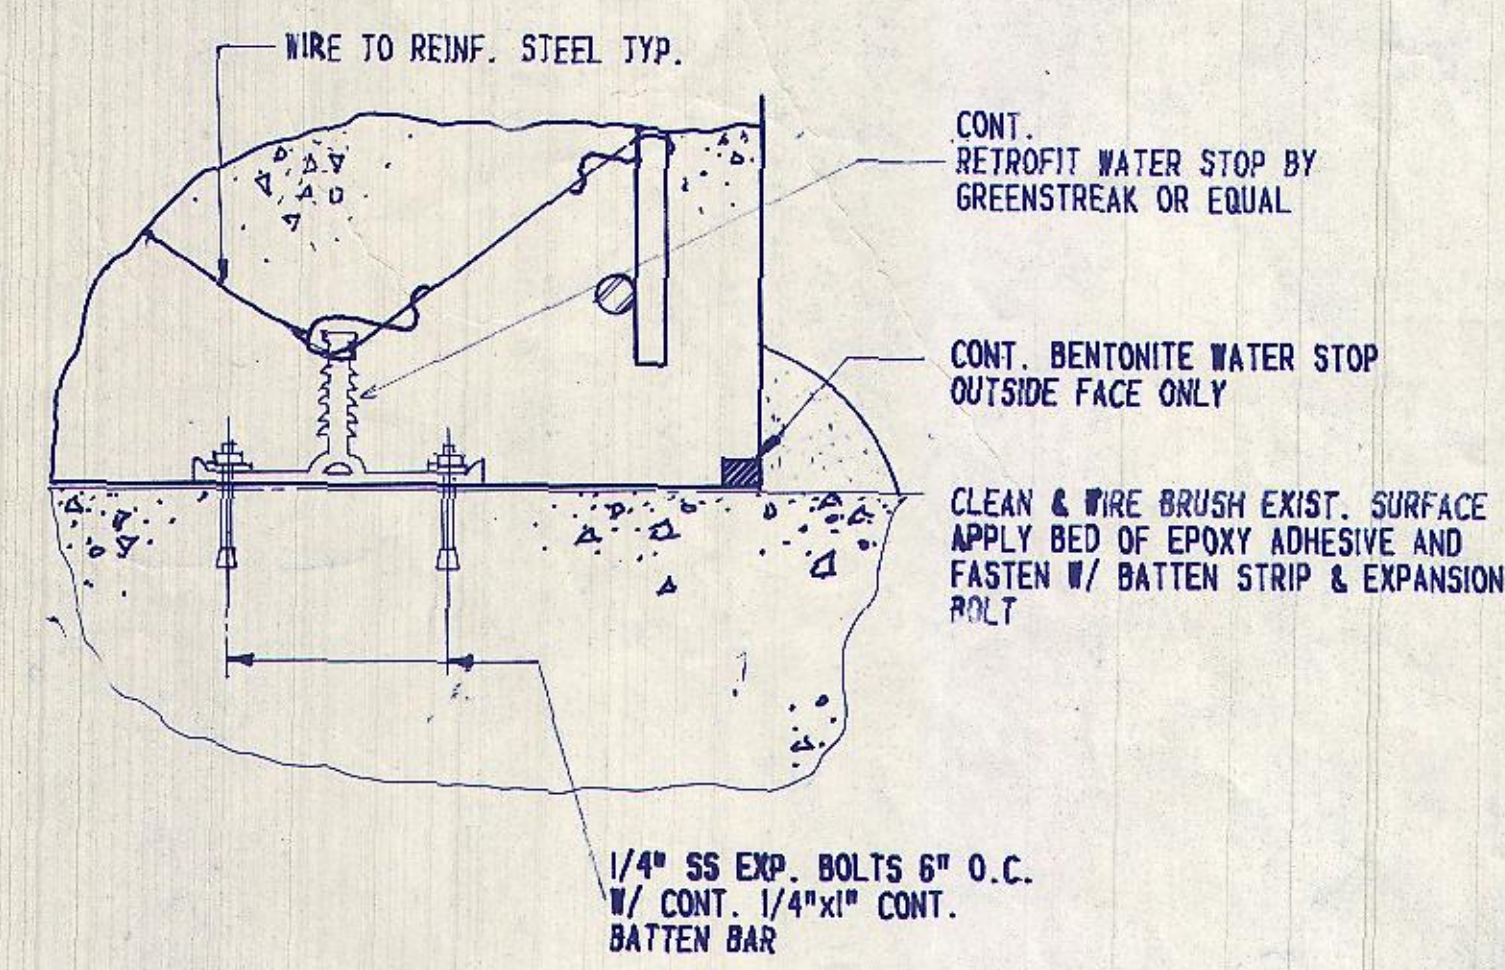


TYP. RETROFIT WATER STOP DETAIL

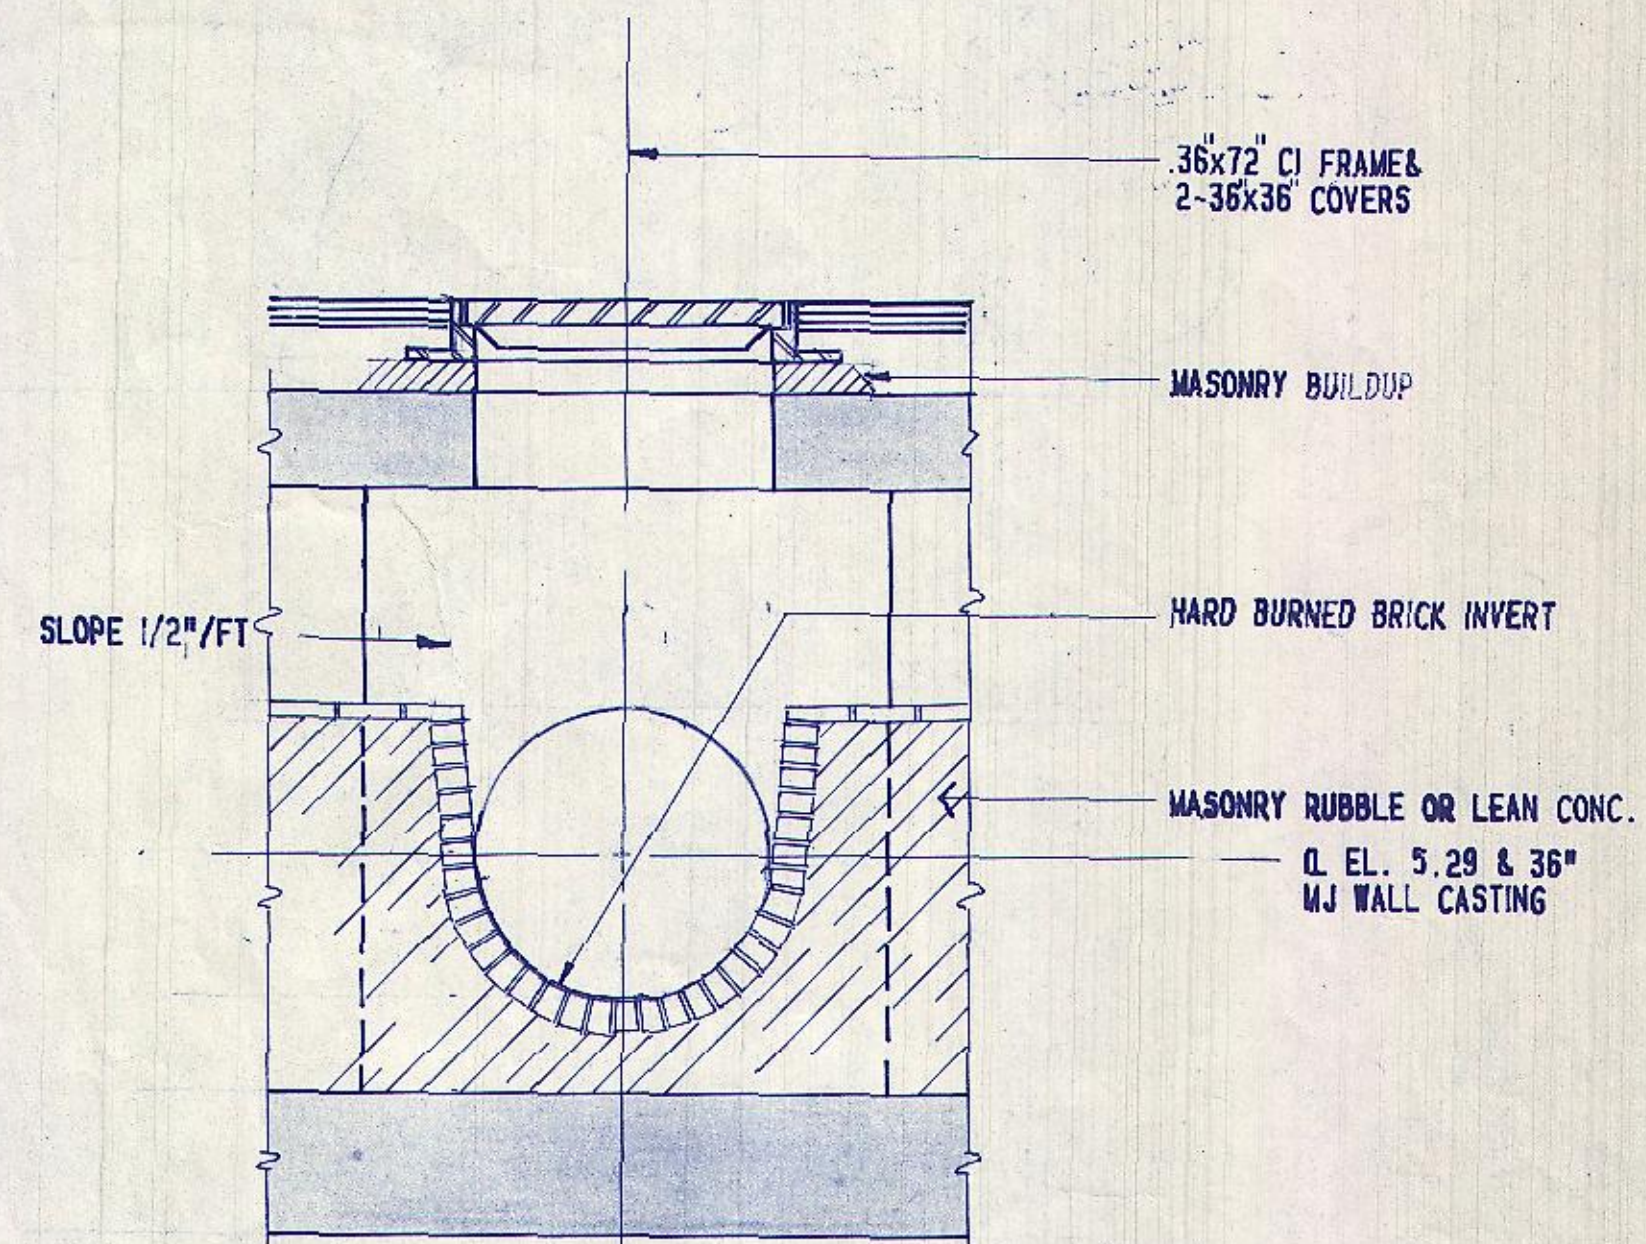


SECTION 3
SCALE: 1/2" = 1'-0"

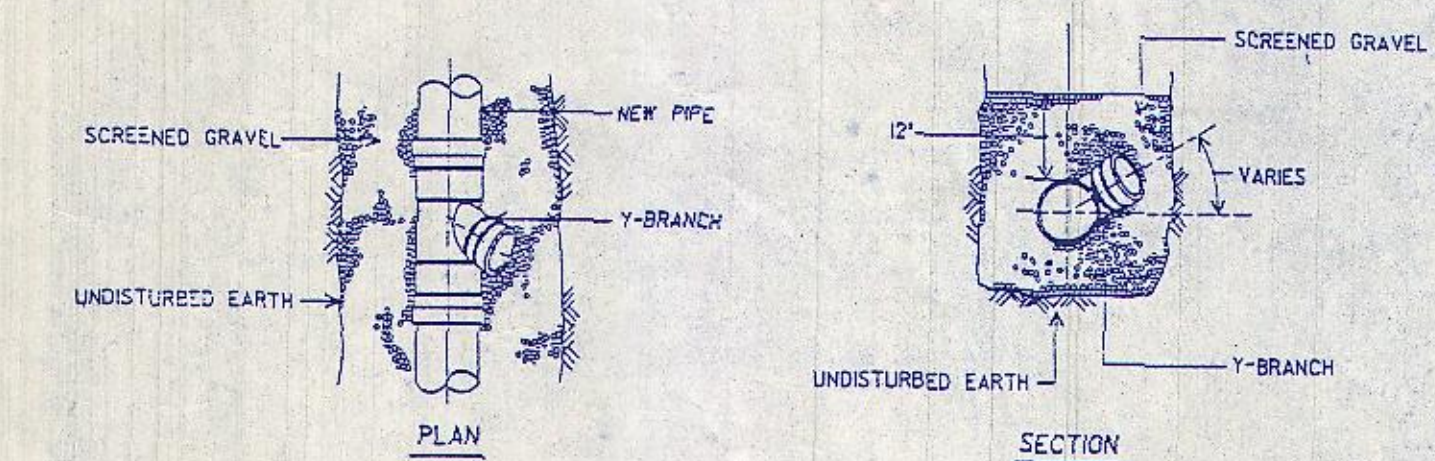


P.V.C. Y-BRANCH

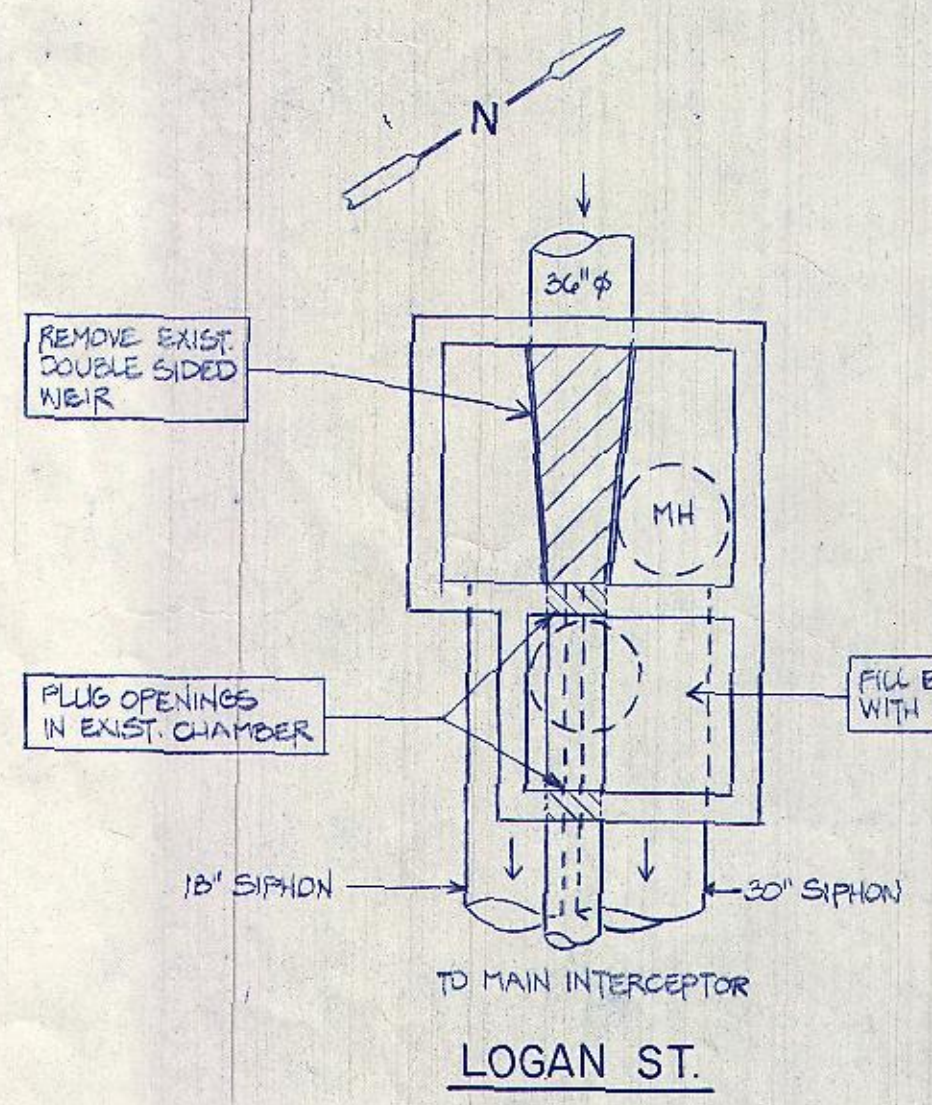


LOGAN ST.

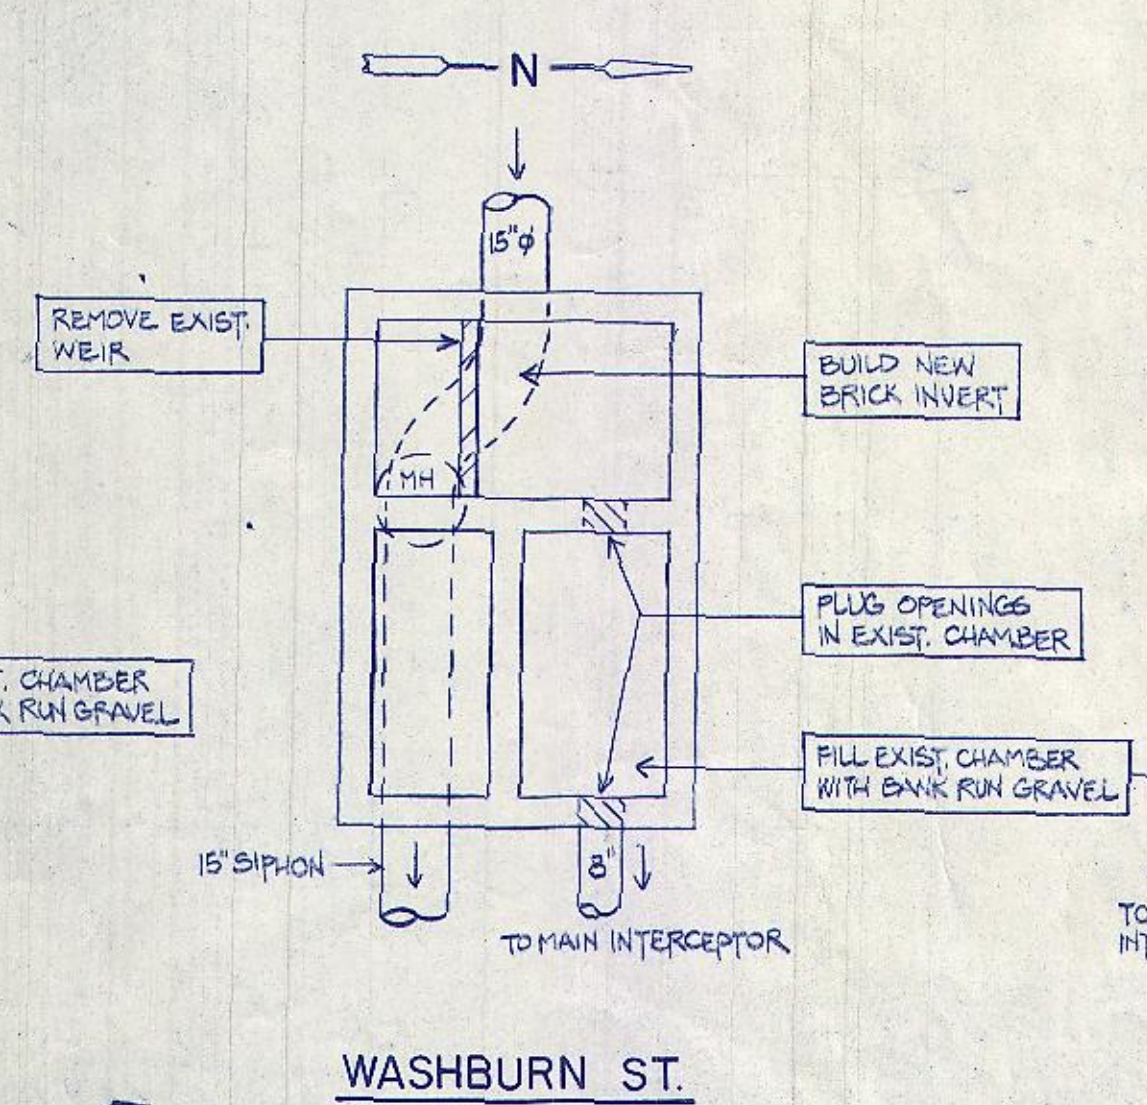

WASHBURN ST.

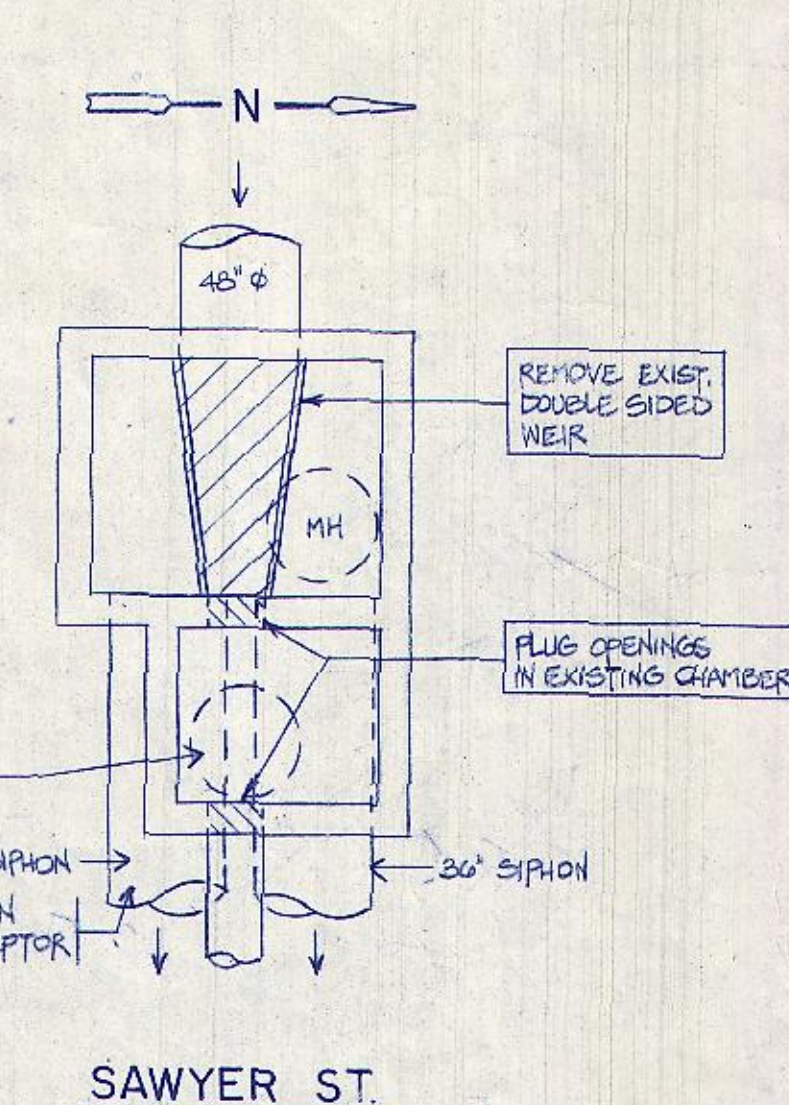

SAWYER ST.

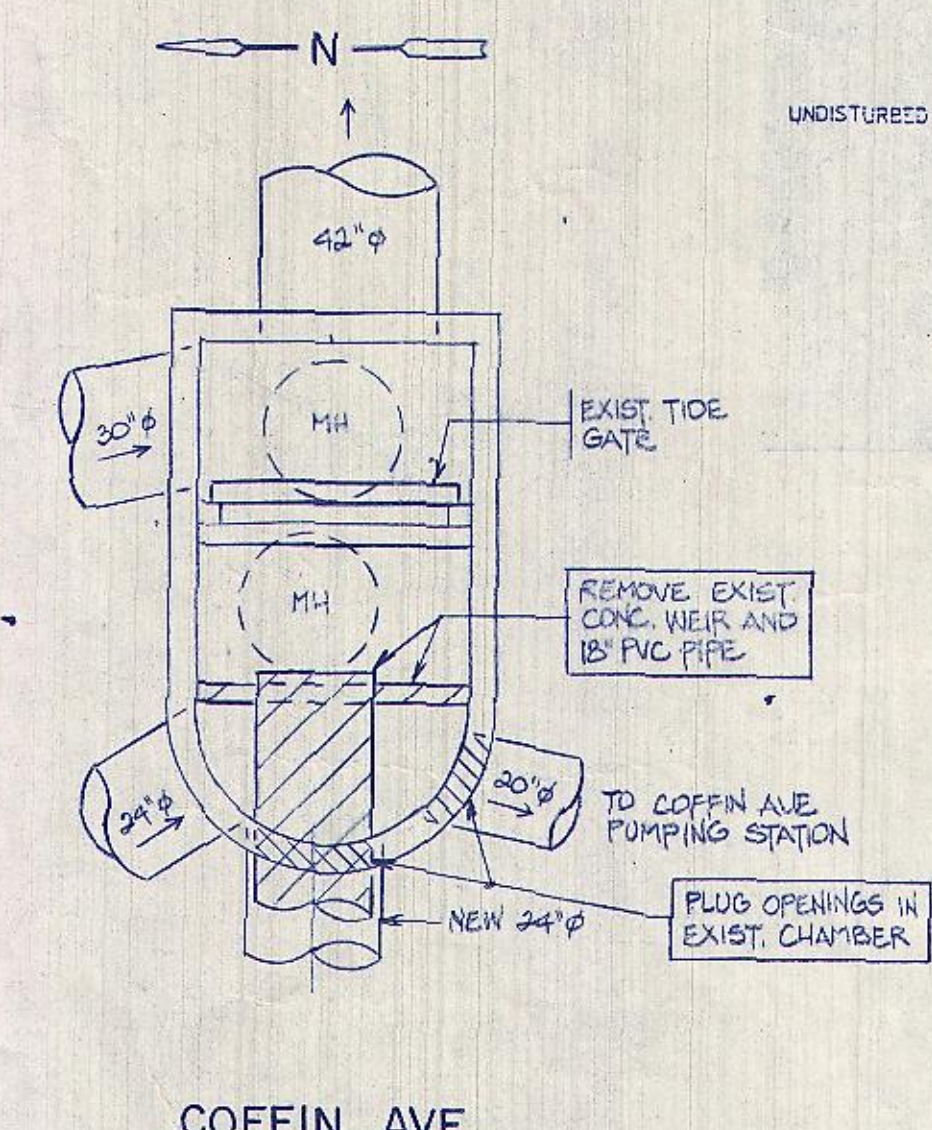

COFFIN AVE.

CONNECTION STRUCTURE MODIFICATIONS
NTS

RECORD DRAWING

Date	Ch'k'd.	Revision
Designed by: <u>RV</u>		
Drawn by: <u>DS</u>		
Checked by: <u>RV</u>		
Approved by: <u>S.J.H.</u>		

CITY OF NEW BEDFORD, MASSACHUSETTS
BELLEVILLE AVENUE FORCE MAIN EXTENSION

CONTRACT NO. 5

CONNECTION STRUCTURE STA. 87+00 AND DETAILS

CAMP DRESSER & MCKEE INC.
Ten Cambridge Center
Cambridge, Massachusetts 02142

CDM
Environmental engineers, scientists, planners, & management consultants

SHEET NO. 16
309-47815