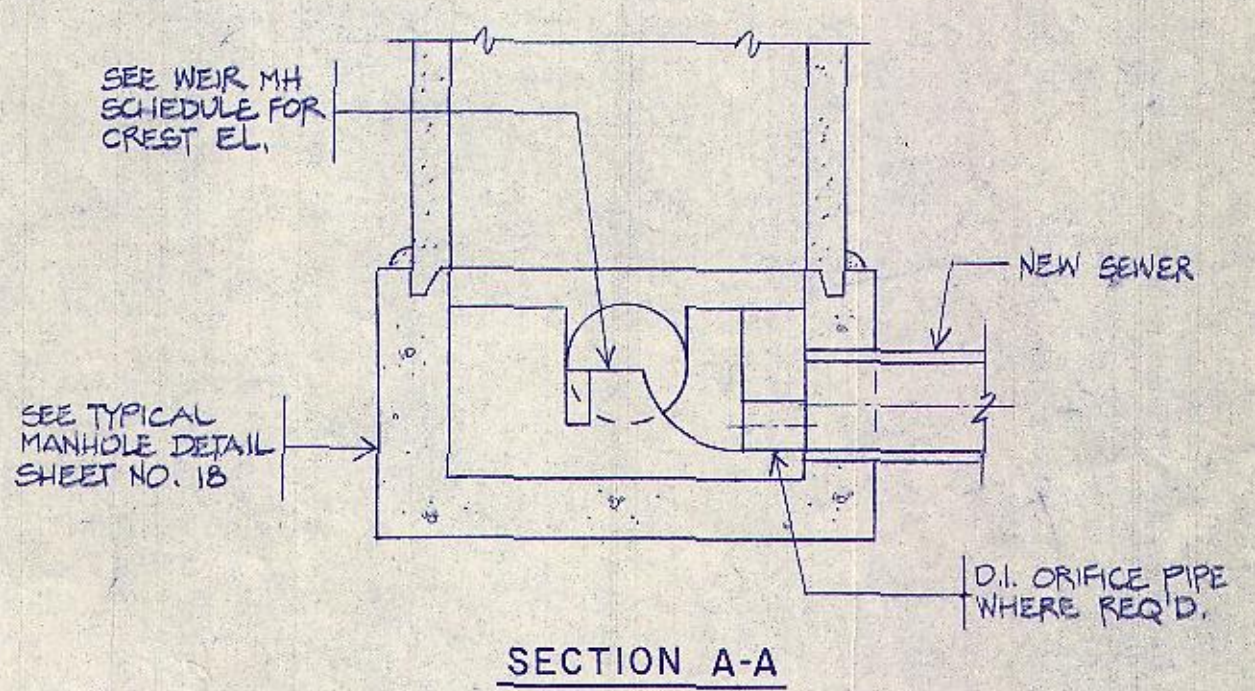
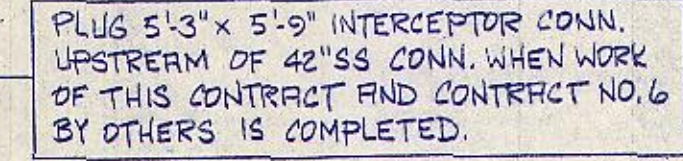
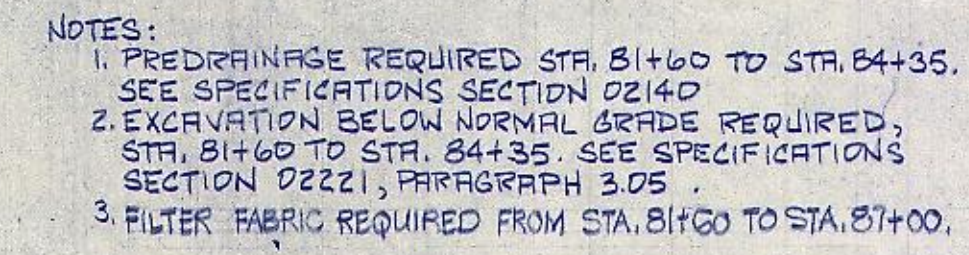
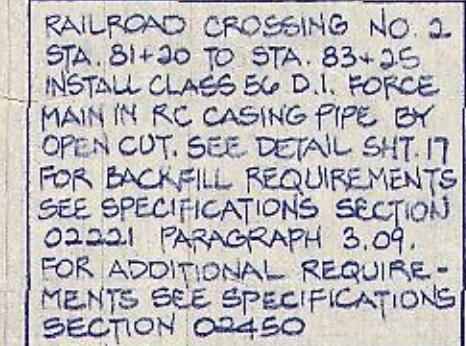


WEIR MANHOLE SCHEDULE

RECORD DRAWING

CITY OF NEW BEDFORD, MASSACHUSETTS
BELLEVILLE AVENUE FORCE MAIN EXTENSION

CONTRACT NO. 5

RAILROAD YARD AND
ACUSHNET AVENUE

CAMP DRESSER & McKEE INC.

Ten Cambridge Center
Cambridge, Massachusetts 0214

CDM
Environmental engineers, scientists,
architects, & management consultants

SHEET NO.

8

309-47807

