
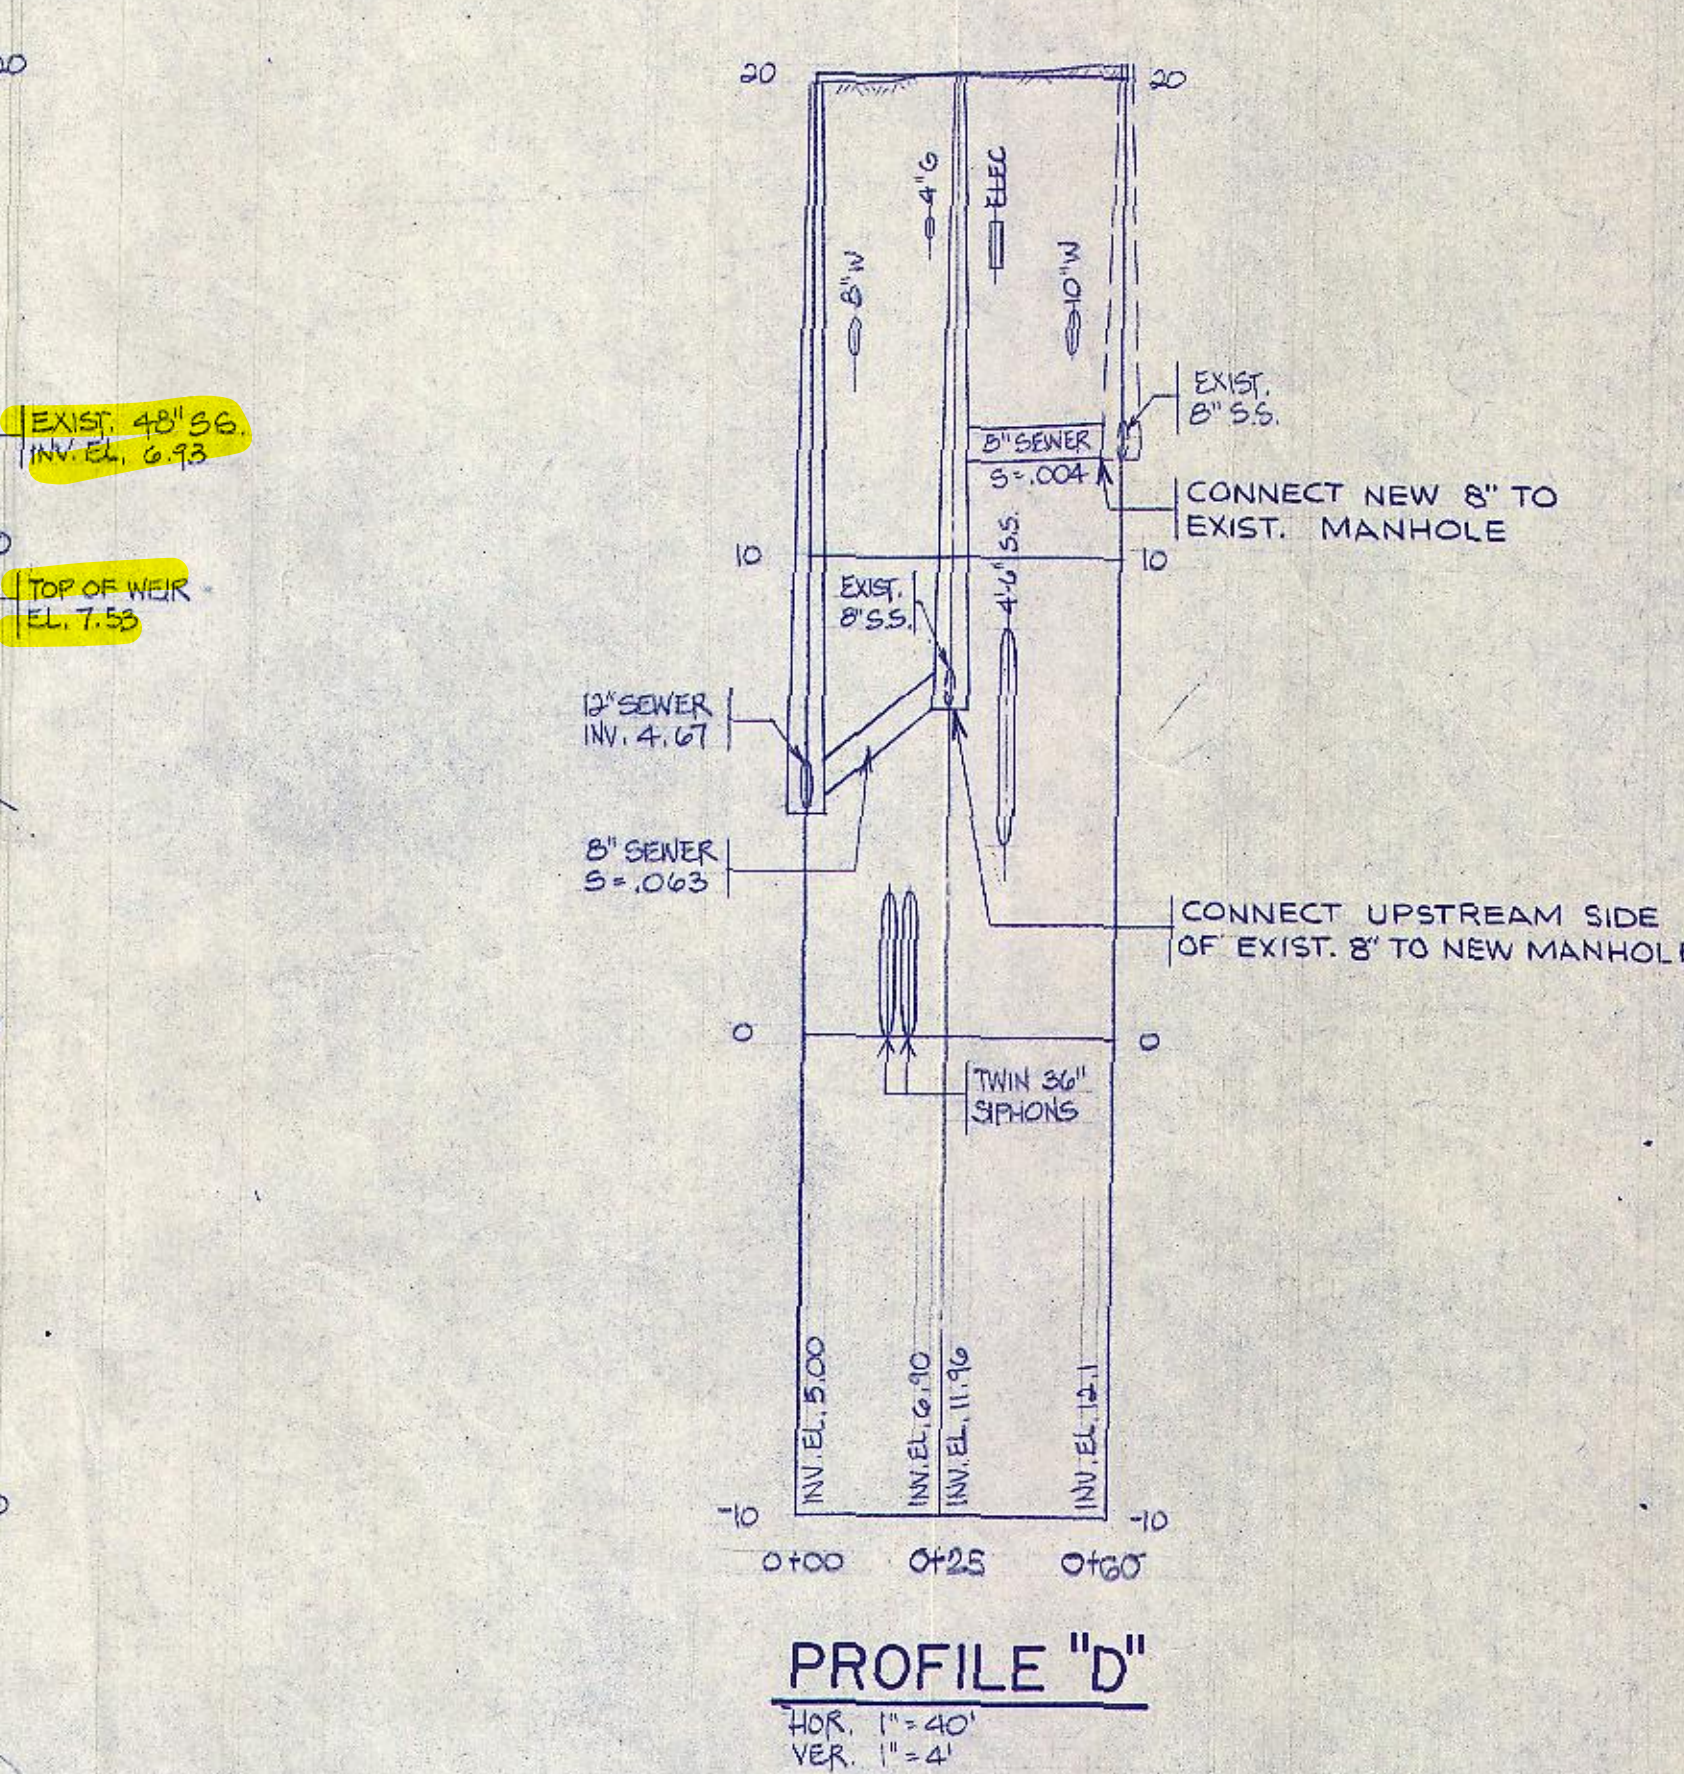
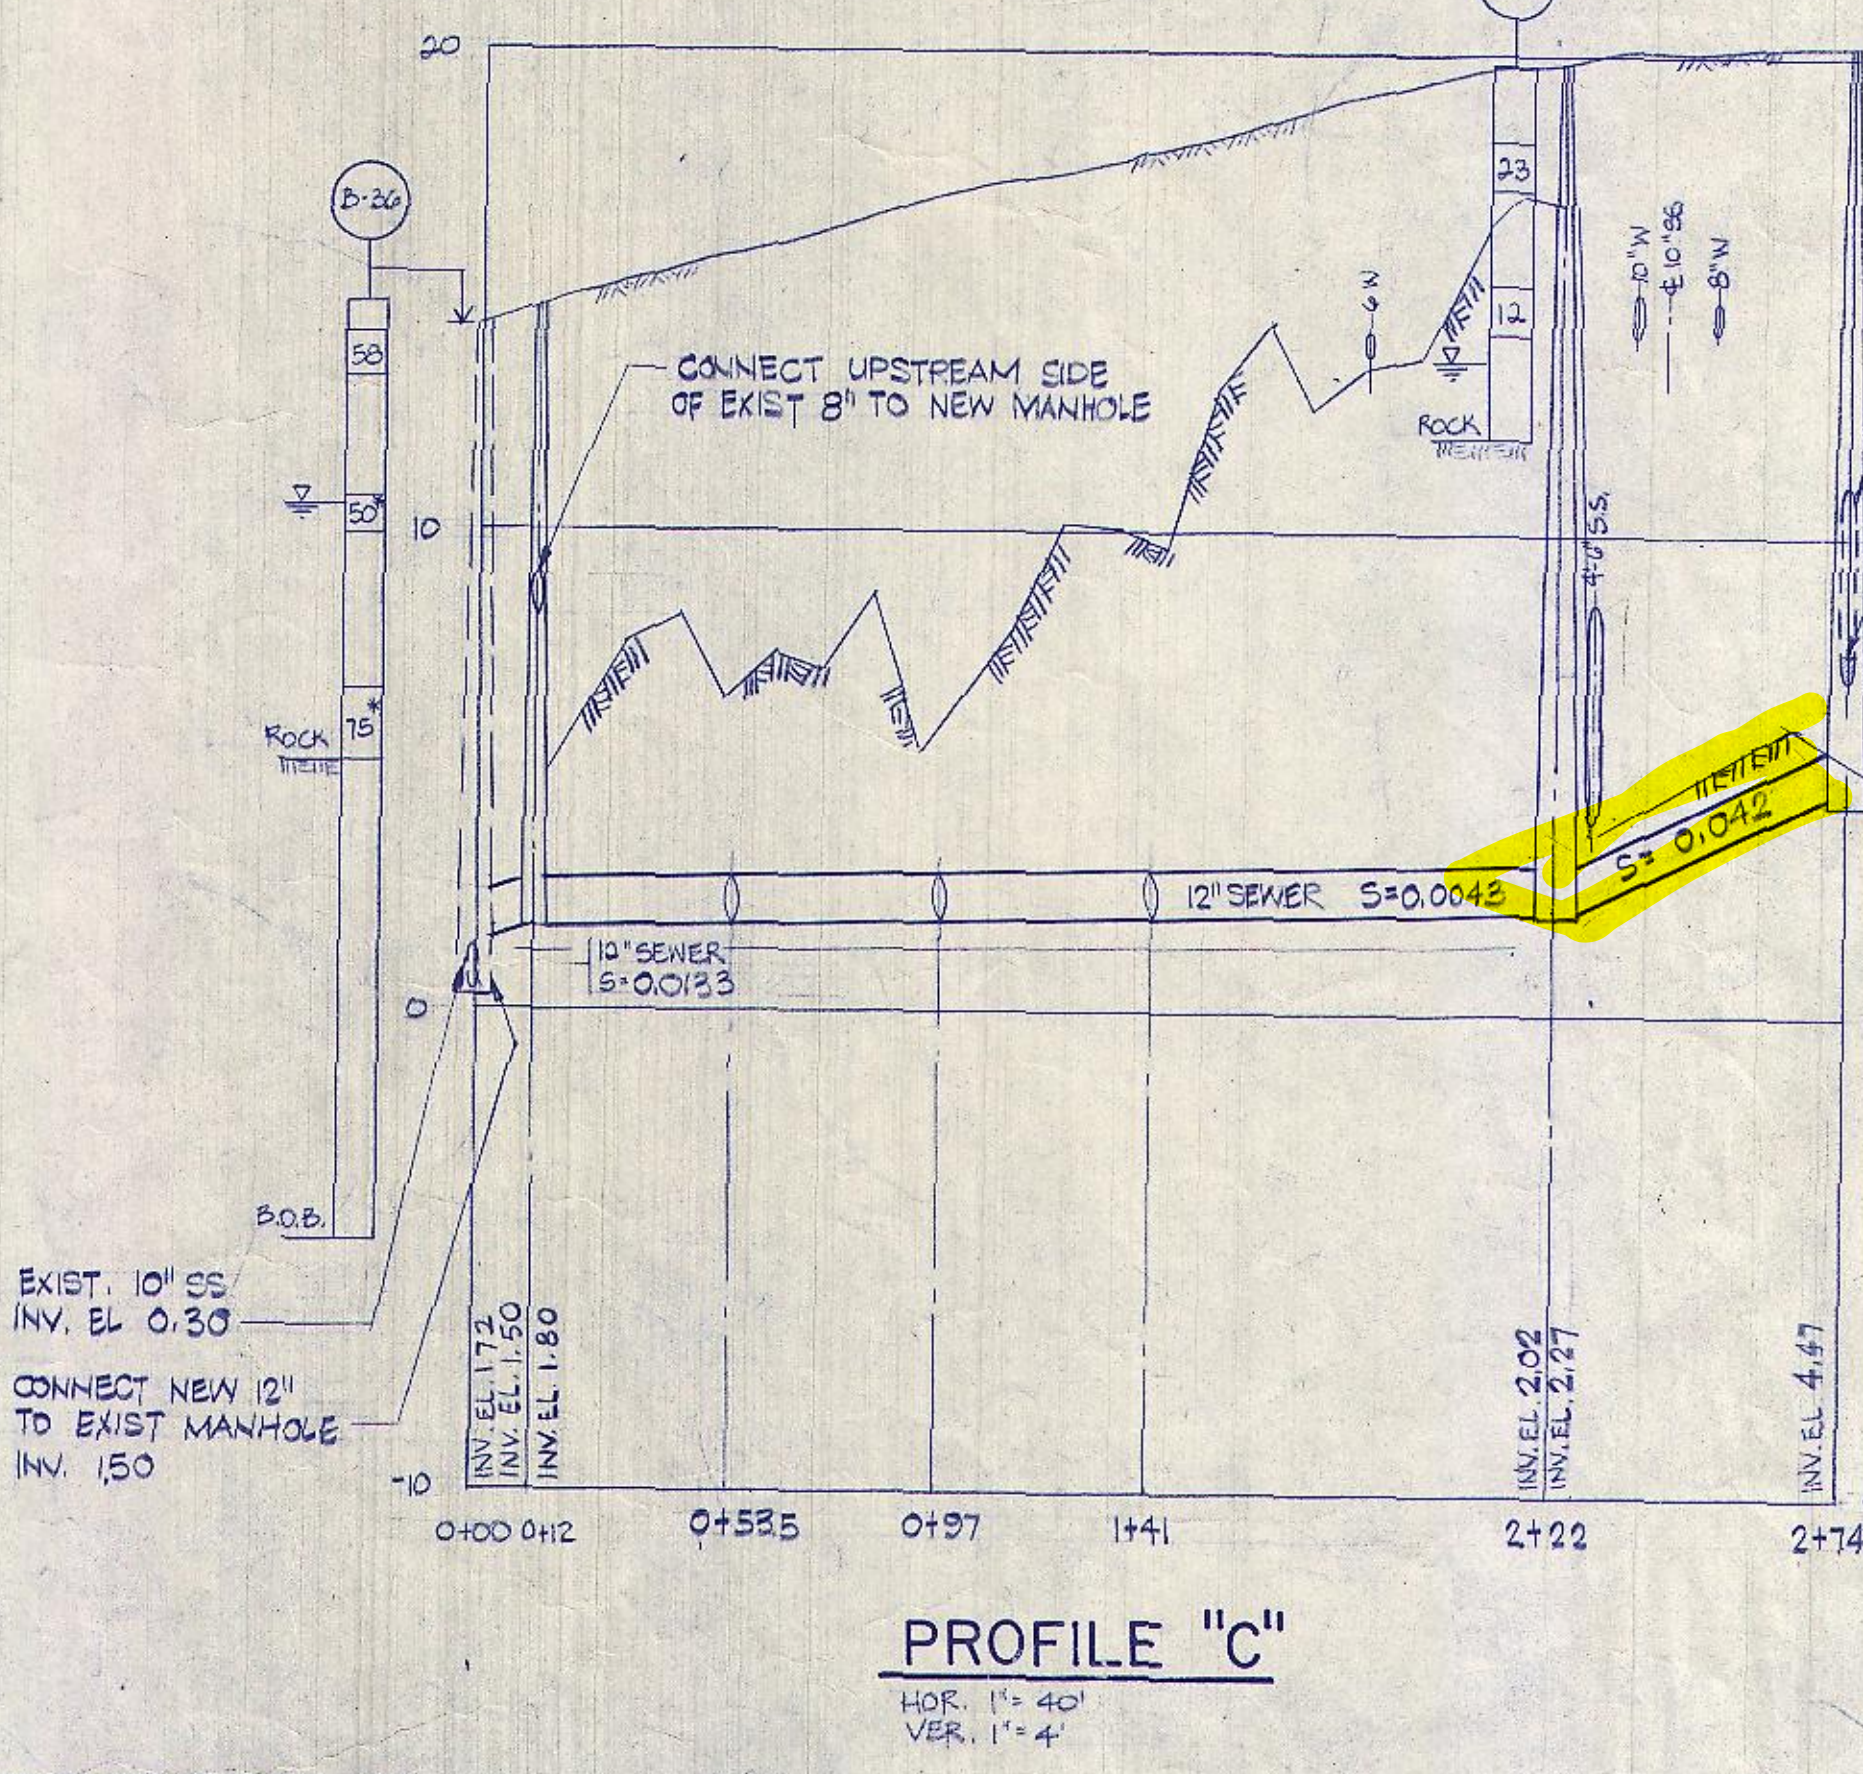
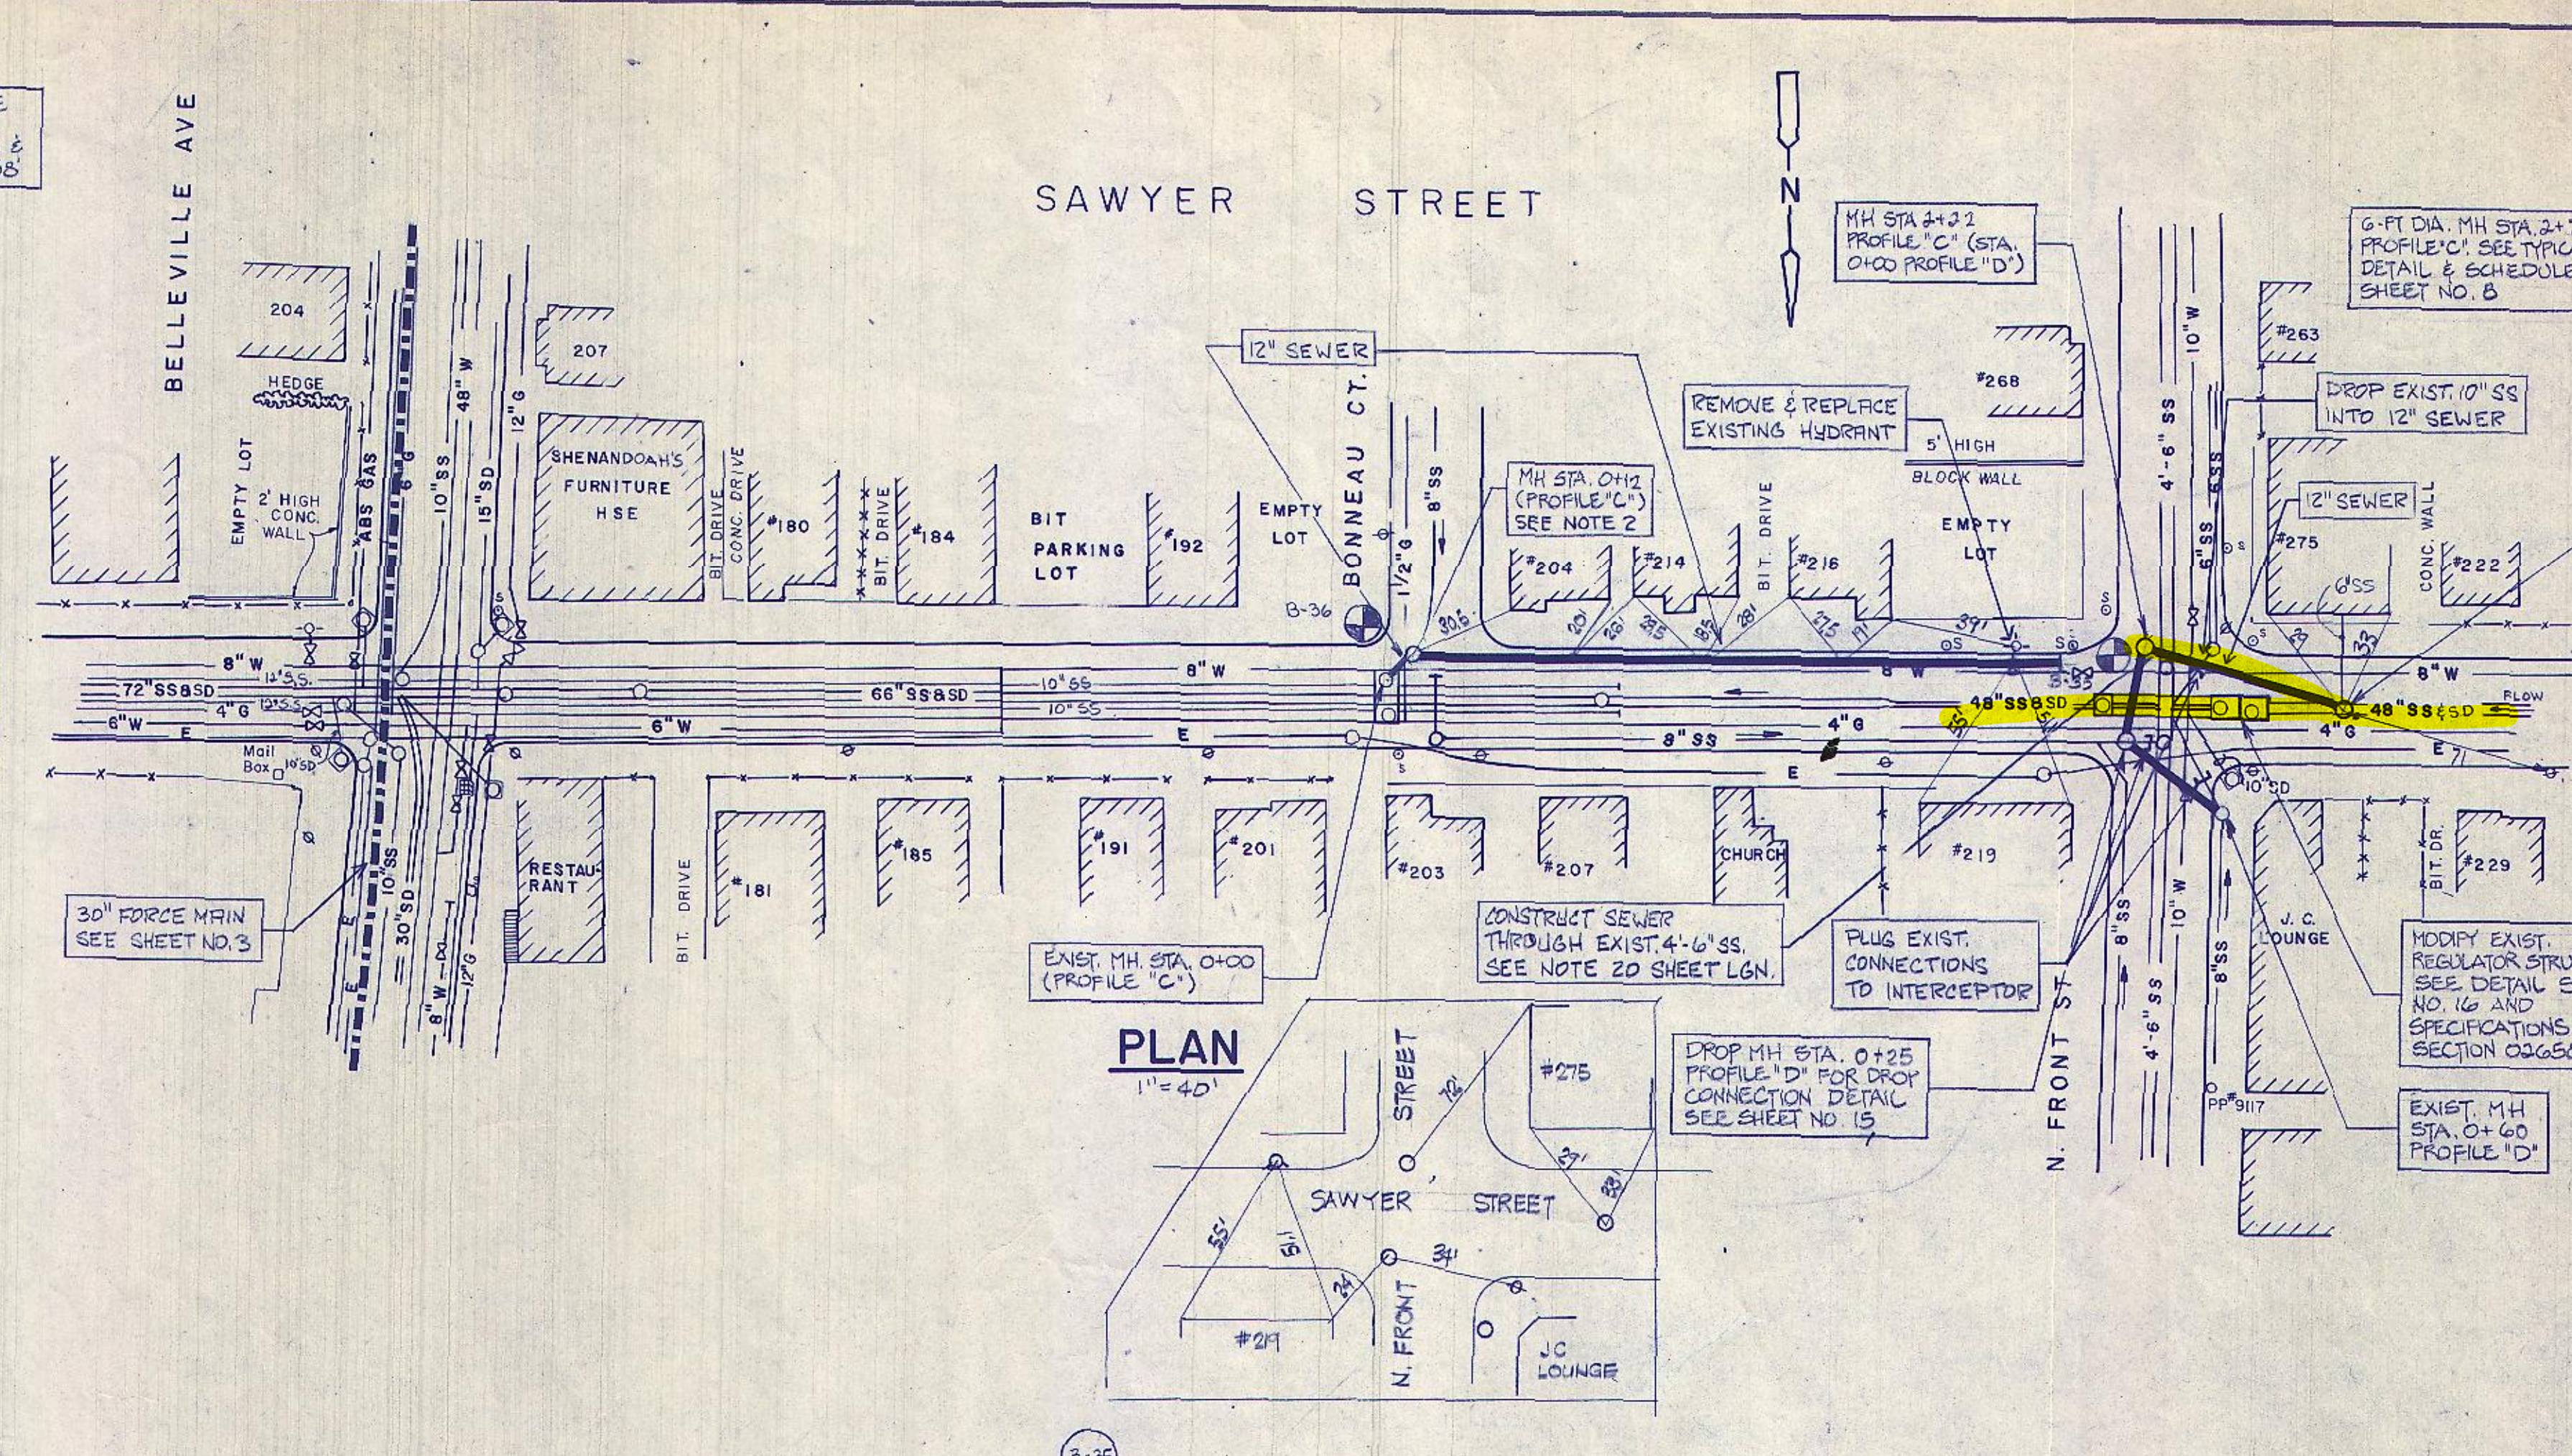
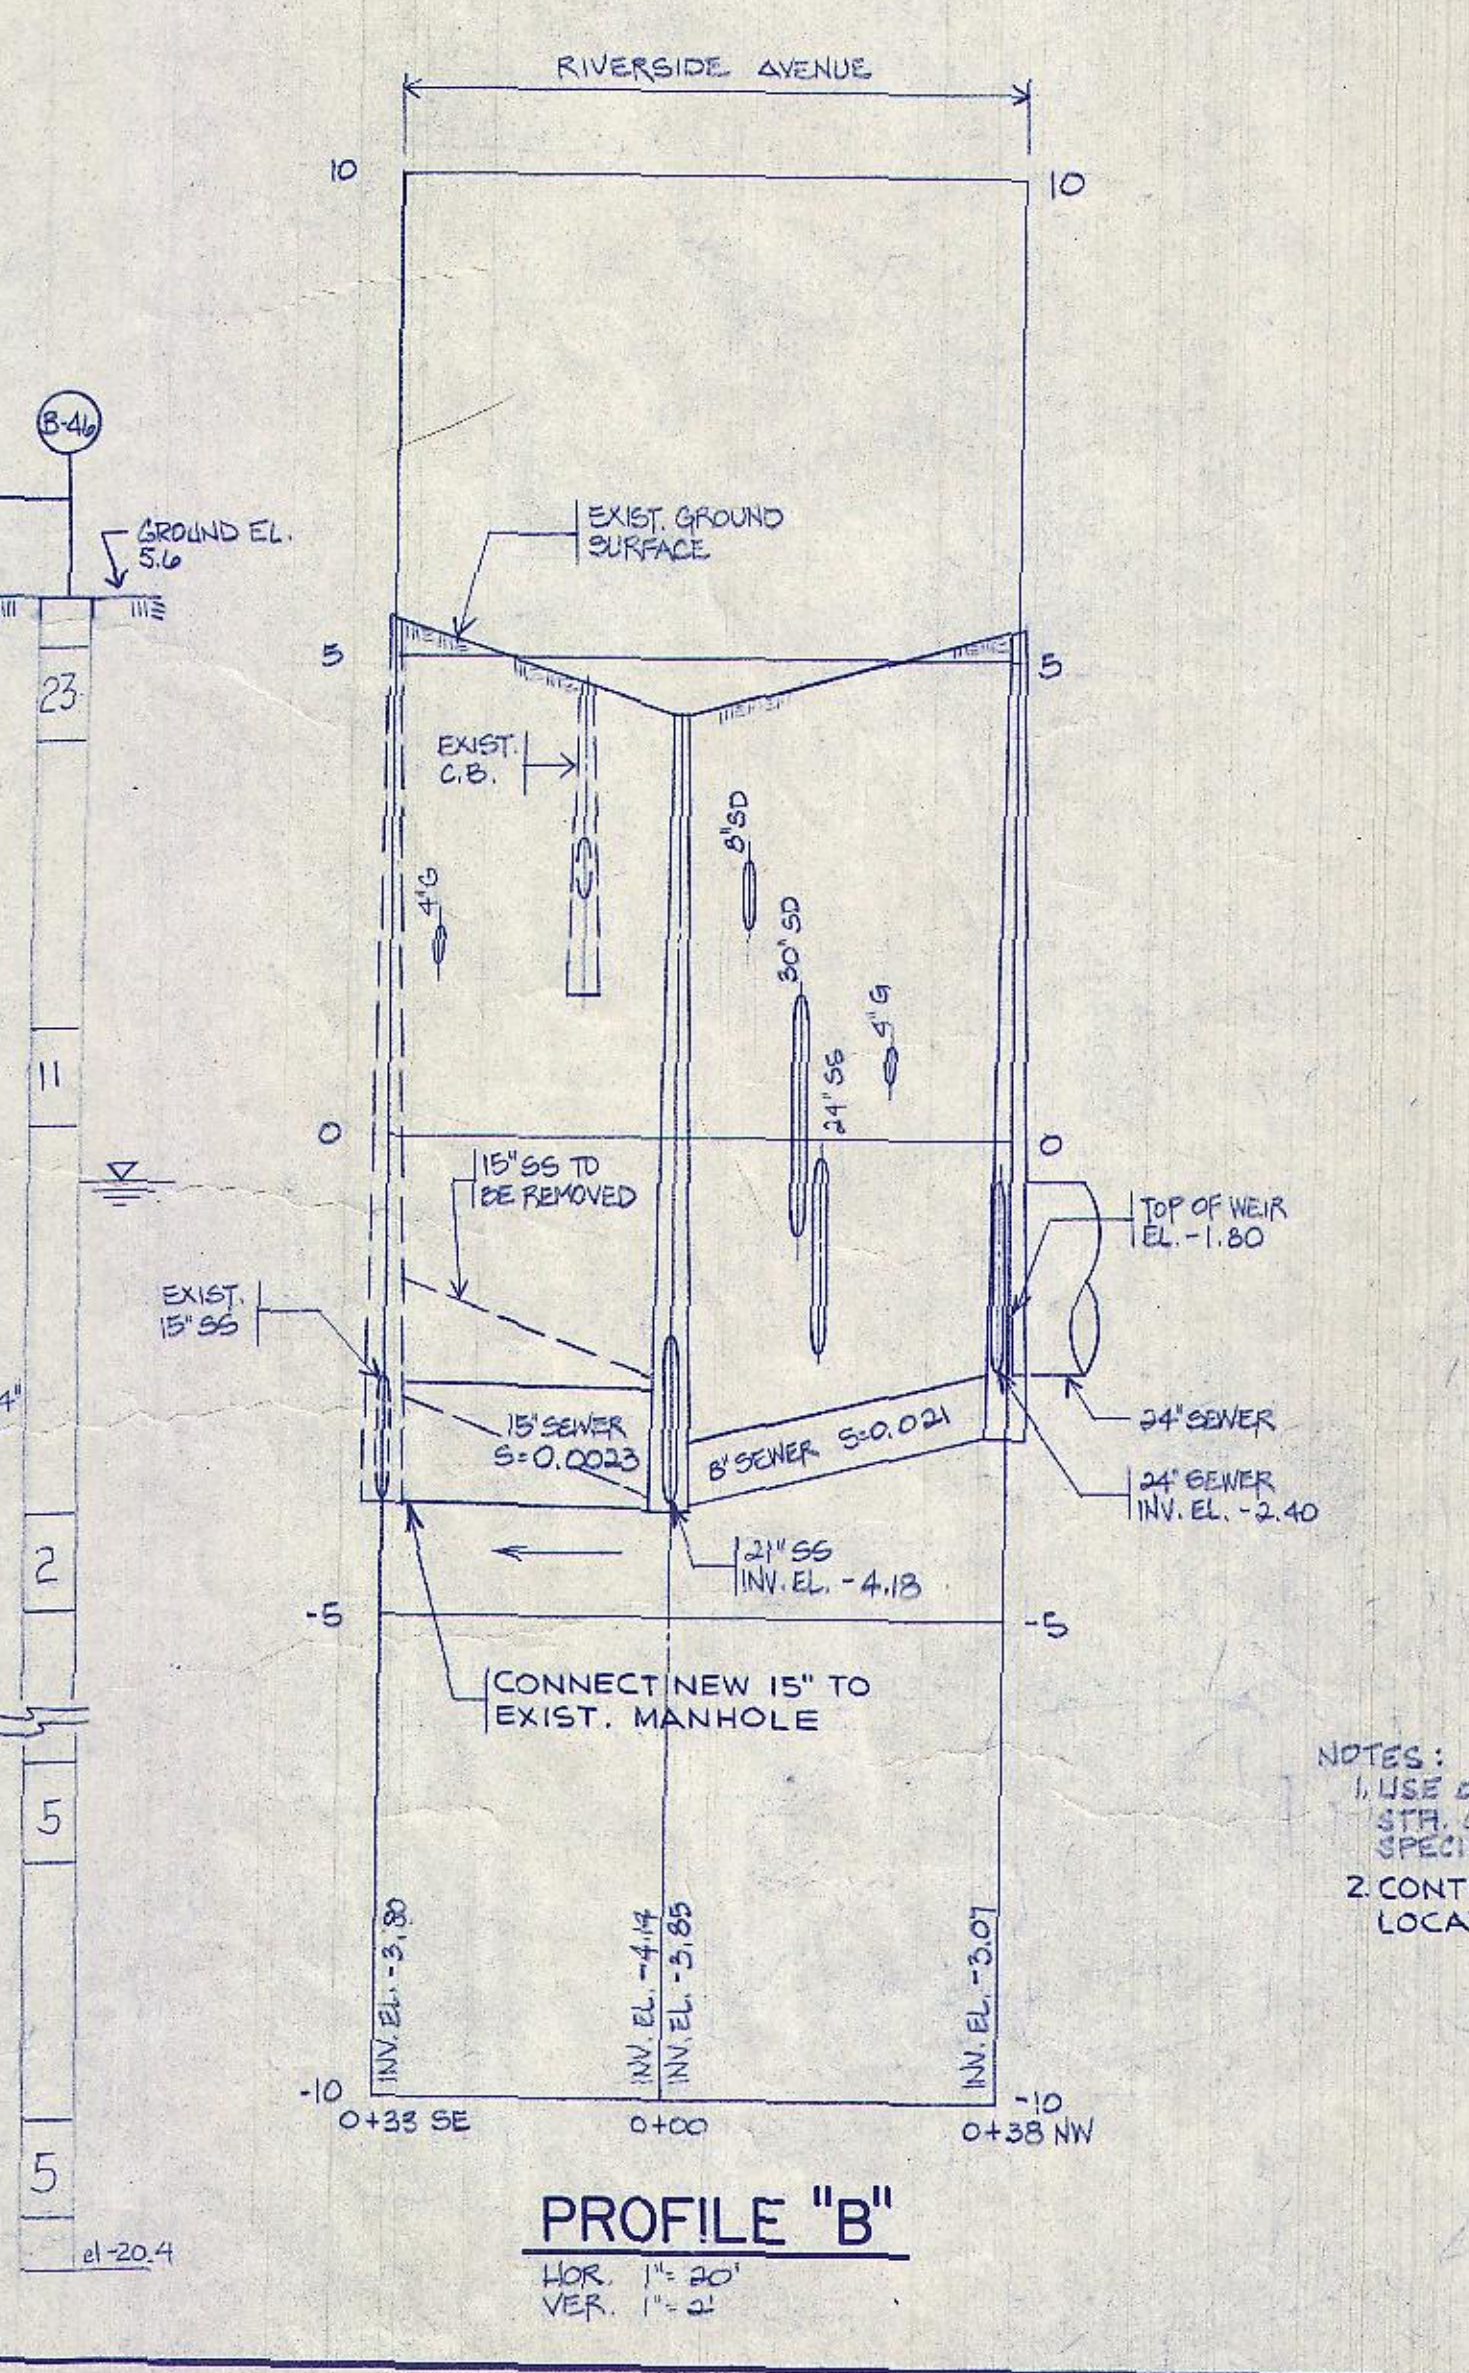
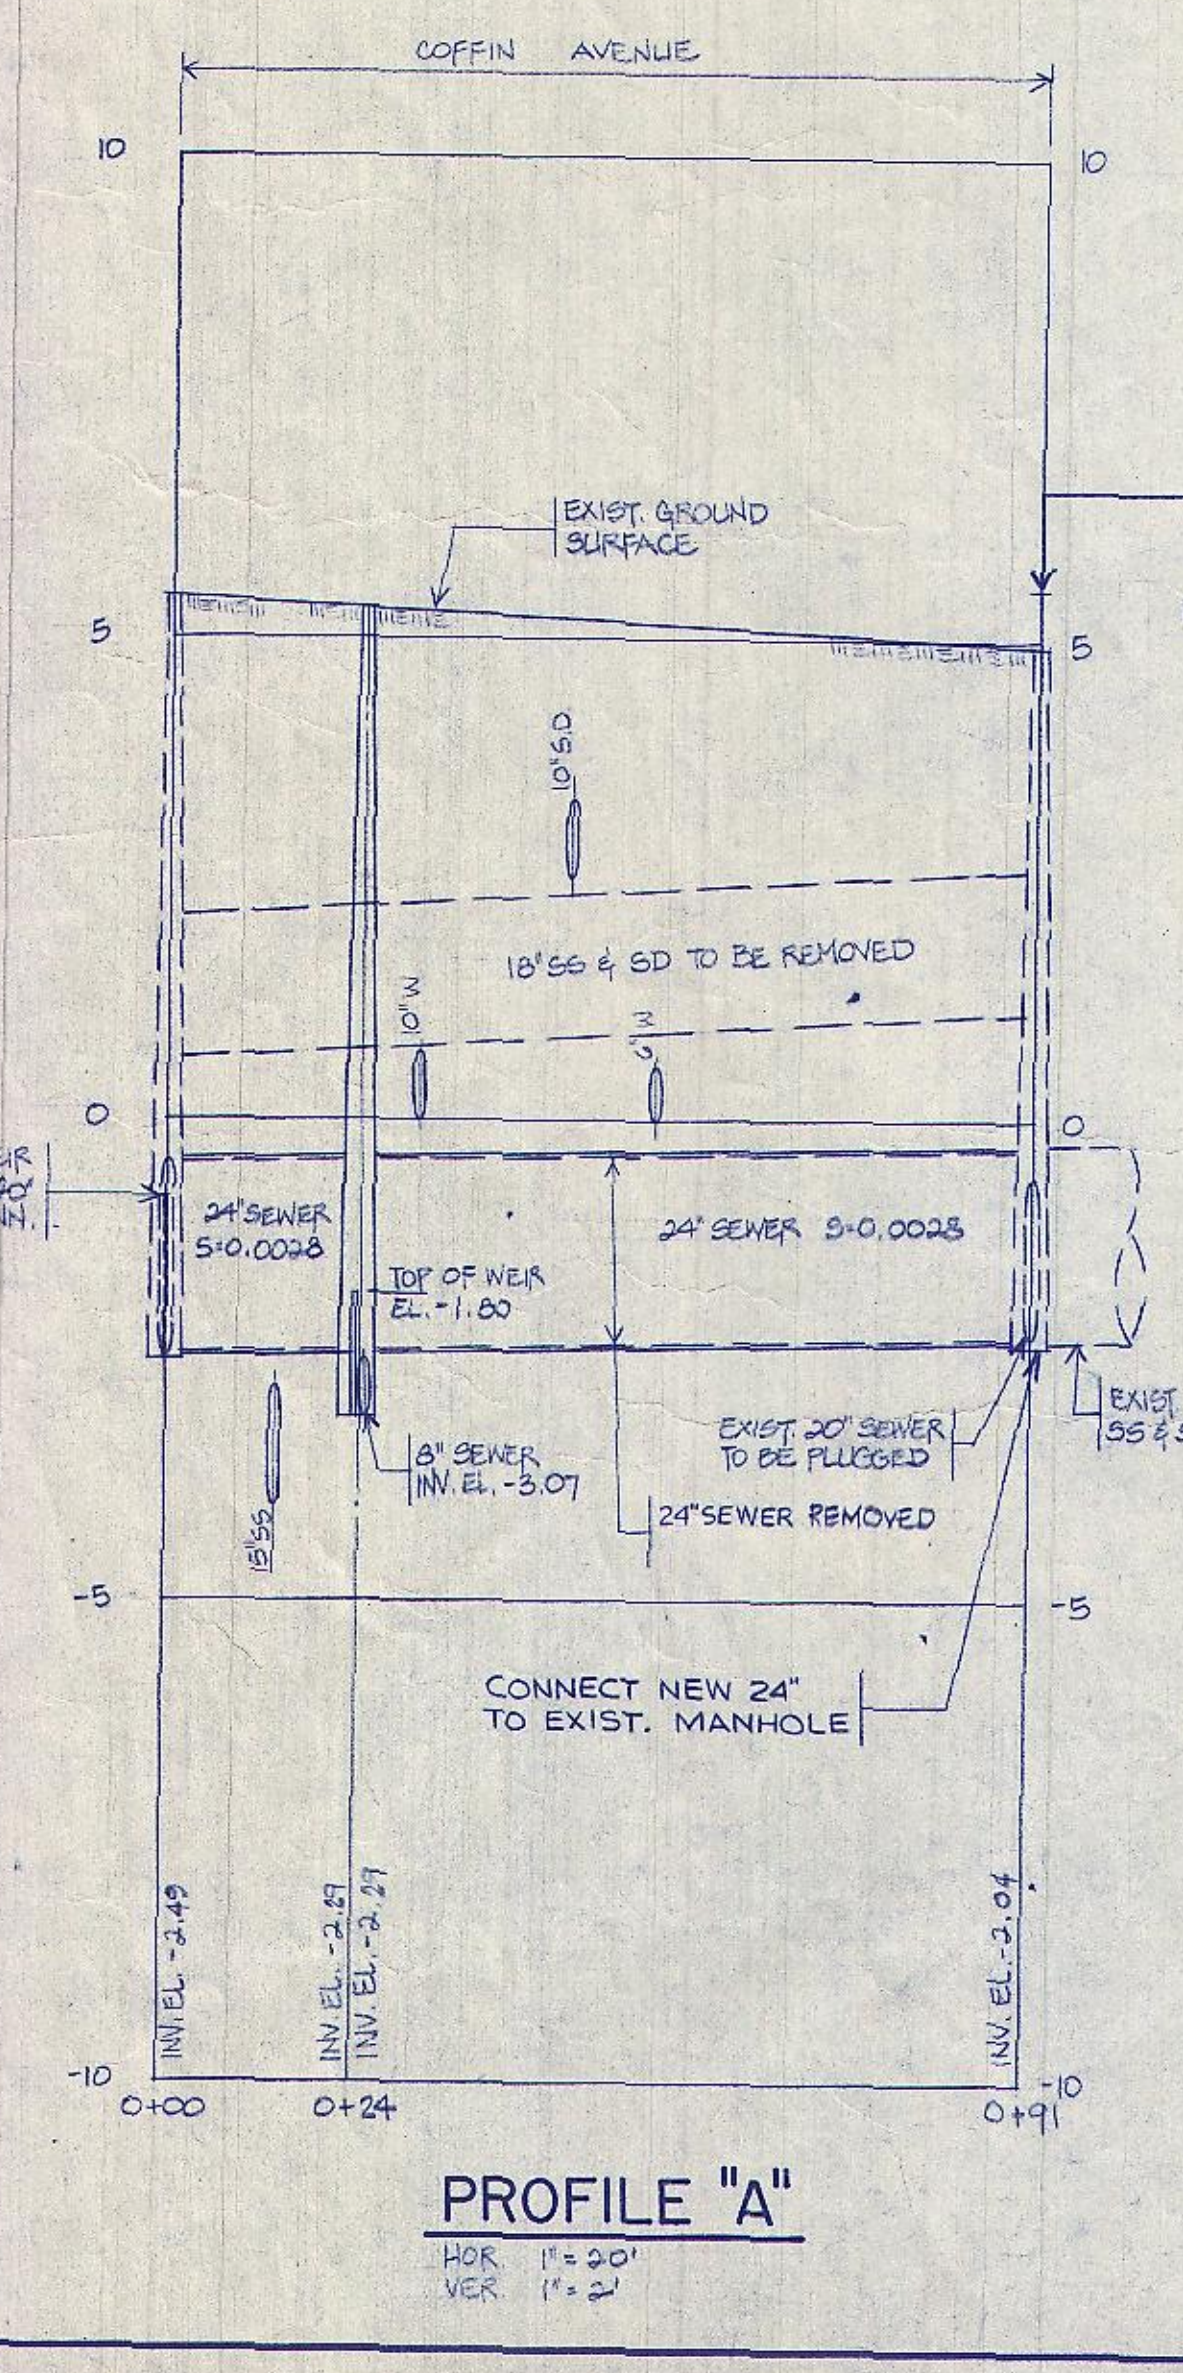


PROJECT MANAGER: Approved by: Date: 1/1/91
 PROJECT ENGINEER: Approved by: Date: 1/1/91
 PLUMBING: Approved by: Date: 1/1/91
 HVAC: Approved by: Date: 1/1/91
 INSTRUMENTATION: Approved by: Date: 1/1/91
 ELECTRICAL: Approved by: Date: 1/1/91
 STRUCTURAL: Approved by: Date: 1/1/91
 ARCHITECTURAL: Approved by: Date: 1/1/91

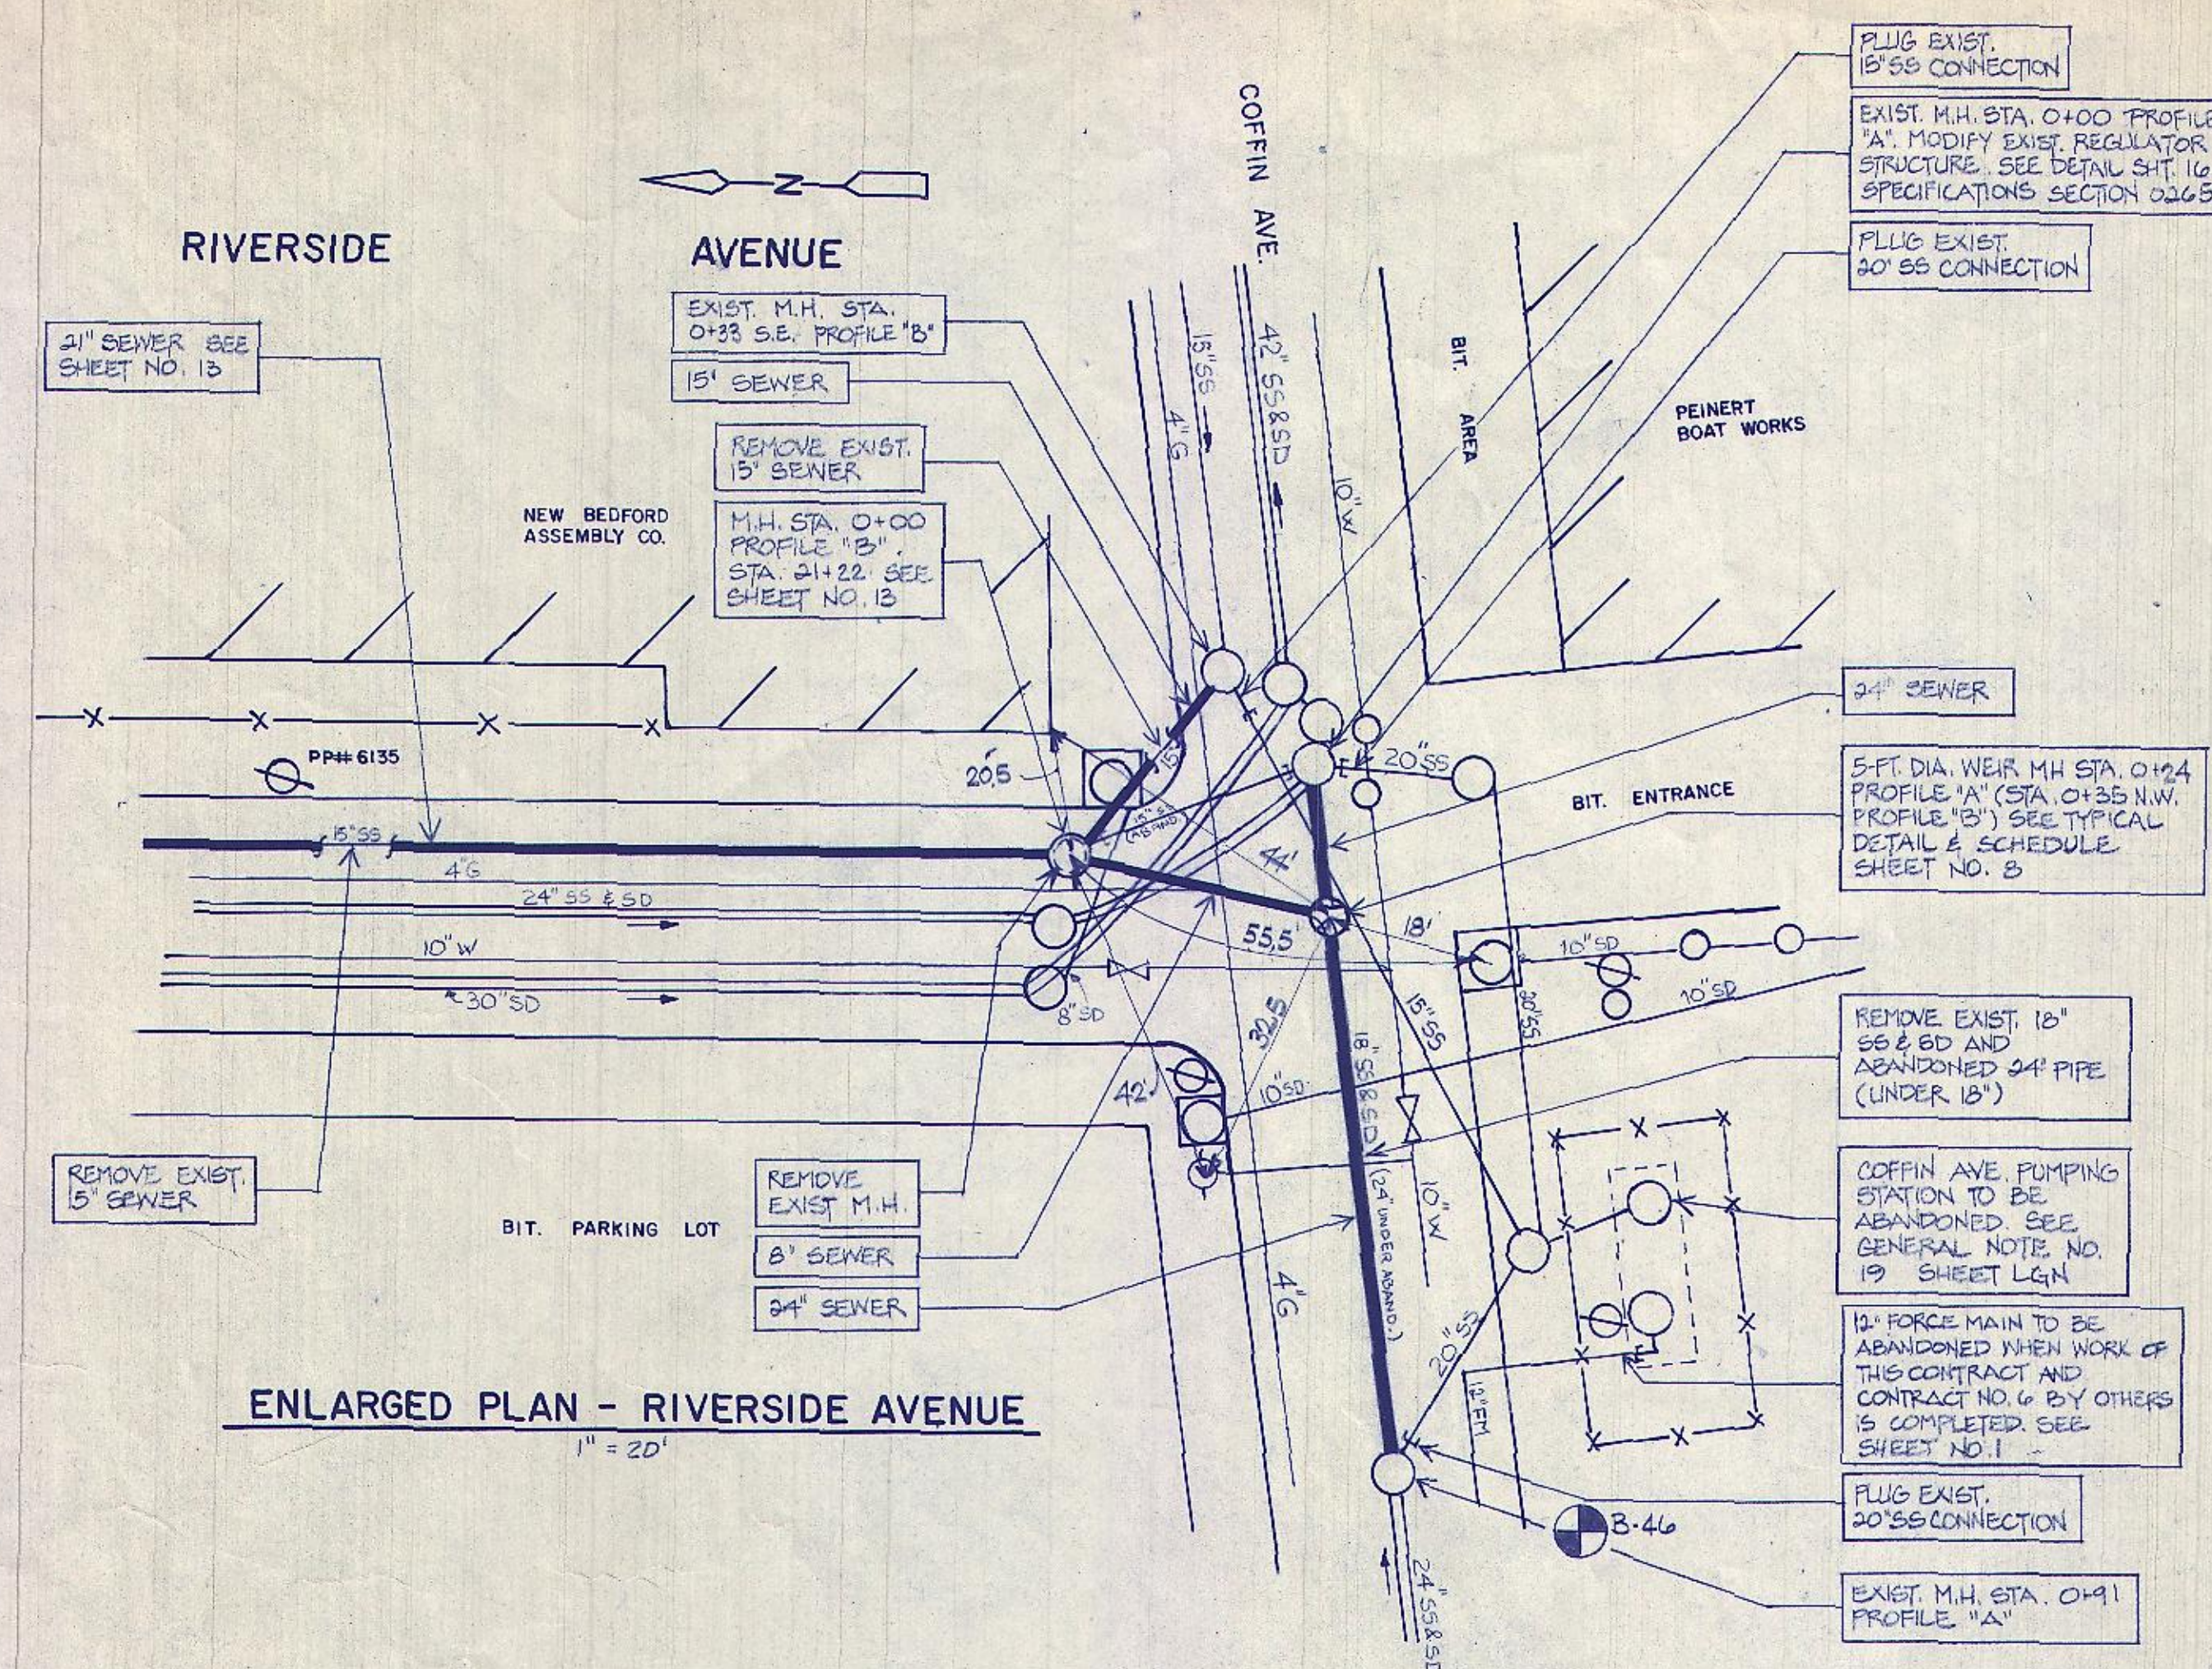

NOTES:
 1. USE OF MOVABLE TRENCH BRACING IS PROHIBITED
 2. CONTRACTOR TO DIG TEST PIT TO VERIFY LOCATION AND ELEVATION OF EXISTING 8" SEWER.

PROFILE "C"
 HOR. 1" = 40'
 VER. 1" = 4'

PROFILE "D"
 HOR. 1" = 40'
 VER. 1" = 4'

RECORD DRAWING



Date	Chk'd.	Revision
7/94		REVISED FOR RECORD DRAWINGS
Designed by:	SAB/AGZ	
Drawn by:	JJB	
Checked by:	SAB	
Approved by:	SJH	

CITY OF NEW BEDFORD, MASSACHUSETTS
 BELLEVILLE AVENUE FORCE MAIN EXTENSION
 CONTRACT NO. 5
 SAWYER STREET
 CAMP DRESSER & McKee INC.
 Ten Cambridge Center
 Cambridge, Massachusetts 02142
 SHEET NO. 11
 309-47810