
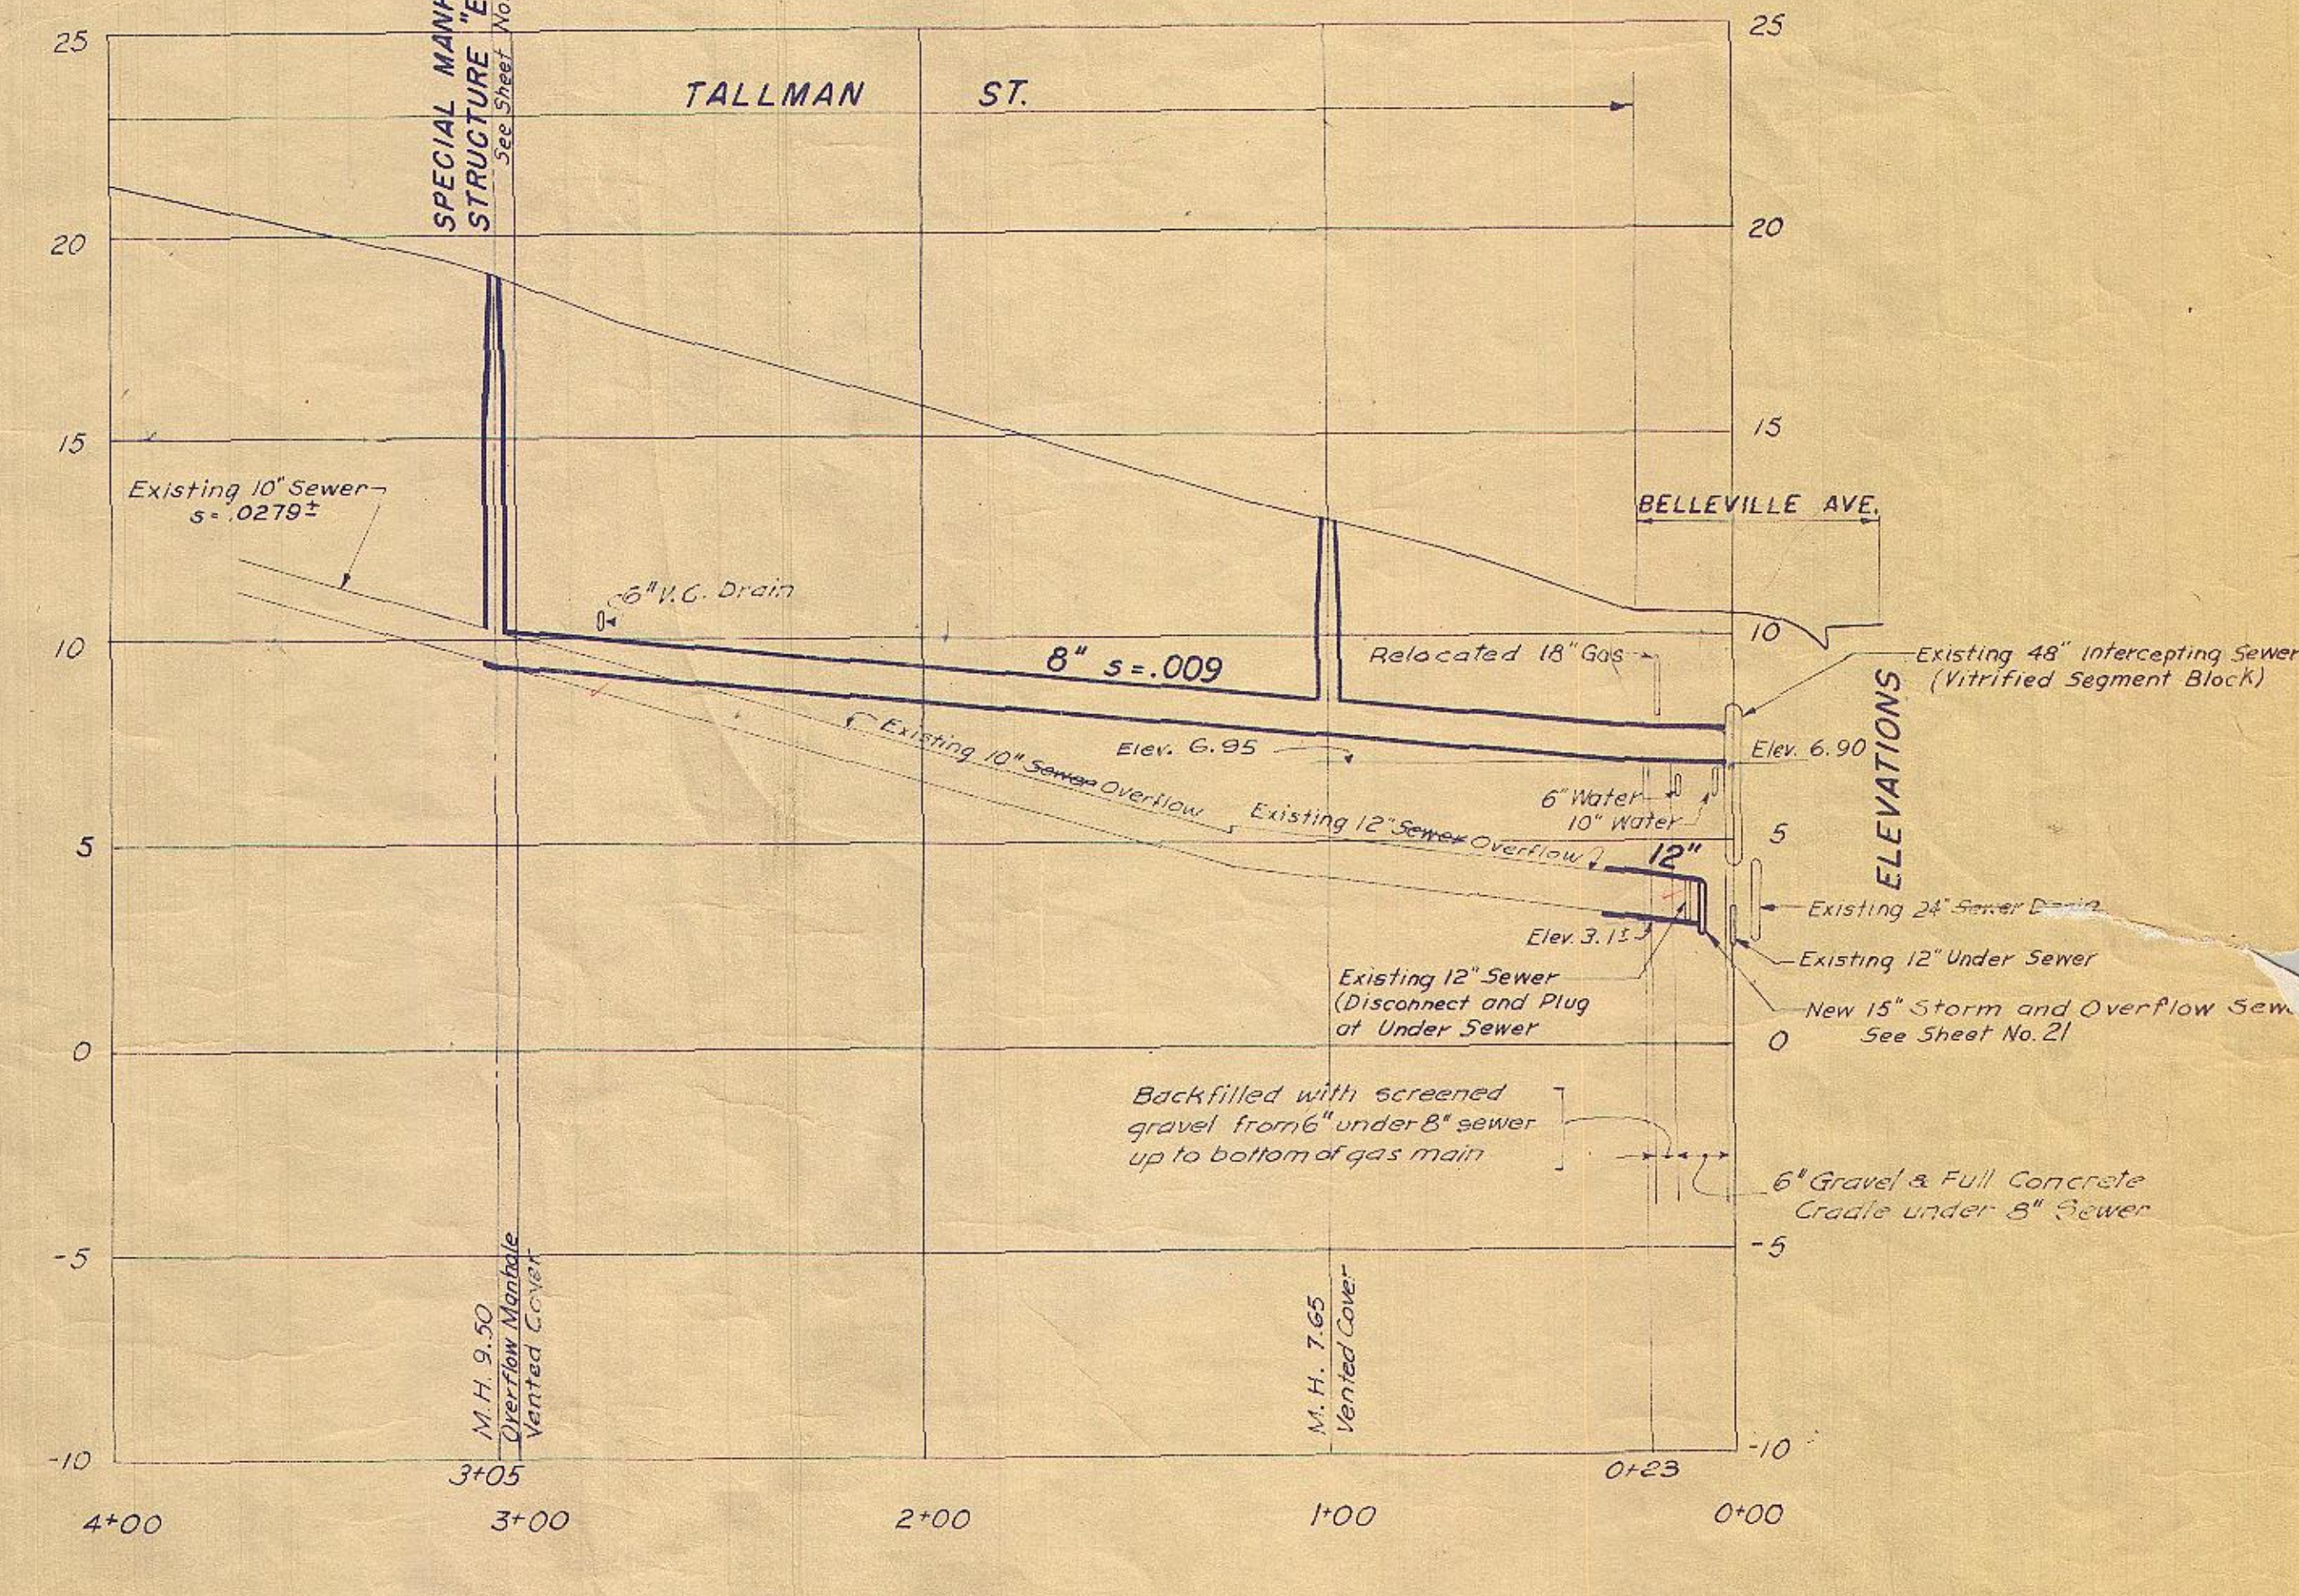
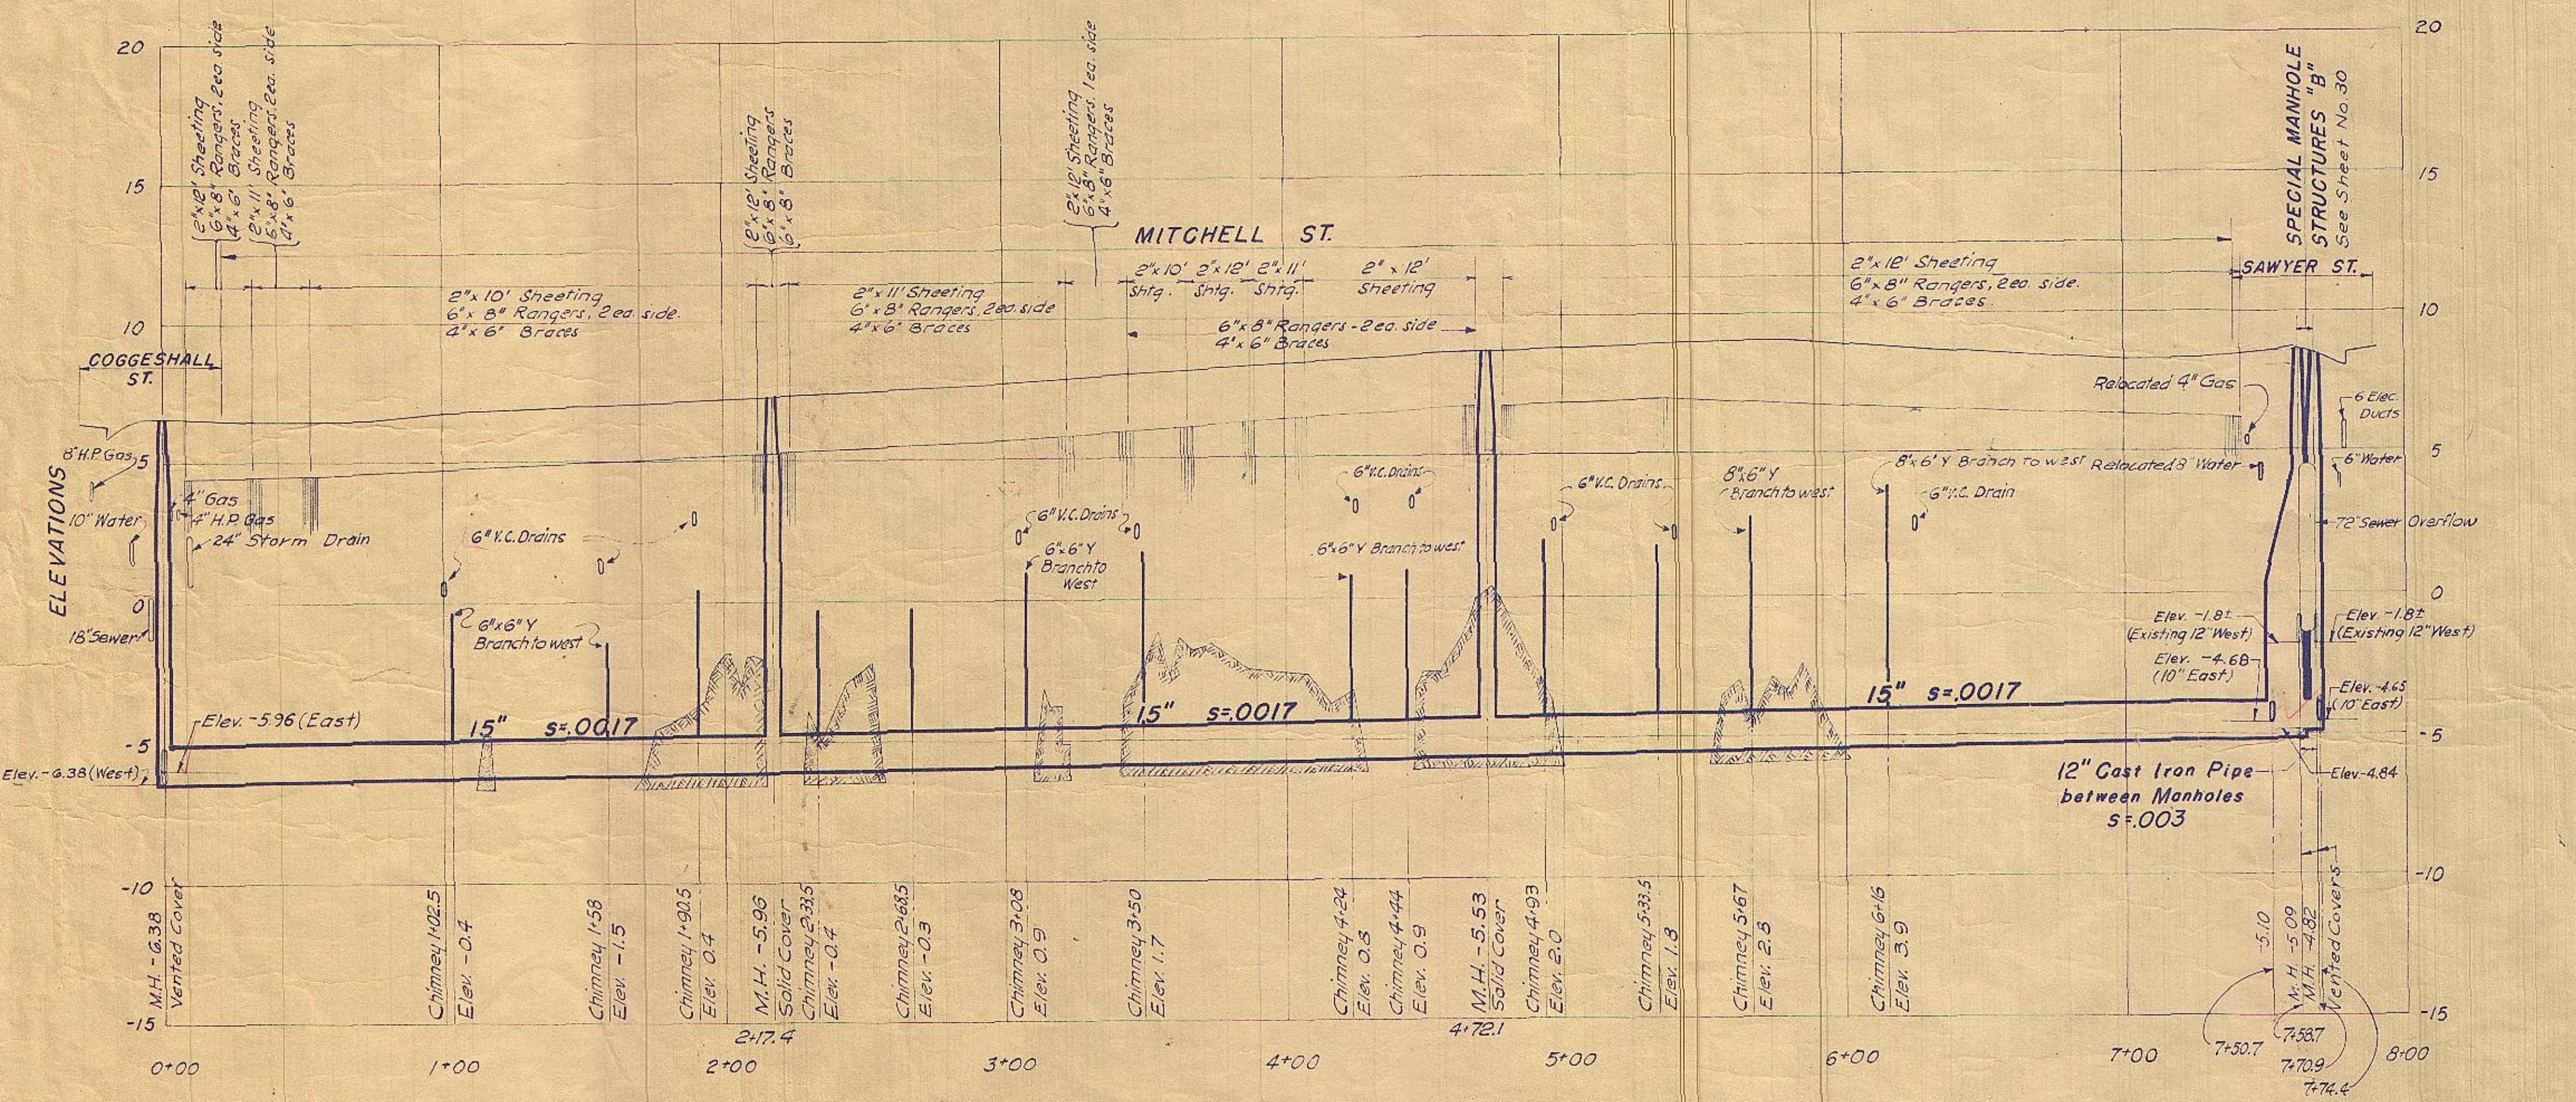
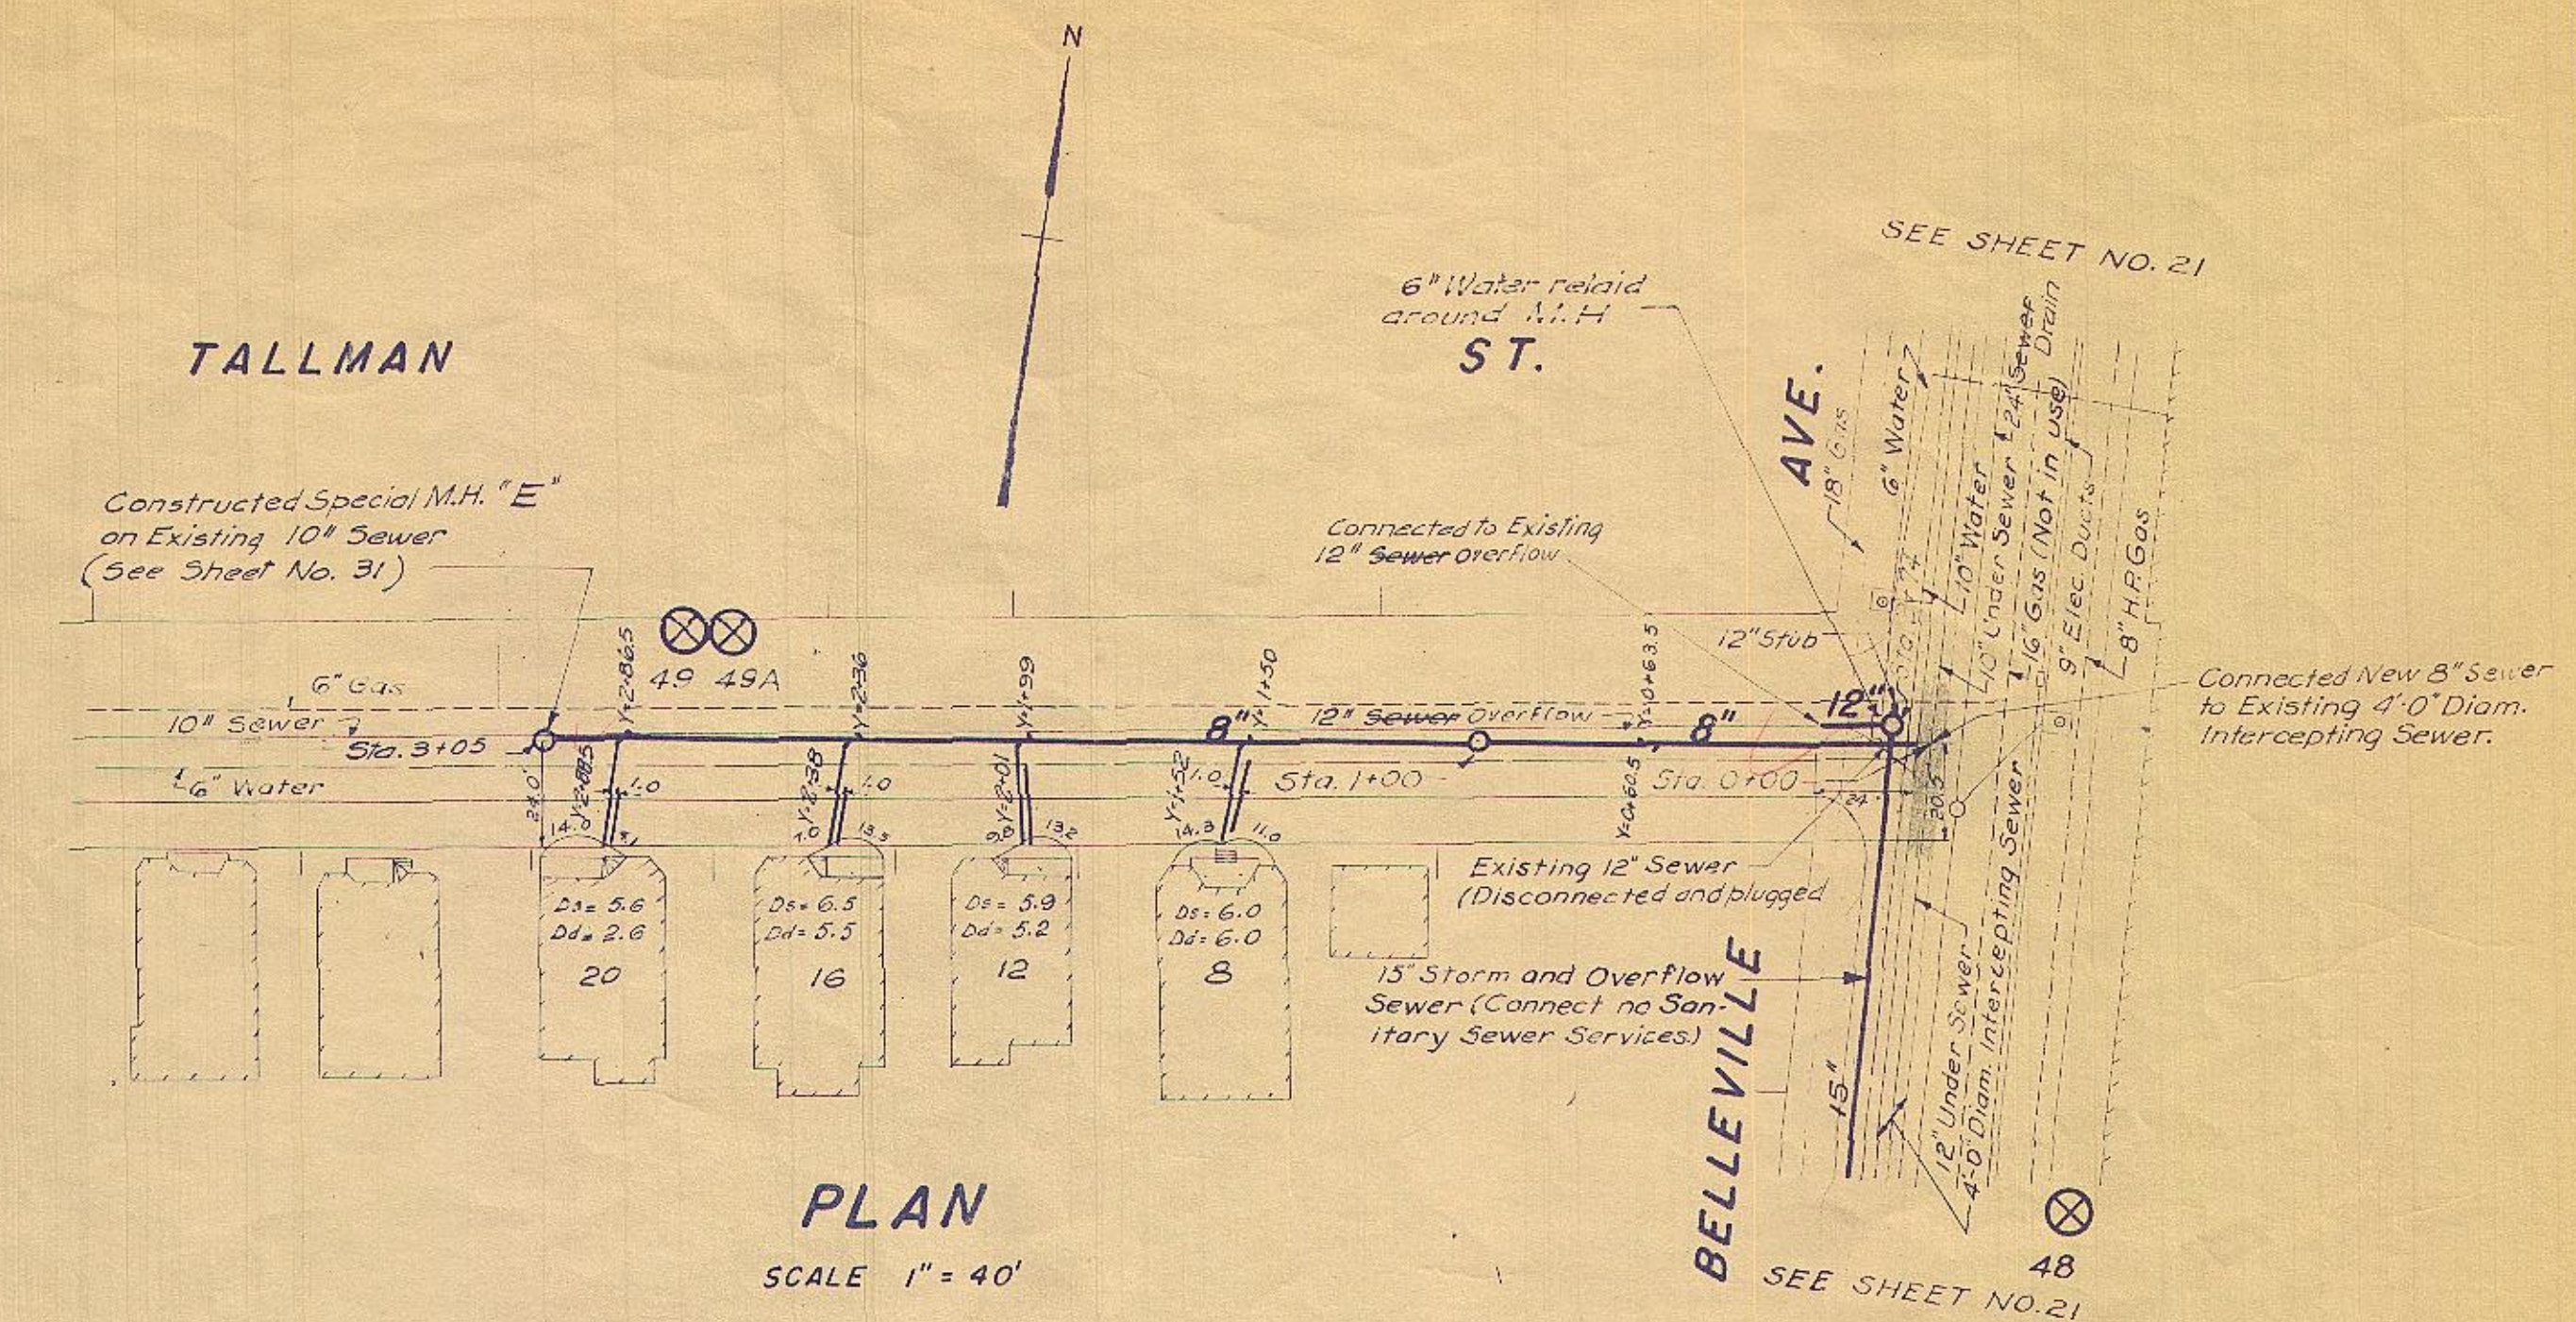


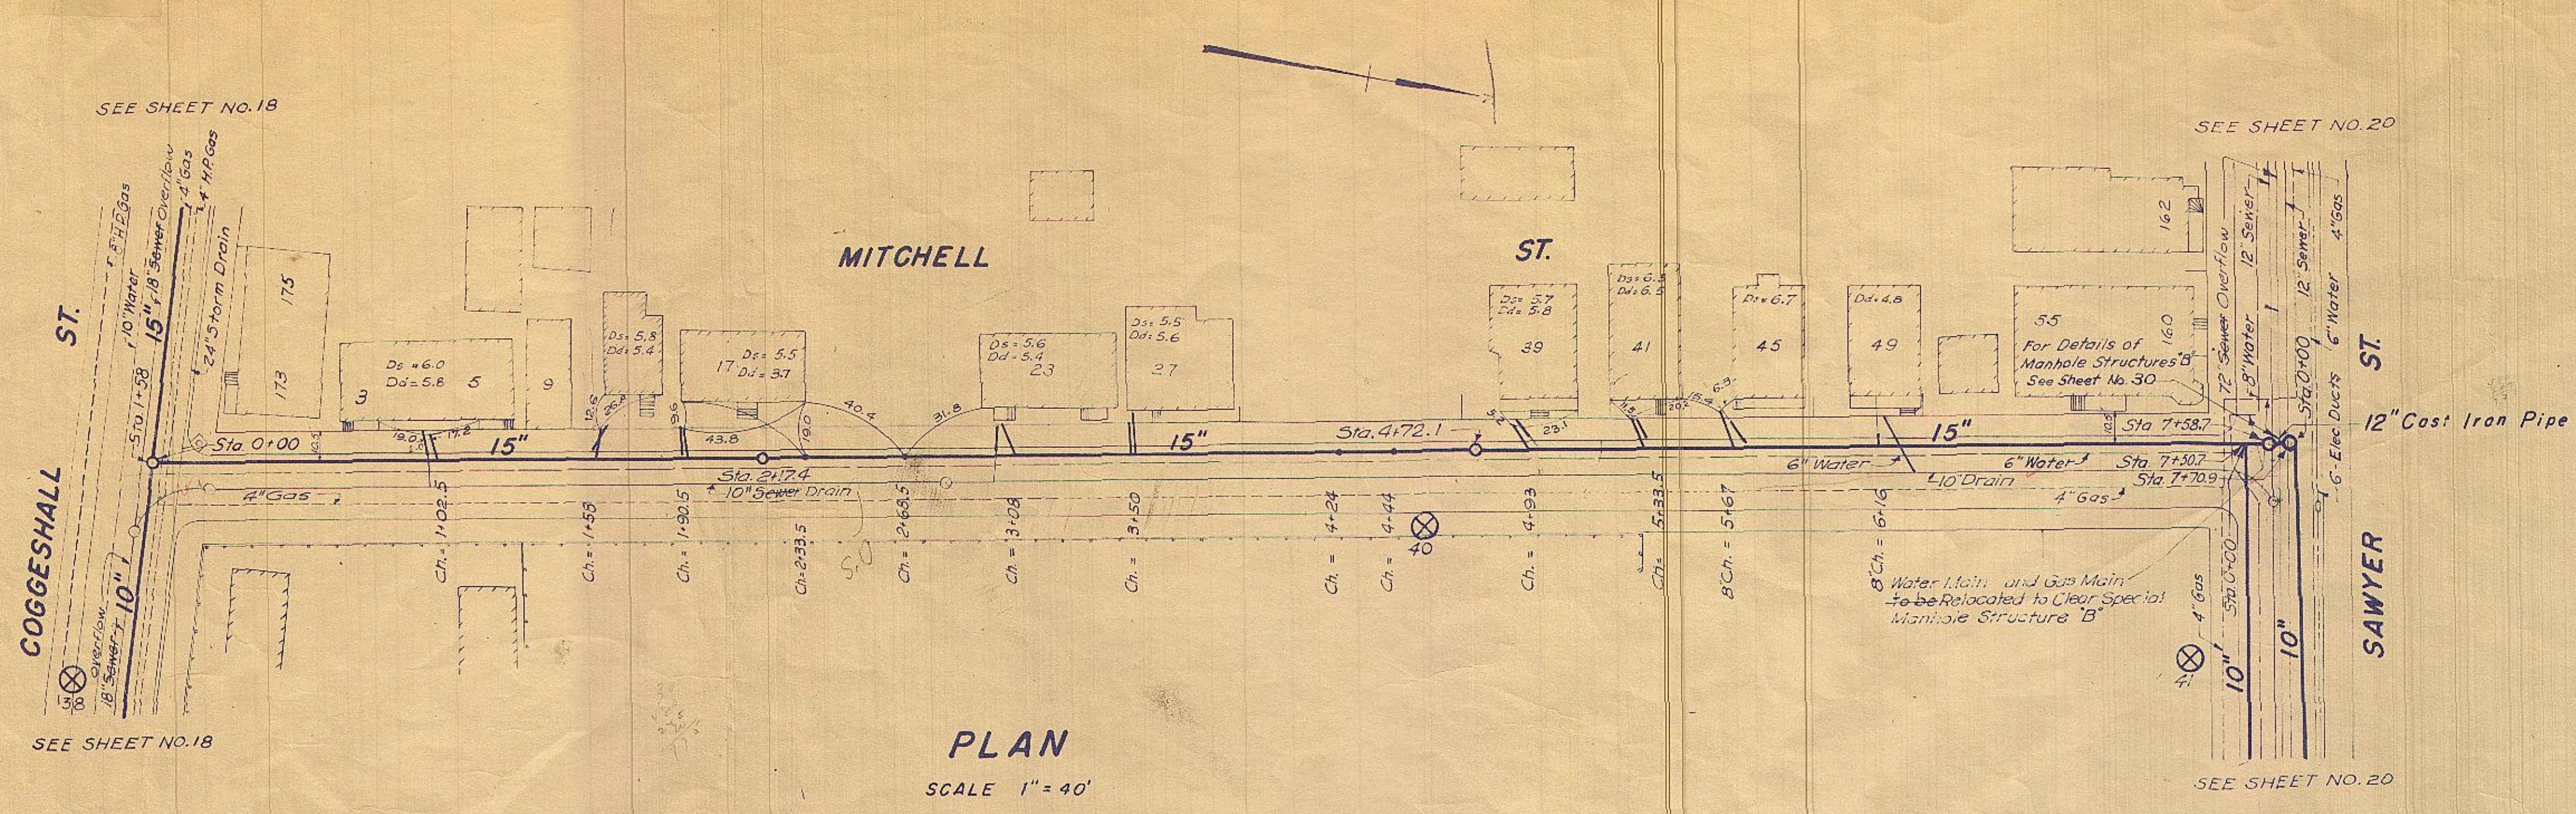

FOR DETAILS, GENERAL NOTES AND LEGEND SEE SHEET NO. 29 AND SHEET NO. 33

RECORD PLAN

NEW BEDFORD, MASSACHUSETTS DEPARTMENT OF PUBLIC WORKS			
ADDITIONS TO INTERCEPTING SEWER SYSTEM			
SEWERS			
MITCHELL ST. (COGGESHALL ST. to SAWYER ST.)			
TALLYMAN ST. (West of BEVELVILLE AVE.)			
SCALE AS NOTED		OCT 1948	
FAY, SPOFFORD & THORNDIKE, ENGINEERS, BOSTON, MASS.		FILE NO. Jn-1	
DES. C.R.S.	TR. R.R.O.B.	CHK. G.C.C.	FILE NO.
DR. G.A.	CHK. G.C.C.	FILE NO.	26
APPROVED		R. W. Horne	
CONTRACT DRAWING		SHEET NO. 19 OF 33	

REV. NO.	DATE	DESCRIPTION	MADE BY	CHK. BY	APP'D. BY
1	2/5/51	Revised as built	B.L.S.	G.C.C.	H
REVISIONS					