

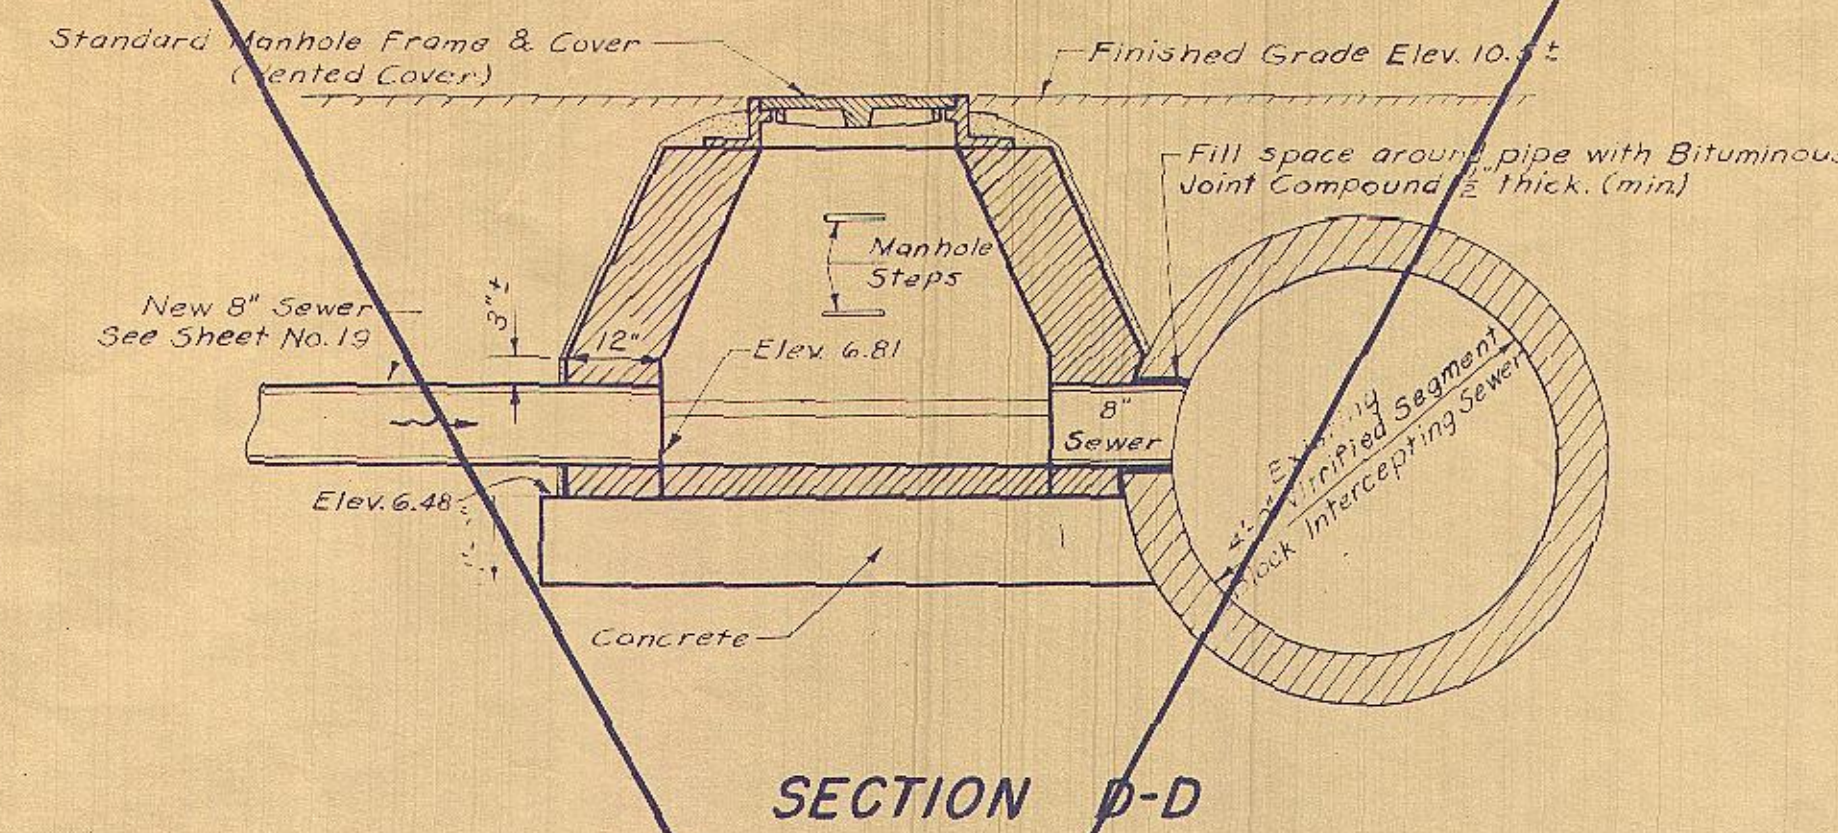
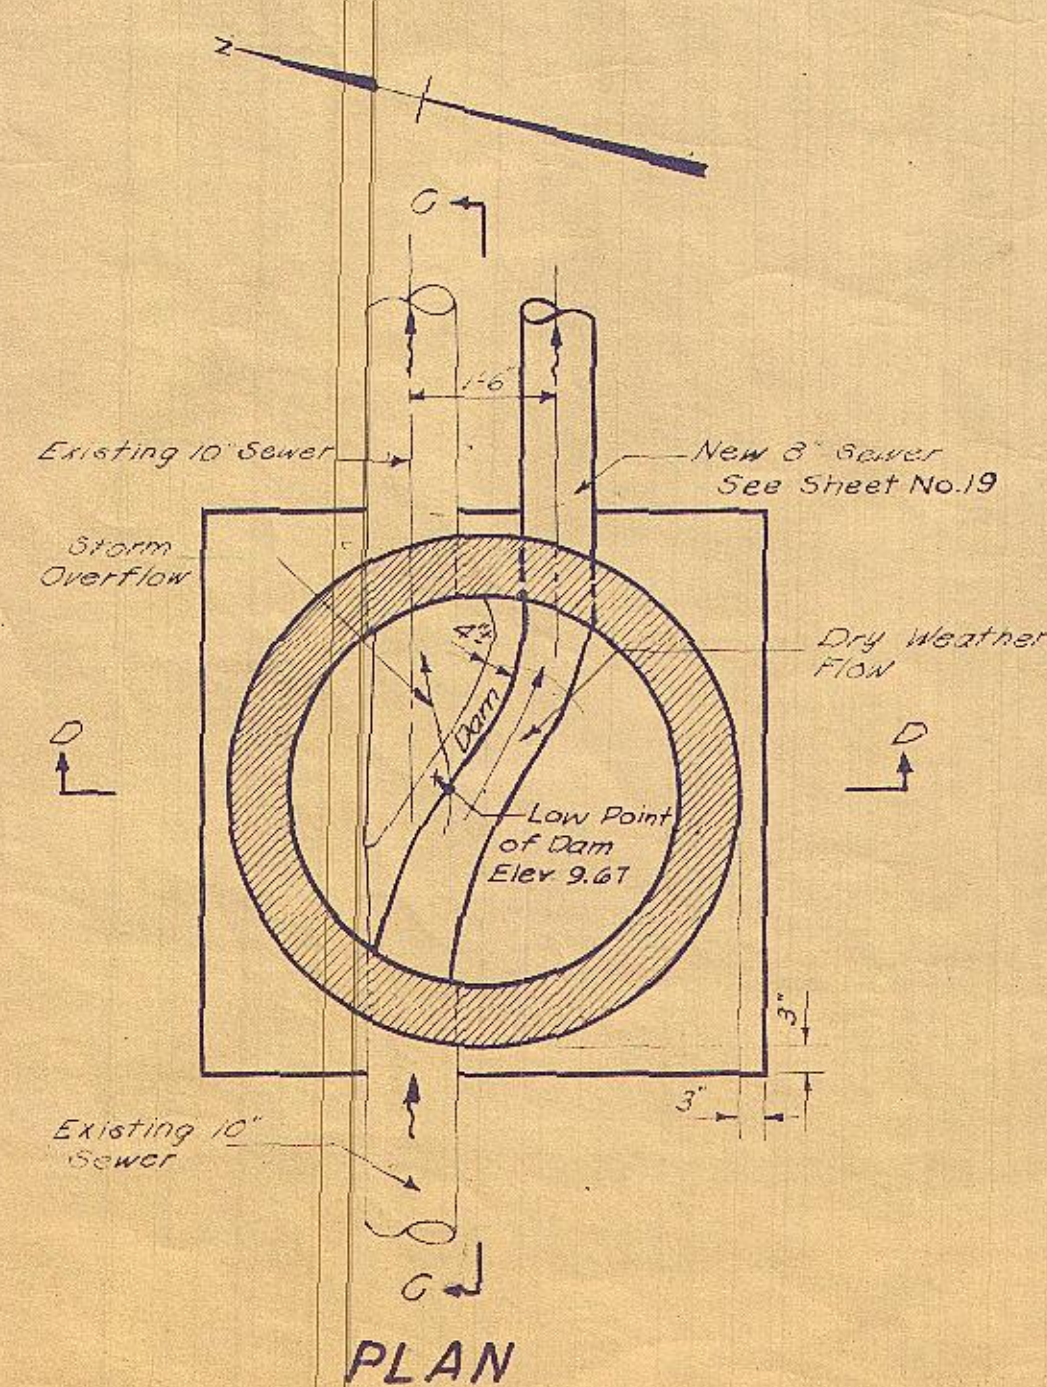
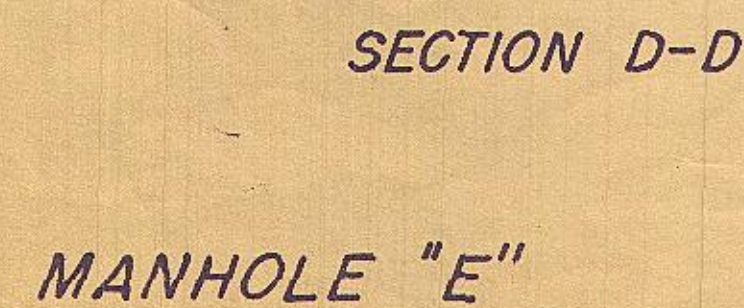
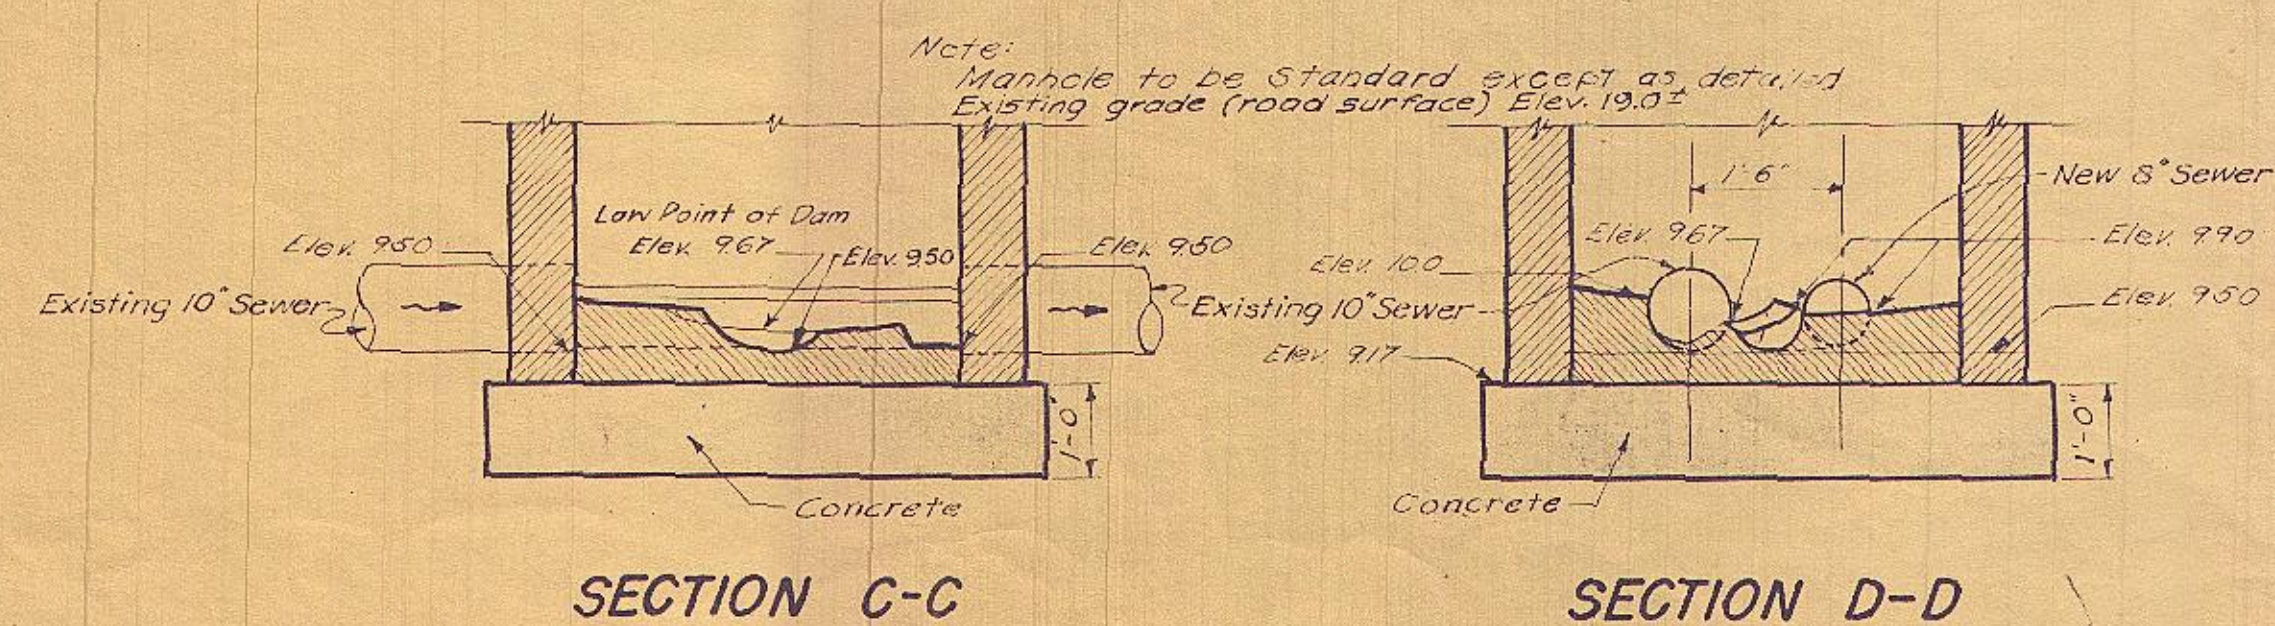
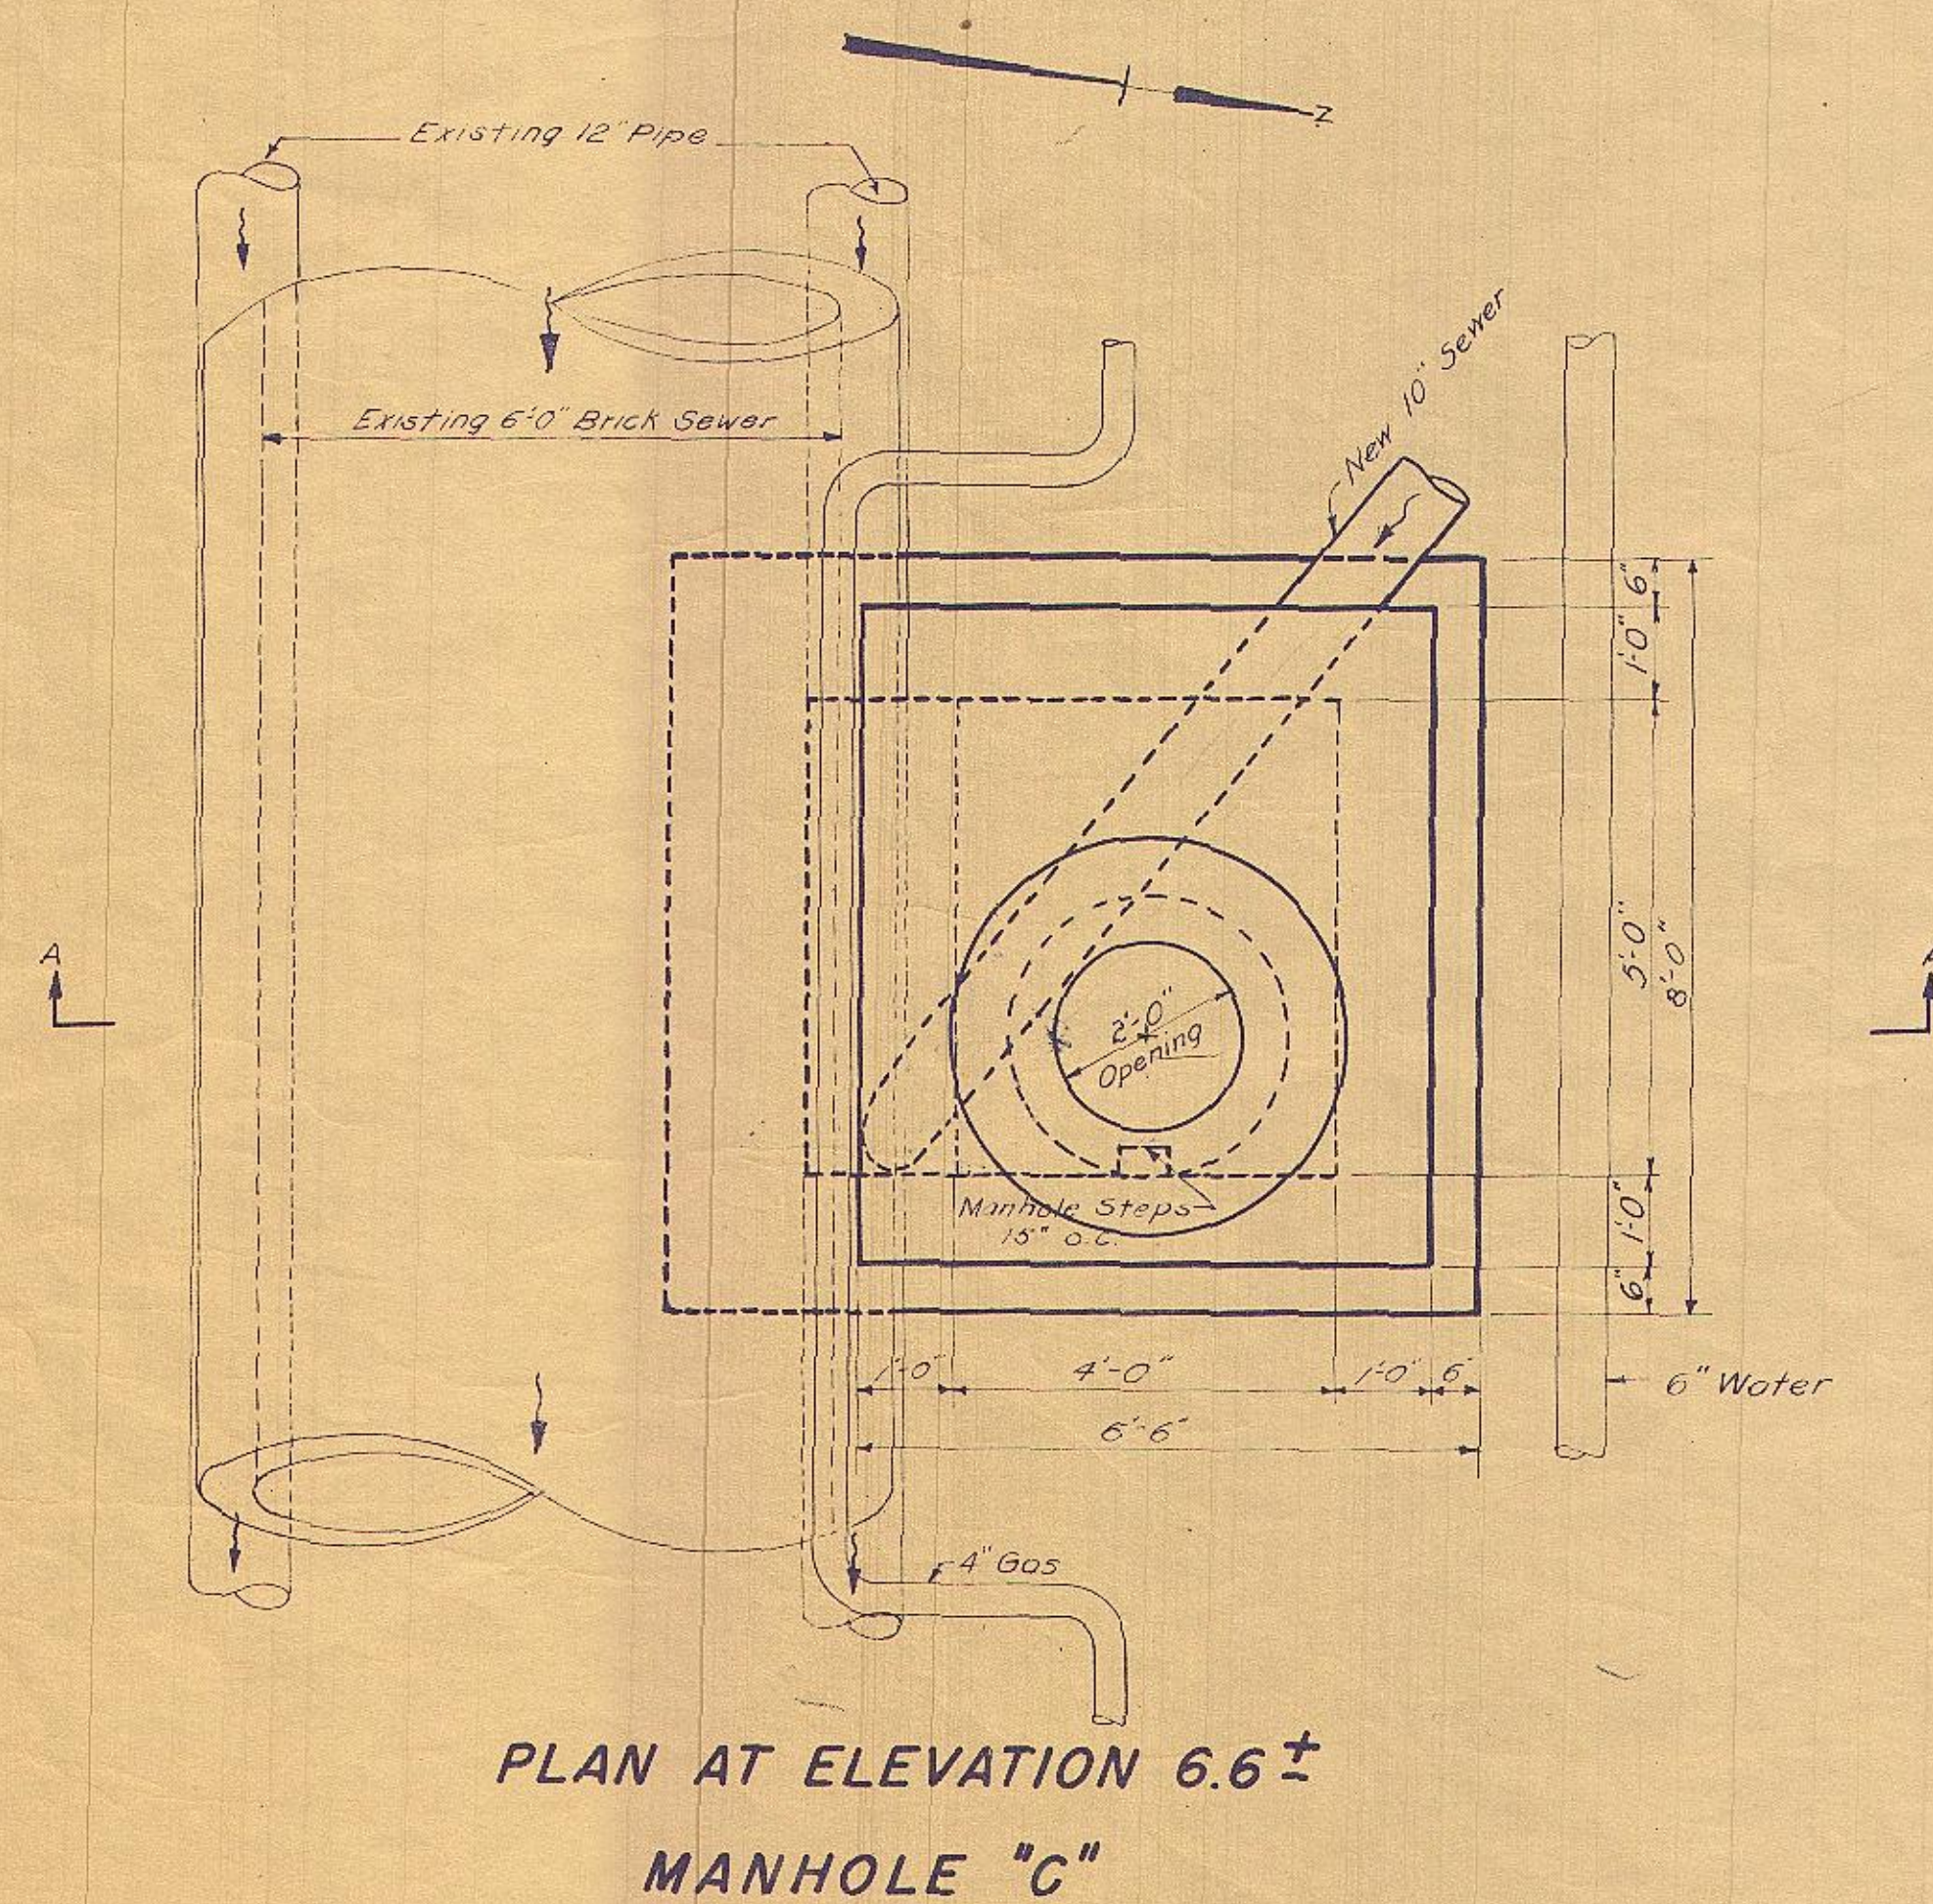
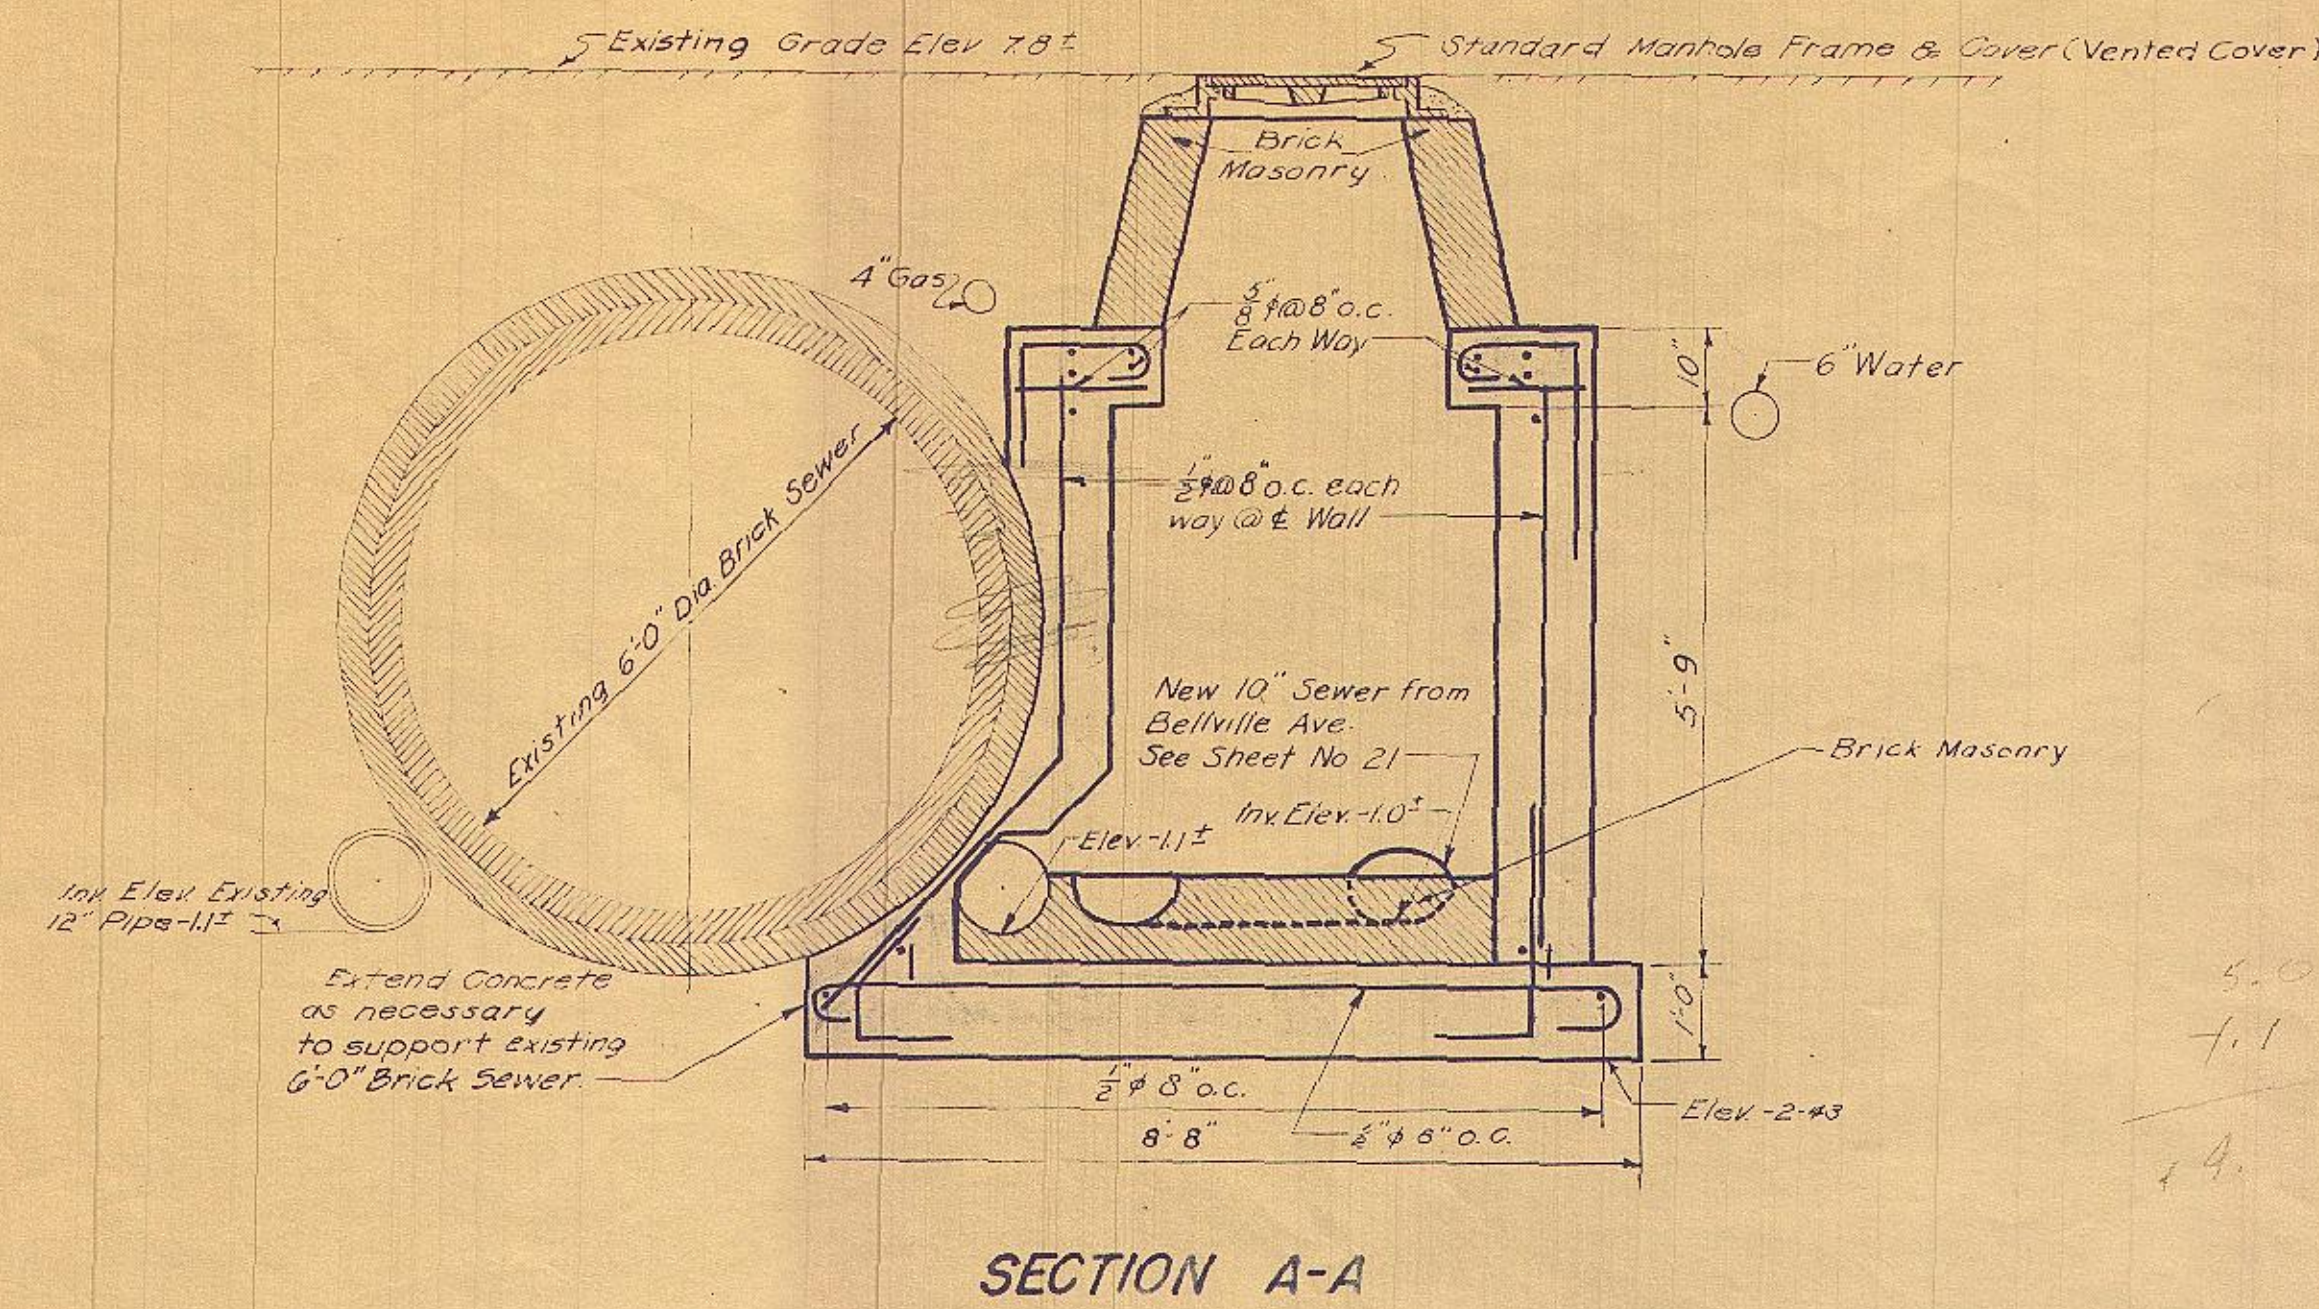
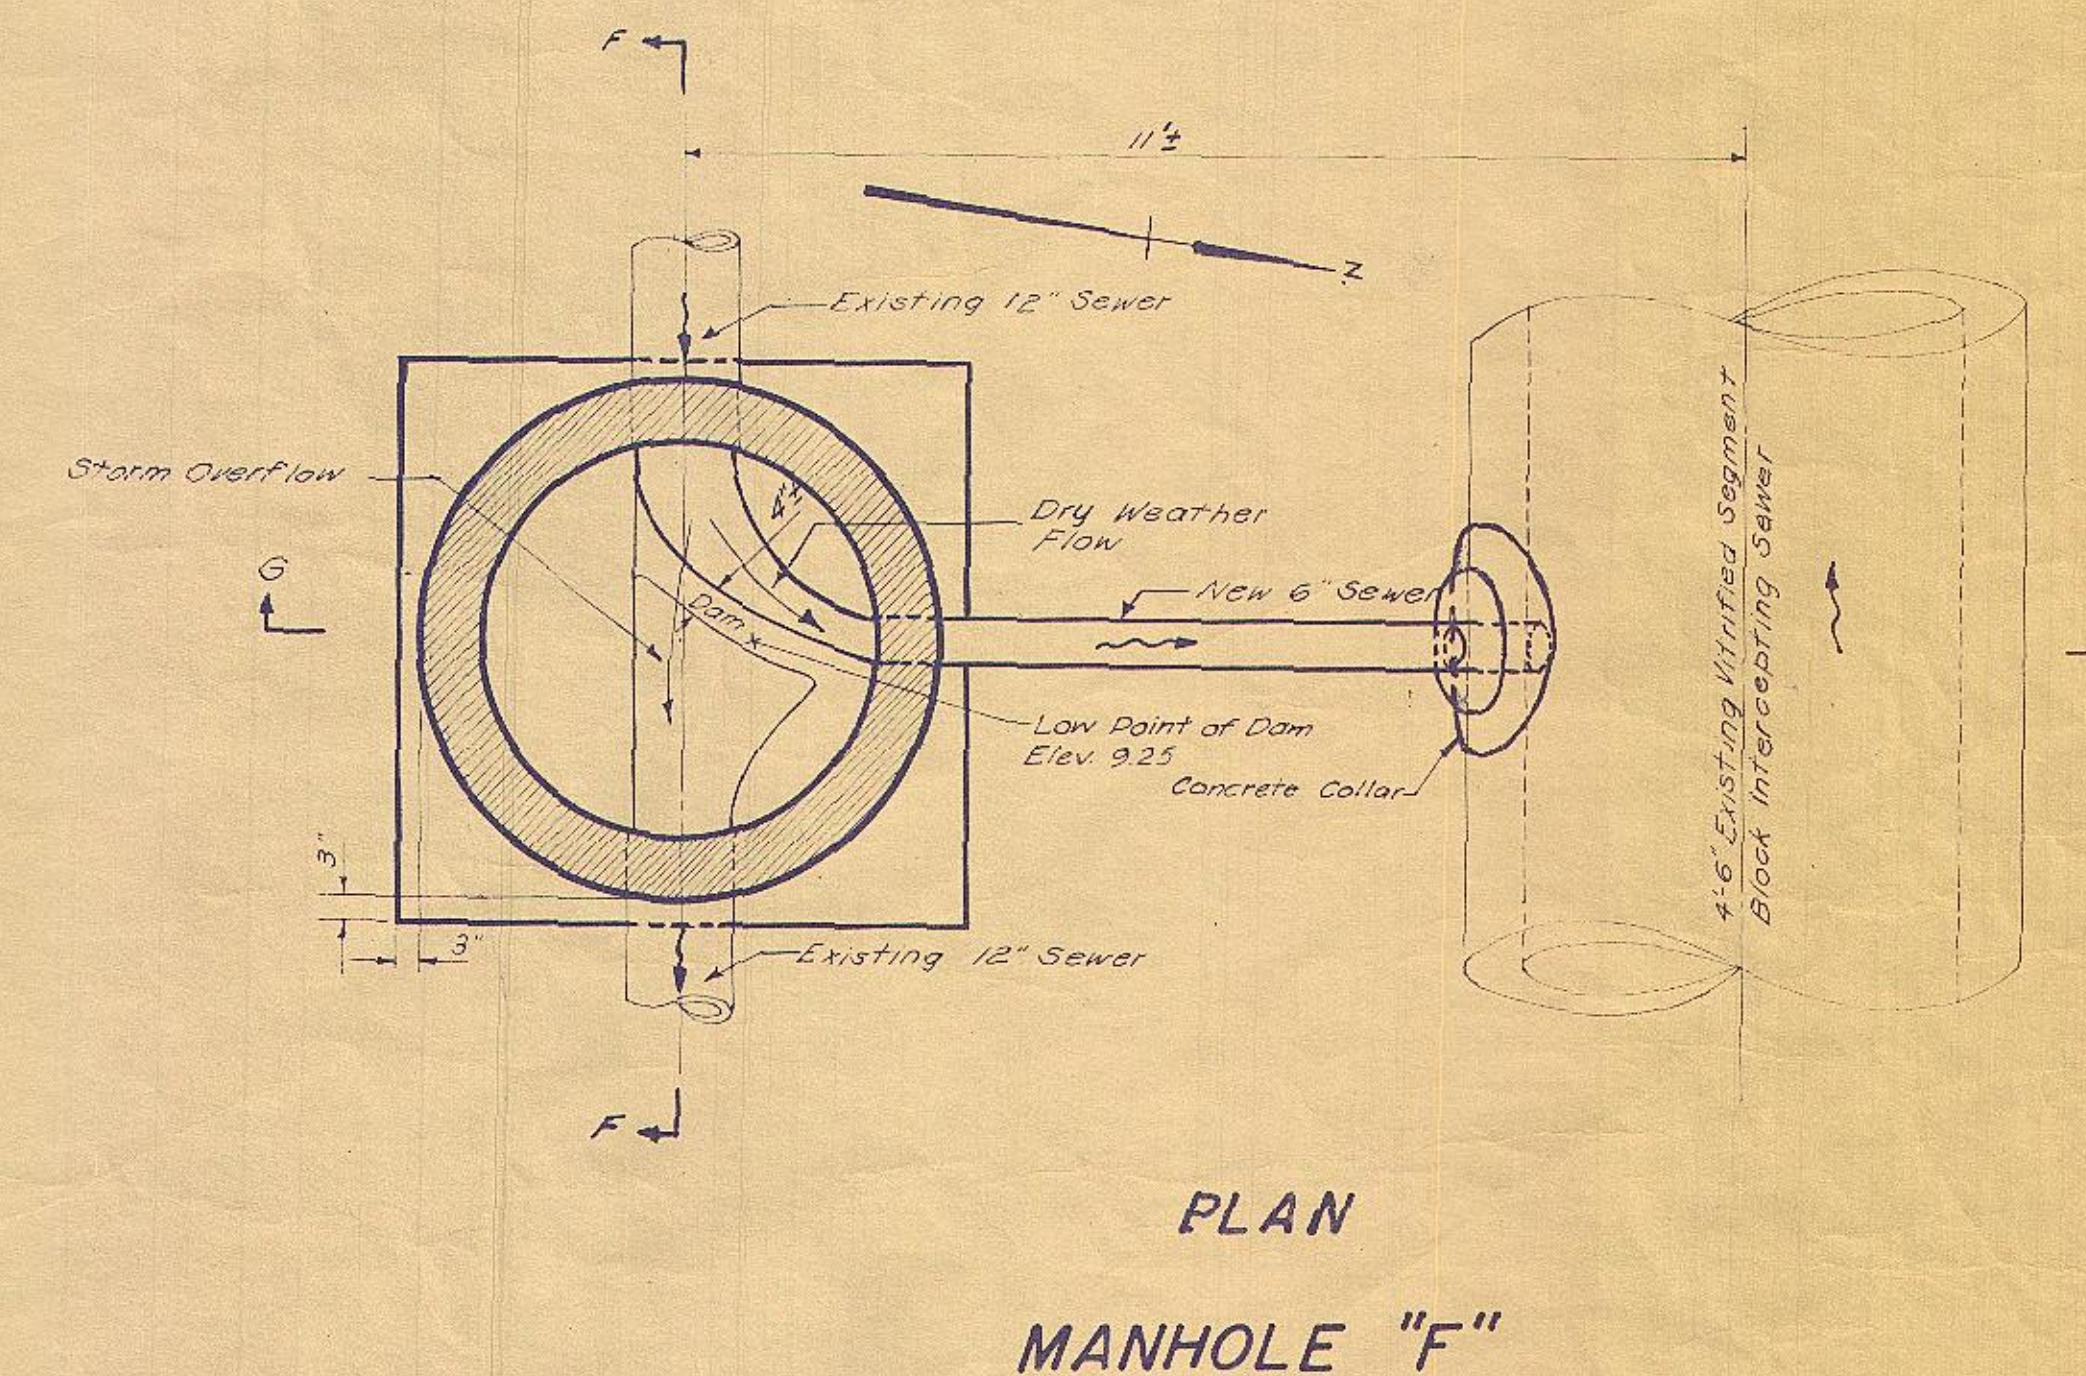
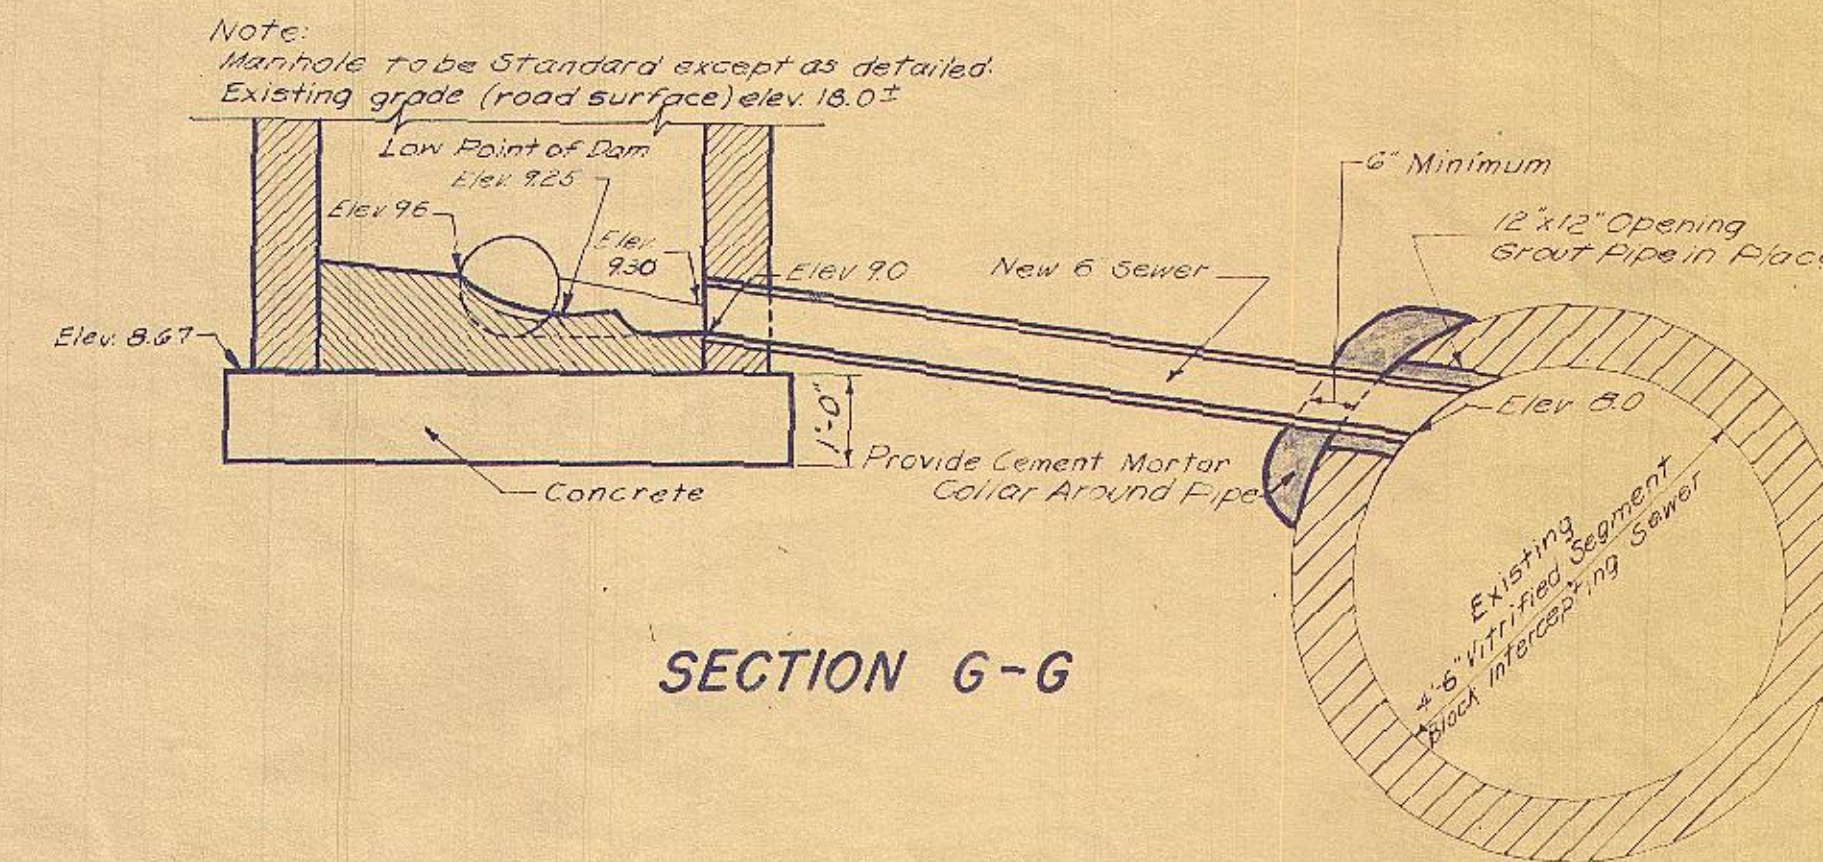


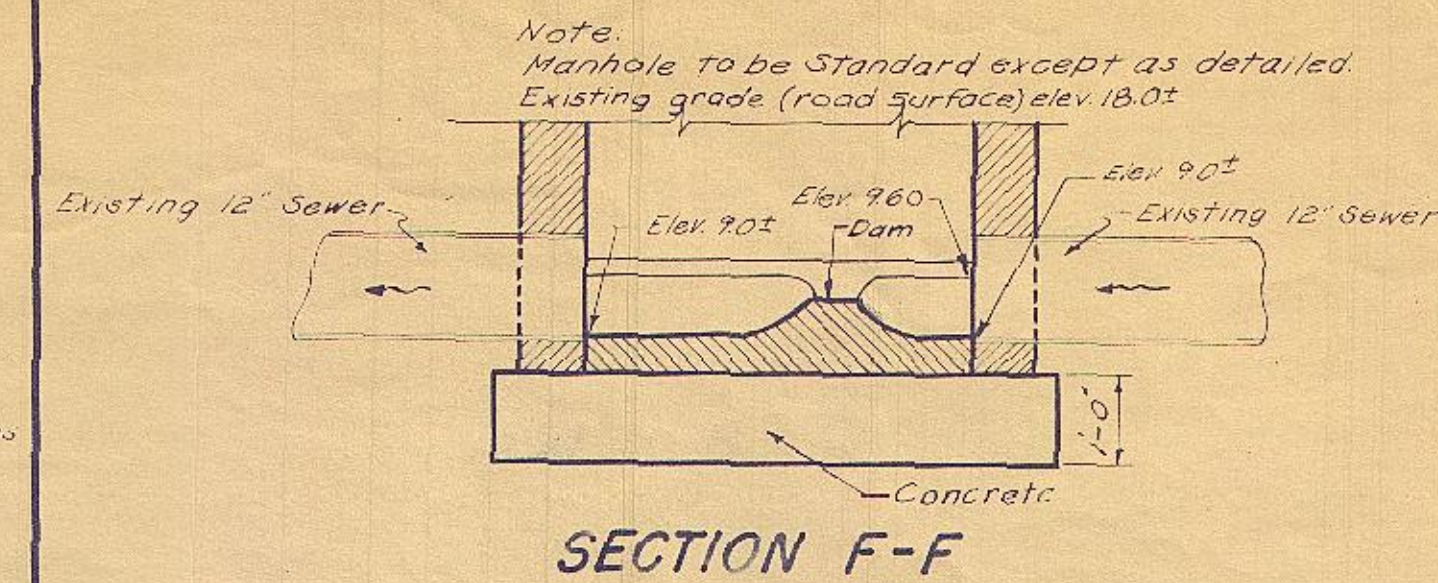

THIS MANHOLE OMITTED

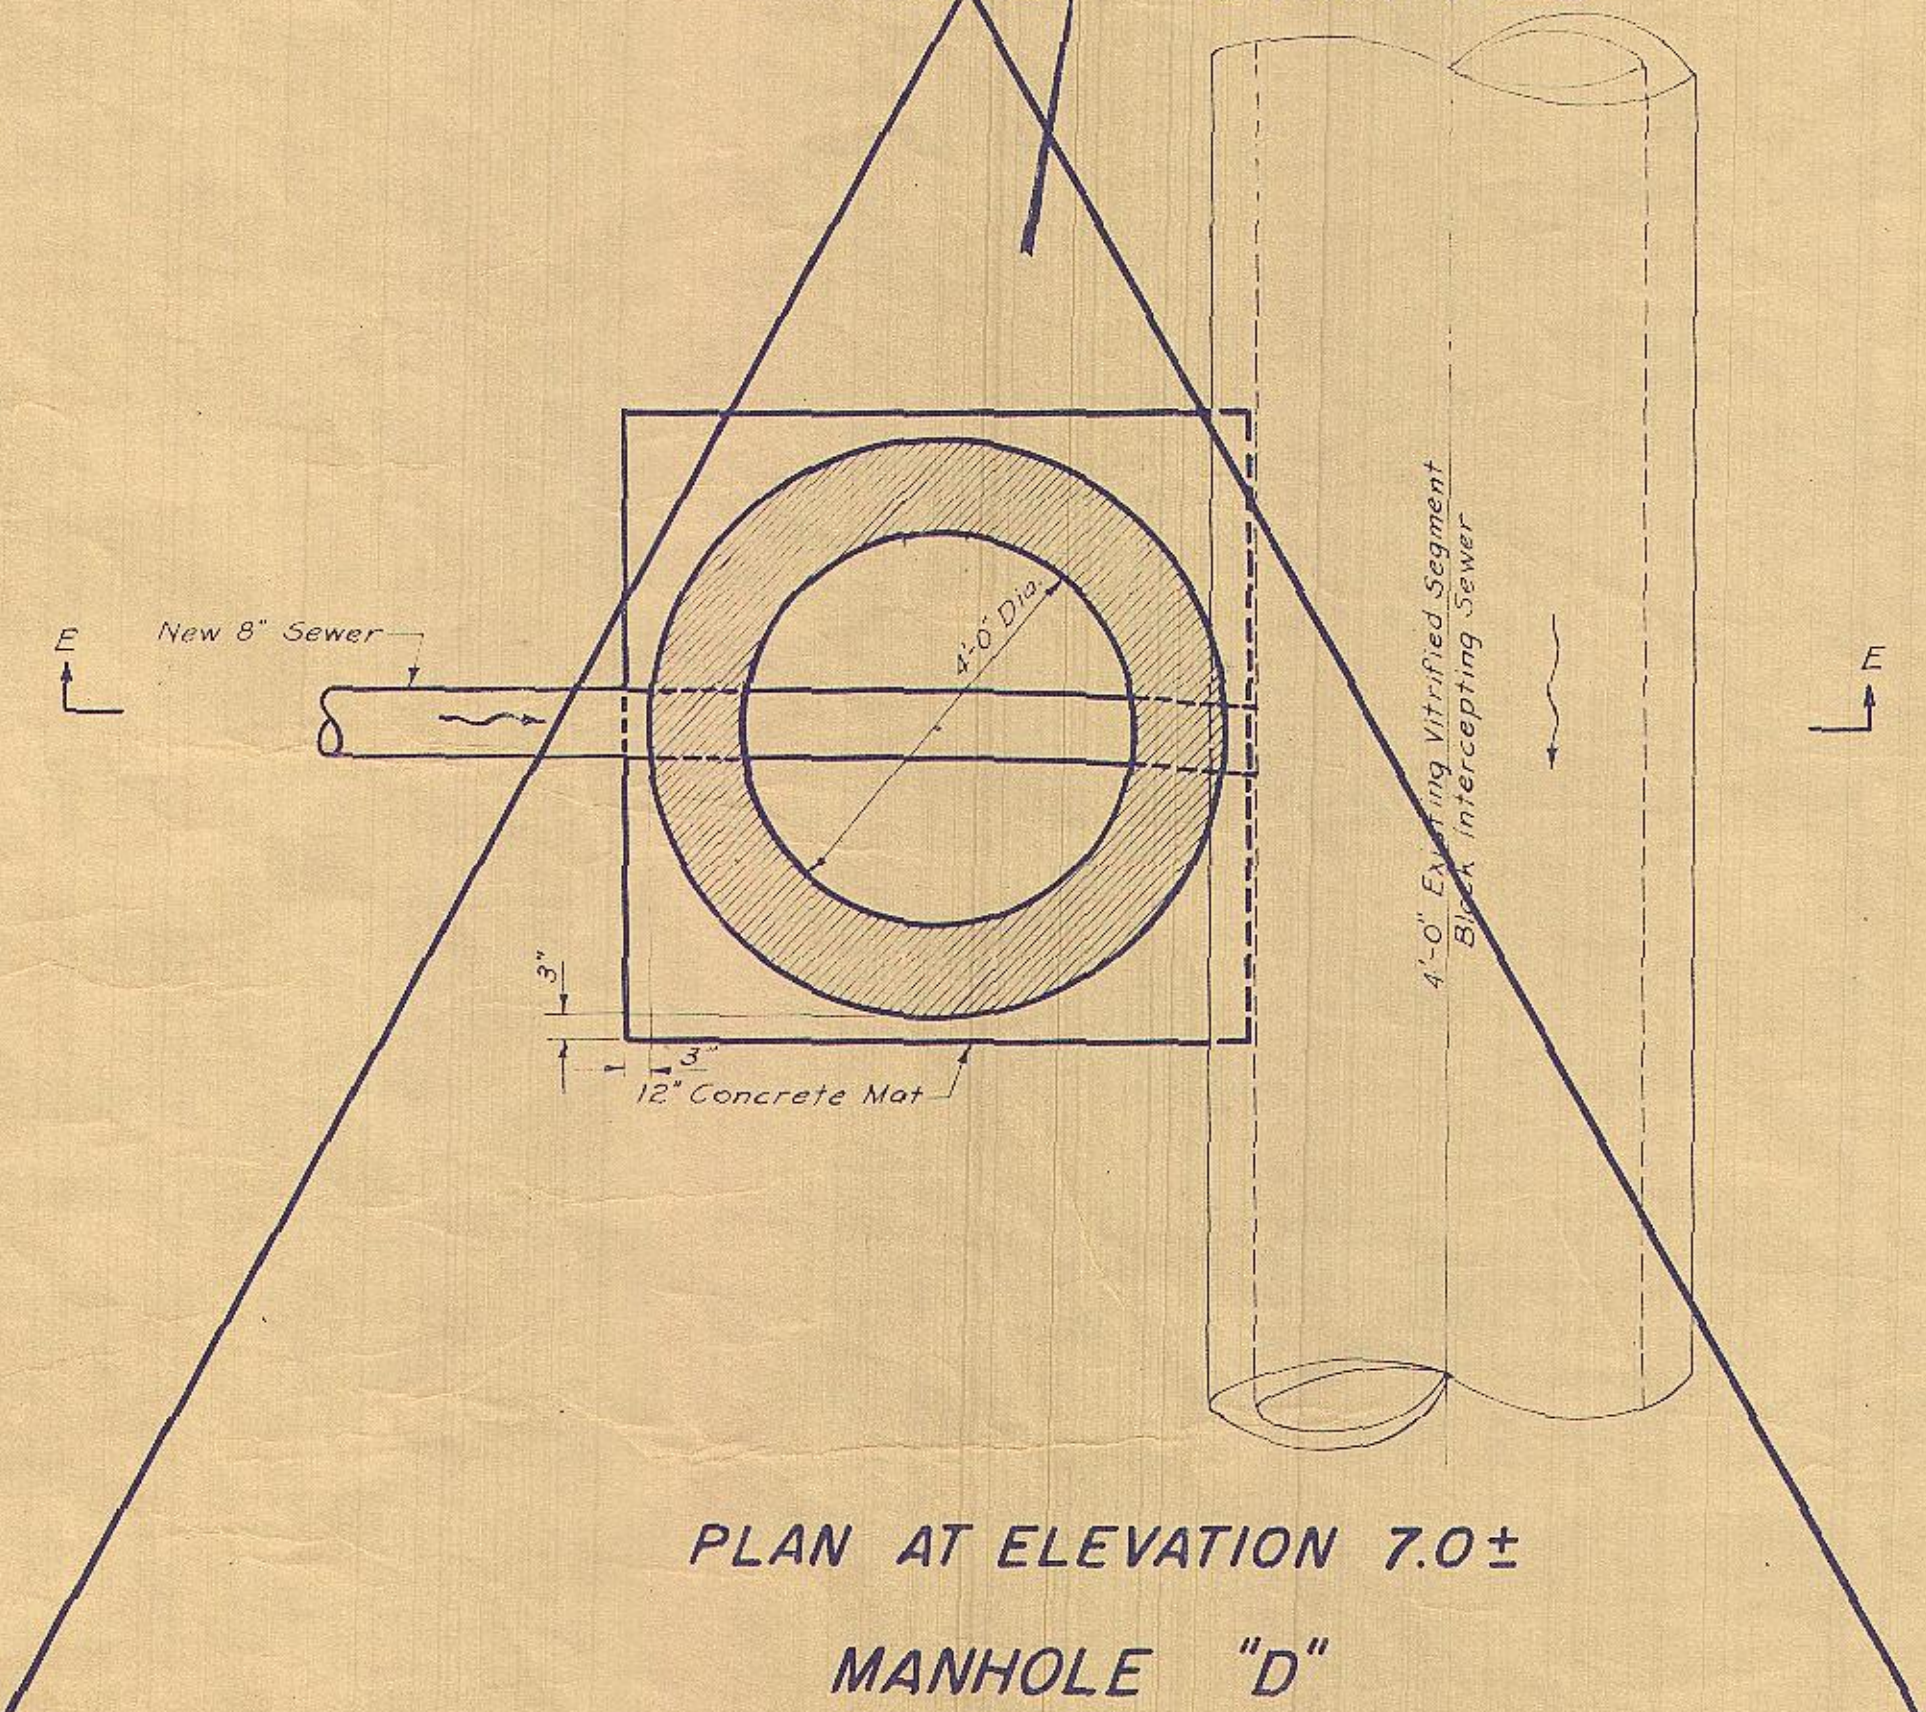

FOR DETAILS, GENERAL NOTES AND LEGEND SEE SHEET NO. 29 AND SHEET NO. 33
FOR LOCATION OF MANHOLE "C" SEE SHEET NO. 21
FOR LOCATION OF MANHOLE "D" AND MANHOLE "E" SEE SHEET NO. 19
FOR LOCATION OF MANHOLE "F" SEE SHEET NO. 13

REV. NO.	DATE	DESCRIPTION	MADE BY	CHK. BY	APPD. BY
1	2/13/1	Revised as Built	DPT	GCC	Y
REVISIONS					

RECORD PLAN

NEW BEDFORD, MASSACHUSETTS DEPARTMENT OF PUBLIC WORKS			
ADDITIONS TO INTERCEPTING SEWER SYSTEM			
SPECIAL MANHOLES STRUCTURES "C," "D," "E" & "F"			
SCALE 1" = 1'-0"		OCT. 1948	
FAY, SPOFFORD & THORNDIKE, ENGINEERS, BOSTON, MASS.			
DES. CR5	RGF PRJ	TR. JOV. R.008	FILE NO. Jn-1
DR. PRJ	R.008	CHK. C.R.S.	PLAN NO. 38
APPROVED R.W. Stone			