


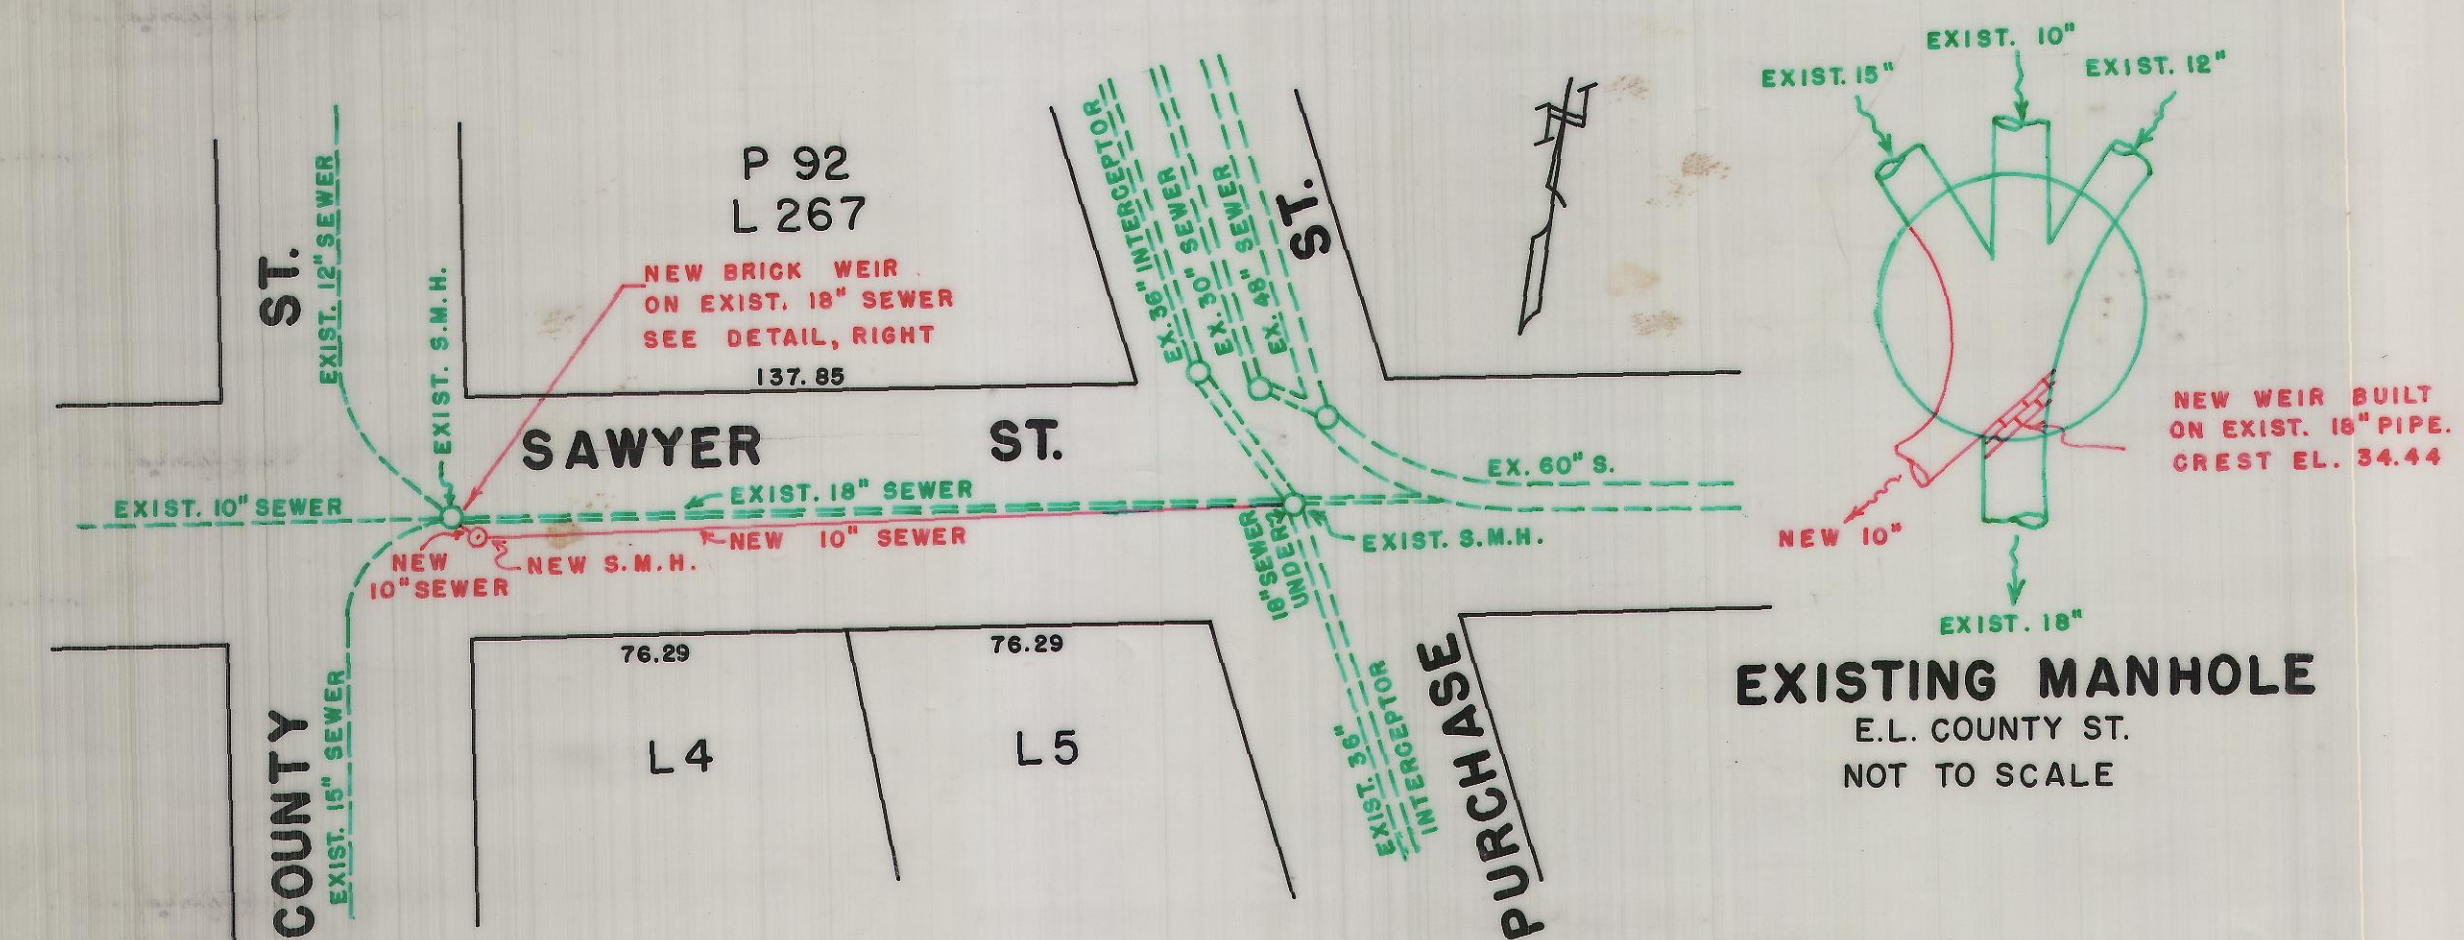

SAWYER ST. DIVERSION SEWER
FROM COUNTY ST. E'LY. TO PURCHASE ST.

SCALES

HORIZONTAL - 1 IN = 40 FT.

CONSTRUCTION BY:

CONSTRUCTION COMPLETED

AMOUNT ASSESSED

VERTICAL - 1 IN = 4 FT.

LABONNE BROS INC.

OCTOBER, 1991

NONE

SCALES

VERTICAL - 1 IN = 4 FT
LABONNE BROS INC.
OCTOBER, 1991
NONE

COMMISSIONER OF PUBLIC WORKS

NOTE:
FOR ADDITIONAL INFORMATION ON
EXISTING 18" SEWER, SEE PLAN 2417.

