
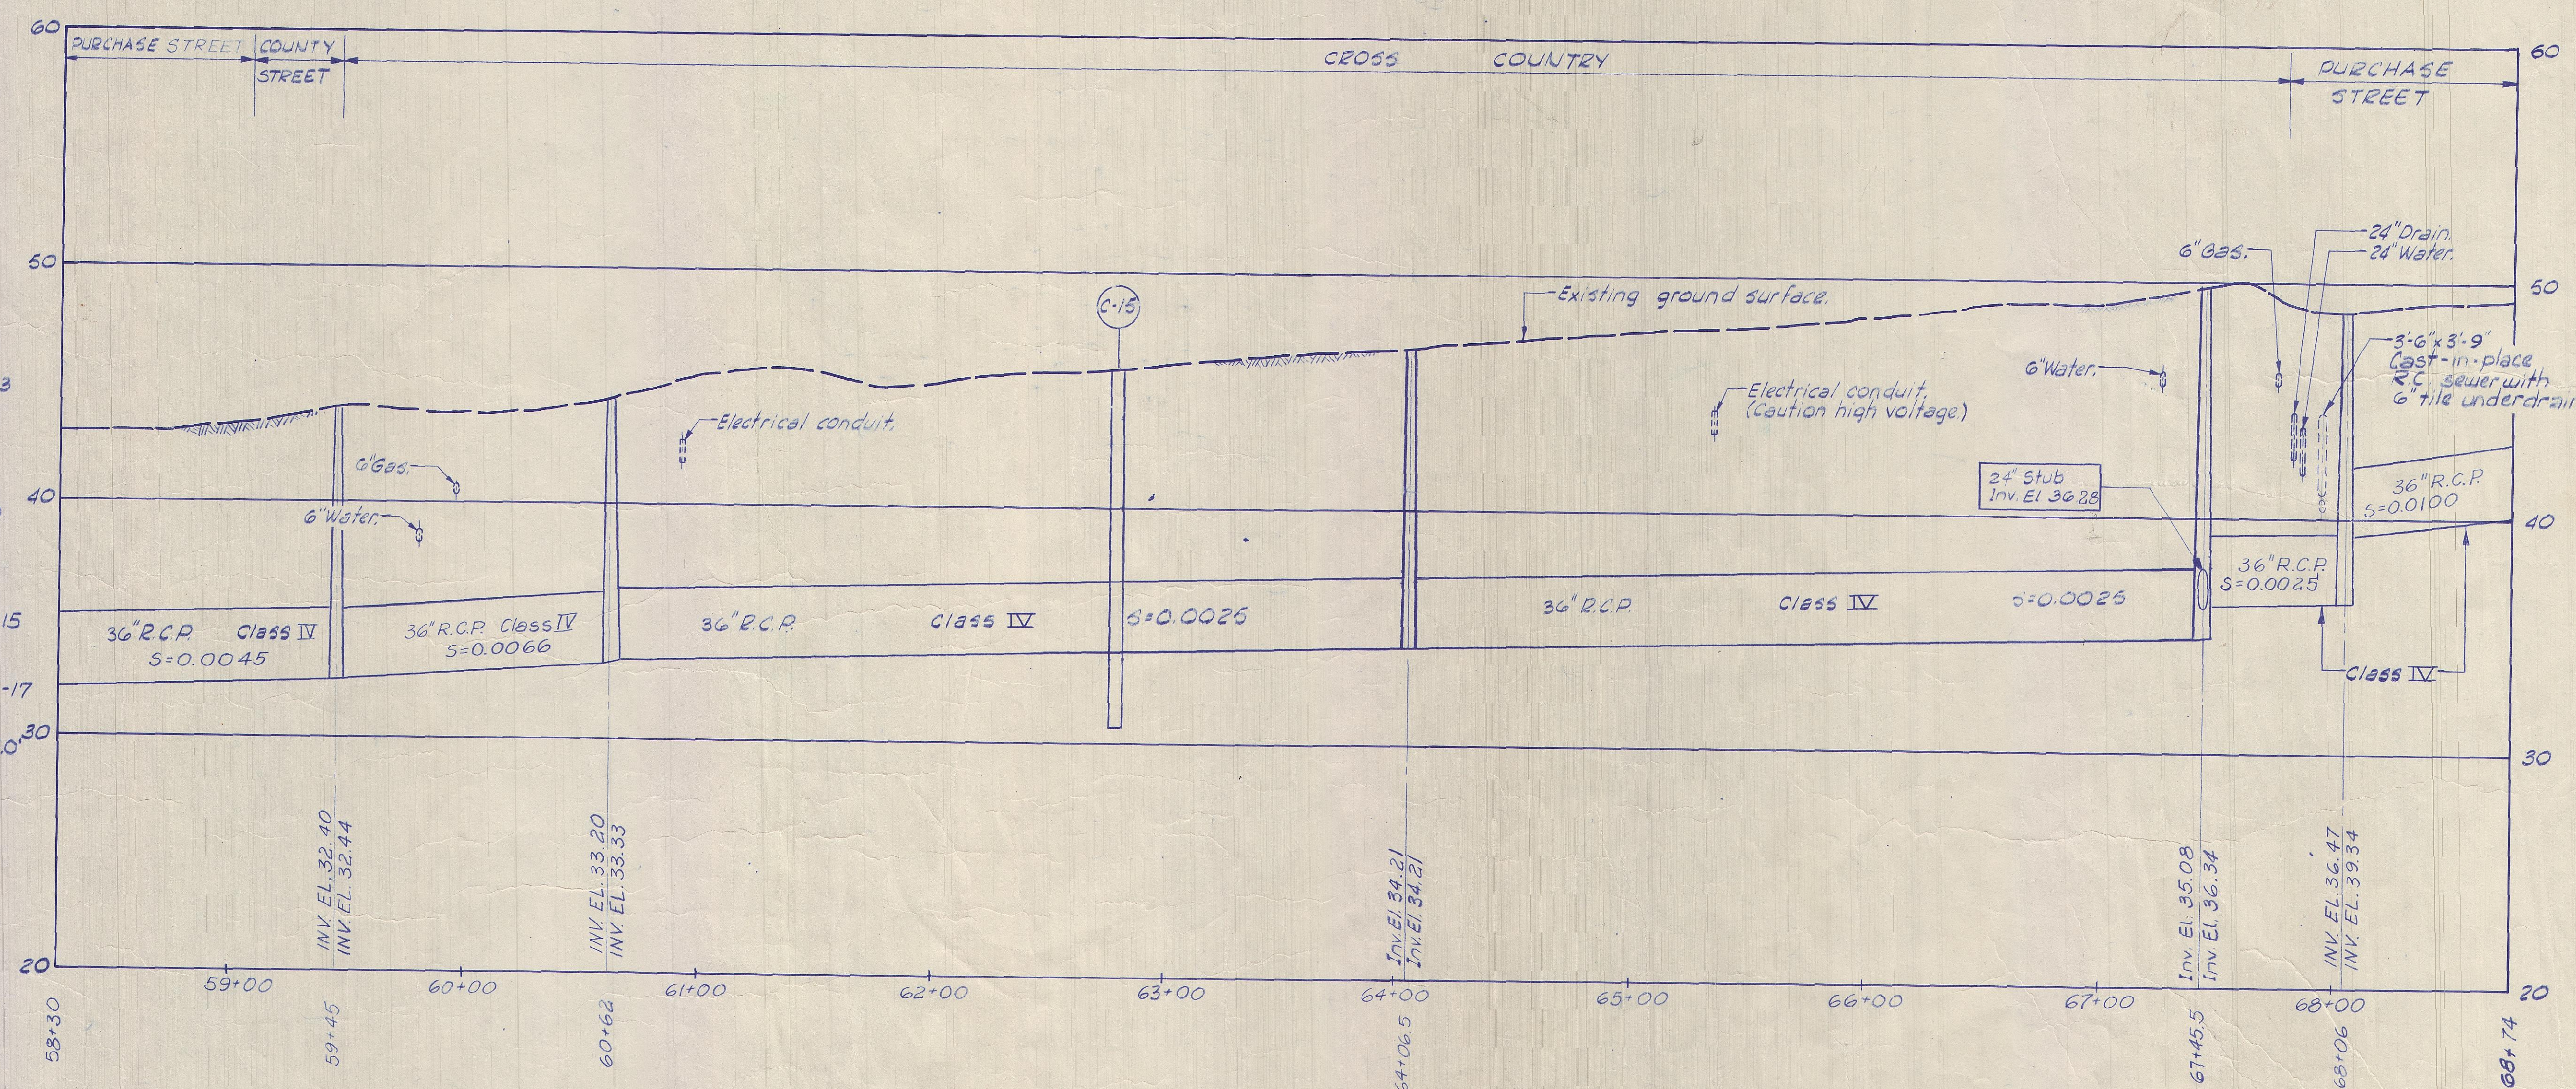


Remove and restore exist fence.
Light pole to be supported and
protected during excavation.

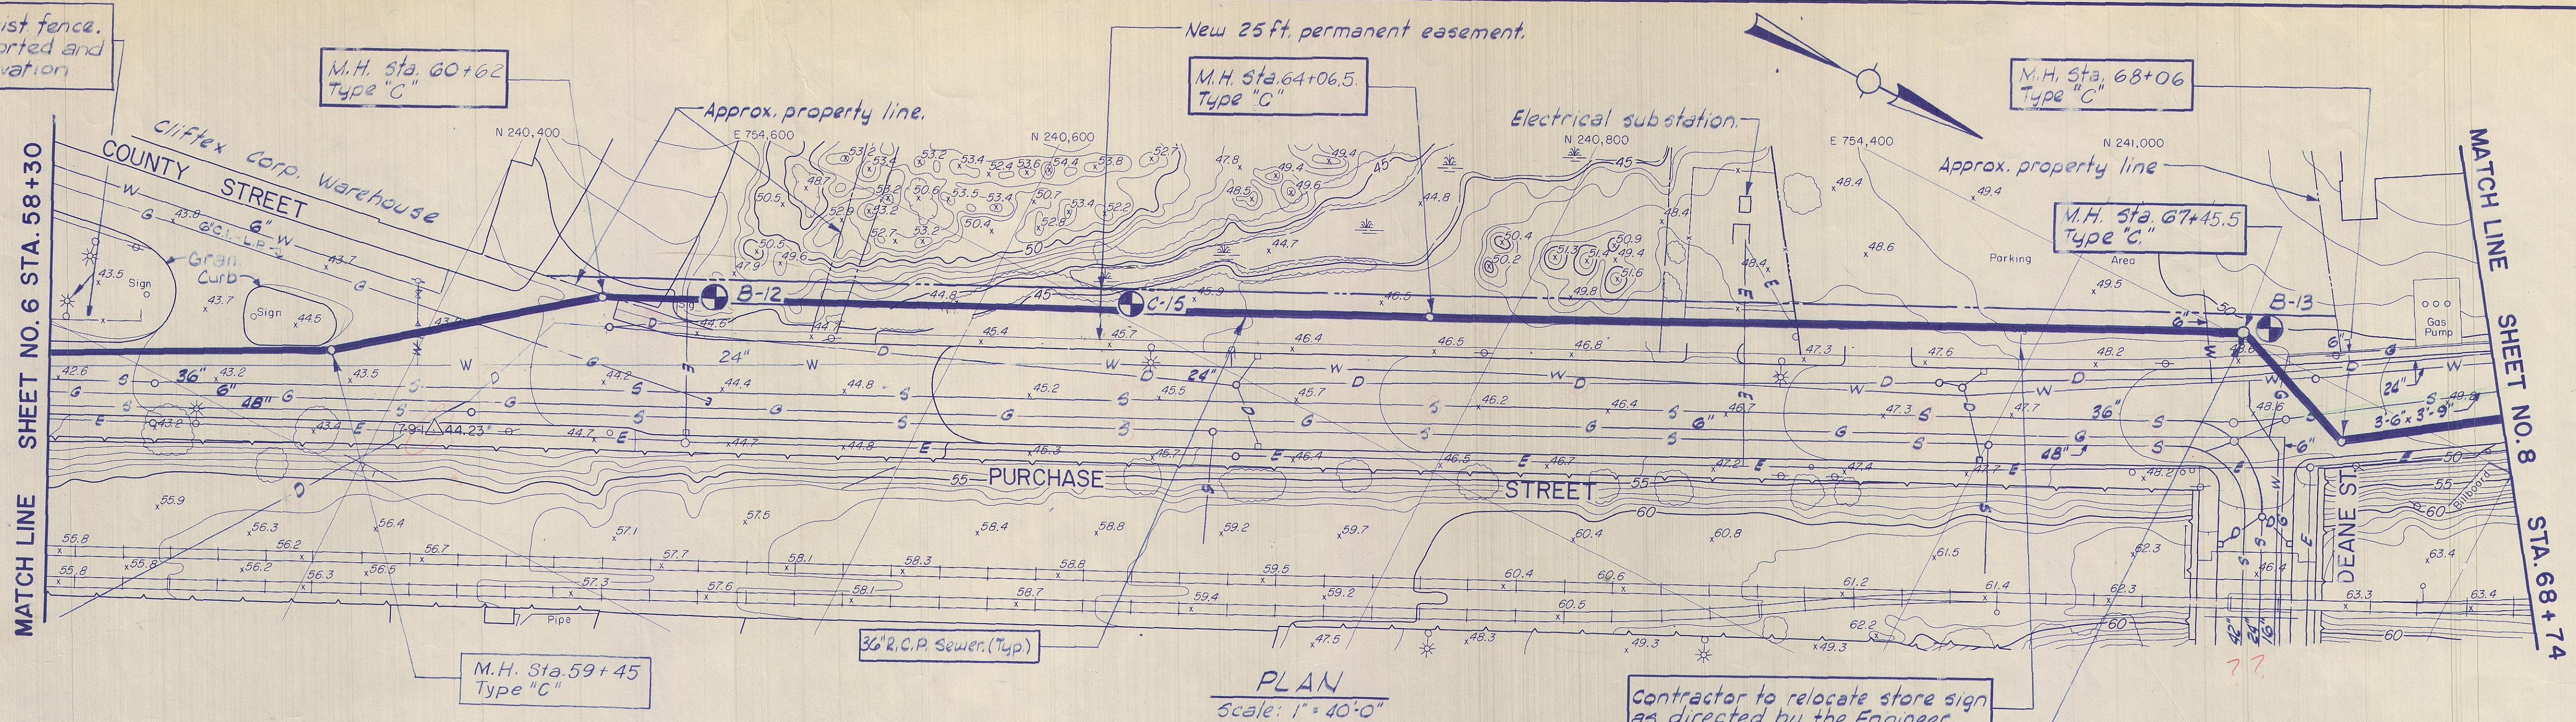

Med. compact sand, loam, cinders, wood fill	2-7-12-13
Soft silty peat trace fine gravel	3
Compact fine to med. sand trace silt	9-17-20
Med. compact to compact fine to med. sand some fine to med. gravel, little silt	14-16-13-15
	19-23-24-17

Bottom of boring 15.0' (El. 30.7)

Approved by:	Date	Name
Structural		
Electrical		
HVAC		
Project Engineer	9/77	P.B.D.
Project Manager	7/77	J.E. Fey

TELEDYNE GEOTRONICS
725 E. 3RD. ST.
LONG BEACH, CALIF. 90802

RECORD DRAWING

10/5/73	W.J.G.	AS-BUILT
Date	Ch'kd.	Revision
Designed by: PBD		
Drawn by: CHE		
Checked by: PBD		
Approved by: RCM		
Date: December, 1976		
Scale: As Noted		

CITY OF NEW BEDFORD, MASSACHUSETTS
DEPARTMENT OF PUBLIC WORKS
WATER POLLUTION ABATEMENT FACILITIES
NORTH END INTERCEPTOR RELIEF SEWER
PROJECT NO. B-21

STA. 58+30 TO STA. 68+74

CAMP DRESSER & McKEE Inc.
Consulting Engineers
Boston, Mass.

SHEET NO.
7
309-26287