


BRANCHES

No. 1 North of N. line of Sawyer St.	140
No. 2	1180
No. 3	2180
No. 4	3180
No. 5	4180
No. 6	5140
No. 7	6140
No. 8	7080
No. 9	8000
No. 10	101.00
No. 11	111.30
No. 12	120.50
No. 13	130.50
No. 14	139.00
No. 15	143.90
No. 16	153.50
No. 17	166.50
No. 18	179.50
No. 19	200.00
No. 20	203.00
No. 21	220.00
No. 22	240.00
No. 23	259.50
No. 24	279.20
No. 25	298.00
No. 26	315.70
No. 27	334.70
No. 28	353.00
No. 29	371.70
No. 30	391.00
No. 31	409.10

BRANCHES

No. 31 North of N. line of Sawyer St.	
No. 32	
No. 33	
No. 34	
No. 35	
No. 36	
No. 37	
No. 38	
No. 39	
No. 40	
No. 41	
No. 42	
No. 43	
No. 44	
No. 45	
No. 46	
No. 47	
No. 48	
No. 49	
No. 50	
No. 51	
No. 52	
No. 53	
No. 54	
No. 55	
No. 56	
No. 57	
No. 58	
No. 59	
No. 60	

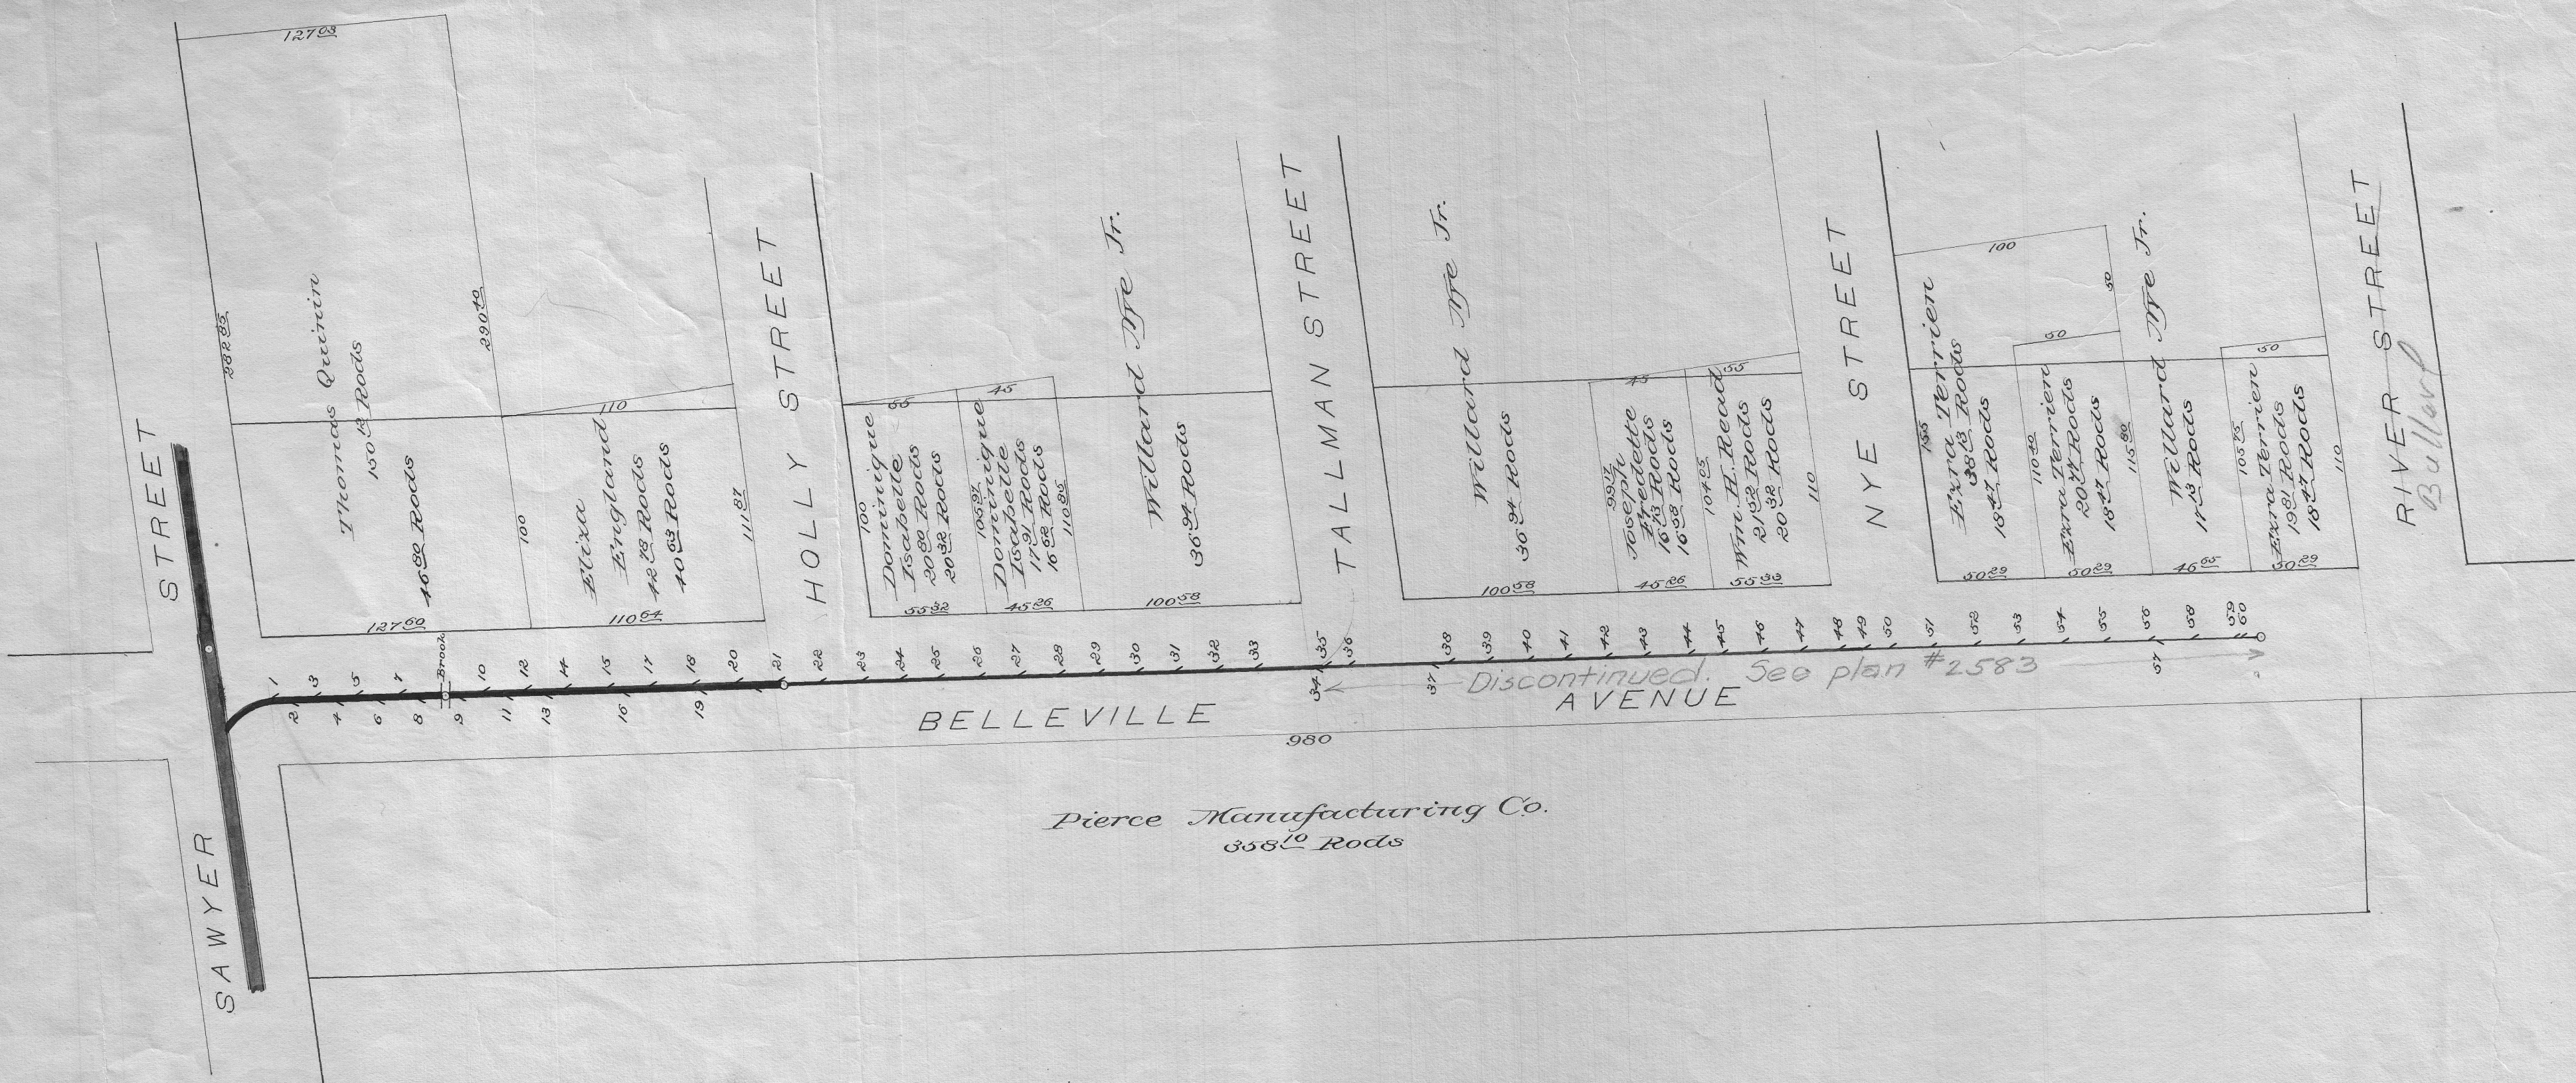

MANHOLES

- No. 1 - 54 ft. North of N. line of Sawyer
- No. 2 - 5 ft. North of S. line of Holly
- No. 3 - 538.70 ft. N. of N. line of Sawyer


LENGTH

362.70 feet of sewer

SCALE

1 inch equals 60 ft.

PARTLY DISCONTINUED (See Plan and Profile; also plan #2583)

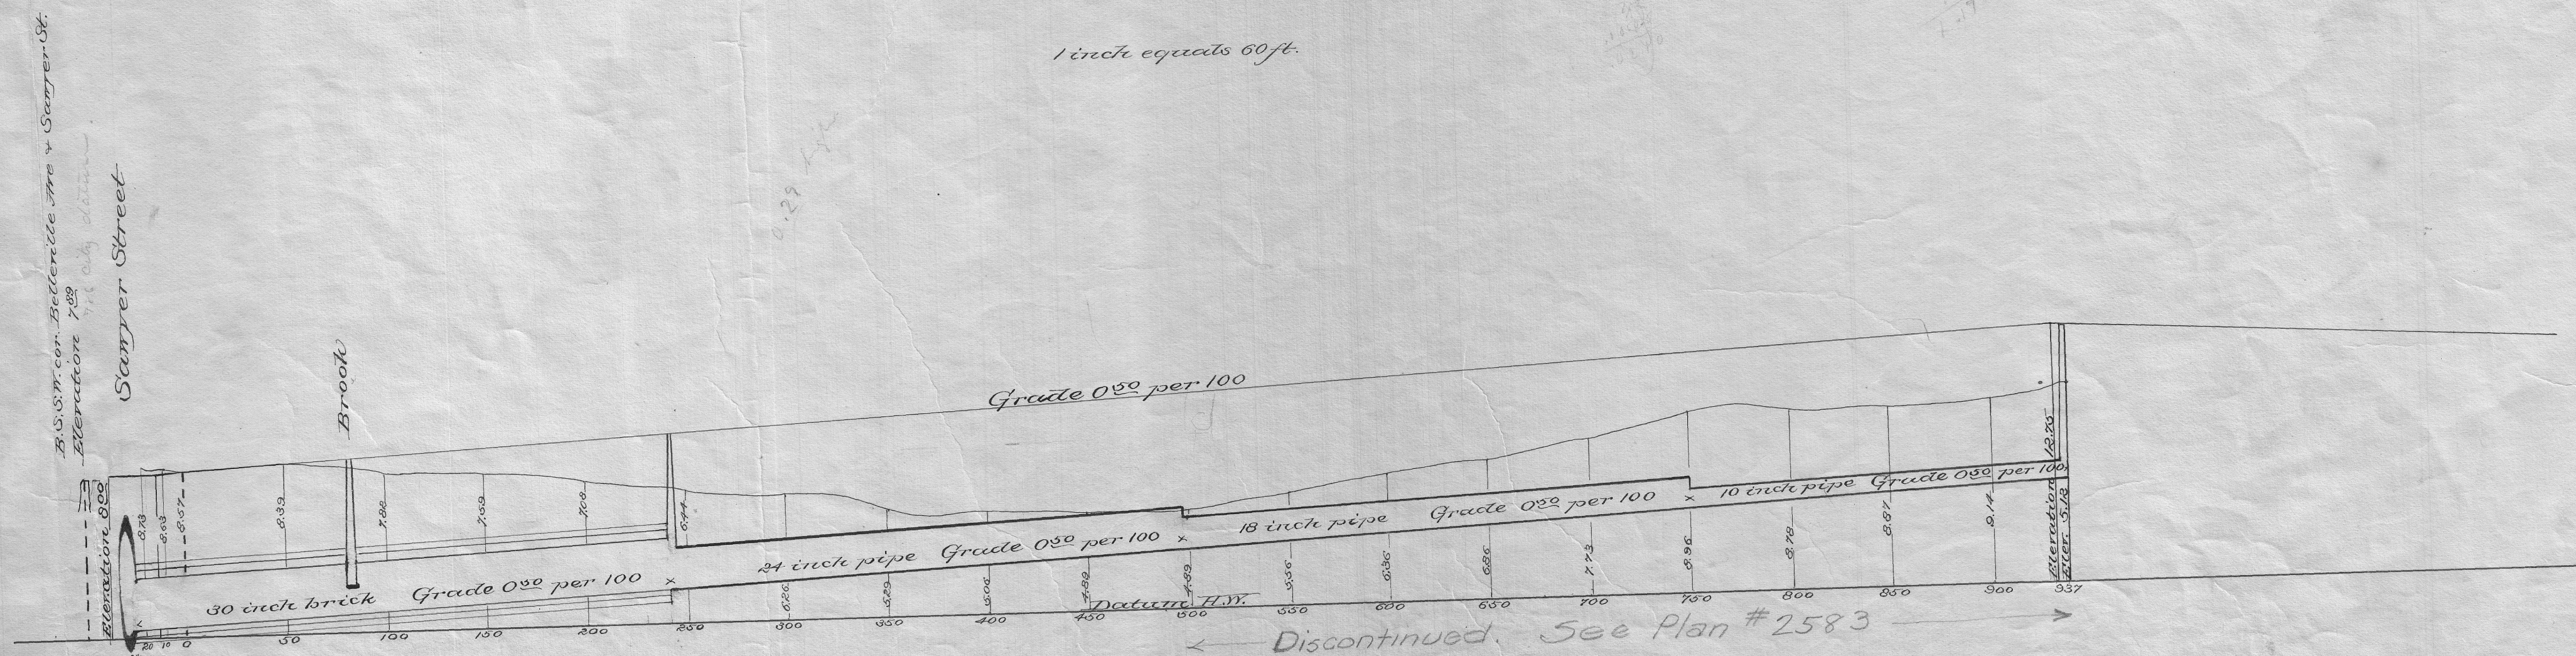

NOTE BOOK, 13 - P. 42
 SURVEY BY *J. H. H. H.*
 PLAN BY *J. H. H. H.*
 COPY BY *J. H. H. H.*
 CHECKED *J. H. H. H.*