
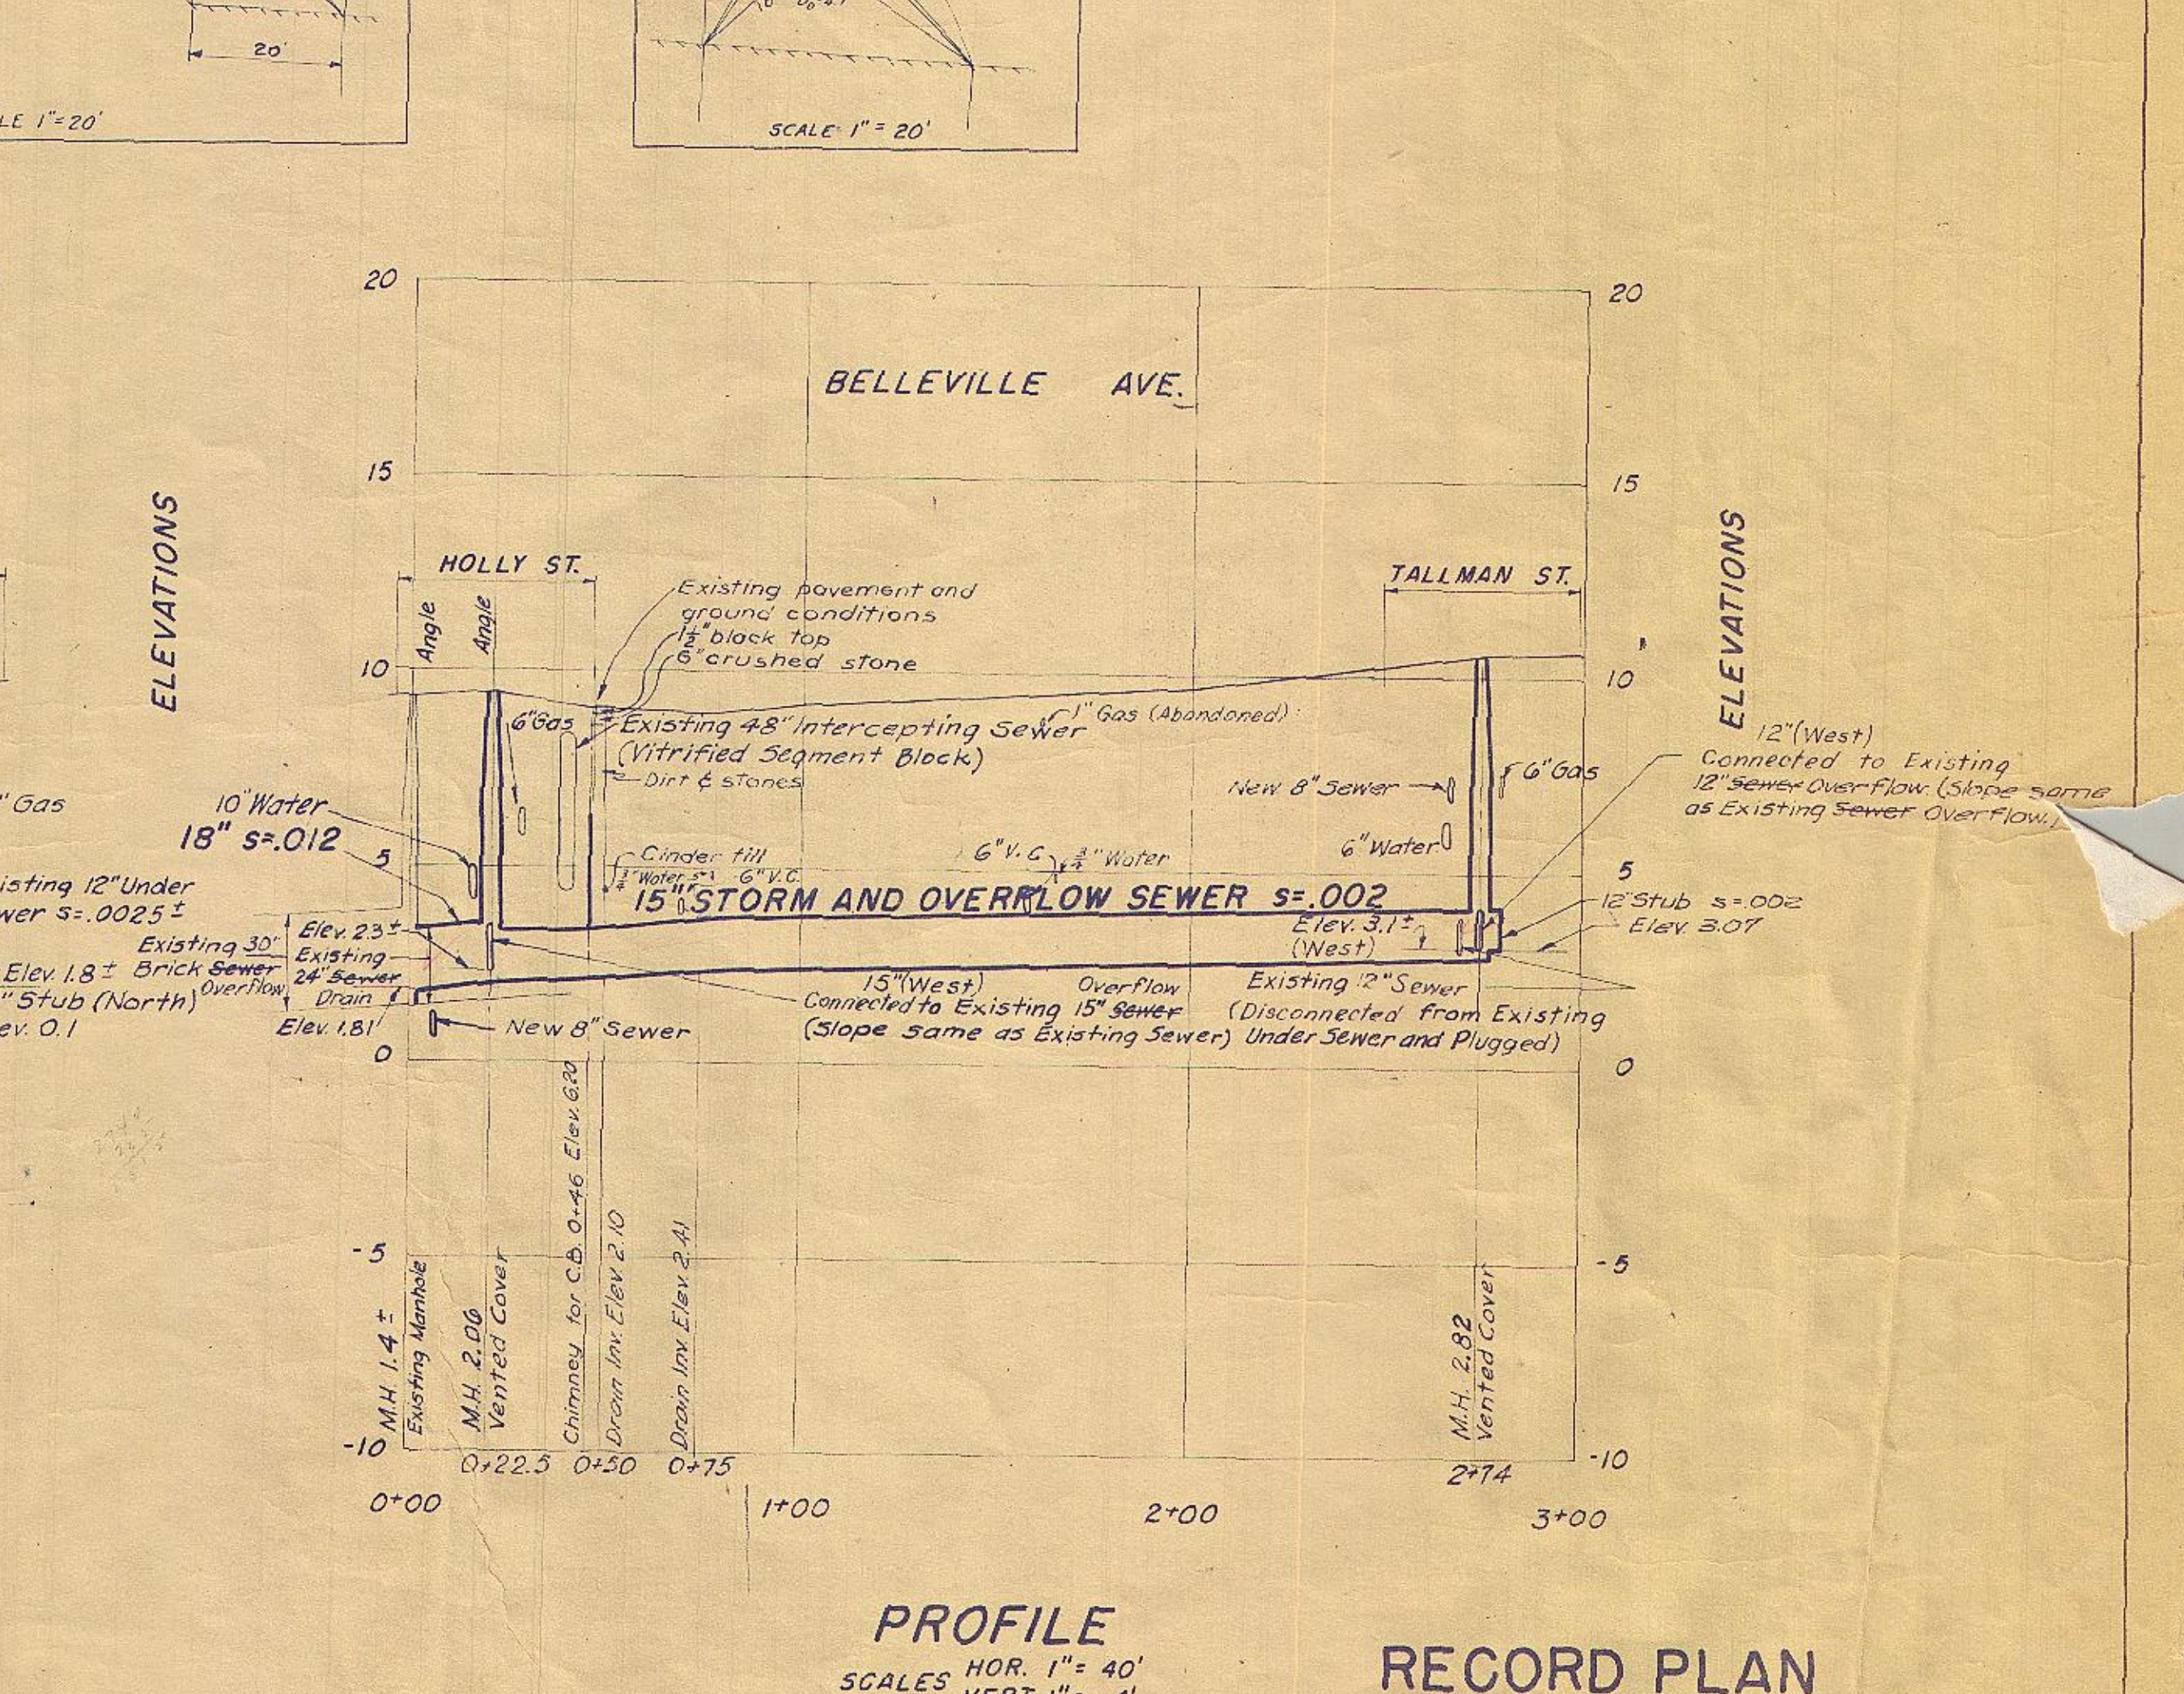
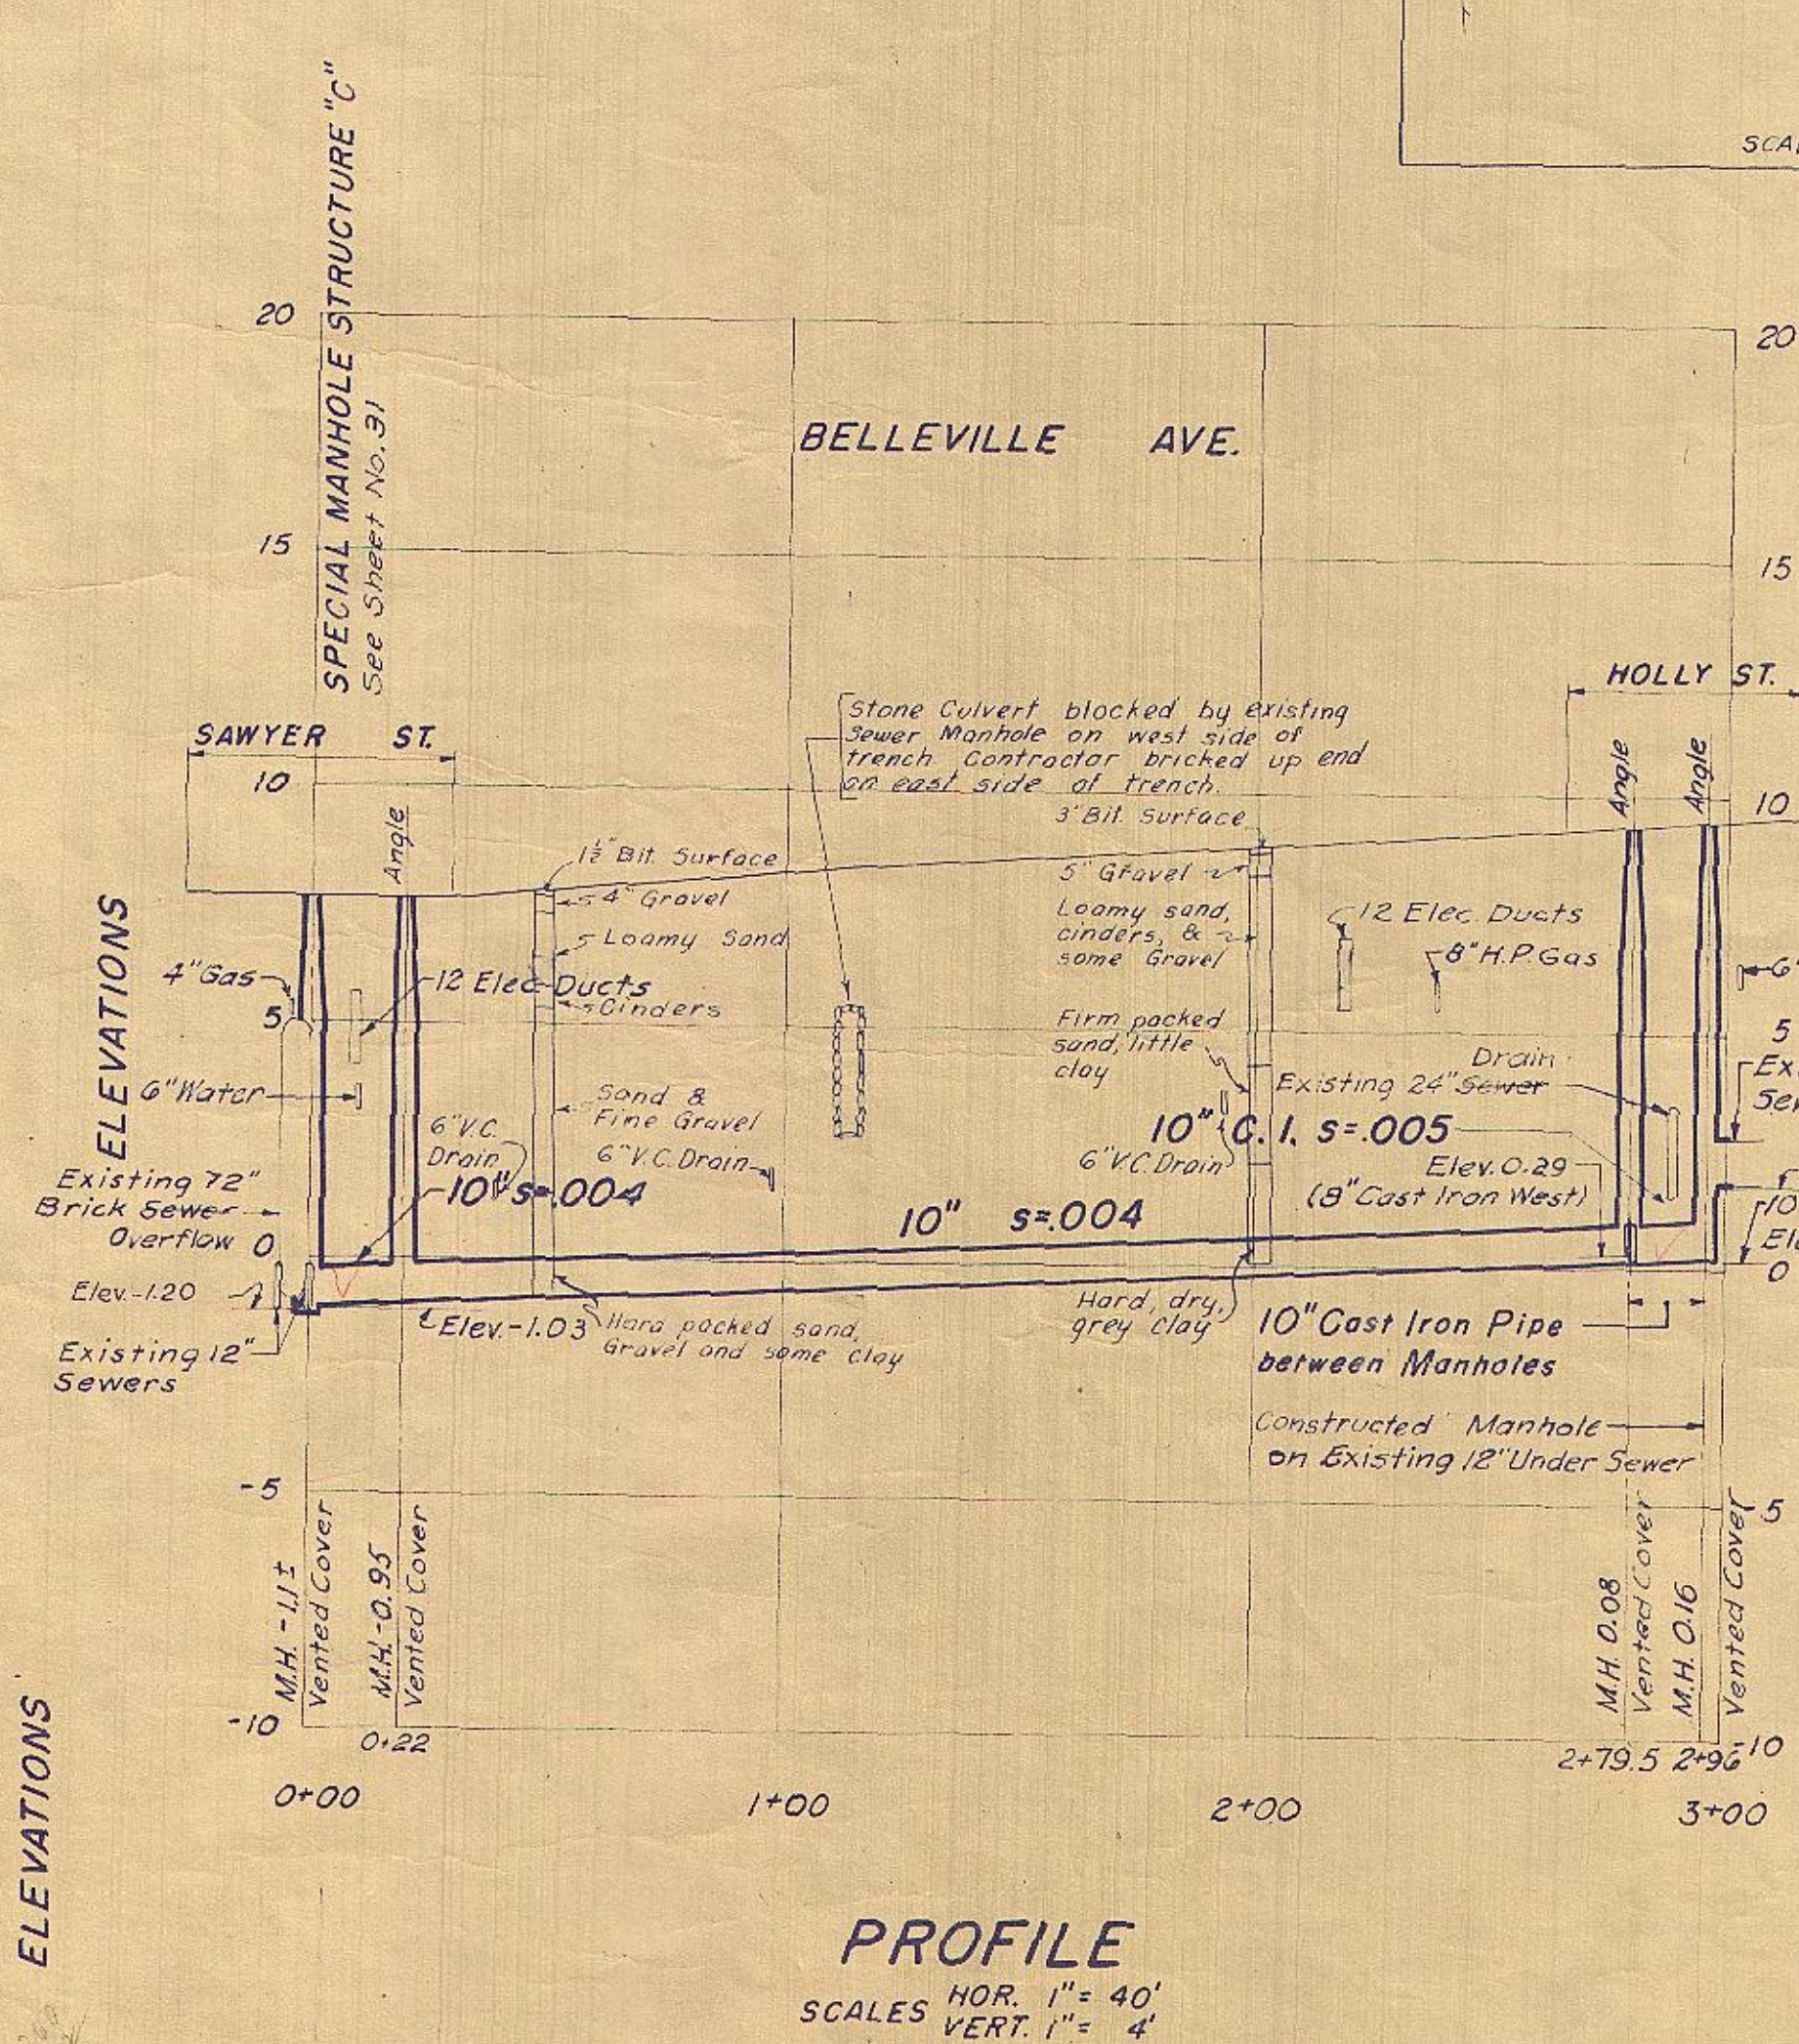
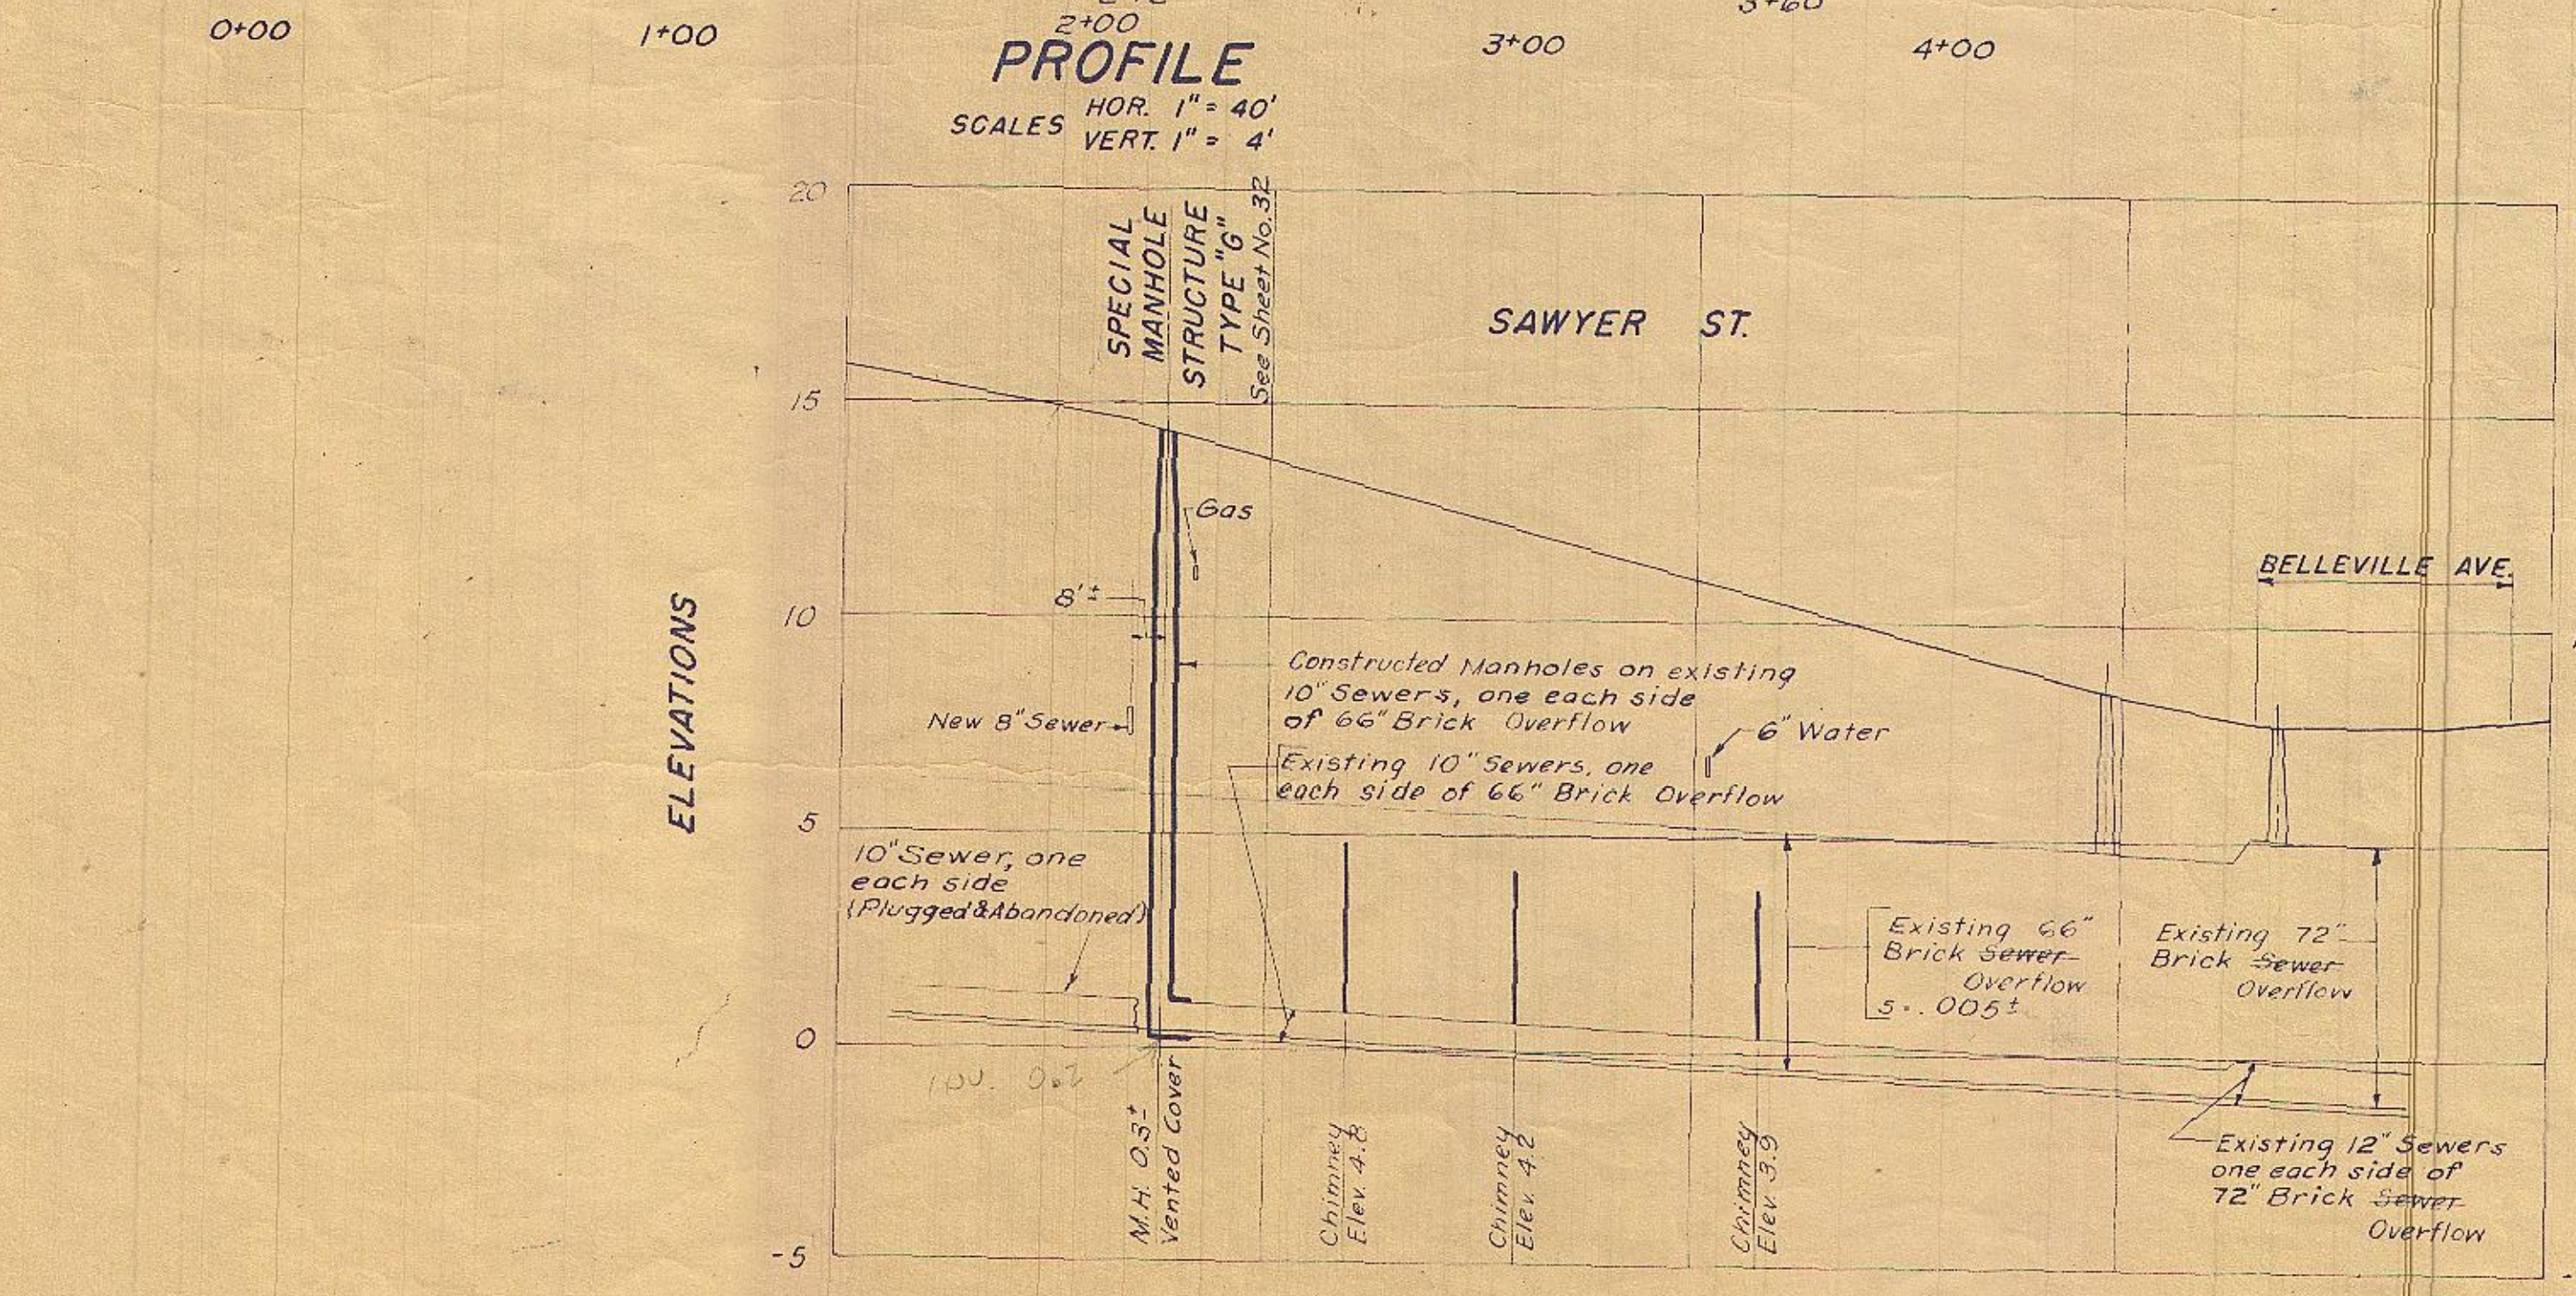
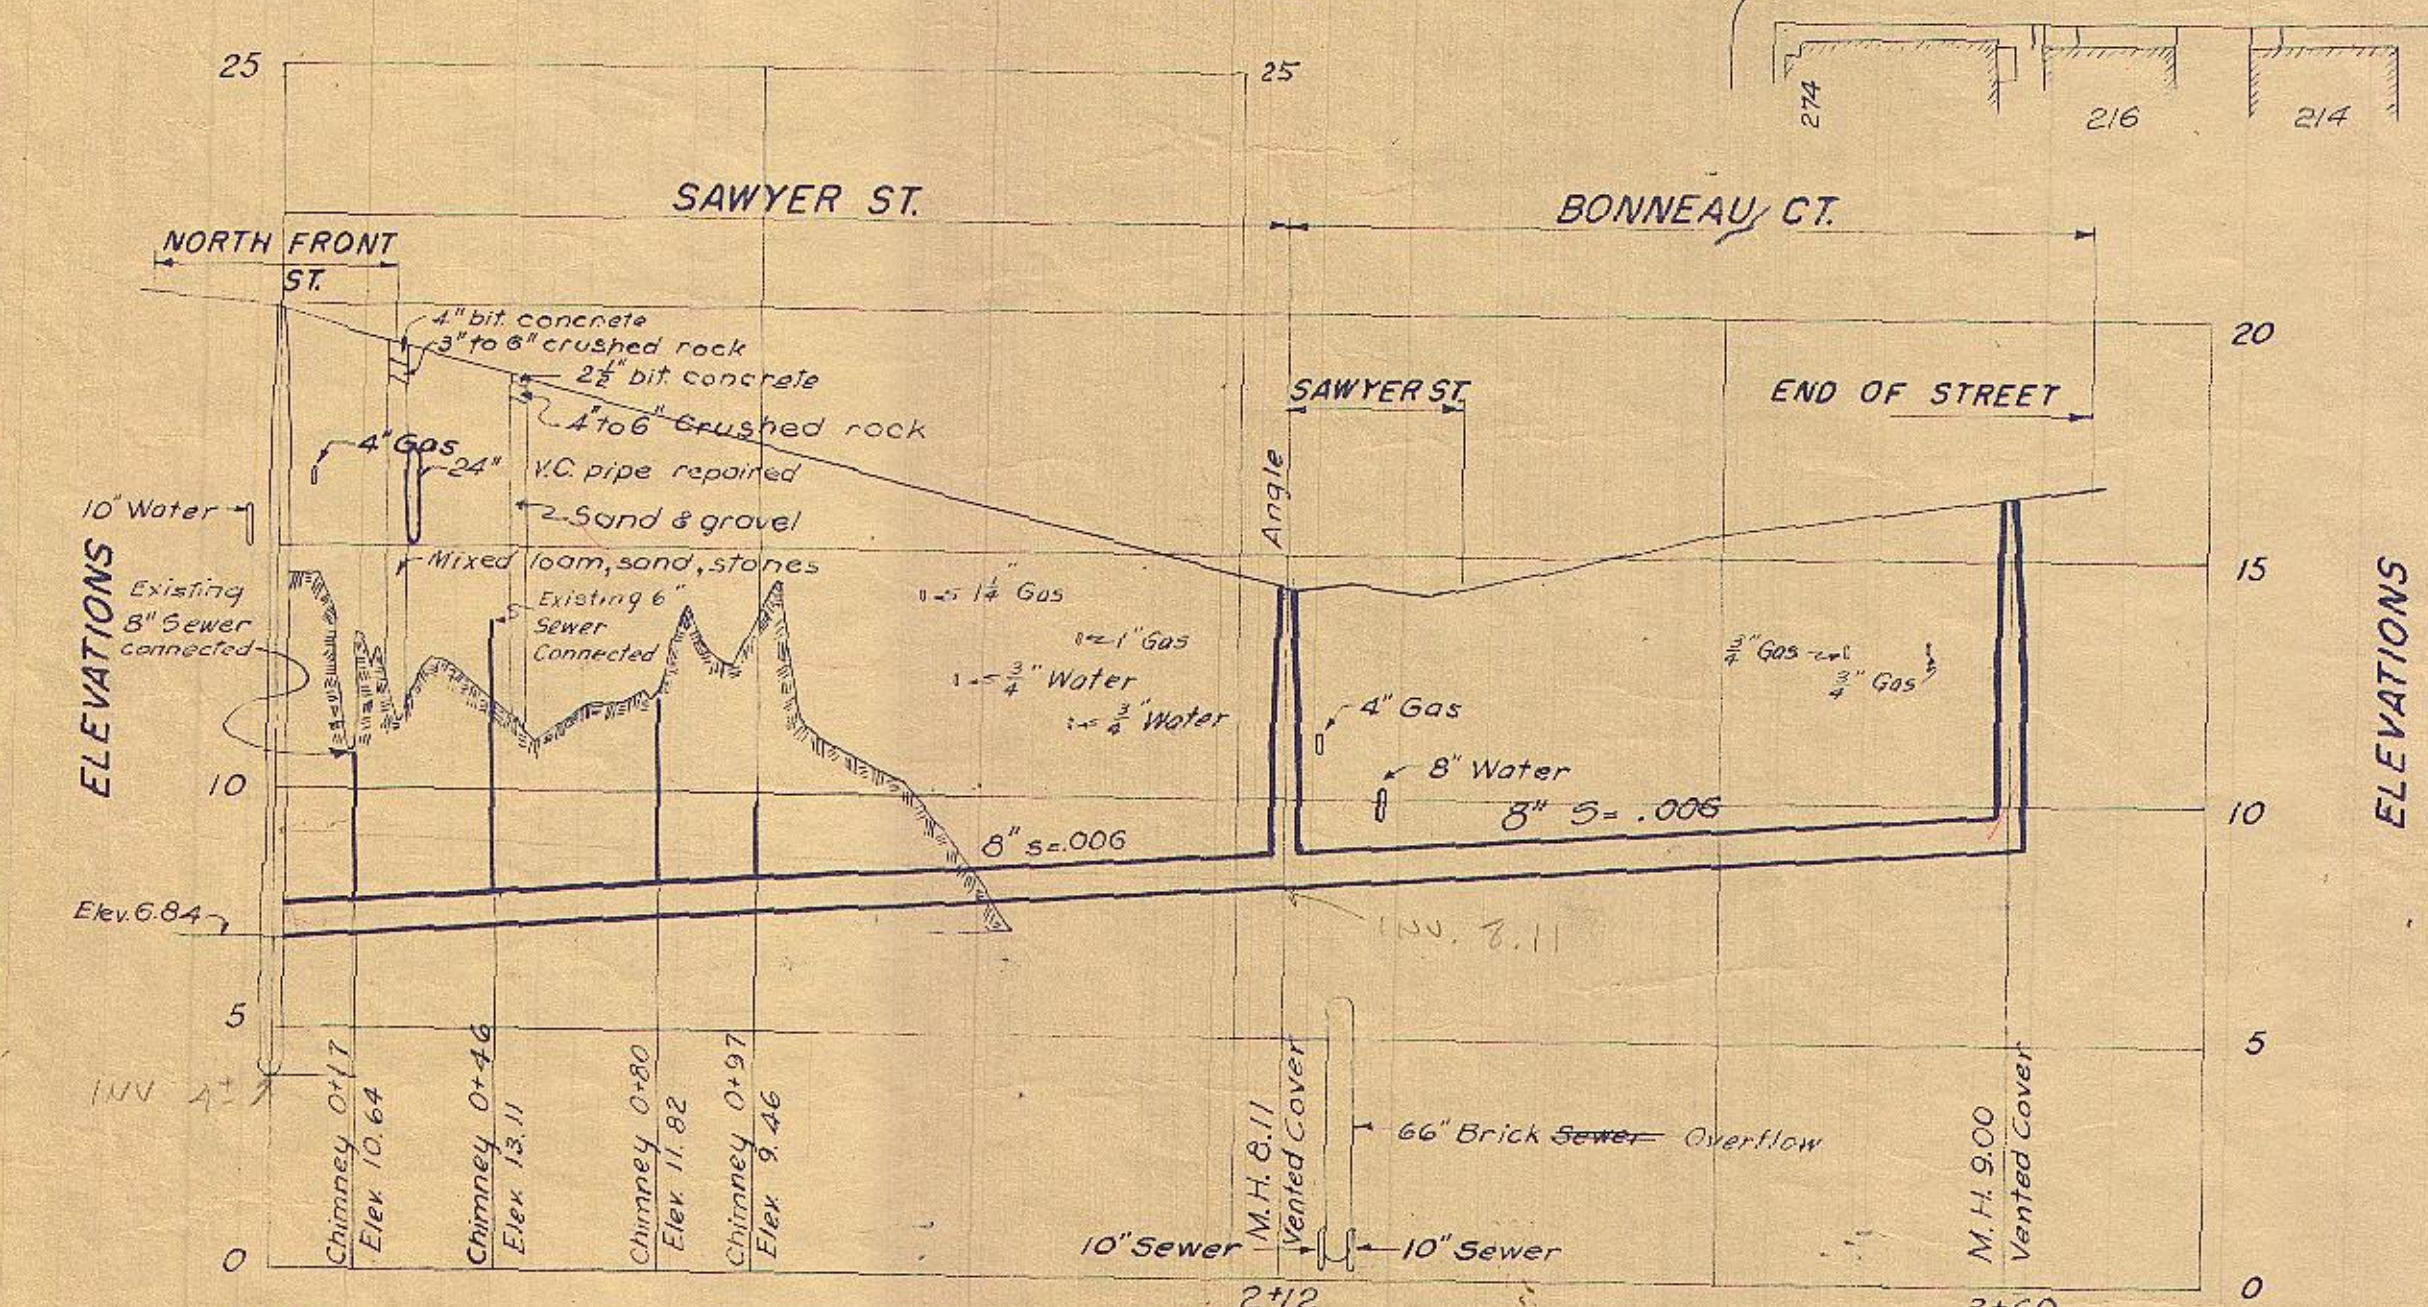


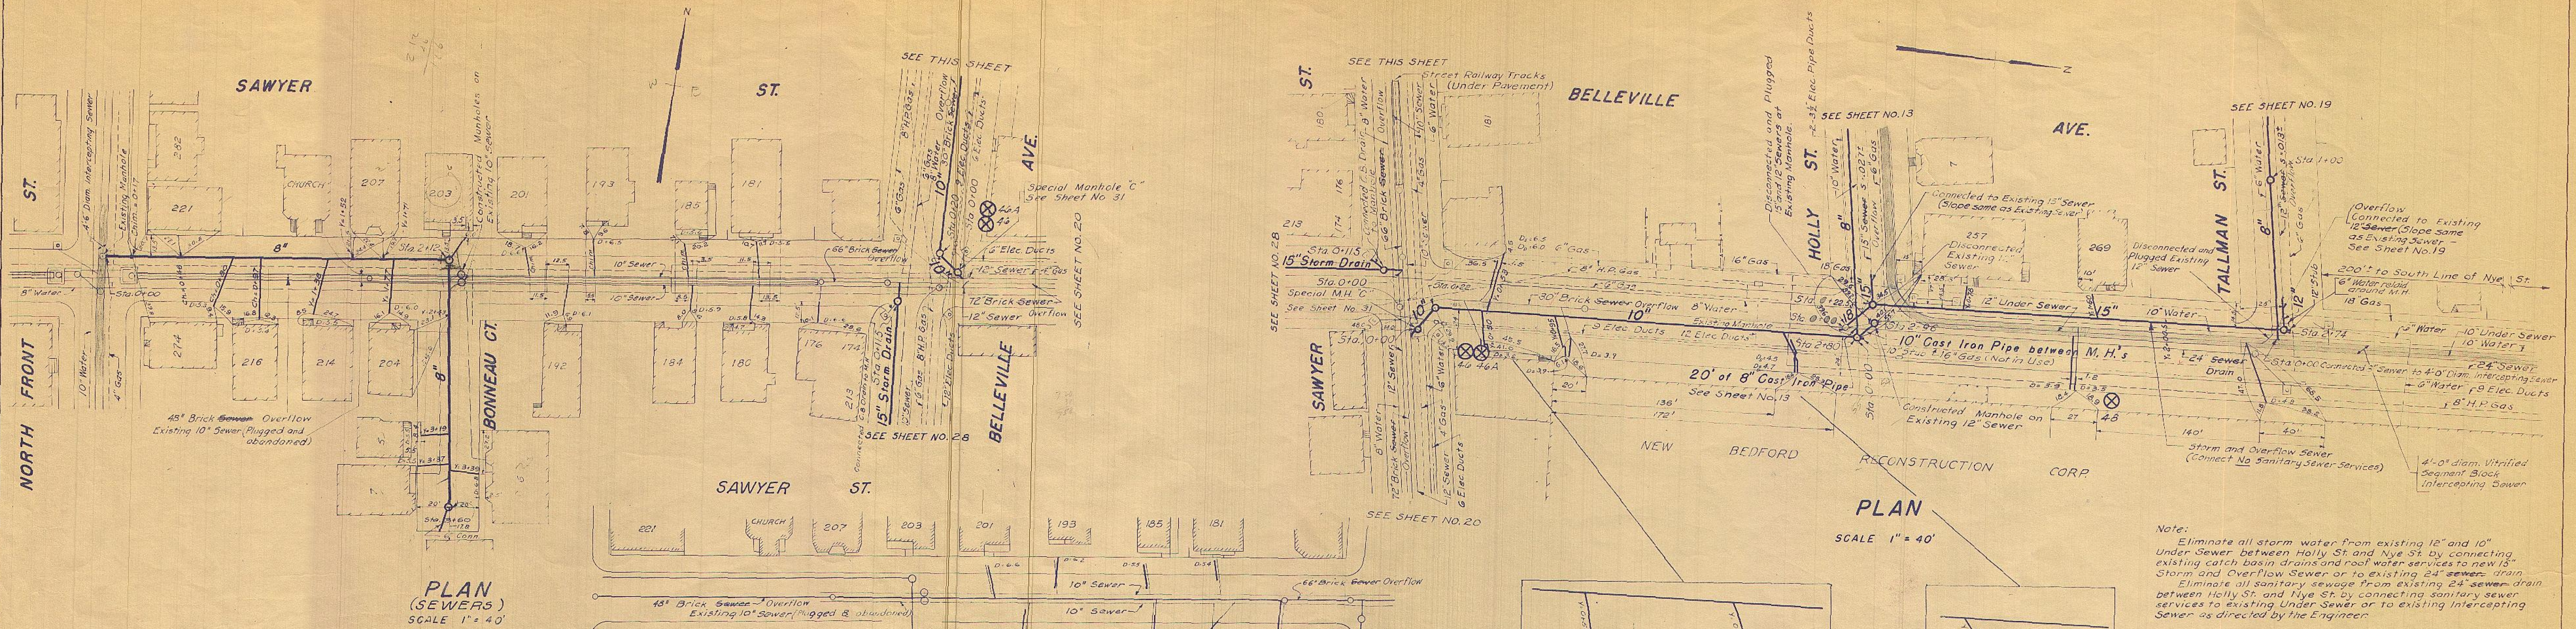

RECORD PLAN

NEW BEDFORD, MASSACHUSETTS
DEPARTMENT OF PUBLIC WORKS

ADDITIONS TO INTERCEPTING SEWER SYSTEM

SEWERS
SAWYER ST. (NORTH FRONT ST. TO BONNEAU CT.)
BONNEAU CT. (SOUTH OF SAWYER ST.)
BELLEVILLE AVE. (HOLLY ST. TO TALLMAN ST.)
BELLEVILLE AVE. (SAWYER ST. TO HOLLY ST.)

SCALE AS NOTED
FAY, SPOFFORD & THORNDIKE, ENGINEERS, BOSTON, MASS.
OCT. 1948

DES. C.R.S. TR. A.R.B. FILE NO. Jn-1
DR. G.R. CH. G.C.C. CSM, C.R.S. PLAN NO. 28

APPROVED *R. W. Horne*

CONTRACT DRAWING SHEET NO. 21 OF 33

REV. NO.	DATE	DESCRIPTION	MADE BY	CHK. BY	APP. BY
1	2-51	Revised as built	BLS HTK	GCC	K
REVISIONS					