


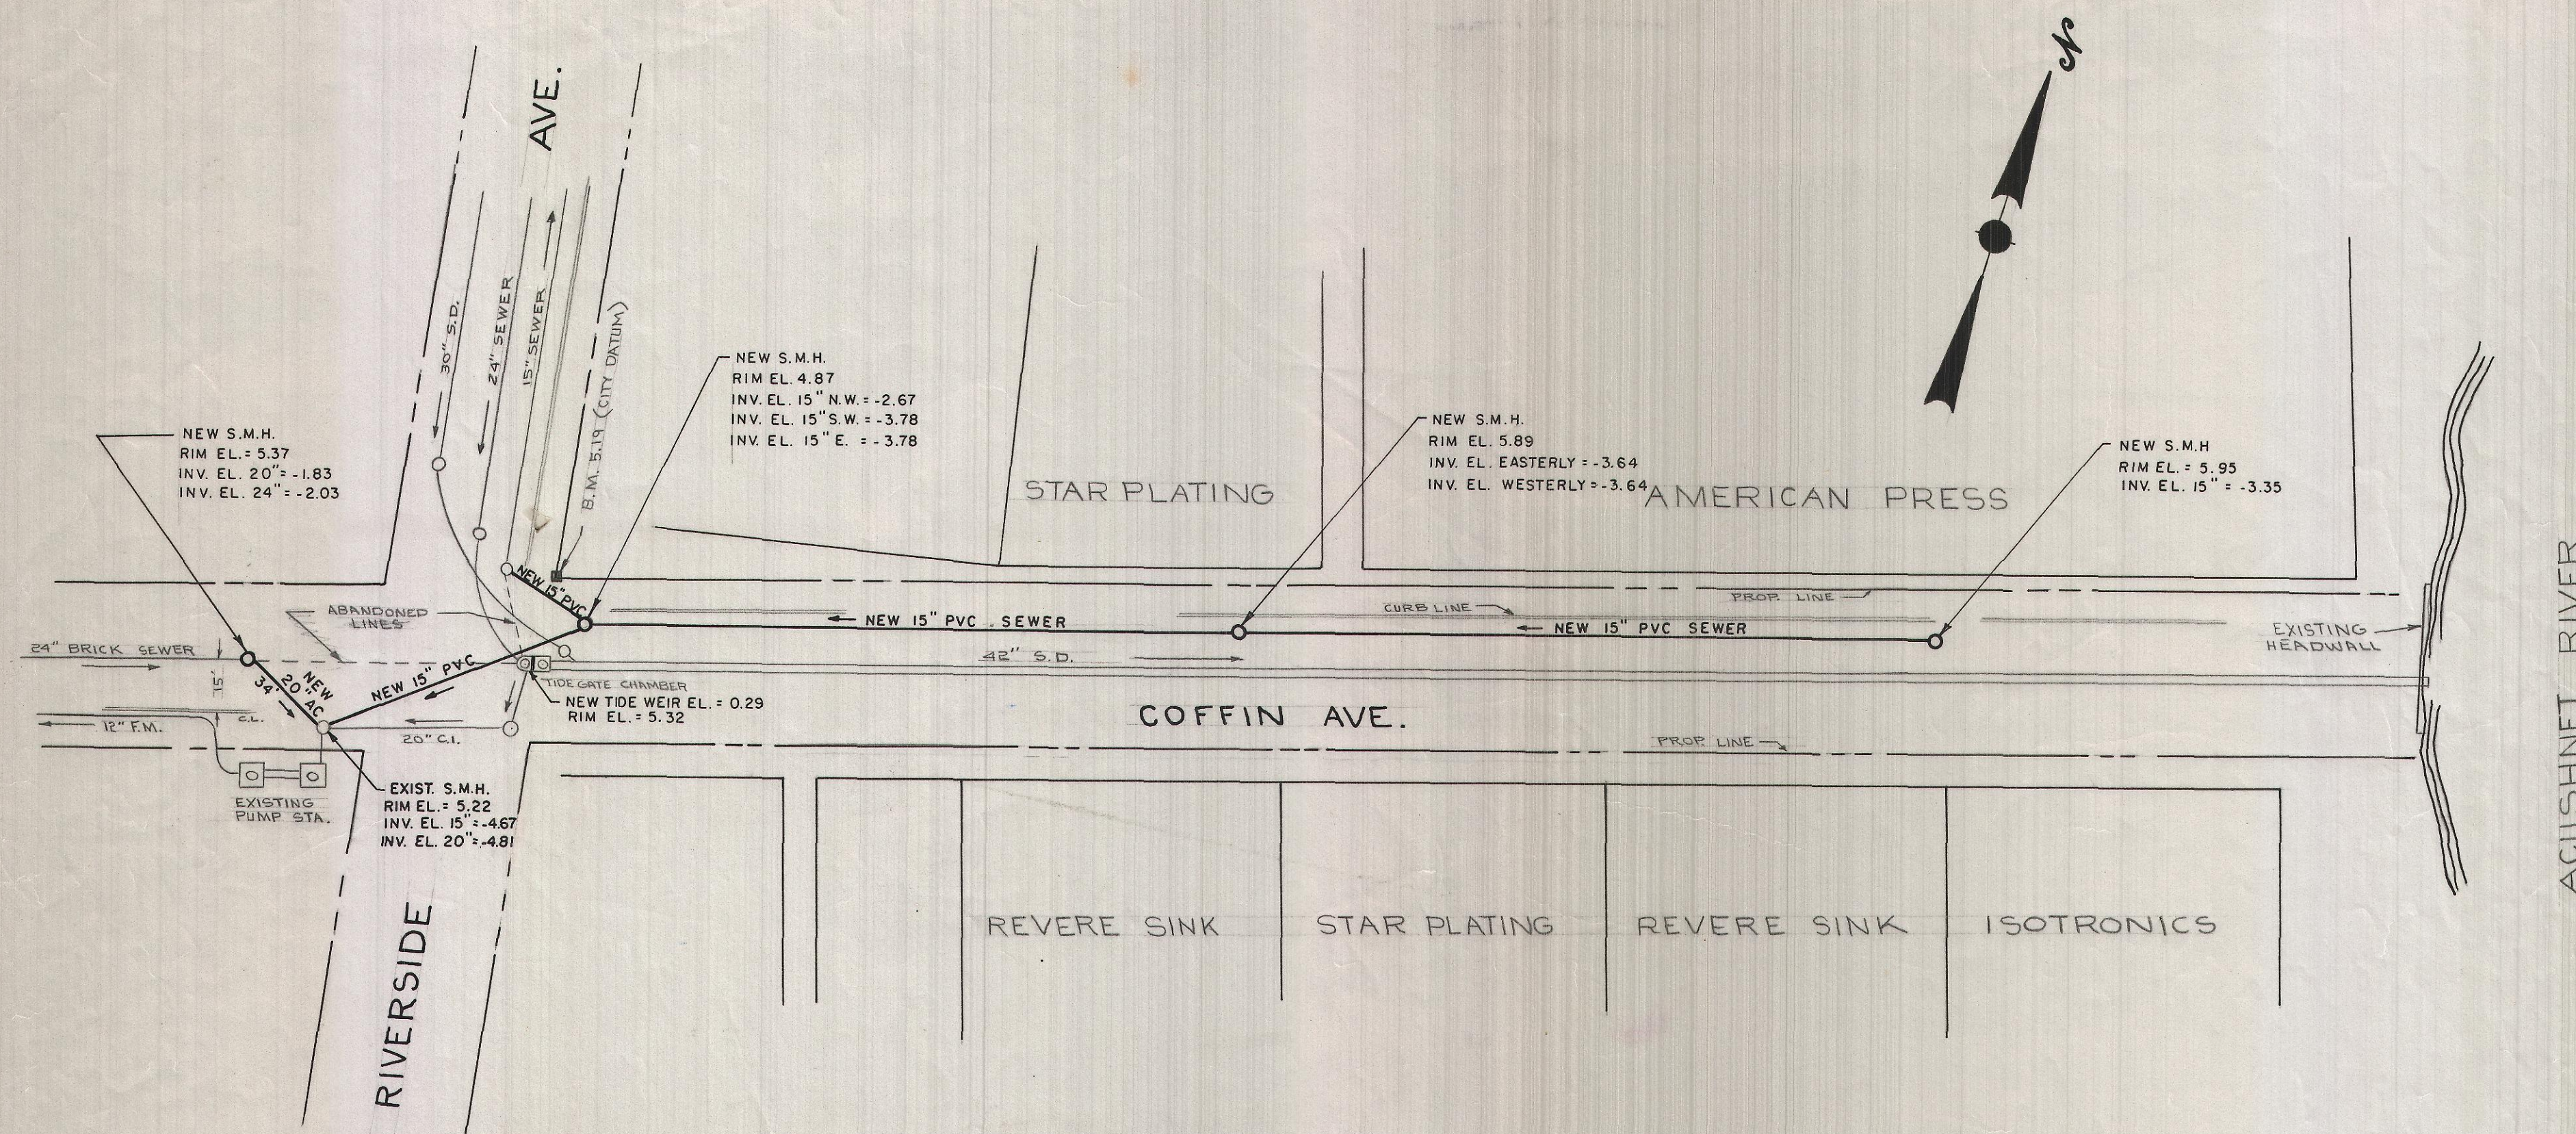

AS BUILT SEWER
COFFIN AVENUE
FROM RIVERSIDE AVE. EASTERLY

SCALE: 1" = 40'

DATE: 6 / 5 / 85

D.P.W. ENGINEERING DIVISION
NEW BEDFORD, MASS.

Robert J. Conto
COMMISSIONER OF PUBLIC WORKS