

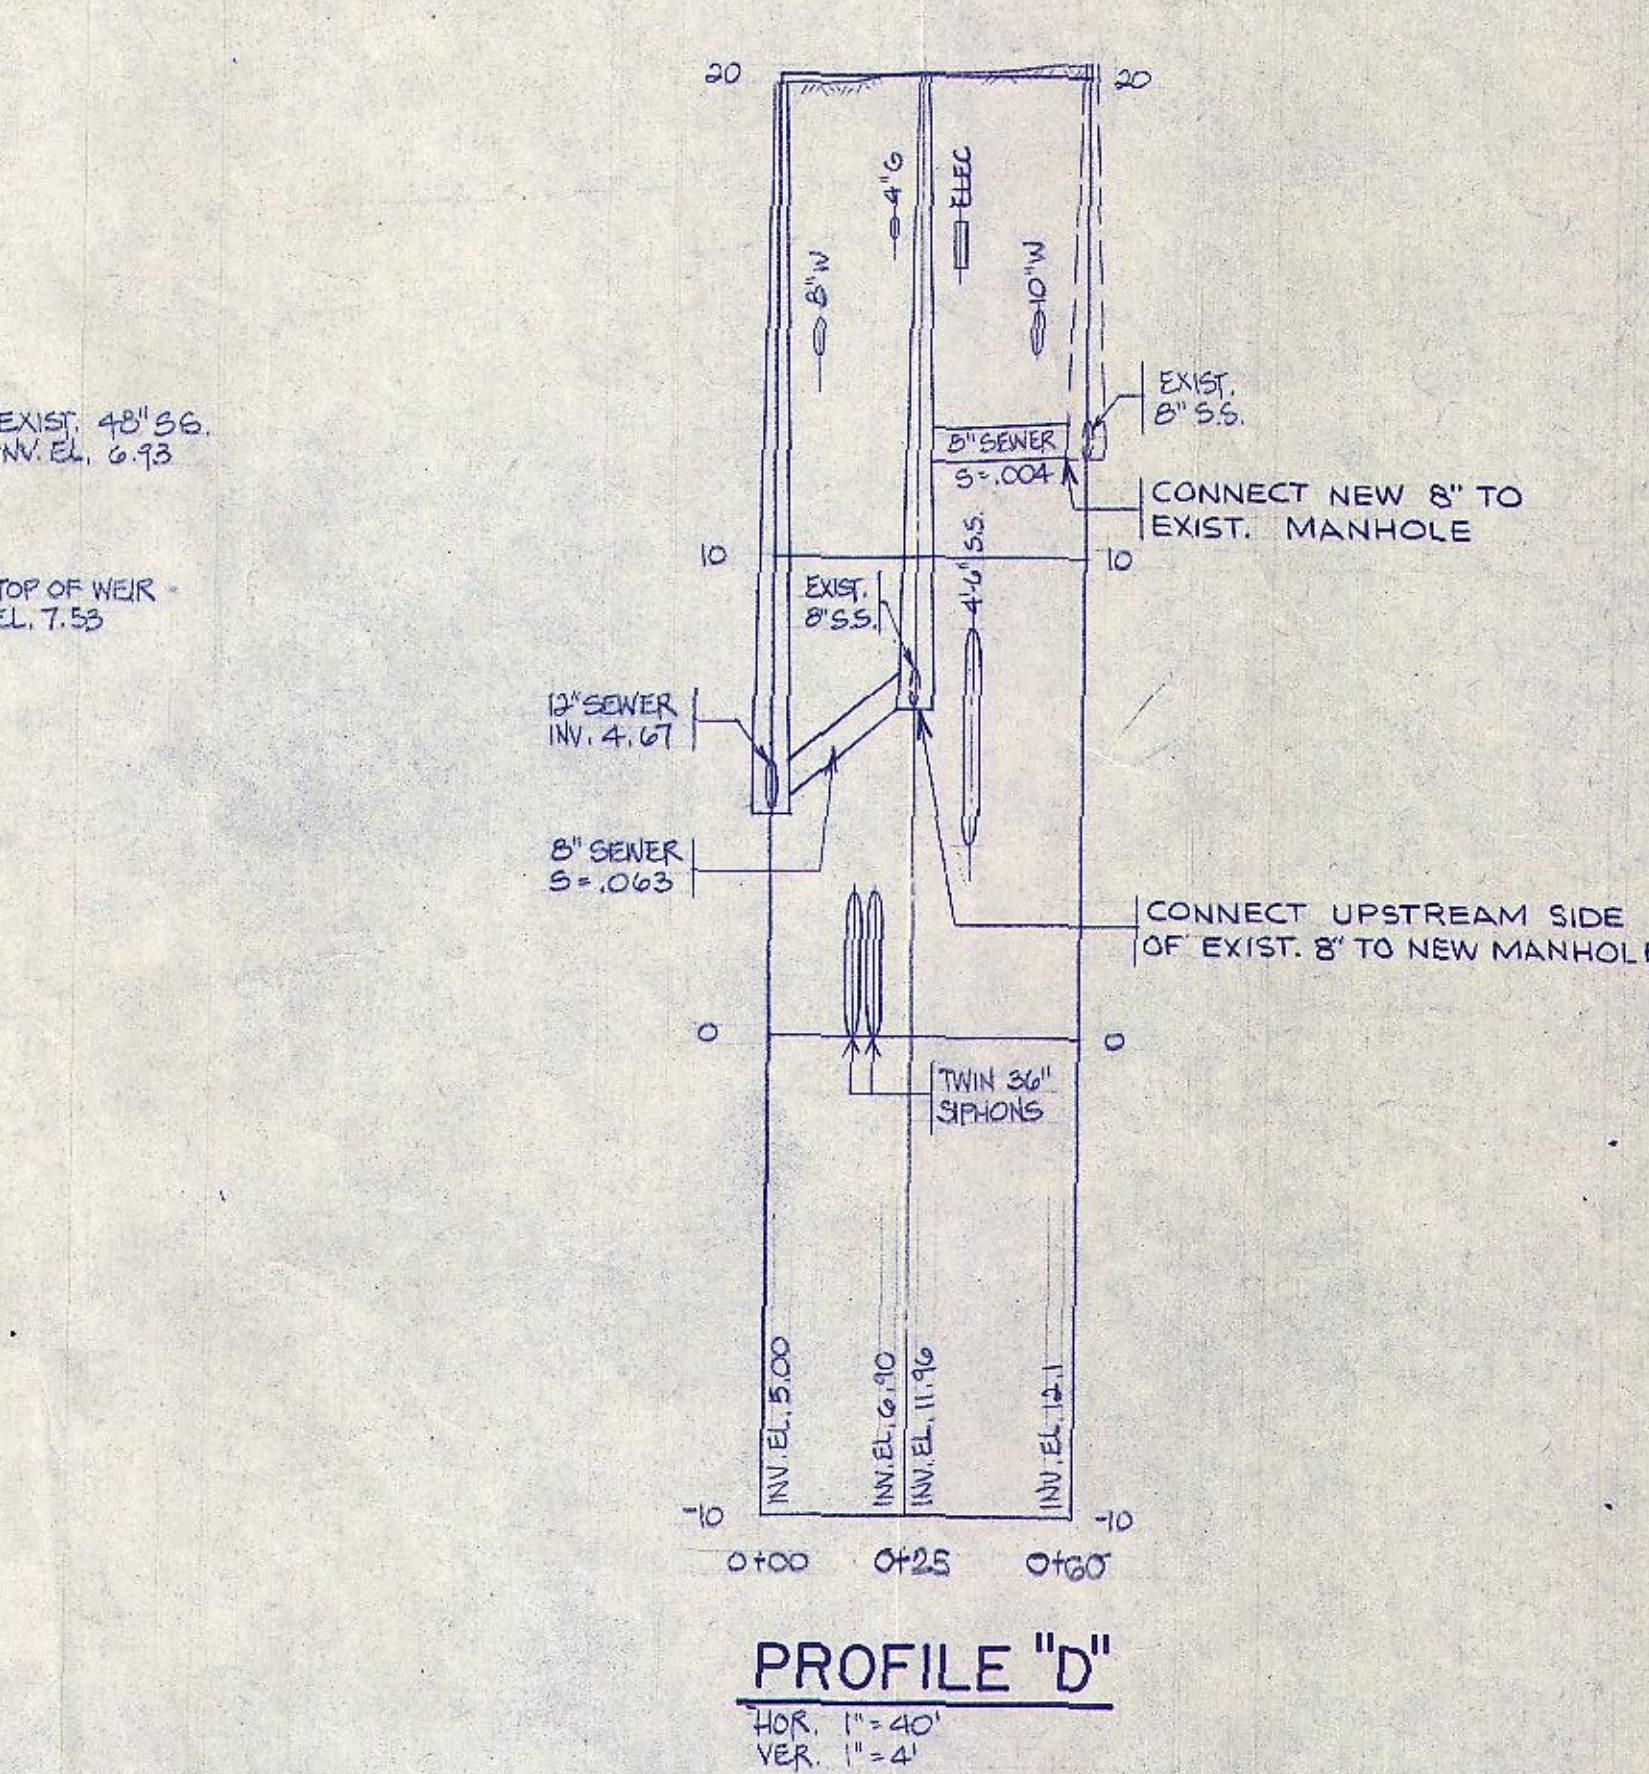
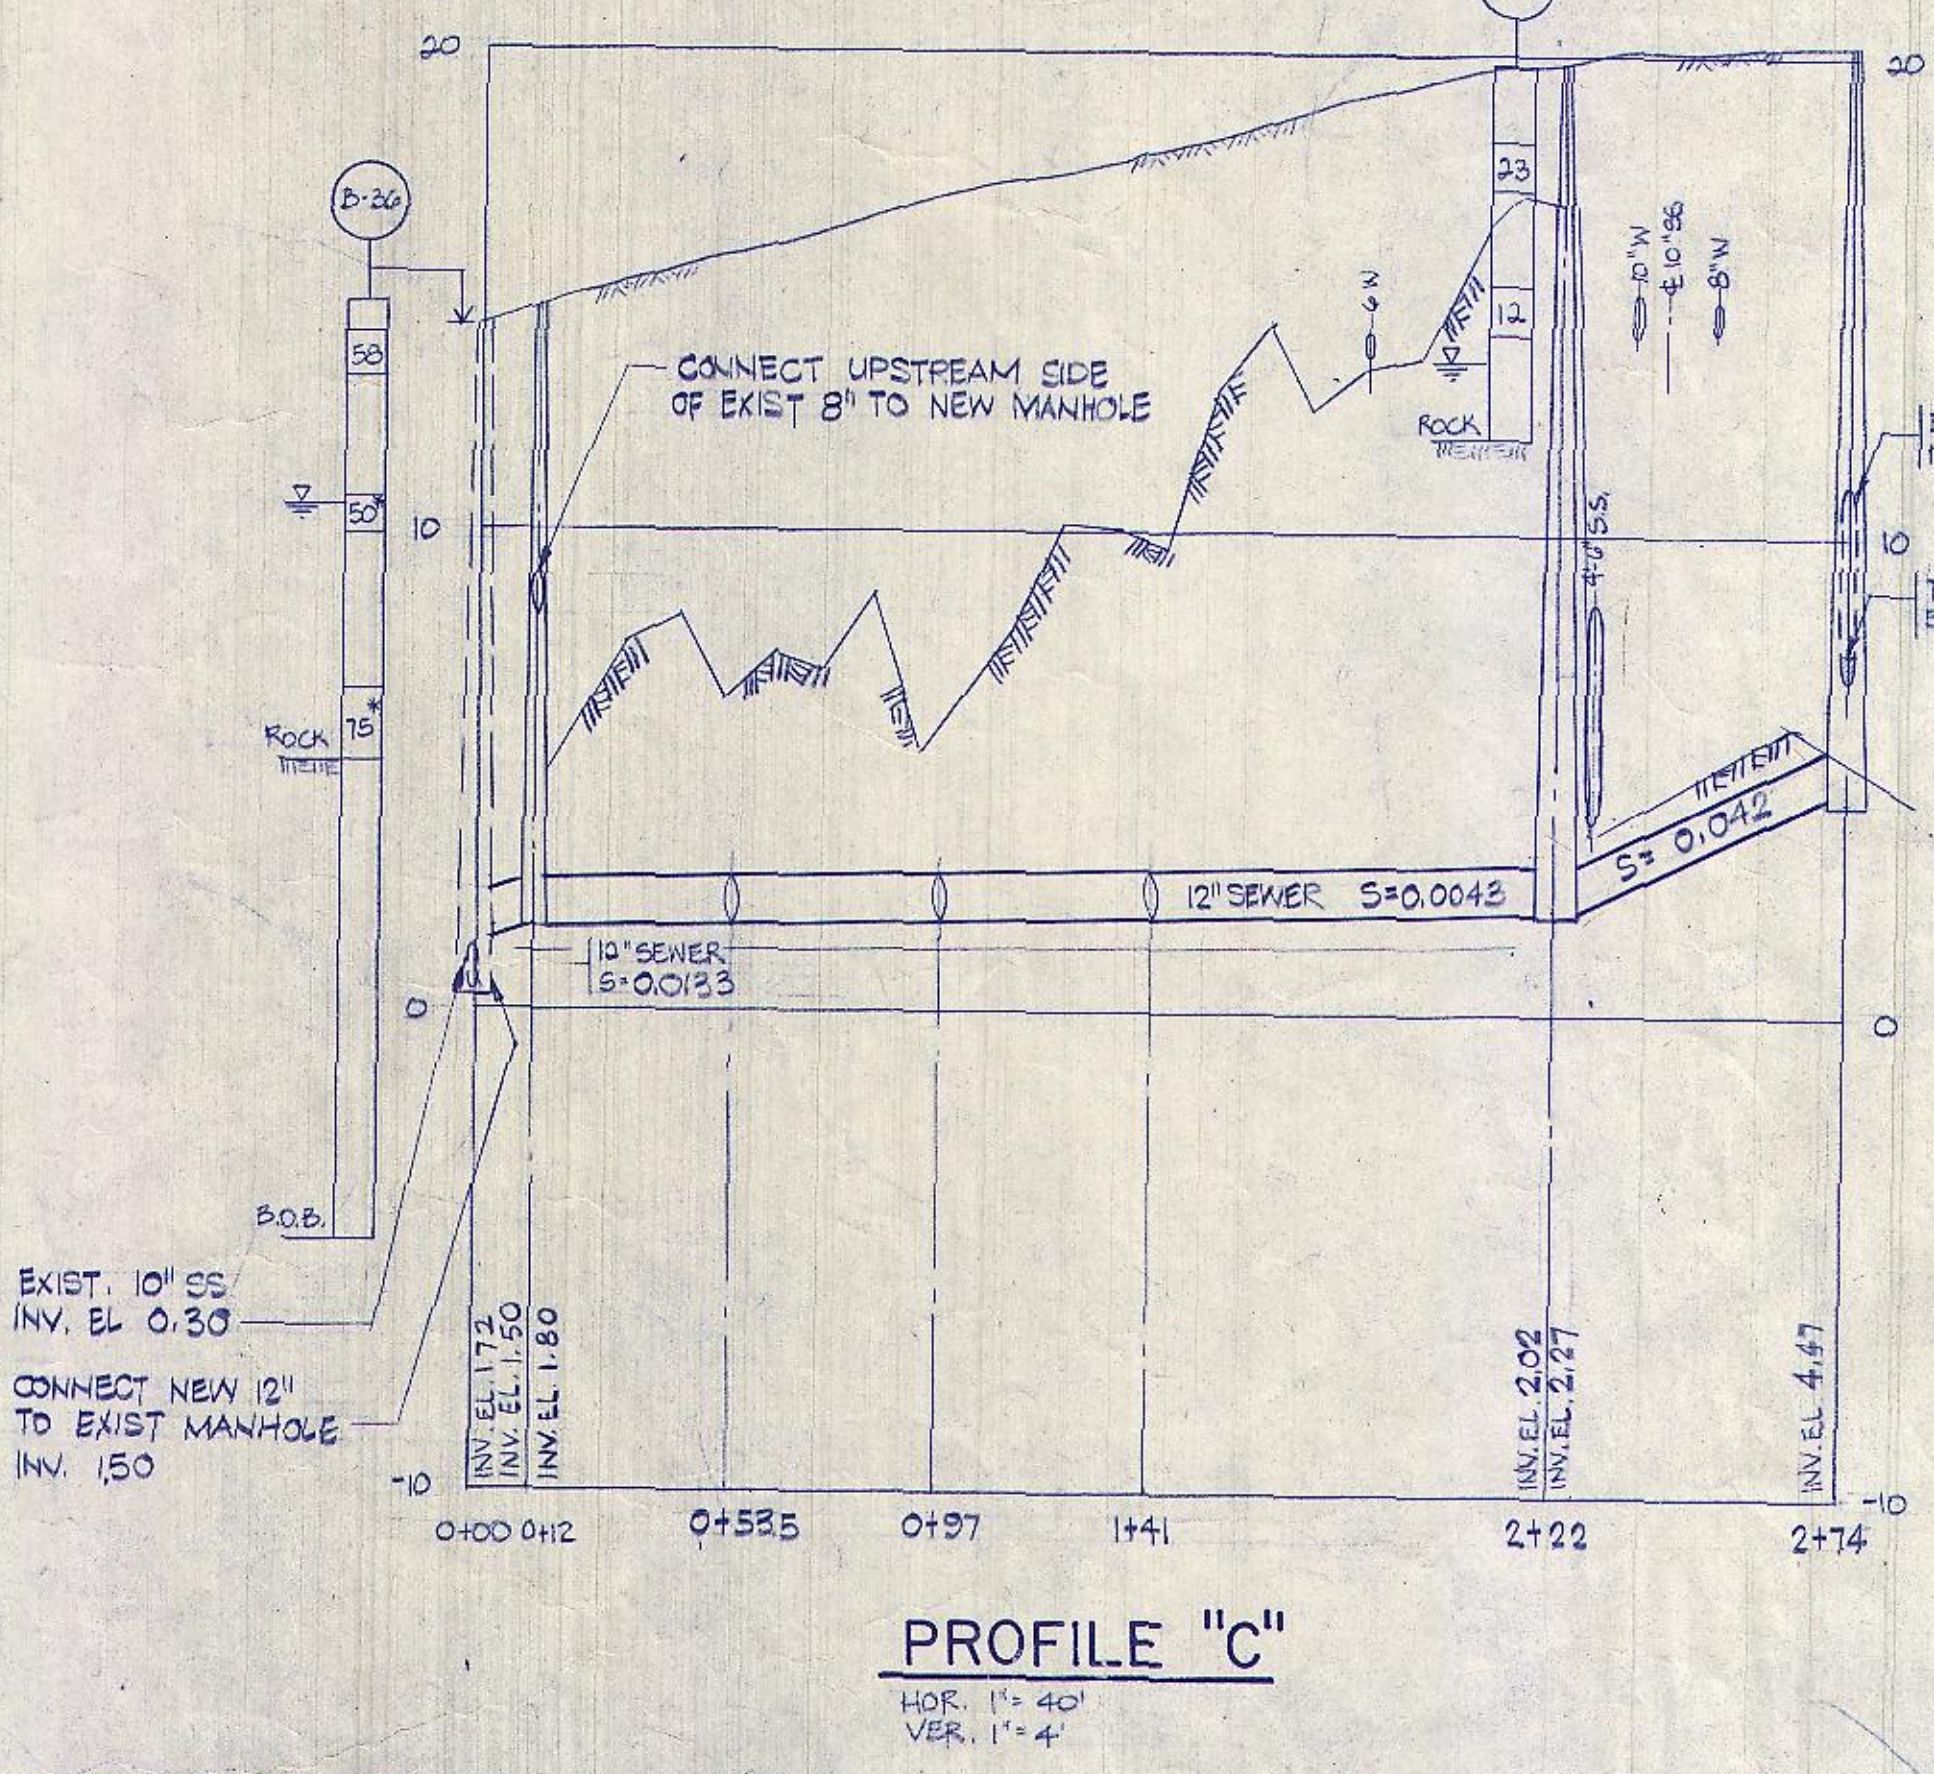
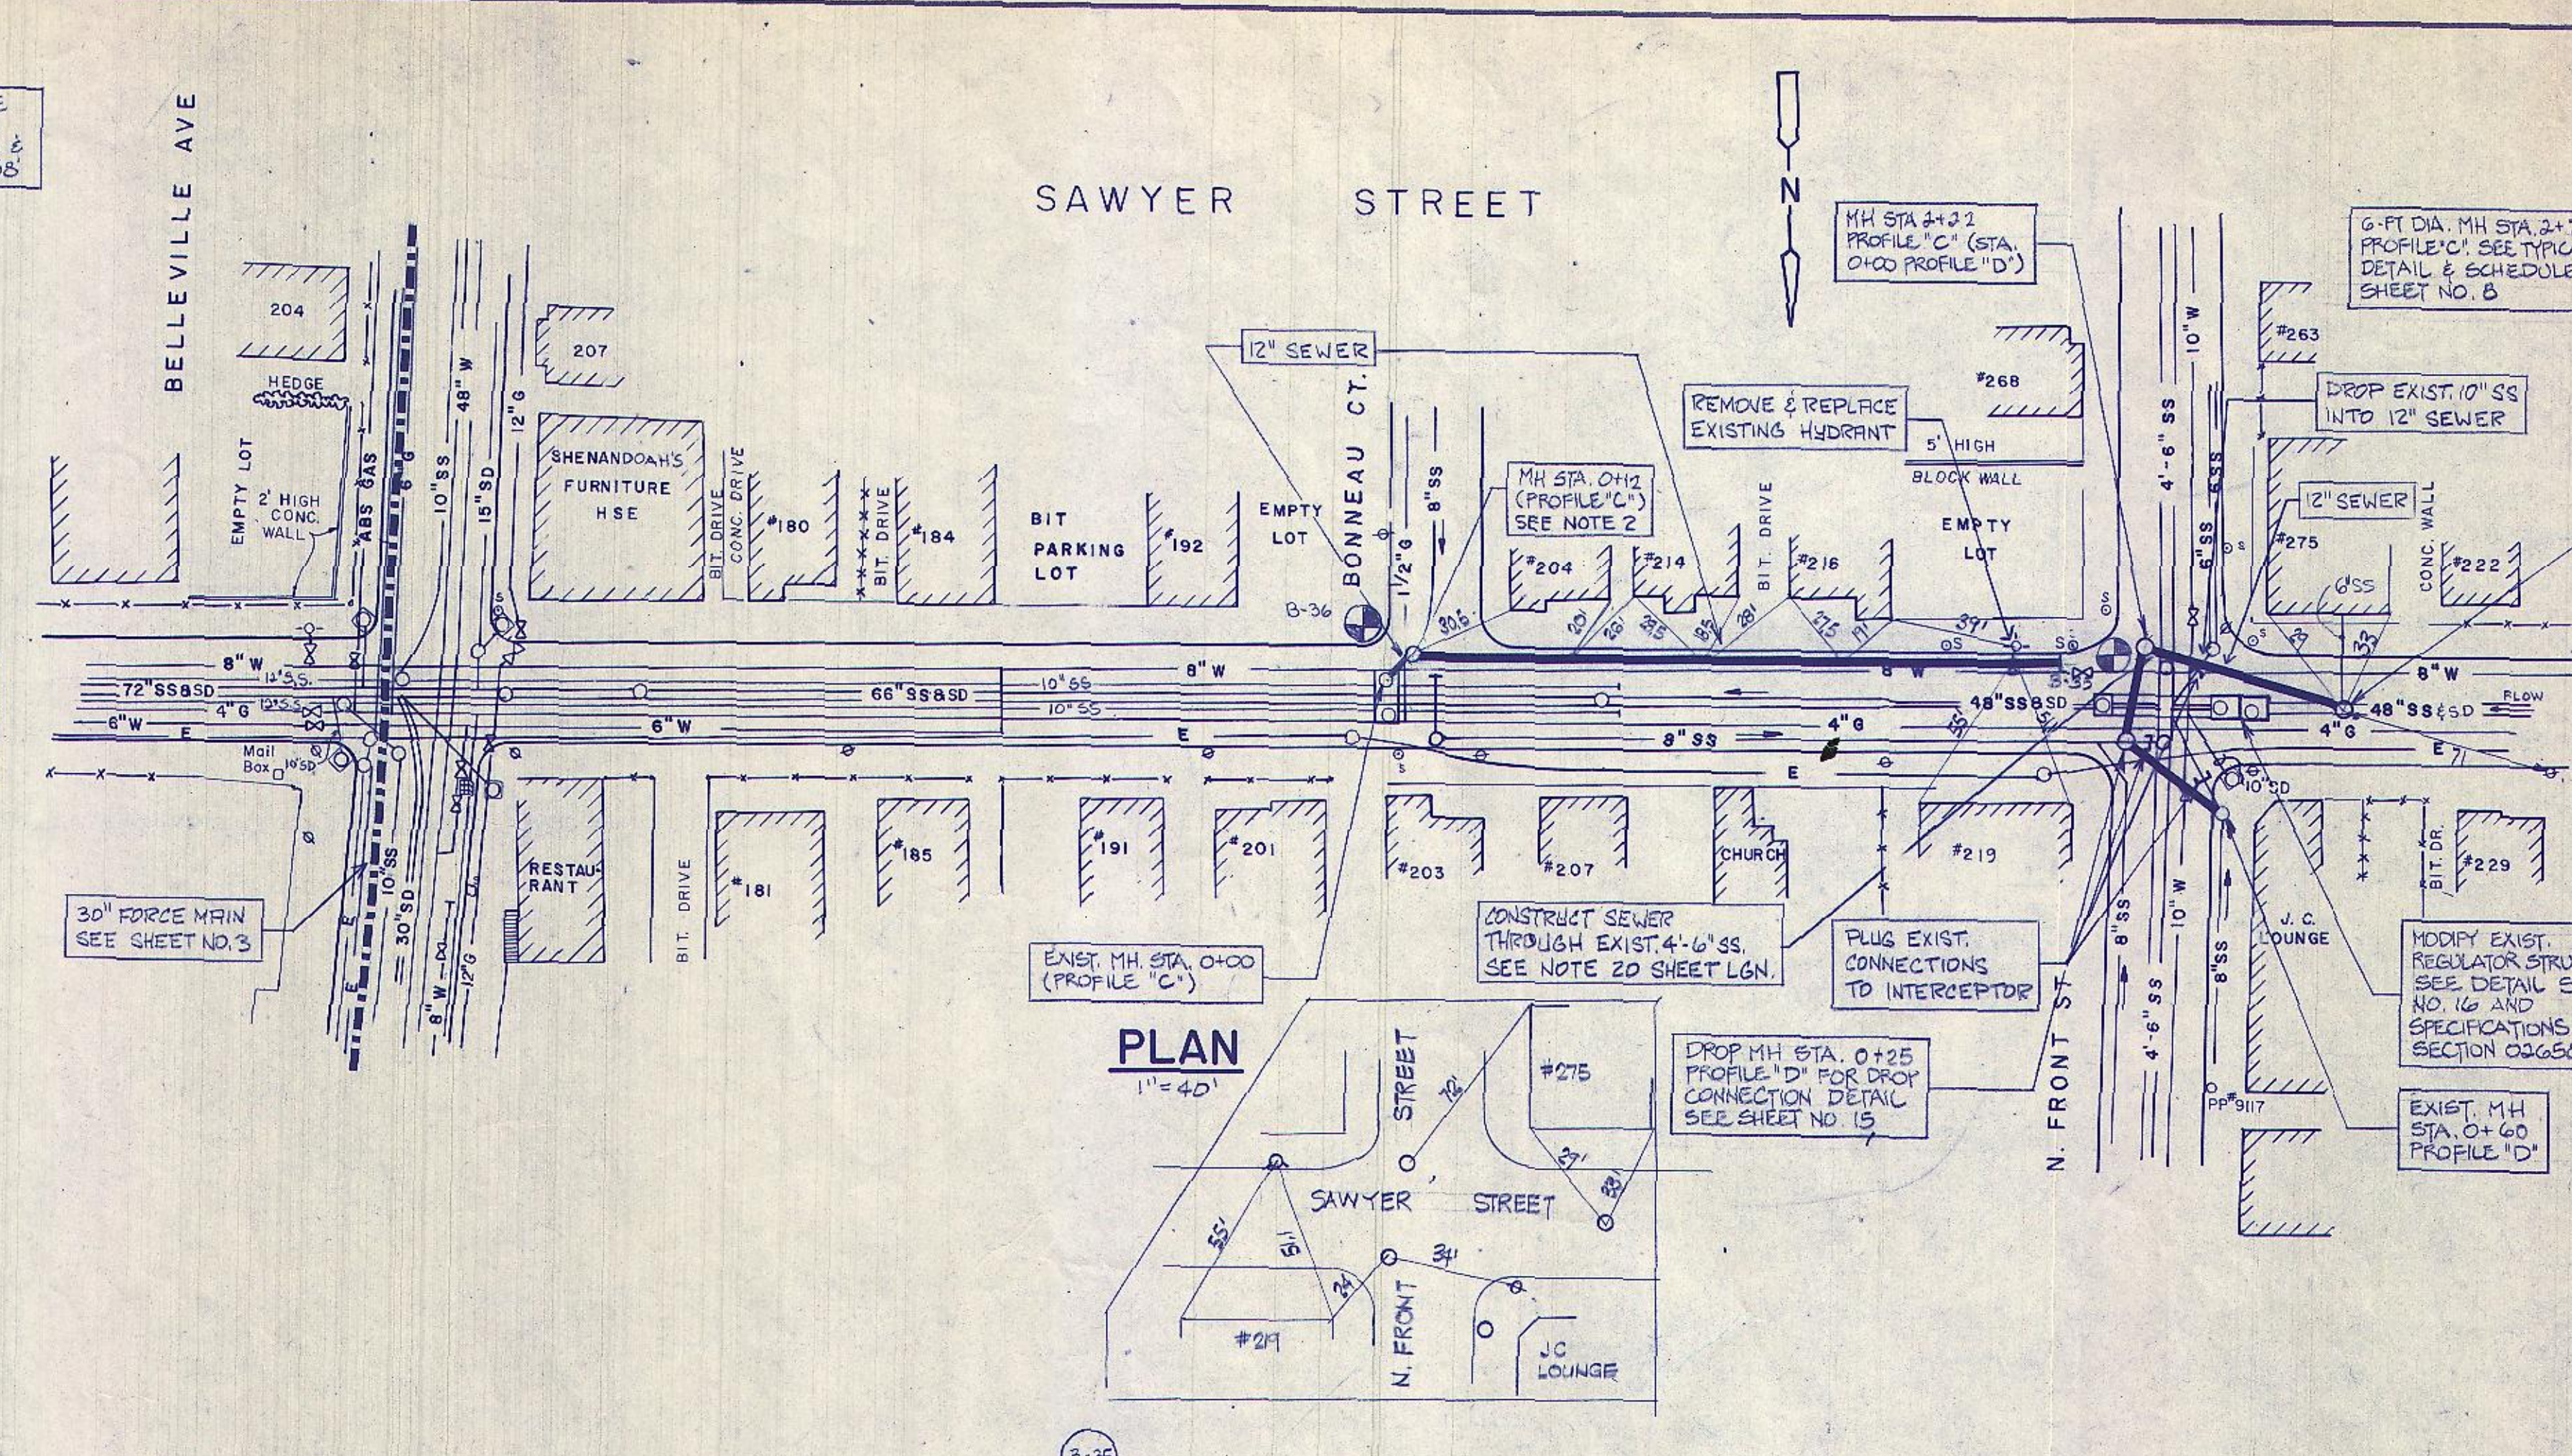
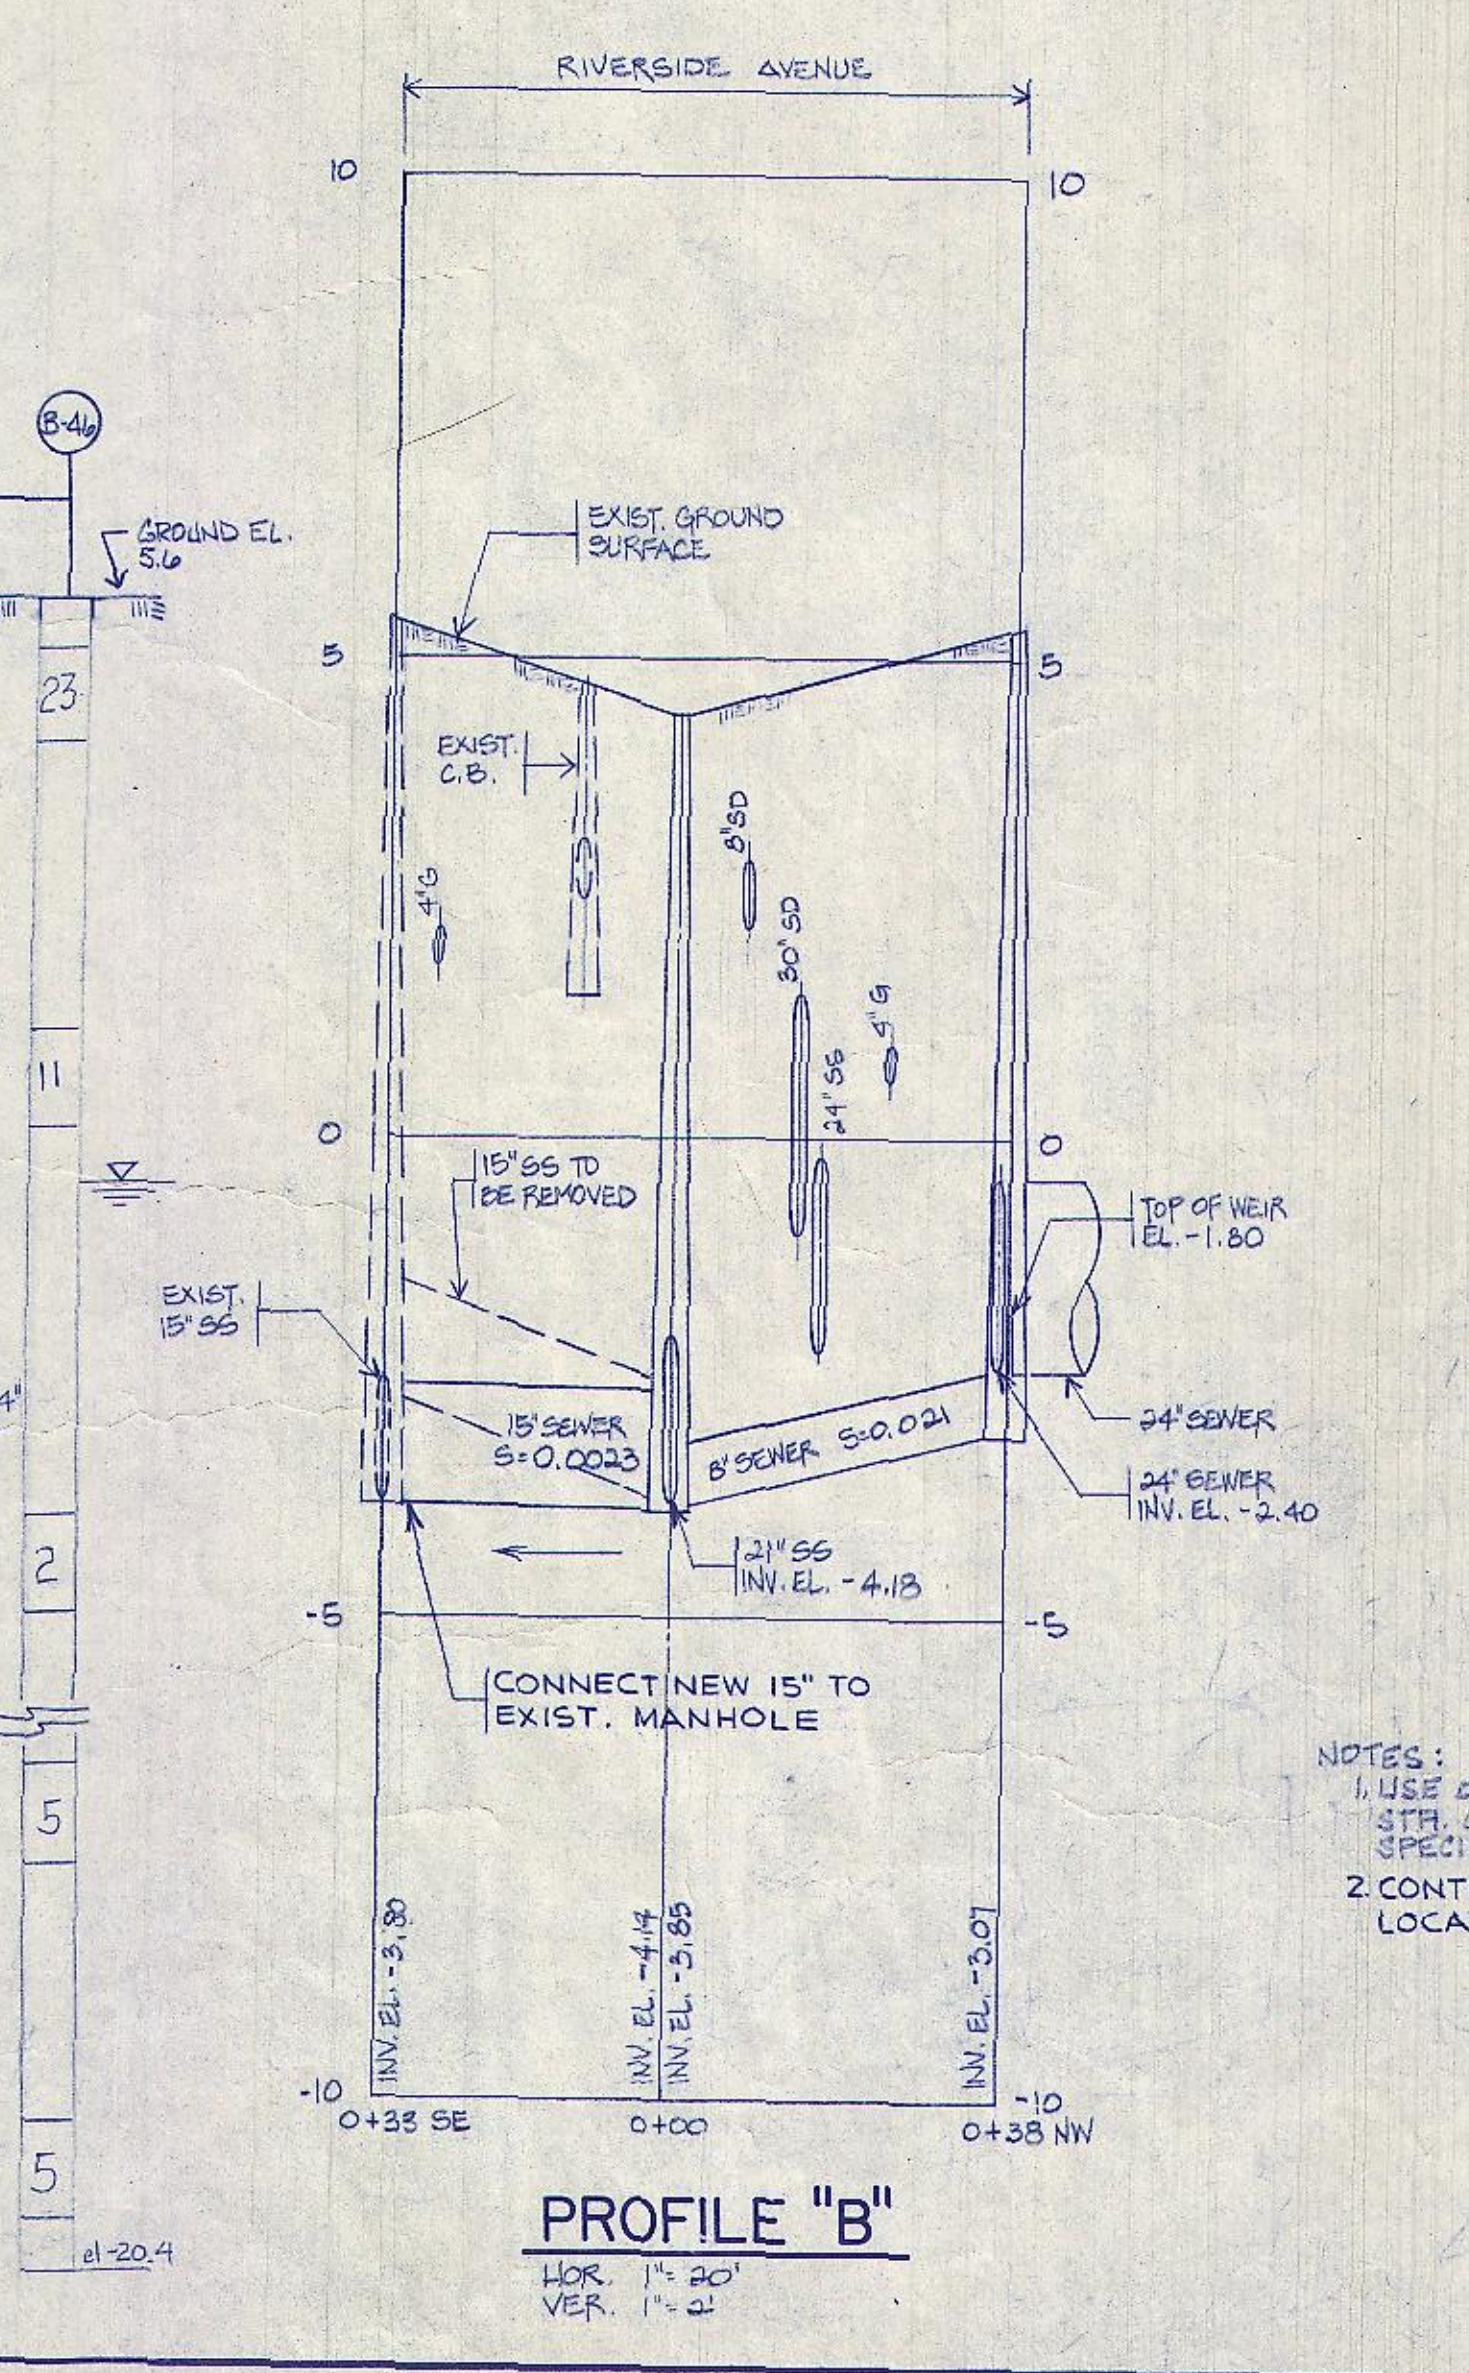


|                  |                                |
|------------------|--------------------------------|
| PROJECT MANAGER  | Approved by: _____ Date: _____ |
| PROJECT ENGINEER | Approved by: _____ Date: _____ |
| PLUMBING         | Approved by: _____ Date: _____ |
| HVAC             | Approved by: _____ Date: _____ |
| INSTRUMENTATION  | Approved by: _____ Date: _____ |
| ELECTRICAL       | Approved by: _____ Date: _____ |
| STRUCTURAL       | Approved by: _____ Date: _____ |
| ARCHITECTURAL    | Approved by: _____ Date: _____ |

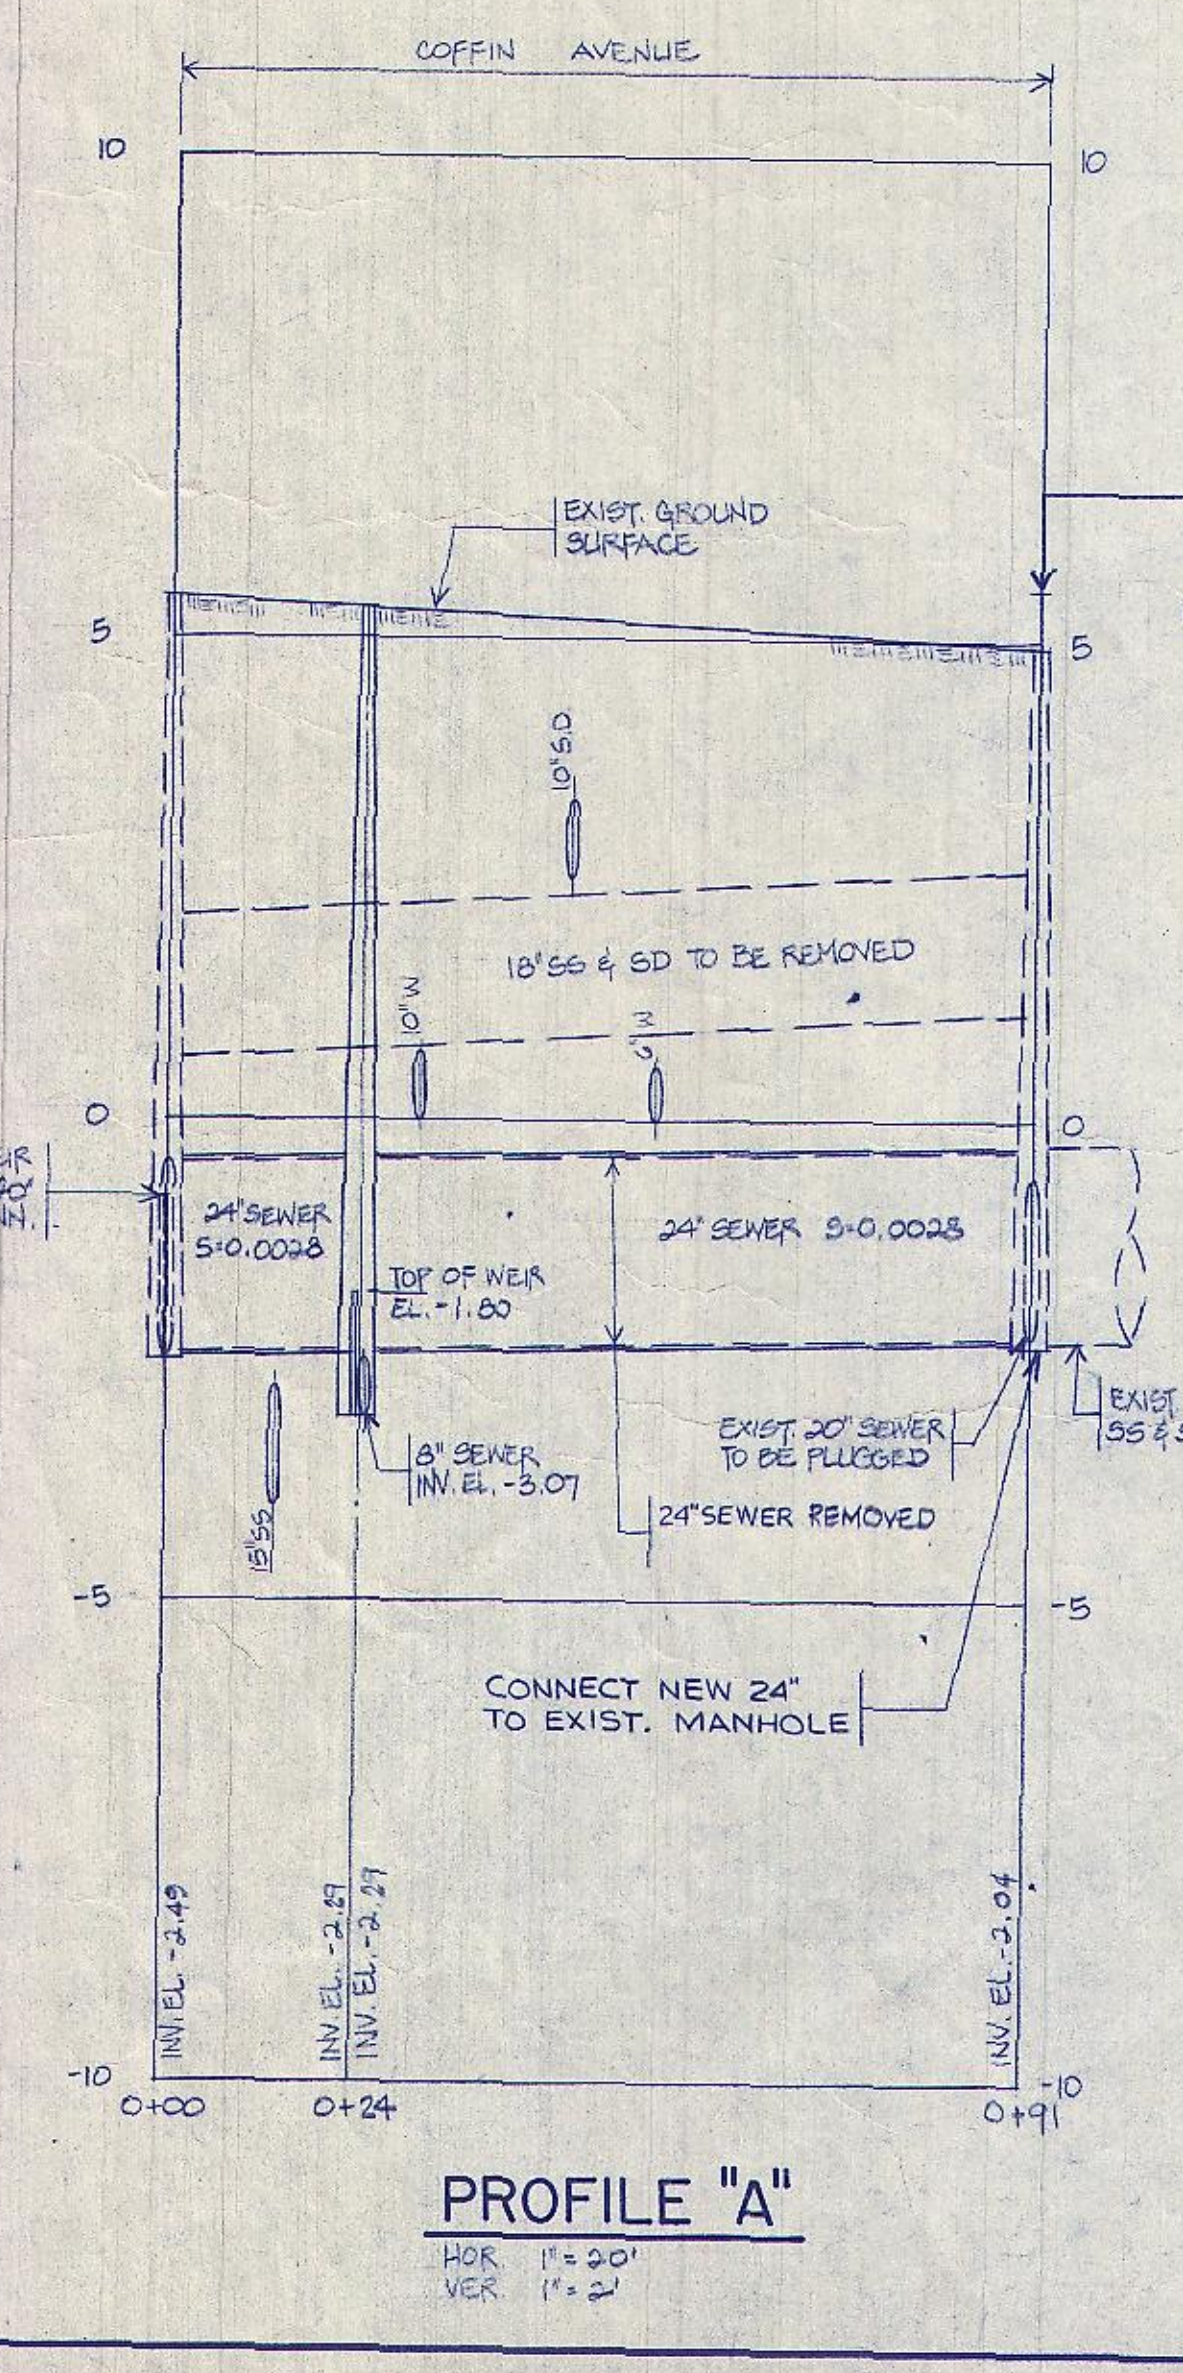

NOTES:  
 1. USE OF MOVABLE TRENCH BRACING IS PROHIBITED  
 2. CONTRACTOR TO DIG TEST PIT TO VERIFY LOCATION AND ELEVATION OF EXISTING 8" SEWER.

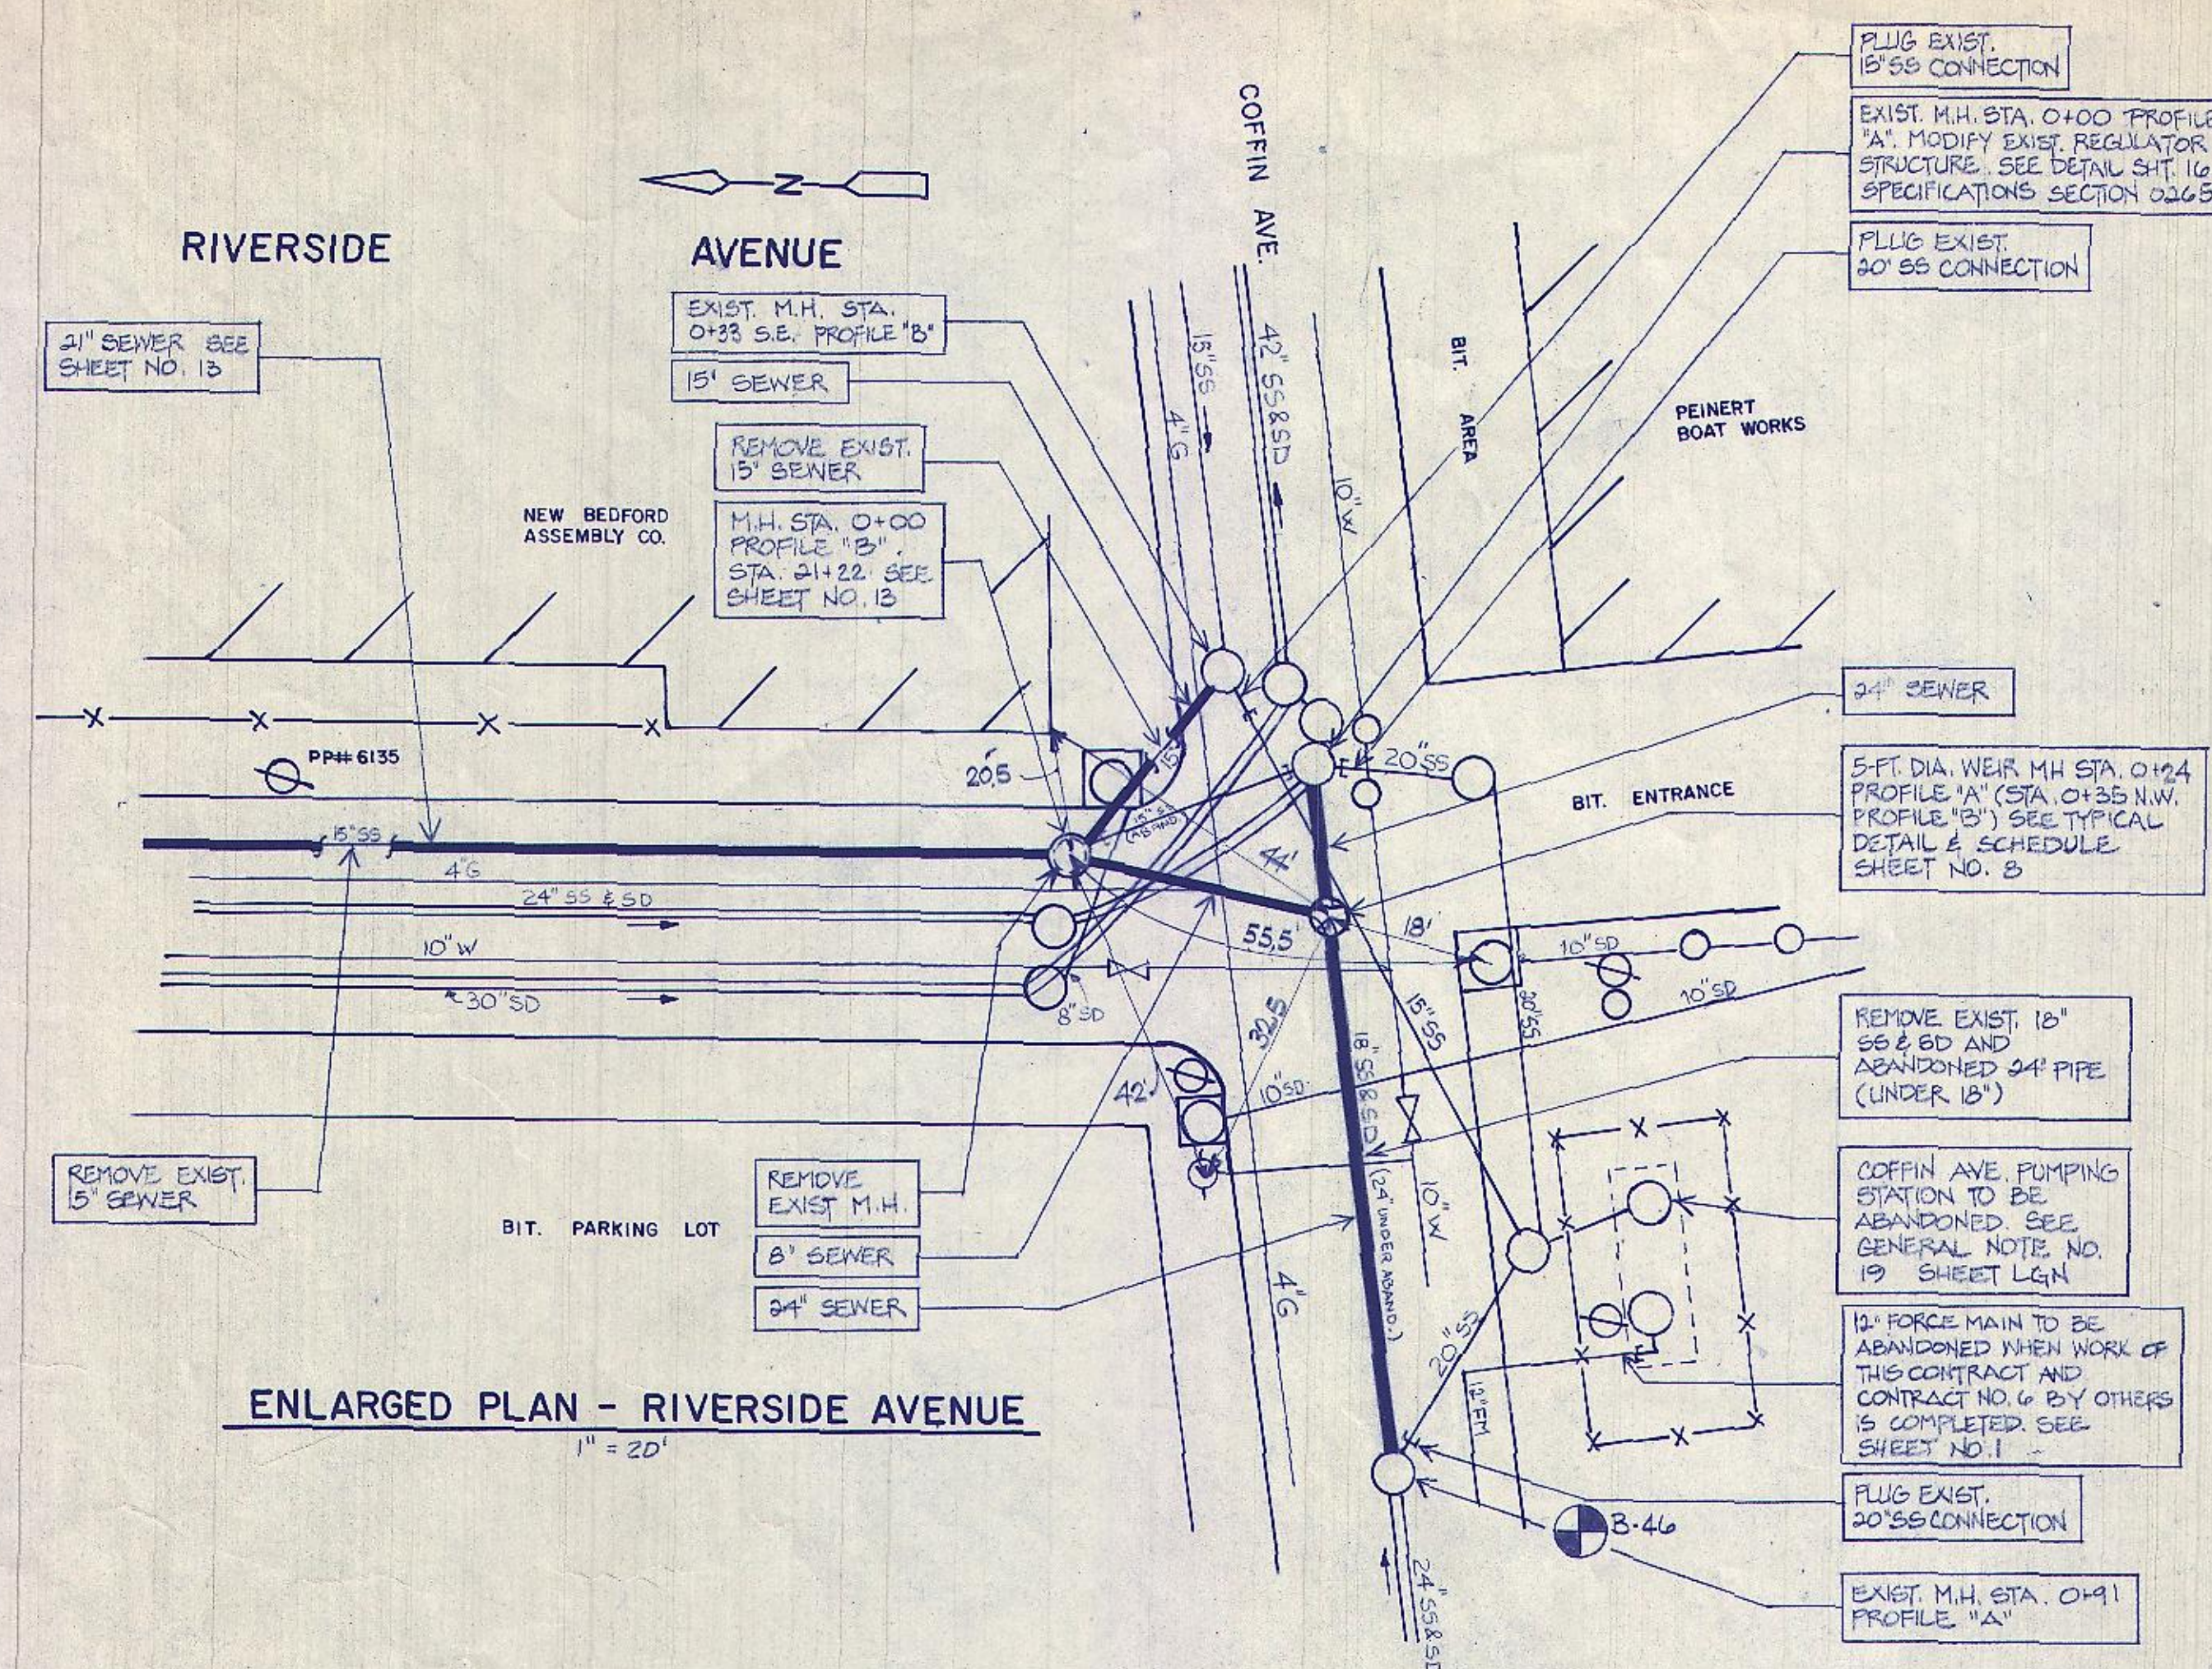

|                                                                           |  |
|---------------------------------------------------------------------------|--|
| CITY OF NEW BEDFORD, MASSACHUSETTS                                        |  |
| BELLEVILLE AVENUE FORCE MAIN EXTENSION                                    |  |
| CONTRACT NO. 5                                                            |  |
| SAWYER STREET                                                             |  |
| SHEET NO. 11                                                              |  |
| CAMP DRESSER & McKEE INC.                                                 |  |
| Ten Cambridge Center<br>Cambridge, Massachusetts 02142                    |  |
| CDM                                                                       |  |
| environmental engineers, scientists,<br>planners & management consultants |  |
| 309-47810                                                                 |  |

|                      |                             |
|----------------------|-----------------------------|
| 7/94                 | REVISED FOR RECORD DRAWINGS |
| Date                 | CHK'd                       |
| Revision             |                             |
| Designed by: SRA/AGZ | Drawn by: JJB               |
| Checked by: SRA      | Scale: AS SHOWN             |
| Approved by: SJH     |                             |