




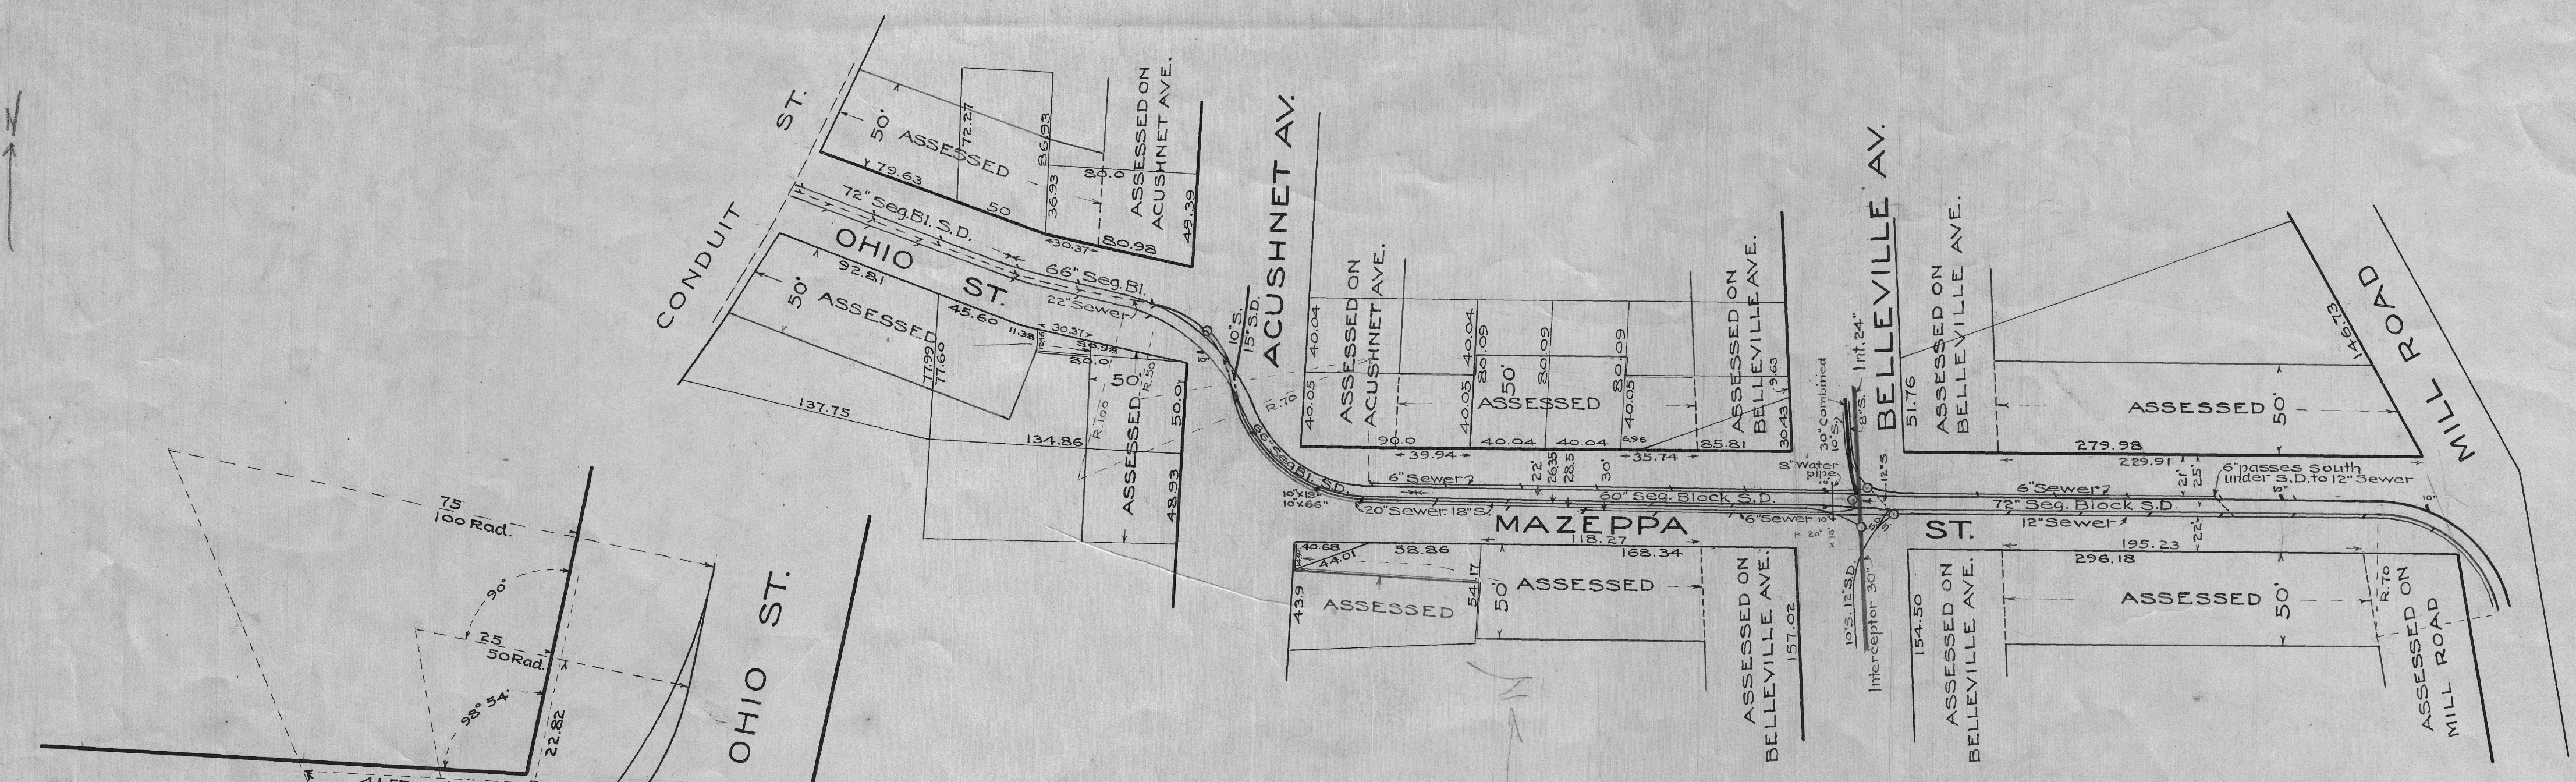


PLAN SHOWING CONSTRUCTION
AT MAZEPPA ST. AND BELLEVILLE AVE.
Scale; 1 in. = 10 ft.

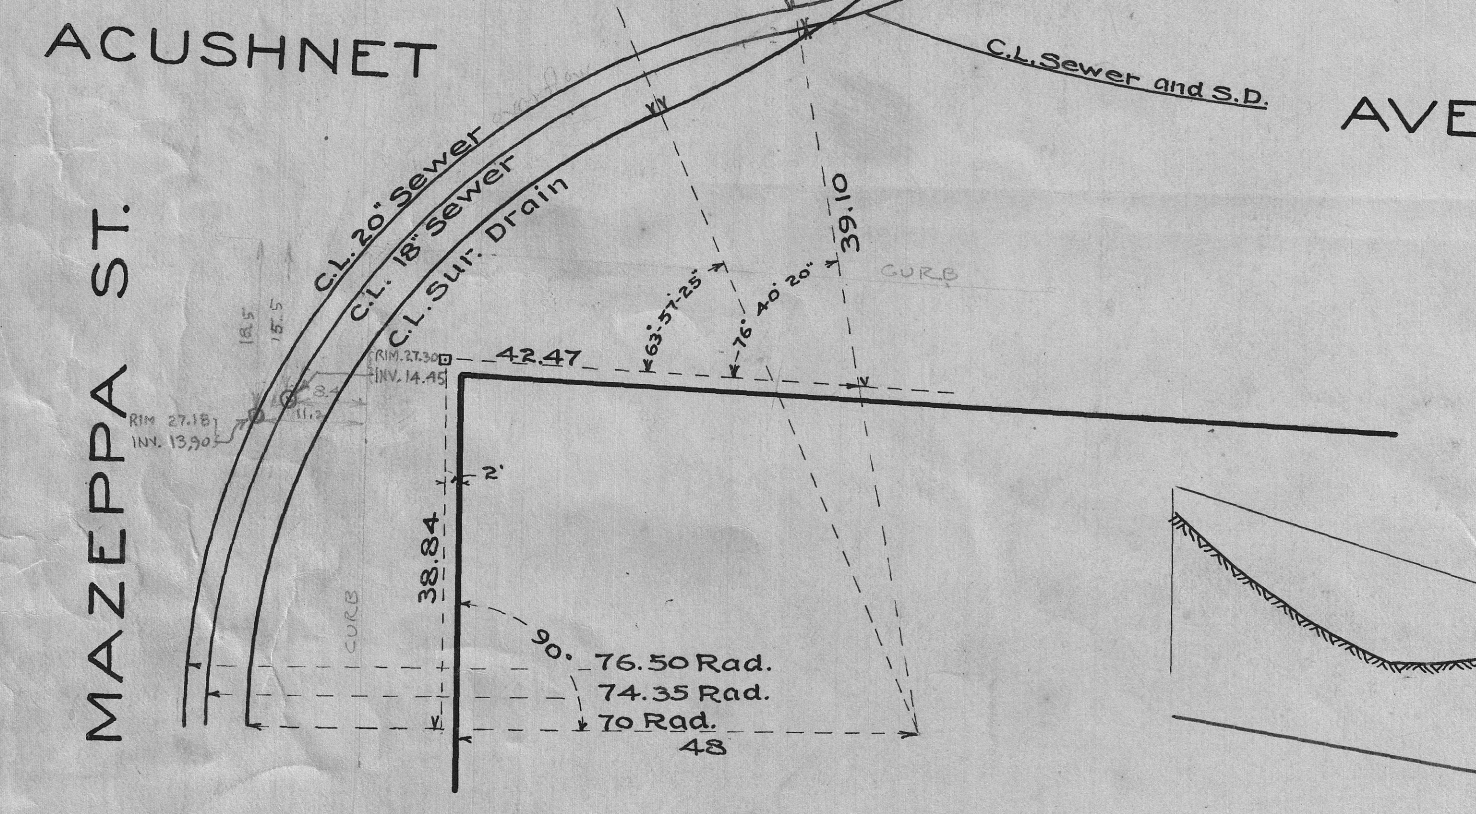

LOCATION PLAN
Scale; 1" = 20'

SHEET NO. 2.
TARKILN HILL SYSTEM FIRST SECTION

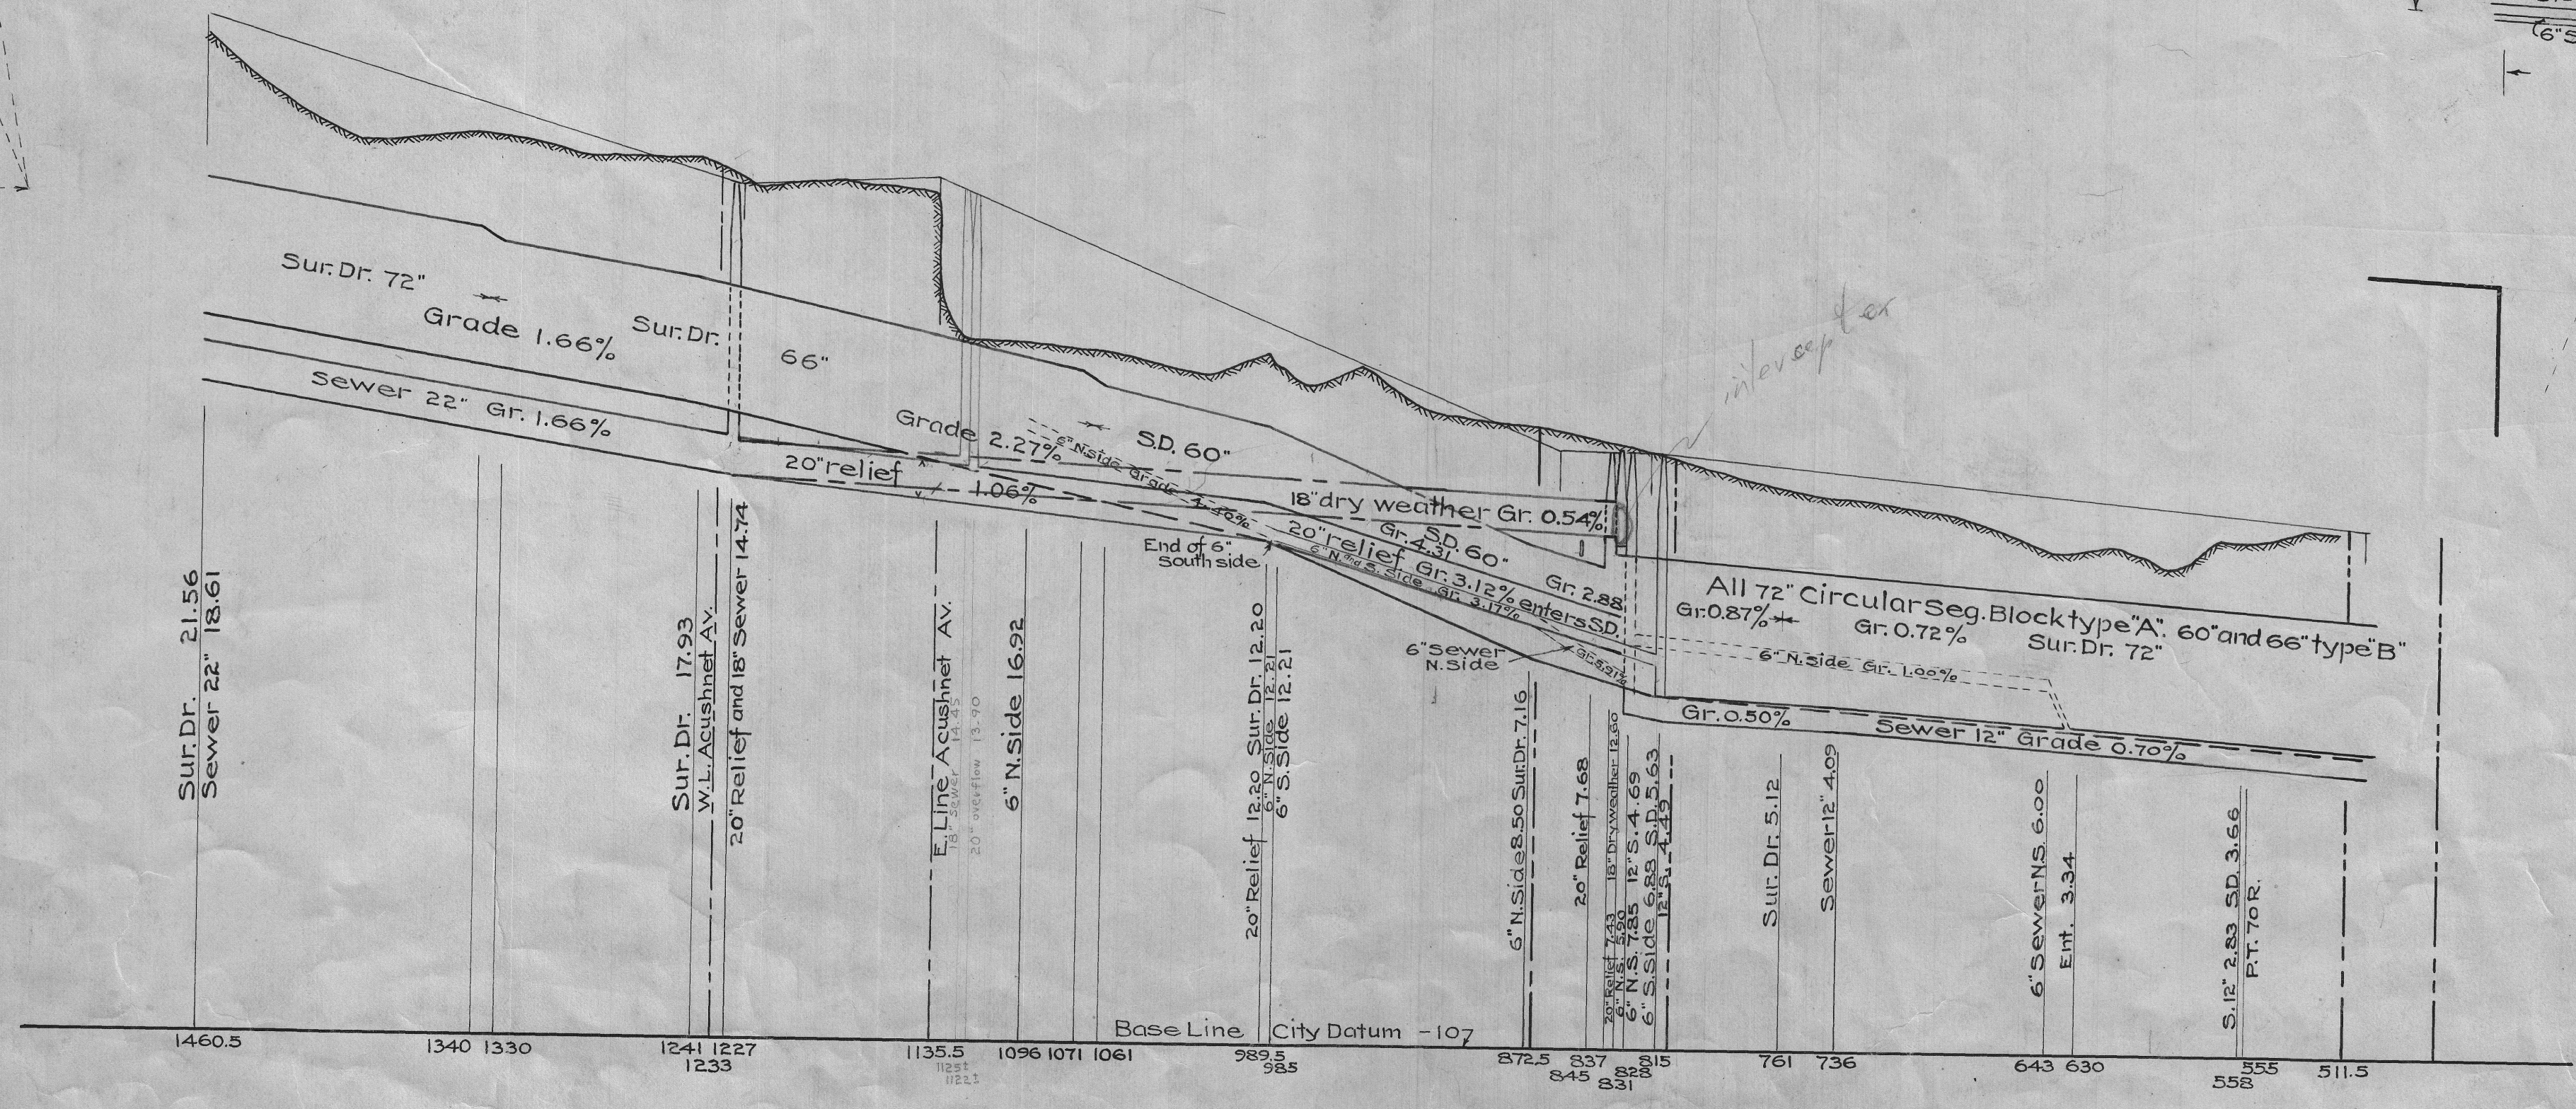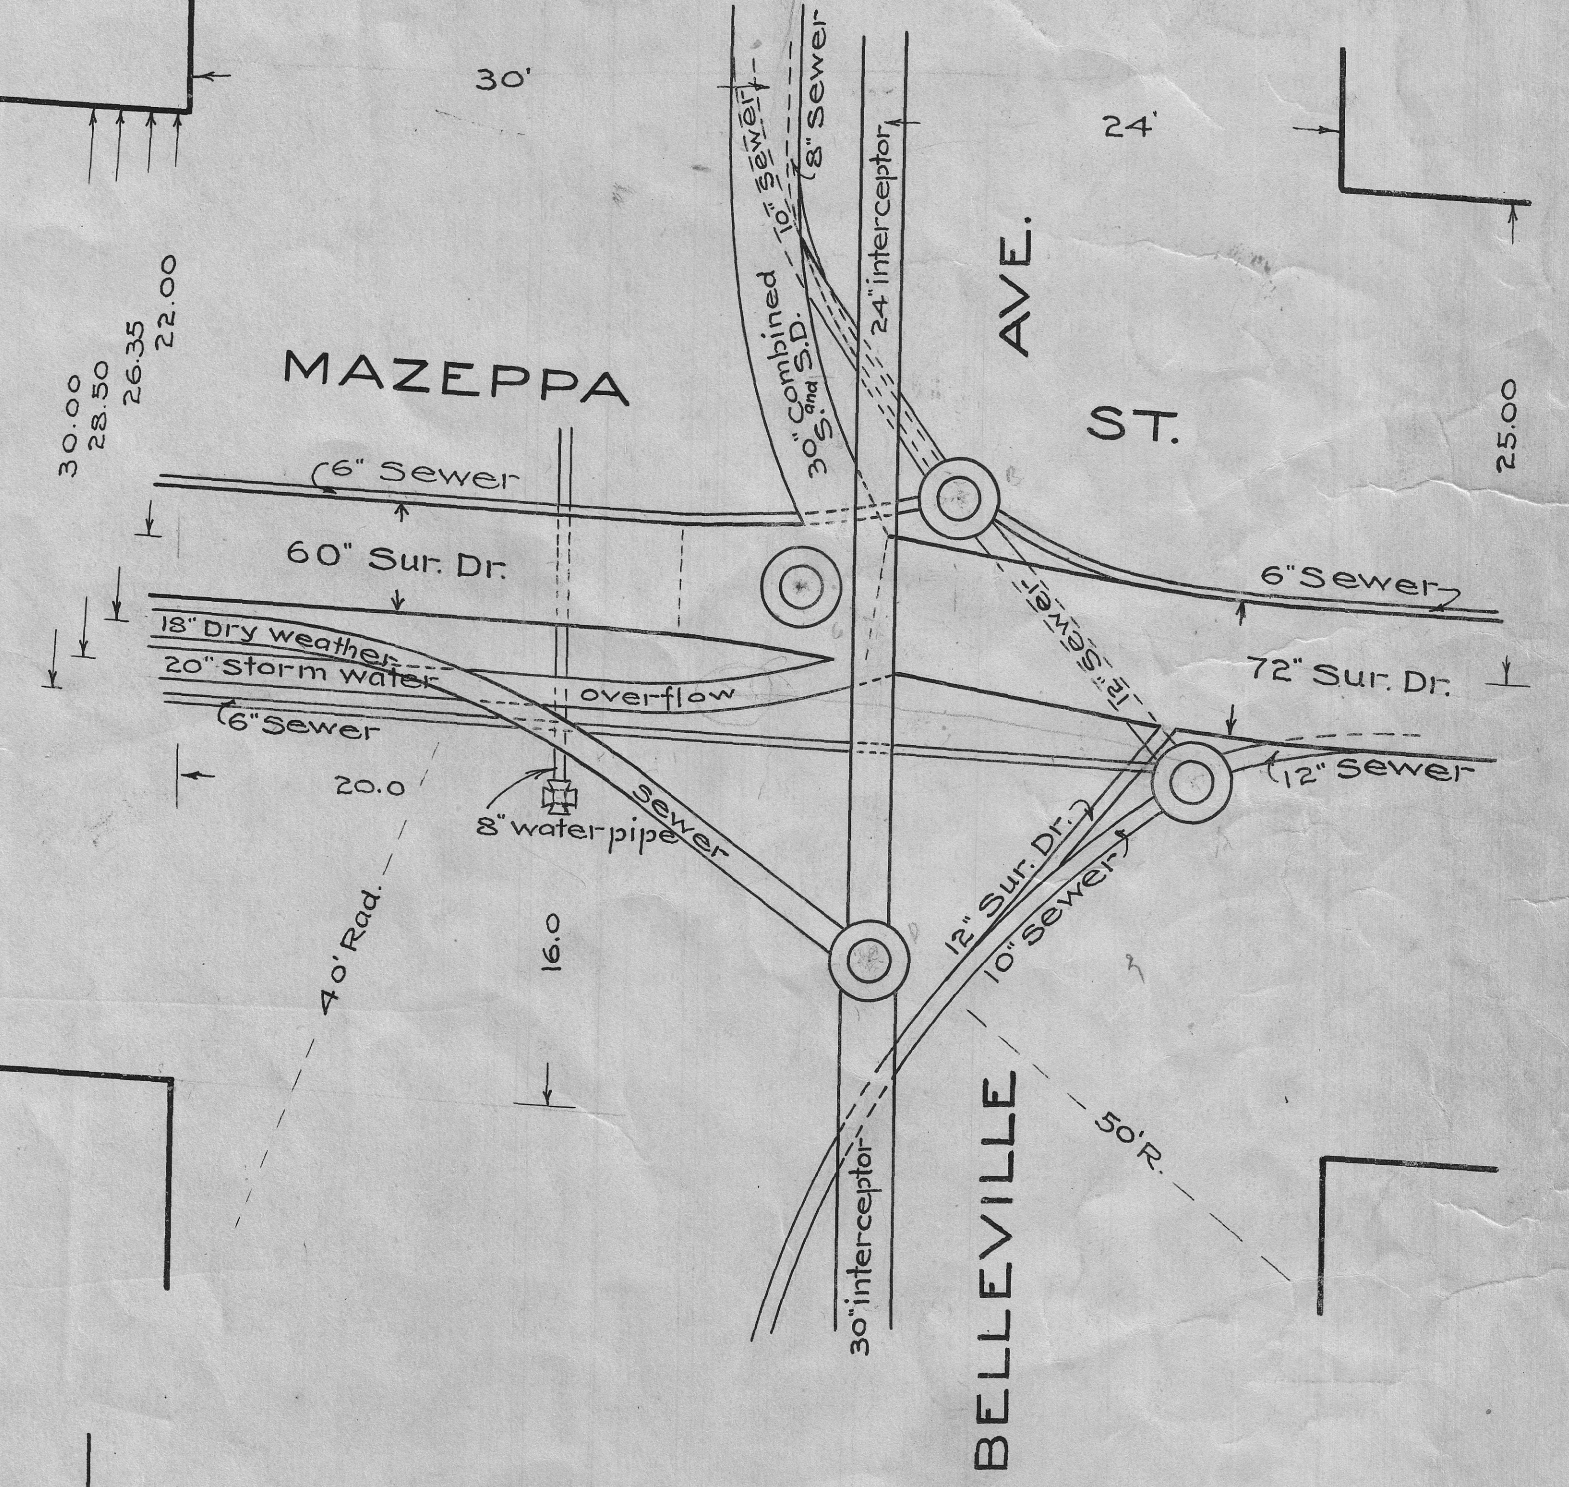

126' Vert
1227
233