



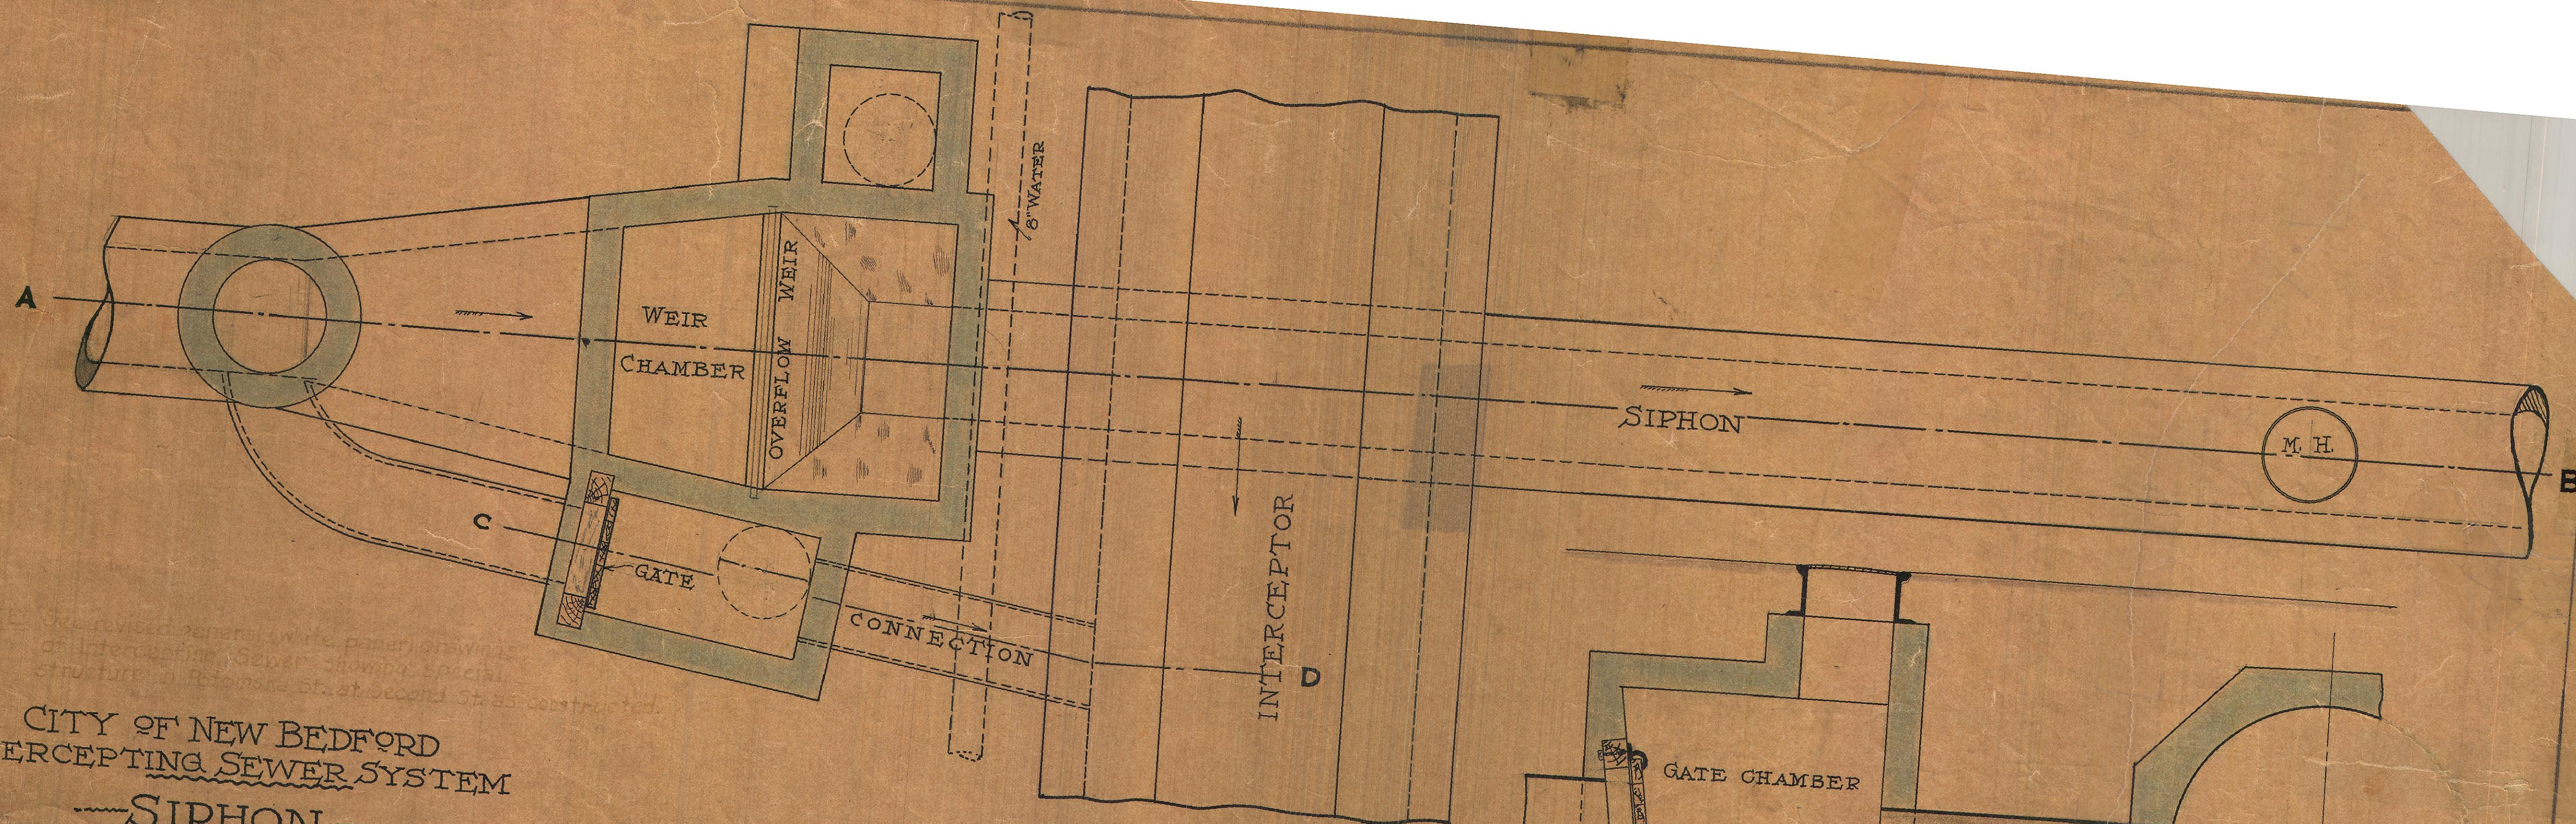

SECTIONAL PLAN

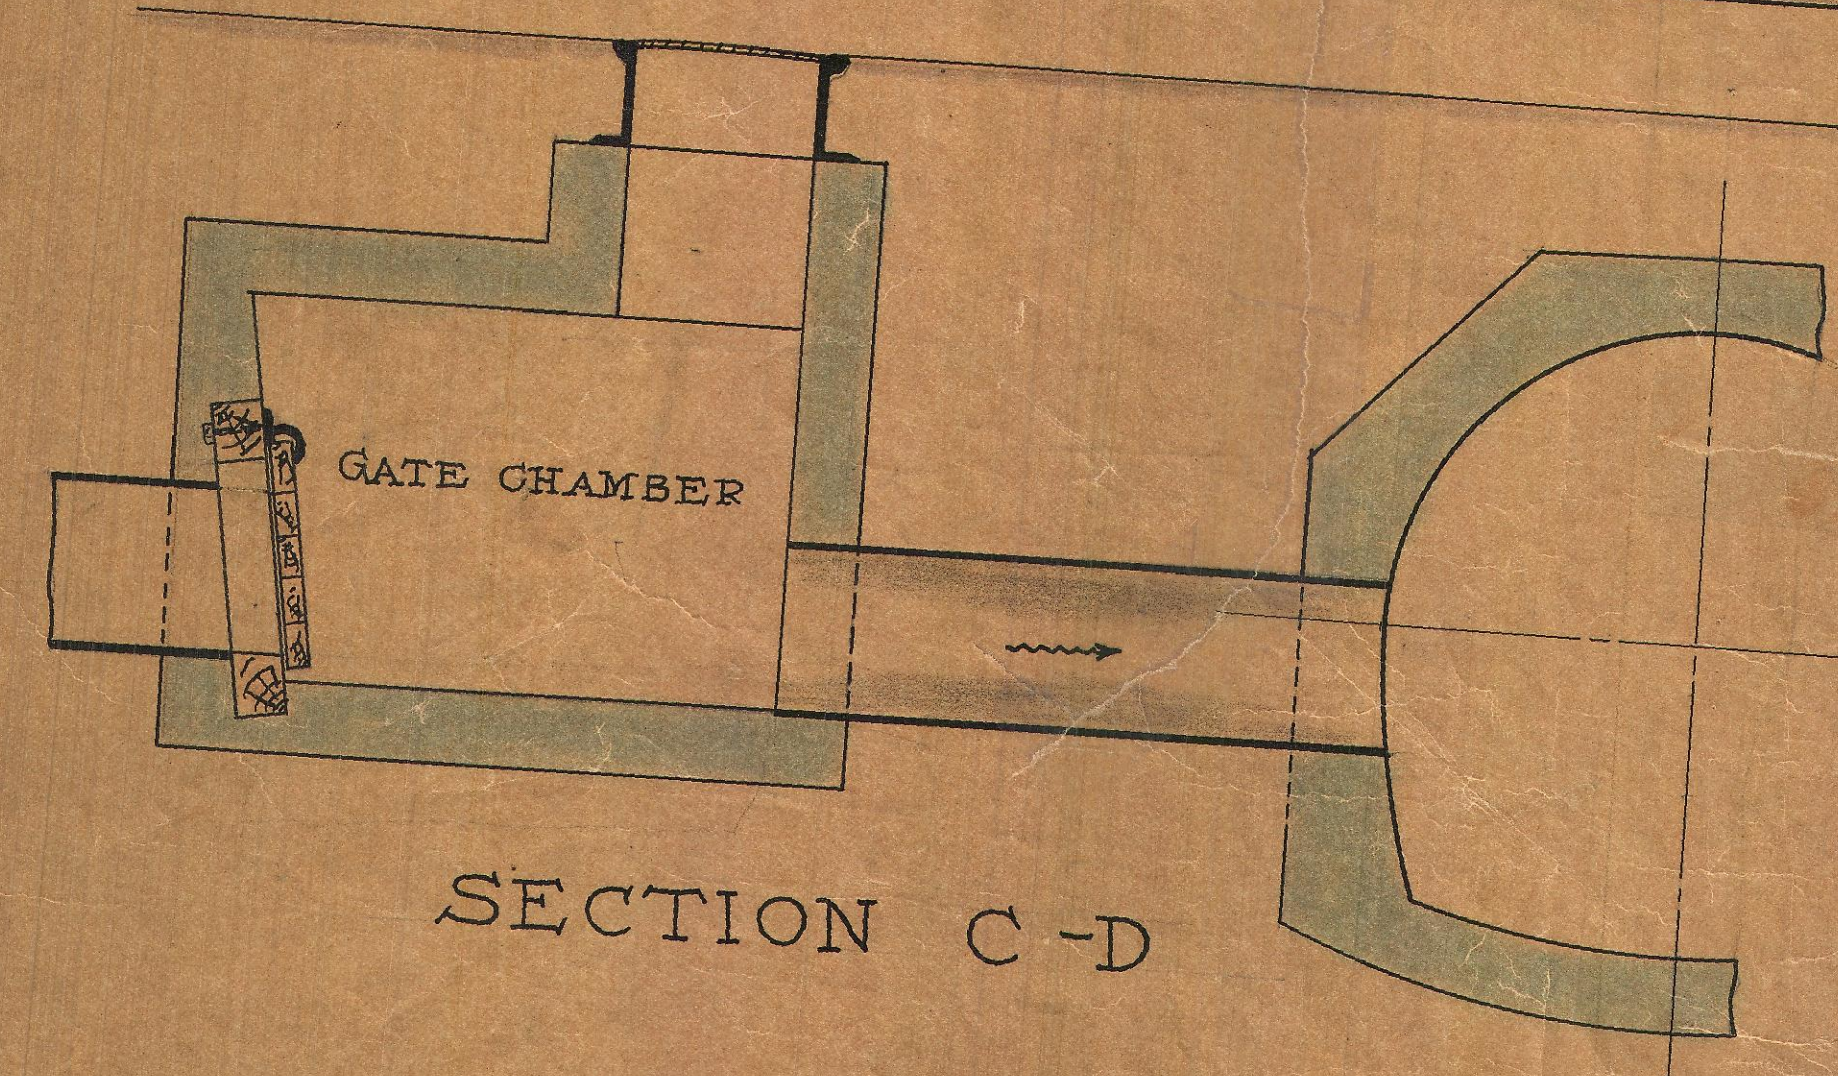


SECTION C-D

NOTE: See Note Book 501-46, 49 showing location of center of manhole openings and dimensions of special structure as constructed.

CITY OF NEW BEDFORD
INTERCEPTING SEWER SYSTEM

SIPHON
POTOMSKA ST.
June, 1913

SCALE $\frac{1}{2}" = 1'-0"$

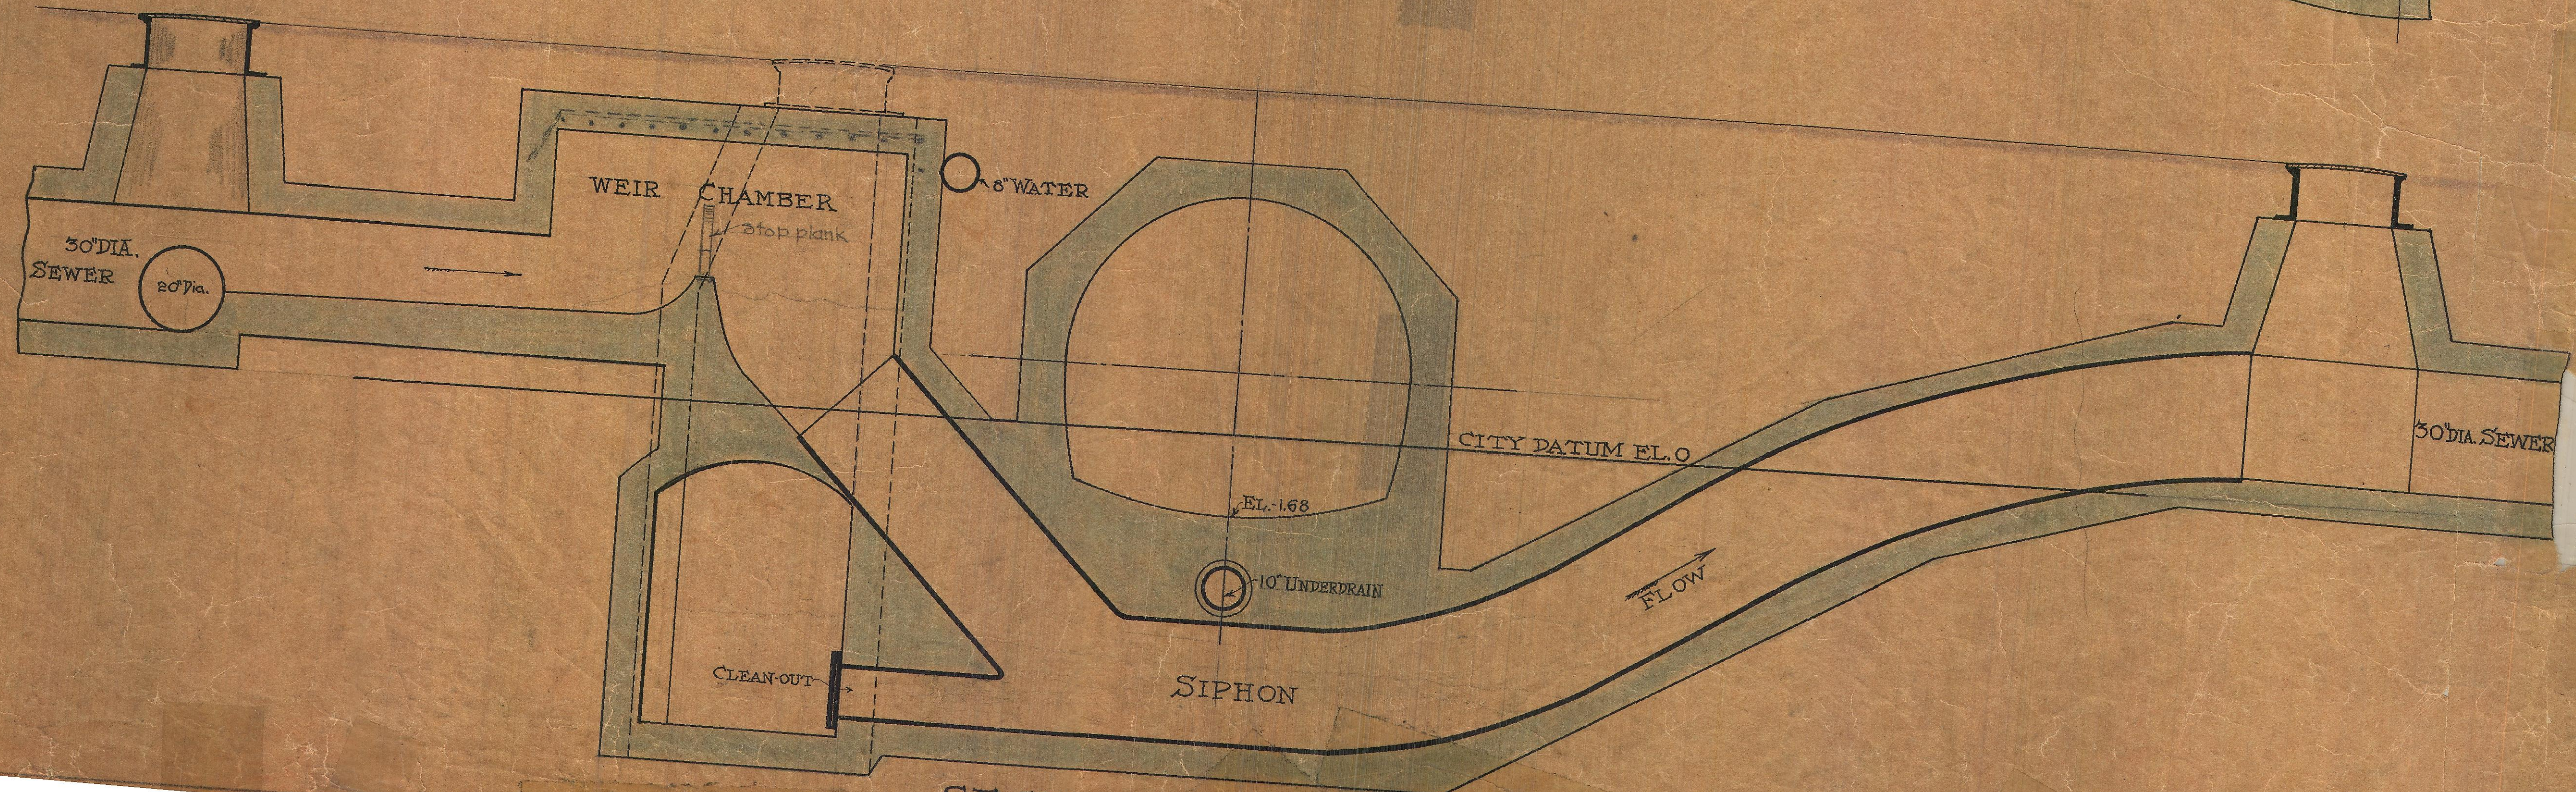

SECTION A-B